



MADHYA PRADESH POWER TRANSMISSION CO.LTD.
(A wholly owned Govt. of Madhya Pradesh Undertaking)
CIN: U40109MP2001SGC014880
Block No.3 Shakti Bhawan, Rampur, Jabalpur (M.P.) 482008
Phone : (0761)270-2162, 2238, 2134 Fax:(0761)2665593 e-mail: mptransco@nic.in

Annexure A

No. 04-01/ADB-III/TR-501/Lot-1/TK / 77/

Dated : 29 JAN 2015

To,

M/s. Bharat Heavy Electricals Ltd,
Tower-A, 5th Floor, Advant Navis
IT Business Park, Plot No. 7,
Express Highway, NOIDA, UP

Fax 0120-6748494

Sub: Construction of new 400kV sub-stations, transmission lines and Augmentation work/feeder bay work on total turnkey basis TR-501(Lot no. 1) against contract dtd. 28.02.2014.

Ref:- i. Your letter No. TBEM/MPPTCL/TR-501/83012/LOT-1/CB/220/SK dtd. 08.01.15.
ii. This office order No. 04-01/ADB-III/MPPTCL/TR-501/Lot-1/TK-II/06602-3 dtd.28.02.2014.

Dear Sirs,

This has reference to your letter dtd. 08.01.2015 vide which you have submitted M/s. Siemens make drawings/details of 220 kV Circuit Breaker for our approval against contract dtd 28.02.2014, as per following details:-

Sl No.	Drawing/details of 220 kV CB	Drg. No.	Observation
1	Record of Drawing	(4) G71AHS-FA403-R608	OK
2	Design details (Three Sheet)	(4) G71AHS-FA403-D608	OK
3	Mandatory Spare List	(4) G71AHS-FA403-S608	OK
4	Standard GA Drawing (Sheet 1 & 2)	(4) G71AHS-FA403-Z608	OK
5	Standard Support Structure (Sheet 2 & 2)	(4) G71AHS-FA403-Z608	OK
6	Name Plate	(4) G71AHS-FA403-N608	Guarantee period should be 24 months from the date of commissioning of S/s (As mark in drawing by Red Ink)
7	Marshalling Box (Sheet 1 of 3)	(4) G71AHS-FA403-L608	OK
8	Control Panel Layout (Sheet 2 of 3)	(4) G71AHS-FA403-L608	OK
9	Inter cabling arrangement (Sheet 3 of 3)	(4) G71AHS-FA403-L608	OK
10	Bill of materials equipment list	(4) G71AHS-FA403-E608	OK
11	Wiring drawing & Terminal plan (total 7 sheets)	(4) G71AHS-FA403-W608	OK

Subject to incorporation of modification indicated with red ink, the drawing submitted by you are generally found in order and hereby approved. Copy of the approved drawing duly stamped is enclosed herewith for your further needful.

Thanking you.

Encl : As above

Yours sincerely,

Chief Engineer (Procurement)

Copy to:

1. The Chief Engineer (EHT-C) MPPTCL, Jabalpur.
2. The Chief Engineer (EHT-M&I) MPPTCL, Jabalpur, with one set of drawing.
3. The S.E. (EHT) Circle, MPPTCL, Bhopal/Jabalpur/Indore.
4. The Executive Engineer (EHT:C.)Dn. MPPTCL, Bhopal/Barwaha-II/Ujjain with one set of drawing.
5. The Executive Engineer (EHT:C.) Dn.-I MPPTCL, Jabalpur with one set of drawing.

Index	Amendment/Revision	Date	Name	Index	Amendment/Revision	Date	Name
A				E			
B				F			
C				G			
D				H			

The reproduction transmission of use of this document or its contents is not permitted without express written authority. Offenders will be liable for damages. All rights, including rights created by patent grant or registration of a utility model or design are reserved.

Sr. No.	Drawing No.	No. of Sh	Brief details of drawings	Amendment to RECORD OF DRAWINGS												Qty of Prints
				A	B	C	D	E	F	G	H	I	J			
1	(4)	G 7 1 A H S - F A 4 0 3 - D 6 0 8 -	Design Details													
2	(4)	G 7 1 A H S - F A 4 0 3 - Z 6 0 8 -	GA Drawing /Support Structure													
3	(4)	G 7 1 A H S - F A 4 0 3 - N 6 0 8 -	Rating Plate													
4	(4)	G 7 1 A H S - F A 4 0 3 - L 6 0 8 -	Equipment Layout (Front/Rear)													
5	(4)	G 7 1 A H S - F A 4 0 3 - E 6 0 8 -	Equipment List													
6	(4)	G 7 1 A H S - F A 4 0 3 - W 6 0 8 -	Wiring Diagram													
7	(4)	G 7 1 A H S - F A 4 0 3 - S 6 0 8 -	Mandatory Spare List													
8	()															
9	()															

Customer : Bharat Heavy Electricals Limited.

PO.No : 144P143 Dt : 11.11.2014.

Project : MPPTCL Balaghat Badnawar Bhopal Chhegaon

Nagdah S/s & T/L.

APPROVED

Executive Engineer
O/o Executive Director (T&P)
M.P. Power Transmission Co. Ltd.
JABALPUR

Drg Codes	C = Construction Details; D = Design Details / Tech Details; E = Equipment List; L = Equipment Layout (Front, Rear); N = Name Plate / Rating Plate; R = Record of Drawings; S = Single Line Diagram; W = Wiring Drawing / Power & Control Circuit; Z = Any Drawing not covered by other code.			
Date	05.01.15	Descr:	SAP No.: 3004137812	
Prep.	AR		Item No: 100	
Ckd.	JR		Qty: 10 x	
Norm			Drg No.: (4)	
		Original/Replacement for/Replaced by:-	Sh 1	
			Name	
			G 7 1 A H S - F A 4 0 3 - R 6 0 8 -	
			1 Sh	

DESIGN DETAILS

1.0 General

- 1.1 Type Designation Siemens Make 3AP1 FI
- 1.2 Governing Standard IEC 62271-100 / IS 13118 (1991)

2.0 Technical Data

- 2.1 System Parameters
- .1 Rated Voltage kV 245 kV
- .2 Frequency Hz. 50
- .3 No. of Poles Three
- .4 Ambient Temperature Range °C -30 to +50

3.0 Operating Data

- 3.1 Type of Operating Mechanism Spring Energy Stored
- 3.2 Mechanism is electrically gang operated Yes
- 3.3 Operating Data
- .1 Closing mSec. Less than 100msec.
- .2 Breaking mSec. ≤ 60
- .3 Opening Time mSec. 28 ± 3
- .4 Arcing Time mSec. ≤ 20
- 3.4 Switching Data
- .1 Rated normal current A 3150
- .2 Rated short circuit breaking current kA 50
- .3 Rated short time current kA 50 (3sec.)
- .4 Rated short circuit making current kAp 100
- .5 First pole to clear factor 1.3
- .6 Out-of-phase breaking current kA 10
- .7 Rated line charging breaking current A 125
- .8 Rated cable charging breaking current A 250
- 3.5 Rated operating sequence O – 0.3sec – CO – 3min – CO

Customer: Bharat Heavy Electricals Limited.

PO. No : 144P143 Dtd : 11.11.2014.

Project : MPPTCL Balaghat Badnawar Bhopal Chhegaon
Nagdah S/s & T/L.

				Sales Ref.: 3004137812	Qty : 10 Nos.
			Date: 05.01.15	Description:- 245kV, 50kA, 3150A,SF6 CB	Sh. 1
			Prep : AR	Work :- 3AP1FI	3 Sh.
			Ckd : JR		
			Siemens Ltd.		
Issue	Remarks	Date	Name	Office	Details :- DESIGN DETAILS
Original/Replacement for/					
Replaced by :-				(4)GA71AHS-FA403-D608-	

APPROVED

Executive Engineer
O/o Executive Director (T&P)
M.P. Power Transmission Co. Ltd.
JABALPUR

4.0	Basic Insulation Level			
4.1	Rated power frequency withstand voltage (1min, 50 Hz)			
.1	Phase to earth	kV	460	
.2	Across the open breaker	kV	460	
.3	Between phases	kV	460	
4.2	Rated lighting impulse withstand voltage (1.2 / 50 micro sec.)			
.1	To earth	kVp	1050	
.2	Across the open breaker	kVp	1050	
.3	Between phases	kVp	1050	
4.3	Creepage distance			
.1	To earth	mm	25 mm/kV Minimum	
.2	Across the open breaker	mm	25mm/kV Minimum	
.3	Insulator type		Hollow porcelain	
5.0	Construction			
5.1	Clearance			
.1	To earth	mm	1900	
.2	Across the open breaker	mm	1900	
.3	Phase to phase	mm	4500	
5.2	Arc quenching Medium			
.1	Nominal pressure SF6 (@20°C)	bar	6.0 rel.	
.2	Signal loss of SF6 (@20°C)	bar	5.2 rel.	
.3	General lockout (@20°C)	bar	5.0 rel.	
.4	Quantity of SF6 gas required per pole of breaker	kg	6.0	
.5	Breaker Poles (3nos.) will be pre filled with transport pressure of 0.5 Bar gauge.	kg	3.6	
.6	Gas being supplied per breaker	kg	18	
5.3	Installation		Outdoor	
5.4	Approx. weight of breaker.	kg	3000 approx.	
6.0	Structures			
6.1	Material		Mild Steel	
6.2	Surface Treatment		Hot Dip Galavanised	

APPROVED

Executive Engineer
O/o Executive Director (T&P)
M.P. Power Transmission Co. Ltd.
JABALPUR

Customer: Bharat Heavy Electricals Limited.

PO. No : 144P143 Dtd : 11.11.2014.

Project : MPPTCL Balaghat Badnawar Bhopal Chhegaon
Nagdah S/s & T/L.

				Sales Ref.: 3004137812	Qty : 10 Nos.
			Date: 05.01.15	Description:- 245kV, 50kA, 3150A, SF6 CB	Sh. 2
			Prep : AR	Work :- 3AP1FI	3 Sh.
			Ckd : JR		
			Siemens Ltd.		
Issue	Remarks	Date	Name	Office	Details :- DESIGN DETAILS
Original/Replacement for/					
Replaced by :-				(4)GA71AHS-FA403-D608-	

S

7.0	Base Frame		
7.1	Material		Mild Steel
7.2	Surface Treatment		Hot Dip Galvanized
8.0	Control Cubicle		
8.1	Construction		
.1	Material of enclosure		CR Sheet Steel
.2	Thickness of sheet steel	mm	3.0
.3	Painting for control cubicle		Powder coated polyurethane
.4	Internal / External shade		697 as per IS5
.5	Degree of protection of enclosure		IP 55
.6	Padlocking facility for cubicle		Provided
.7	Glass window to see spring status		Provided on control cubicle
8.2	Wiring		
.1	Control wiring		
.1	Size		2.5 sq. mm, flexible copper conductor
.2	Insulation		Grey 1100V Grade
.2	Earth Wiring		
.1	Size		2.5 sq. mm, flexible copper conductor
.2	Insulation		Yellow Green 600V Grade
8.3	Control Terminals		
.1	Type		Stud type
.2	Make		Connectwell / Elmex
.3	Size	mm ²	2.5
.4	Spare unwired terminal	%	20 Nos.
8.4	Auxiliary Supply		

Circuit	Rated Voltage	Source	Range
Spring Charging Motor	240V AC	External	85 – 110%
Closing Coil (300W)	220V DC	External	85 – 110%
Trip Coil – 1 & 2 (1300W)	220V DC	External	70 – 110%
Space Heater / Socket / Illumination	240V AC	External	--

APPROVED
Executive Engineer
O/o Executive Director (T&P)
M.P. Power Transmission Co. Ltd.
JABALPUR

Customer: Bharat Heavy Electricals Limited.

PO. No : 144P143 Dtd : 11.11.2014.

Project : MPPTCL Balaghat Badnawar Bhopal Chhegaon
Nagdah S/s & T/L.

				Sales Ref.: 3004137812		Qty : 10 Nos.		
			Date: 05.01.15	Description:- 245kV, 50kA, 3150A, SF6 CB Work :- 3AP1FI Details :- DESIGN DETAILS			Sh. 3 3 Sh.	
			Prep : AR					
			Ckd : JR					
			Siemens Ltd.					
Issue	Remarks	Date	Name	Office				
Original/Replacement for/ Replaced by :-					(4)GA71AHS-FA403-D608-			

List of Mandatory Spares:

- | | |
|---|----------|
| 1. Complete Pole without Mechanism | – 2 Nos. |
| 2. Trip Coil | – 20 Nos |
| 3. Closing Coil | – 10 Nos |
| 4. SF6 gas Density Monitor | – 6 Nos |
| 5. Spring Charging Motor | – 3 Nos. |
| 6. Spring Charging Motor | – 3 Nos. |
| 7. Limit Switch | – 3 Nos. |
| 8. 20% additional SF6 gas in separate Cylinder – Total 36 kgs for 10 breakers i.e. 2 Cylinders (18 kgs each.) | |

APPROVED



 Executive Engineer
 O/o Executive Director (T&P)
 M.P. Power Transmission Co. Ltd.
 JABALPUR

Customer: Bharat Heavy Electricals Limited.						
PO. No : 144P143 Dtd: 11.11.2014.						
Project : MPPTCL Balaghat Badnawar Bhopal Chhegaon Nagdah S/s & T/L.						
				Sales Ref.: 3004137812	Qty : 10 Nos.	
			Date: 05.01.15	Description:- 245kV, 50kA, 3150A, SF6 CB	Sh. 1	
			Prep : AR			
			Ckd : JR			
			Siemens Ltd.			
Issue	Remarks	Date	Name	Office	Work :- 3AP1FI	1 Sh.
Original/Replacement for/ Replaced by :-					Details :- Mandatory Spare List	
					(4)GA71AHS-FA403-S608-	

1) Poles - 3nos.
2) Spring op.
3) Marshalling

DWG_ADD 4) Support
5) Foundation
6) Interpole

The reproduction, transmission or use of this document or its contents is not permitted without express written authority from the copyright owner. In the event of any unauthorized reproduction, the copyright owner shall be liable for any damages suffered by the copyright owner.

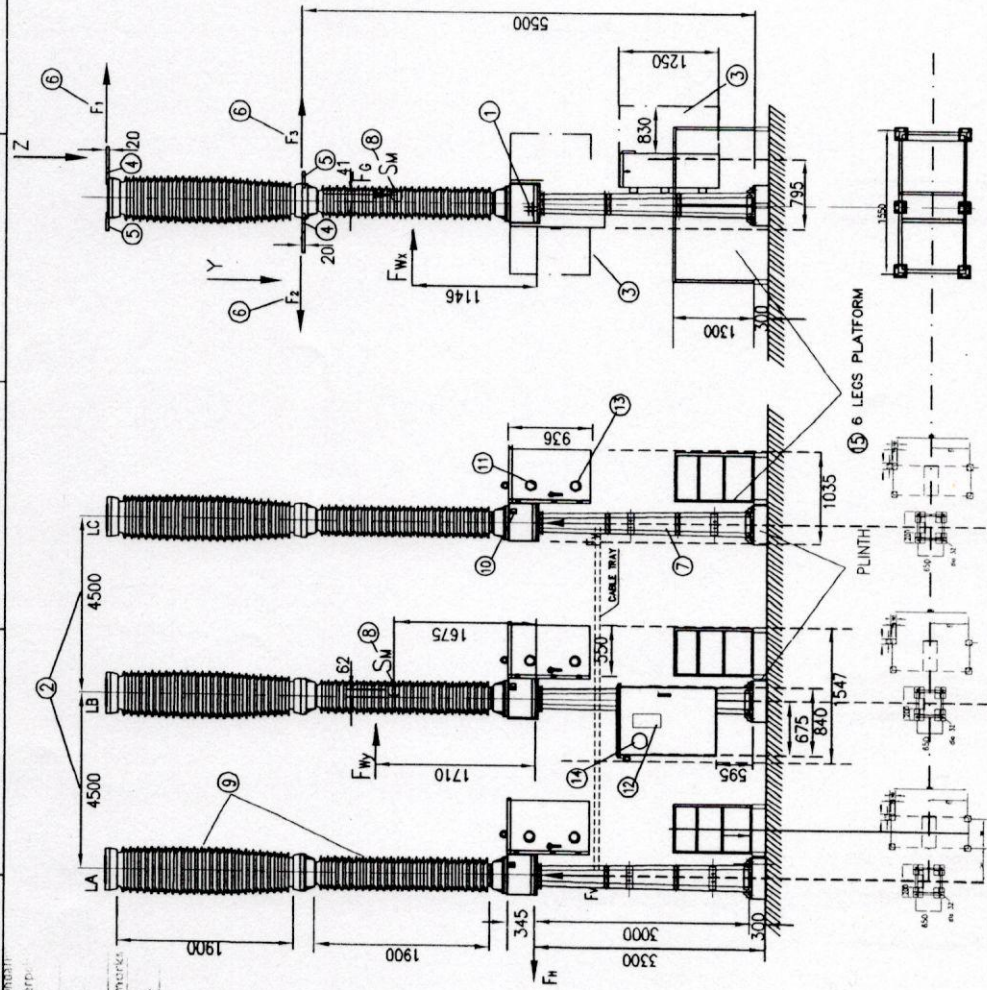

BILL OF MATERIAL

- 1) Poles - 3nos.
- 2) Spring operating mechanism with control panel - 3nos.
- 3) Marshalling Box fixed with Y pole - 1no.
- 4) Support Structure - 3nos.
- 5) Foundation Bolts - 12nos. (nos./Pole)
- 6) Interpole cable - unarmoured, 2.5 sqmm

operating loads per pillar
vertical FV : +23 000 N (up)
-28 000 N (down)
Horizontal FH : ~ 6 500 N (in Y direction)

Loads per pole (LB)				
FG	Fw	Fwy	Fstat	Fstat-dyn
Weight loads	Wind loads, at a wind speed of 55 m/s		Tensile load at terminal	
9.2 kN	5.2 kN	3.87 kN	2.0 kN	4.0 kN

Customer : Bharat Heavy Electricals Limited.
PO No : 146/143 DT: 11.11.2014
Project : MPPTCL Balinghat Badmash Bhopal Chhigason
Nagdah Sh & TIL

Original/Replacement for/Replaced by :-

Siemens Ltd.
AURANGABAD

Deser : 245KW, 500A(3S), 3150A, SF6 CB
Work : 3AP1FI
Details : STANDARD GA DRAWING

Sales Order: 3004.137812
Line Item: 100

Qty. : 10x
All dimensions are in MM
Drg. No:- (4) C71AHS-FA403-2608-
Sh. 1
2 Sh.

NOT TO SCALE

COMPLETE WEIGHT OF THE CB WITHOUT STRUCTURE = 3000 KG APPROX.
WEIGHT OF INDIVIDUAL POLE WITH CONTROL PANEL = 920 KG APPROX.
TOTAL WEIGHT OF THE STRUCTURE = 750 KG APPROX.
WEIGHT OF THE INDIVIDUAL STRUCTURE = 300 KG APPROX.

- 1) HOLES FOR EARTHING TERMINALS
- 2) POLE TO POLE DISTANCE - 4500MM
- 3) CLEARANCE REQUIRED FOR CHECKING AND DISMANTLING
- 4) ALUMINIUM ALLOY TERMINAL PLATES WITH HOLES,
- 5) TERMINAL PLATES TO THE OPPOSITE MOUNTING AS REQUIRED (THICKNESS 26MM)
- 6) PERMISSIBLE TENSILE LOAD AT TERMINALS USING THE FOLLOWING FORMULAE,
THE DATA MUST BE OBSERVED.

$$F_1 \leq F; \quad F_2 < F_1 \times 1.94; \quad F = F_p \times 0.53 \times F$$

F1 - Terminal Load at TOP
F2 - Terminal Load at Bottom- Opposite F1
F3 - Terminal Load at Bottom - Same Direction of F1
F - GCB Limiting Load values for Static & Dynamic Condition

- 7) SUPPORT STRUCTURE
- 8) CENTRE OF GRAVITY
- 9) PORCELAIN INSULATOR 25mm/kV ABIL/MIL/IEC/PRATHAMESH MAKE
- 10) MECHANICAL "ON/OFF" INDICATION
- 11) PRESSURE GAUGE
- 12) RATING PLATE
- 13) VIEWING WINDOW FOR SPRING CHARGING STATUS.
- 14) WINDOW FOR VIEWING INDICATING LAMP
- 15) 6 LEGS PLATFORM

APPROVED

Executive Engineer
O/o Executive Director (T&P)
M.F. Power Transmission Co. Ltd.
JABALPUR

Issue

Remarks

Date

Name

Norm

Ckd

Prep

Date

PO No

Customer

Project

Original/Replacement for/Replaced by :-

Details : STANDARD GA DRAWING

Work : 3AP1FI

Deser : 245KW, 500A(3S), 3150A, SF6 CB

Sales Order: 3004.137812

Line Item: 100


Qty. : 10x

All dimensions are in MM

Drg. No:- (4) C71AHS-FA403-2608-


Sh. 1

2 Sh.

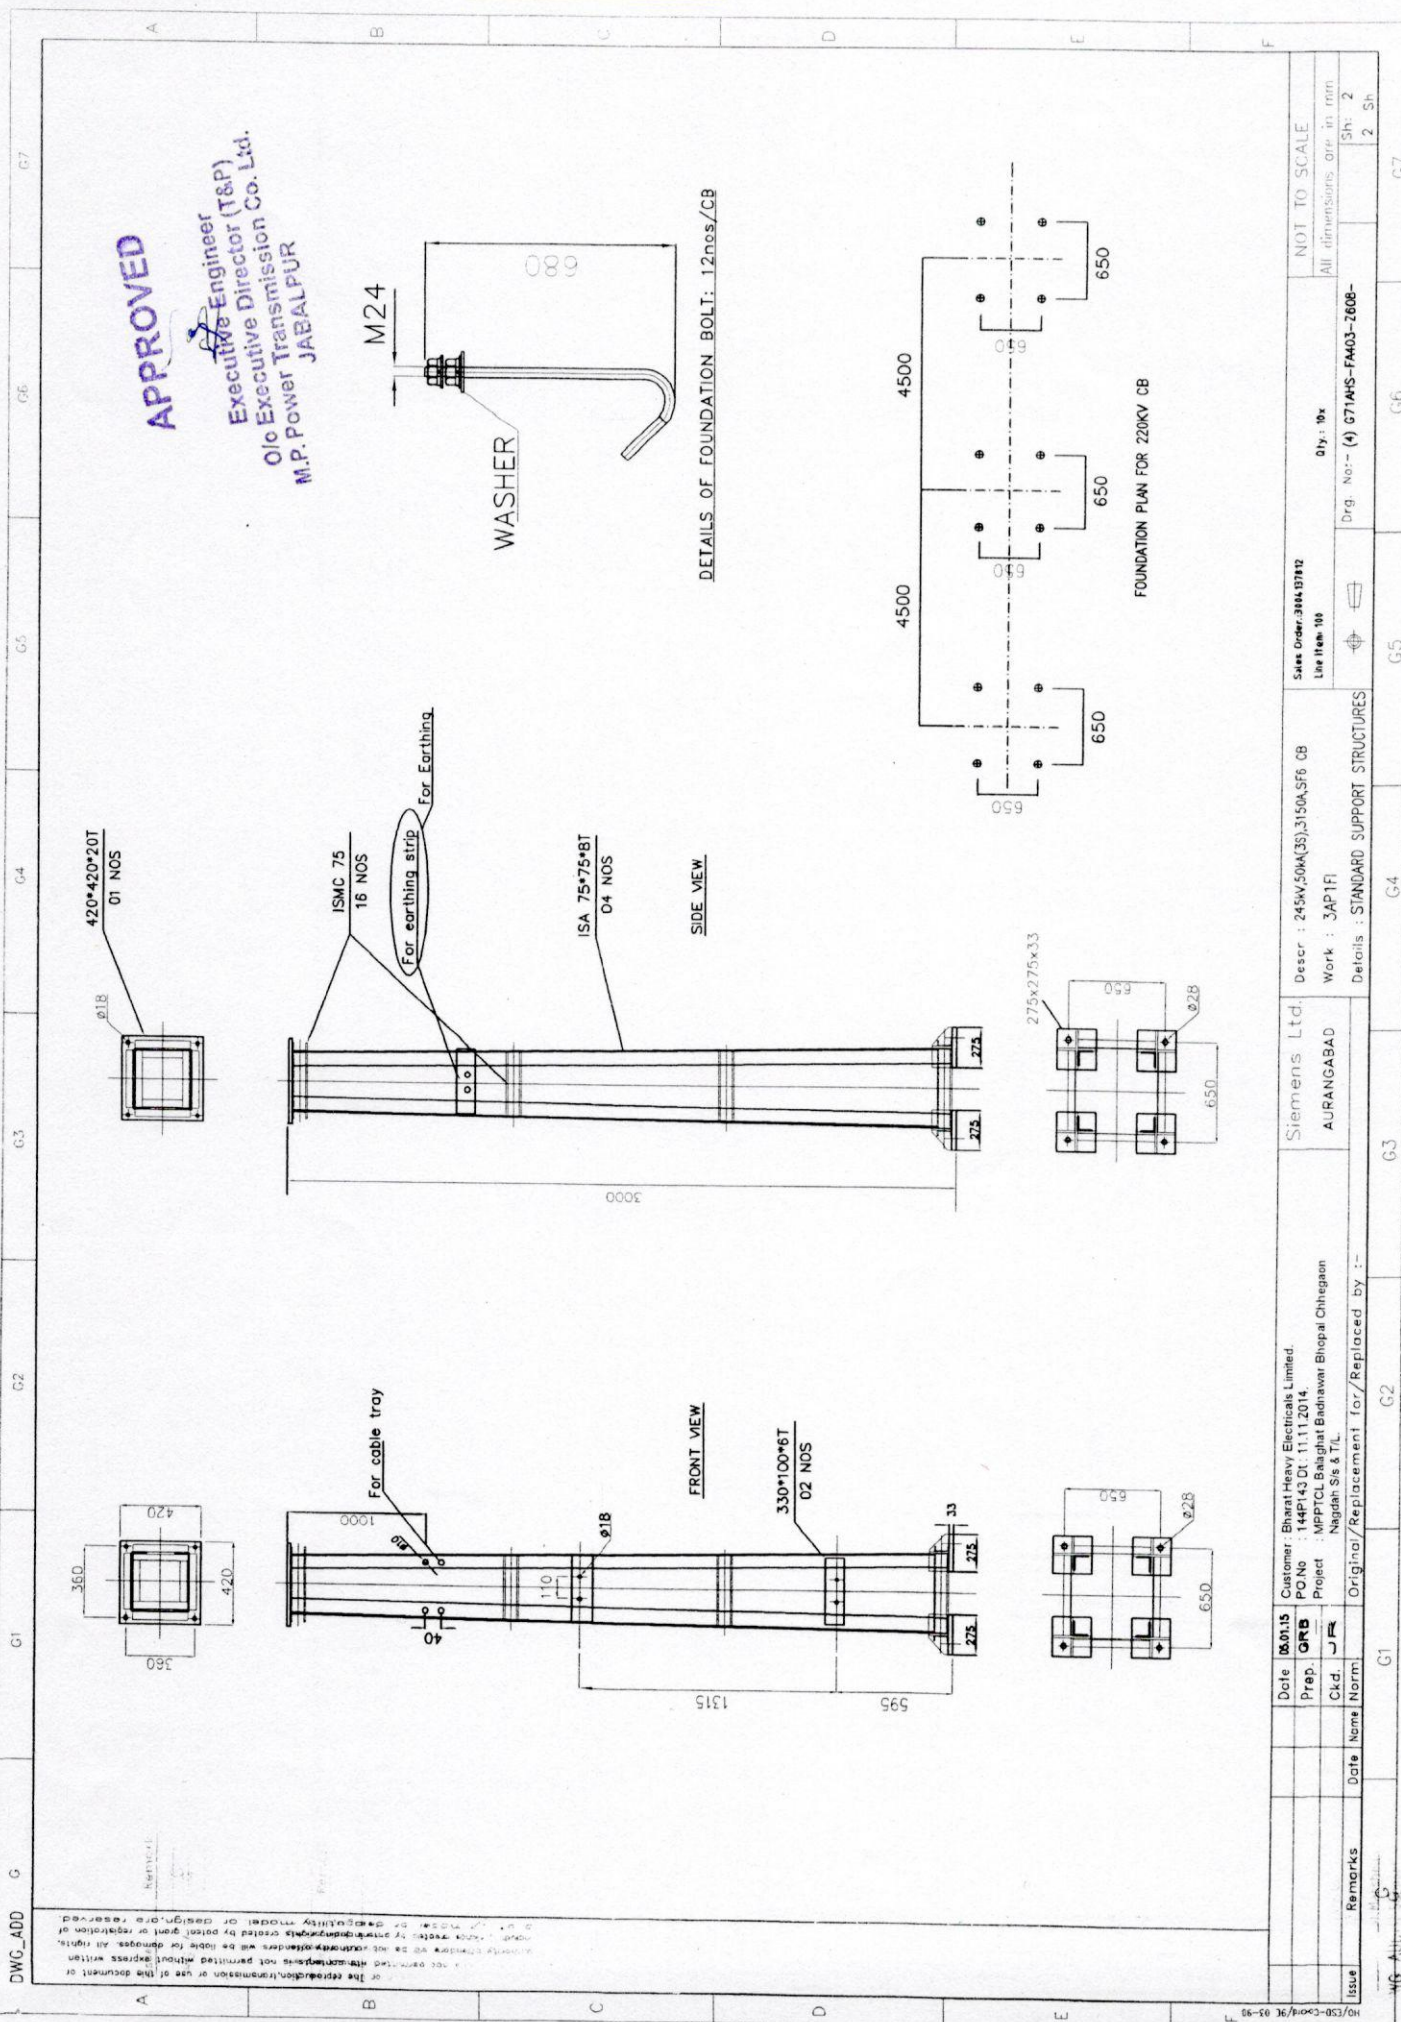

Issue	Remarks	Date	Name	Norm	Cl'd	Prep.	Date	18.01.15	Customer: Bharti Heavy Electricals Limited. PO No. 144P143 DI, 11.11.2014. Project: MPPTCL Balaghat Badhwar Bhopal Chhagan Nagari Ss & TL	Siemens Ltd. AURANGABAD	Descr : 245W,50A(3S),3150A,SF6 CB Work : 3AP1FI	Sales Order:3004137912 Line Item:100	Qty: 10x Drg. No:- (4) 671MS-FA403-2608-	NOT TO SCALE All dimensions are in mm	Sh: 2 2 Sh
-------	---------	------	------	------	------	-------	------	----------	--	----------------------------	--	---	---	--	---------------

CONTROL UNIT FRONT VIEW

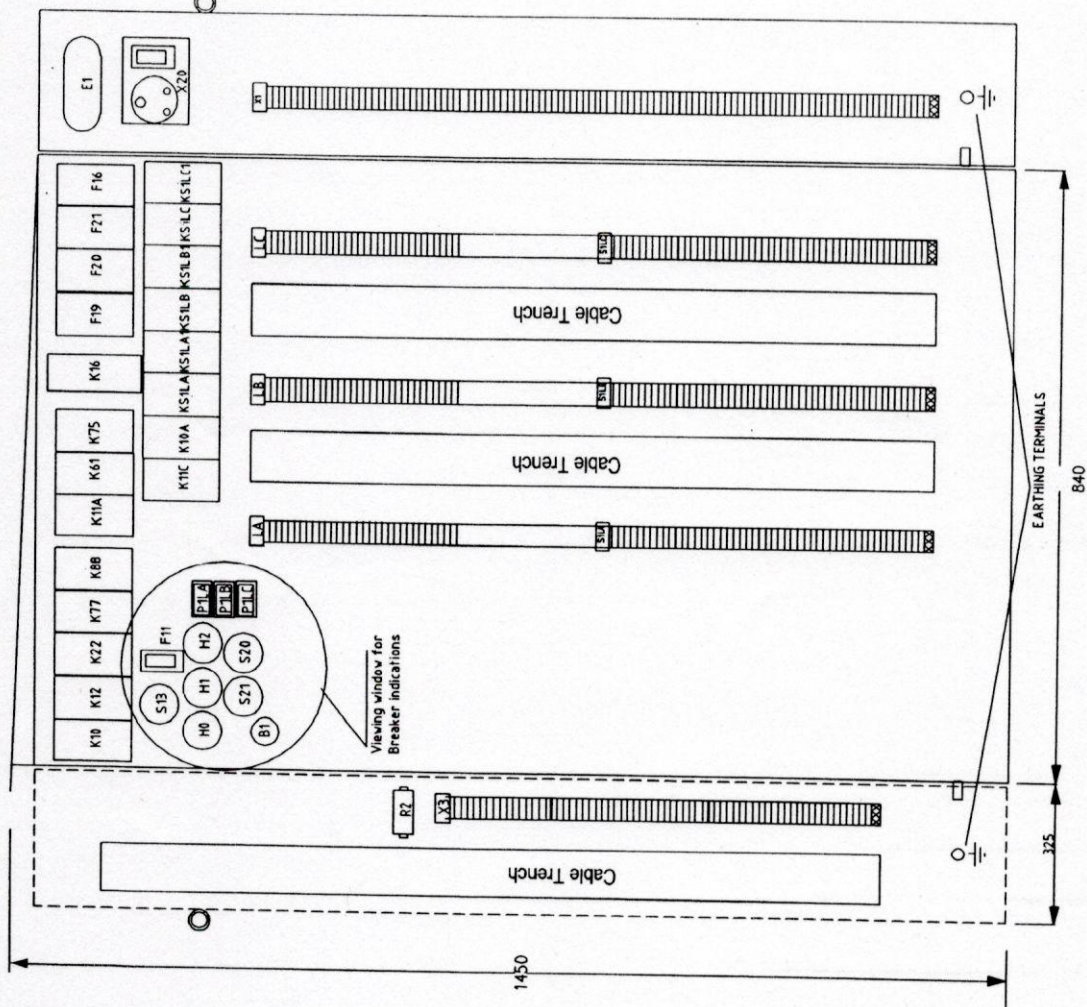

APPROVED

Executive Engineer
O/o Executive Director (T&P)
M.P. Power Transmission Co. Ltd.
JABALPUR

R2: SPACE HEATER

B1: THERMOSTAT

K10, K11A: AUXILIARY CONTACTOR FOR GENERAL LOCKOUT

K75: AUXILIARY CONTACTORS FOR ANTI-PUMPING

K12: AUXILIARY CONTACTOR FOR DC CHANGEDOVER

K11A/B/C: AUXILIARY CONTACTOR FOR TRIP SYNCHRONIZING EACH PHASE

K16: ON DELAY TIMER ENFORCED TRIPPLE POLE OPERATION

K77: AUXILIARY CONTACTOR FOR MANUAL TRIP

K61: AUXILIARY CONTACTOR FOR TRIP CIRCUIT

S21, S20: OPENGREEN/CLOSE(RED) PUSH BUTTONS

F19, F21: MCB FOR DC SUPPLY

F20: 3P-N MCB AC SUPPLY

F16: MCB FOR SPRING CHARGING MOTOR

F11: ON/OFF SWITCH FOR ILLUMINATION

H0/H1/H2: OFF(GREEN)/ON(RED)/SPRING(BLUE) CHARGING INDICATING LAMP

S20: LOCAL/REMOTE SWITCH

X20: PLUG SOCKET WITH SWITCH

E1: PANEL LAMP

P1A/P1B/P1C: OPERATIONAL COUNTERS (ELECTRICAL)

L.A, L.B, L.C: TERMINALS FOR INERPOLE WIRING

KS1A, KS1B, KS1C, KS1D, KS1E, KS1F, KS1G, KS1H, KS1I, KS1J, KS1K, KS1L, KS1M, KS1N, KS1O, KS1P, KS1Q, KS1R, KS1S, KS1T, KS1U, KS1V, KS1W, KS1X, KS1Y, KS1Z, KS1AA, KS1AB, KS1AC, KS1AD, KS1AE, KS1AF, KS1AG, KS1AH, KS1AI, KS1AJ, KS1AK, KS1AL, KS1AM, KS1AN, KS1AO, KS1AP, KS1AQ, KS1AR, KS1AS, KS1AT, KS1AU, KS1AV, KS1AW, KS1AX, KS1AY, KS1AZ, KS1BA, KS1BB, KS1BC, KS1BD, KS1BE, KS1BF, KS1BG, KS1BH, KS1BI, KS1BJ, KS1BK, KS1BL, KS1BM, KS1BN, KS1BO, KS1BP, KS1BQ, KS1BR, KS1BS, KS1BT, KS1BU, KS1BV, KS1BW, KS1BX, KS1BY, KS1BZ, KS1CA, KS1CB, KS1CC, KS1CD, KS1CE, KS1CF, KS1CG, KS1CH, KS1CI, KS1CJ, KS1CK, KS1CL, KS1CM, KS1CN, KS1CO, KS1CP, KS1CQ, KS1CR, KS1CS, KS1CT, KS1CU, KS1CV, KS1CW, KS1CX, KS1CY, KS1CZ, KS1DA, KS1DB, KS1DC, KS1DD, KS1DE, KS1DF, KS1DG, KS1DH, KS1DI, KS1DJ, KS1DK, KS1DL, KS1DM, KS1DN, KS1DO, KS1DP, KS1DQ, KS1DR, KS1DS, KS1DT, KS1DU, KS1DV, KS1DW, KS1DX, KS1DY, KS1DZ, KS1EA, KS1EB, KS1EC, KS1ED, KS1EE, KS1EF, KS1EG, KS1EH, KS1EI, KS1EJ, KS1EK, KS1EL, KS1EM, KS1EN, KS1EO, KS1EP, KS1EQ, KS1ER, KS1ES, KS1ET, KS1EU, KS1EV, KS1EW, KS1EX, KS1EY, KS1EZ, KS1FA, KS1FB, KS1FC, KS1FD, KS1FE, KS1FF, KS1FG, KS1FH, KS1FI, KS1FJ, KS1FK, KS1FL, KS1FM, KS1FN, KS1FO, KS1FP, KS1FQ, KS1FR, KS1FS, KS1FT, KS1FU, KS1FV, KS1FW, KS1FX, KS1FY, KS1FZ, KS1GA, KS1GB, KS1GC, KS1GD, KS1GE, KS1GF, KS1GG, KS1GH, KS1GI, KS1GJ, KS1GK, KS1GL, KS1GM, KS1GN, KS1GO, KS1GP, KS1GQ, KS1GR, KS1GS, KS1GT, KS1GU, KS1GV, KS1GW, KS1GX, KS1GY, KS1GZ, KS1HA, KS1HB, KS1HC, KS1HD, KS1HE, KS1HF, KS1HG, KS1HH, KS1HI, KS1HJ, KS1HK, KS1HL, KS1HM, KS1HN, KS1HO, KS1HP, KS1HQ, KS1HR, KS1HS, KS1HT, KS1HU, KS1HV, KS1HW, KS1HX, KS1HY, KS1HZ, KS1IA, KS1IB, KS1IC, KS1ID, KS1IE, KS1IF, KS1IG, KS1IH, KS1II, KS1IJ, KS1IK, KS1IL, KS1IM, KS1IN, KS1IO, KS1IP, KS1IQ, KS1IR, KS1IS, KS1IT, KS1IU, KS1IV, KS1IW, KS1IX, KS1IY, KS1IZ, KS1JA, KS1JB, KS1JC, KS1JD, KS1JE, KS1JF, KS1JG, KS1JH, KS1JI, KS1JJ, KS1JK, KS1JL, KS1JM, KS1JN, KS1JO, KS1JP, KS1JQ, KS1JR, KS1JS, KS1JT, KS1JU, KS1JV, KS1JW, KS1JX, KS1JY, KS1JZ, KS1KA, KS1KB, KS1KC, KS1KD, KS1KE, KS1KF, KS1KG, KS1KH, KS1KI, KS1KJ, KS1KK, KS1KL, KS1KM, KS1KN, KS1KO, KS1KP, KS1KQ, KS1KR, KS1KS, KS1KT, KS1KU, KS1KV, KS1KW, KS1KX, KS1KY, KS1KZ, KS1LA, KS1LB, KS1LC, KS1LD, KS1LE, KS1LF, KS1LG, KS1LH, KS1LI, KS1LJ, KS1LK, KS1LM, KS1LN, KS1LO, KS1LP, KS1LQ, KS1LR, KS1LS, KS1LT, KS1LU, KS1LV, KS1LW, KS1LX, KS1LY, KS1LZ, KS1MA, KS1MB, KS1MC, KS1MD, KS1ME, KS1MF, KS1MG, KS1MH, KS1MI, KS1MJ, KS1MK, KS1ML, KS1MM, KS1MN, KS1MO, KS1MP, KS1MQ, KS1MR, KS1MS, KS1MT, KS1MU, KS1MV, KS1MW, KS1MX, KS1MY, KS1MZ, KS1NA, KS1NB, KS1NC, KS1ND, KS1NE, KS1NF, KS1NG, KS1NH, KS1NI, KS1NJ, KS1NK, KS1NL, KS1NM, KS1NN, KS1NO, KS1NP, KS1NQ, KS1NR, KS1NS, KS1NT, KS1NU, KS1NV, KS1NW, KS1NX, KS1NY, KS1NZ, KS1OA, KS1OB, KS1OC, KS1OD, KS1OE, KS1OF, KS1OG, KS1OH, KS1OI, KS1OJ, KS1OK, KS1OL, KS1OM, KS1ON, KS1OO, KS1OP, KS1OQ, KS1OR, KS1OS, KS1OT, KS1OU, KS1OV, KS1OW, KS1OX, KS1OY, KS1OZ, KS1PA, KS1PB, KS1PC, KS1PD, KS1PE, KS1PF, KS1PG, KS1PH, KS1PI, KS1PJ, KS1PK, KS1PL, KS1PM, KS1PN, KS1PO, KS1PP, KS1PQ, KS1PR, KS1PS, KS1PT, KS1PU, KS1PV, KS1PW, KS1PX, KS1PY, KS1PZ, KS1QA, KS1QB, KS1QC, KS1QD, KS1QE, KS1QF, KS1QG, KS1QH, KS1QI, KS1QJ, KS1QK, KS1QL, KS1QM, KS1QN, KS1QO, KS1QP, KS1QQ, KS1QR, KS1QS, KS1QT, KS1QU, KS1QV, KS1QW, KS1QX, KS1QY, KS1QZ, KS1RA, KS1RB, KS1RC, KS1RD, KS1RE, KS1RF, KS1RG, KS1RH, KS1RI, KS1RJ, KS1RK, KS1RL, KS1RM, KS1RN, KS1RO, KS1RP, KS1RQ, KS1RR, KS1RS, KS1RT, KS1RU, KS1RV, KS1RW, KS1RX, KS1RY, KS1RZ, KS1SA, KS1SB, KS1SC, KS1SD, KS1SE, KS1SF, KS1SG, KS1SH, KS1SI, KS1SJ, KS1SK, KS1SL, KS1SM, KS1SN, KS1SO, KS1SP, KS1SQ, KS1SR, KS1SS, KS1ST, KS1SU, KS1SV, KS1SW, KS1SX, KS1SY, KS1SZ, KS1TA, KS1TB, KS1TC, KS1TD, KS1TE, KS1TF, KS1TG, KS1TH, KS1TI, KS1TJ, KS1TK, KS1TL, KS1TM, KS1TN, KS1TO, KS1TP, KS1TQ, KS1TR, KS1TS, KS1TT, KS1TU, KS1TV, KS1TW, KS1TX, KS1TY, KS1TZ, KS1UA, KS1UB, KS1UC, KS1UD, KS1UE, KS1UF, KS1UG, KS1UH, KS1UI, KS1UJ, KS1UK, KS1UL, KS1UM, KS1UN, KS1UO, KS1UP, KS1UQ, KS1UR, KS1US, KS1UT, KS1UU, KS1UV, KS1UW, KS1UX, KS1UY, KS1UZ, KS1VA, KS1VB, KS1VC, KS1VD, KS1VE, KS1VF, KS1VG, KS1VH, KS1VI, KS1VJ, KS1VK, KS1VL, KS1VM, KS1VN, KS1VO, KS1VP, KS1VQ, KS1VR, KS1VS, KS1VT, KS1VU, KS1VV, KS1VW, KS1VX, KS1VY, KS1VZ, KS1WA, KS1WB, KS1WC, KS1WD, KS1WE, KS1WF, KS1WG, KS1WH, KS1WI, KS1WJ, KS1WK, KS1WL, KS1WM, KS1WN, KS1WO, KS1WP, KS1WQ, KS1WR, KS1WS, KS1WT, KS1WU, KS1WV, KS1WW, KS1WX, KS1WY, KS1WZ, KS1XA, KS1XB, KS1XC, KS1XD, KS1XE, KS1XF, KS1XG, KS1XH, KS1XI, KS1XJ, KS1XK, KS1XL, KS1XM, KS1XN, KS1XO, KS1XP, KS1XQ, KS1XR, KS1XS, KS1XT, KS1XU, KS1XV, KS1XW, KS1XX, KS1XY, KS1XZ, KS1YA, KS1YB, KS1YC, KS1YD, KS1YE, KS1YF, KS1YG, KS1YH, KS1YI, KS1YJ, KS1YK, KS1YL, KS1YM, KS1YN, KS1YO, KS1YP, KS1YQ, KS1YR, KS1YS, KS1YT, KS1YU, KS1YV, KS1YW, KS1YX, KS1YY, KS1YZ, KS1ZA, KS1ZB, KS1ZC, KS1ZD, KS1ZE, KS1ZF, KS1ZG, KS1ZH, KS1ZI, KS1ZJ, KS1ZK, KS1ZL, KS1ZM, KS1ZN, KS1ZO, KS1ZP, KS1ZQ, KS1ZR, KS1ZS, KS1ZT, KS1ZU, KS1ZV, KS1ZW, KS1ZX, KS1ZY, KS1ZZ

NOTE: Degree of protection - IP55 as per IS 13947

Color Shade Internal/External - 657 as per IS 5

POSITIONING OF EQUIPMENTS MAY CHANGE DURING MANUFACTURING

Descr : 25KV, 50KA, 315KA-SF6-B

Work : 3KPF

Details : MARSHALLING_BOX

Siemens Ltd.

AURANGABAD

Customer: Bharat Heavy Electricals Limited

PO No: 144P/43 DT: 11.11.2014

Project: MPTCL Bhadrachal Bhatnagar Bhopal Chhiggaon

Date: 05.01.15

Prep: AR

Ckd: JFR

Date: 05.01.15

Name: Norm

Original/Replacement for/Replaced by :-

Remarks

Sh. 1

Sh. 3

Sh. 1

Sh. 3

Sh. 1

Sh. 1

Sh. 3

Sh. 1

OPERATING MECHANISM COMPARTMENT POLE LA, LB, LC

FRONT VIEW

BACK VIEW

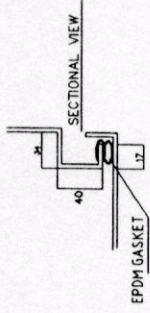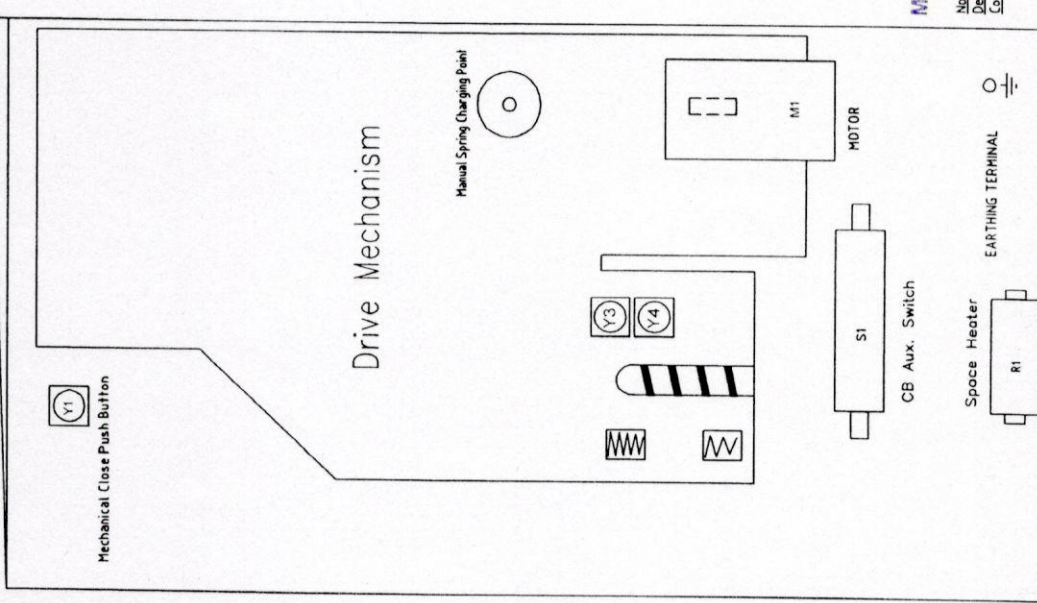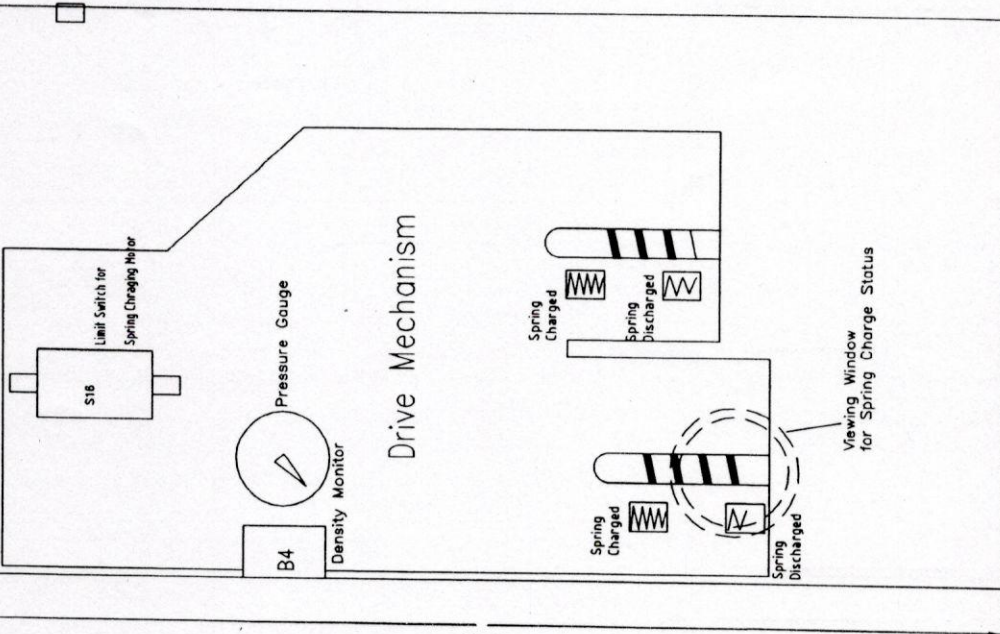

APPROVED

Executive Engineer
O/o Executive Director (T&P)
M.P. Power Transmission Co. Ltd.
JABALPUR

NOTE:
Degree of protection - IP55 as per IS 13947
Grip Shade Internal : 697 as per ISS

Customer: Bharat Heavy Electricals Limited.
PO No: 14PT/43 D/T: 11.11.2014.
Project: MPPTCL Bilaspur Badinarwar Bilaspur Chhigagon
Nagda S&S & TIL

Descr : 245KV, 50KA, 3150A-SF6-CB
Work : SAPIF
Details : CONTROL PANEL LAYOUT

Sales Order: 3004/37812
Line Item: 00

Qty: 10x
Sh. 2
3 Sh.

Siemens Ltd.
AURANGABAD

Date: 05.01.15
Prep: A/R
Ckd: J/R
Date: 02/01/15
Norm: Norm
Original/Replacement for/Replaced by :-

1 2 3 4 5 6 7 8

1 2 3 4 5 6 7 8


1 2 3 4 5 6 7 8

1 2 3 4 5 6 7 8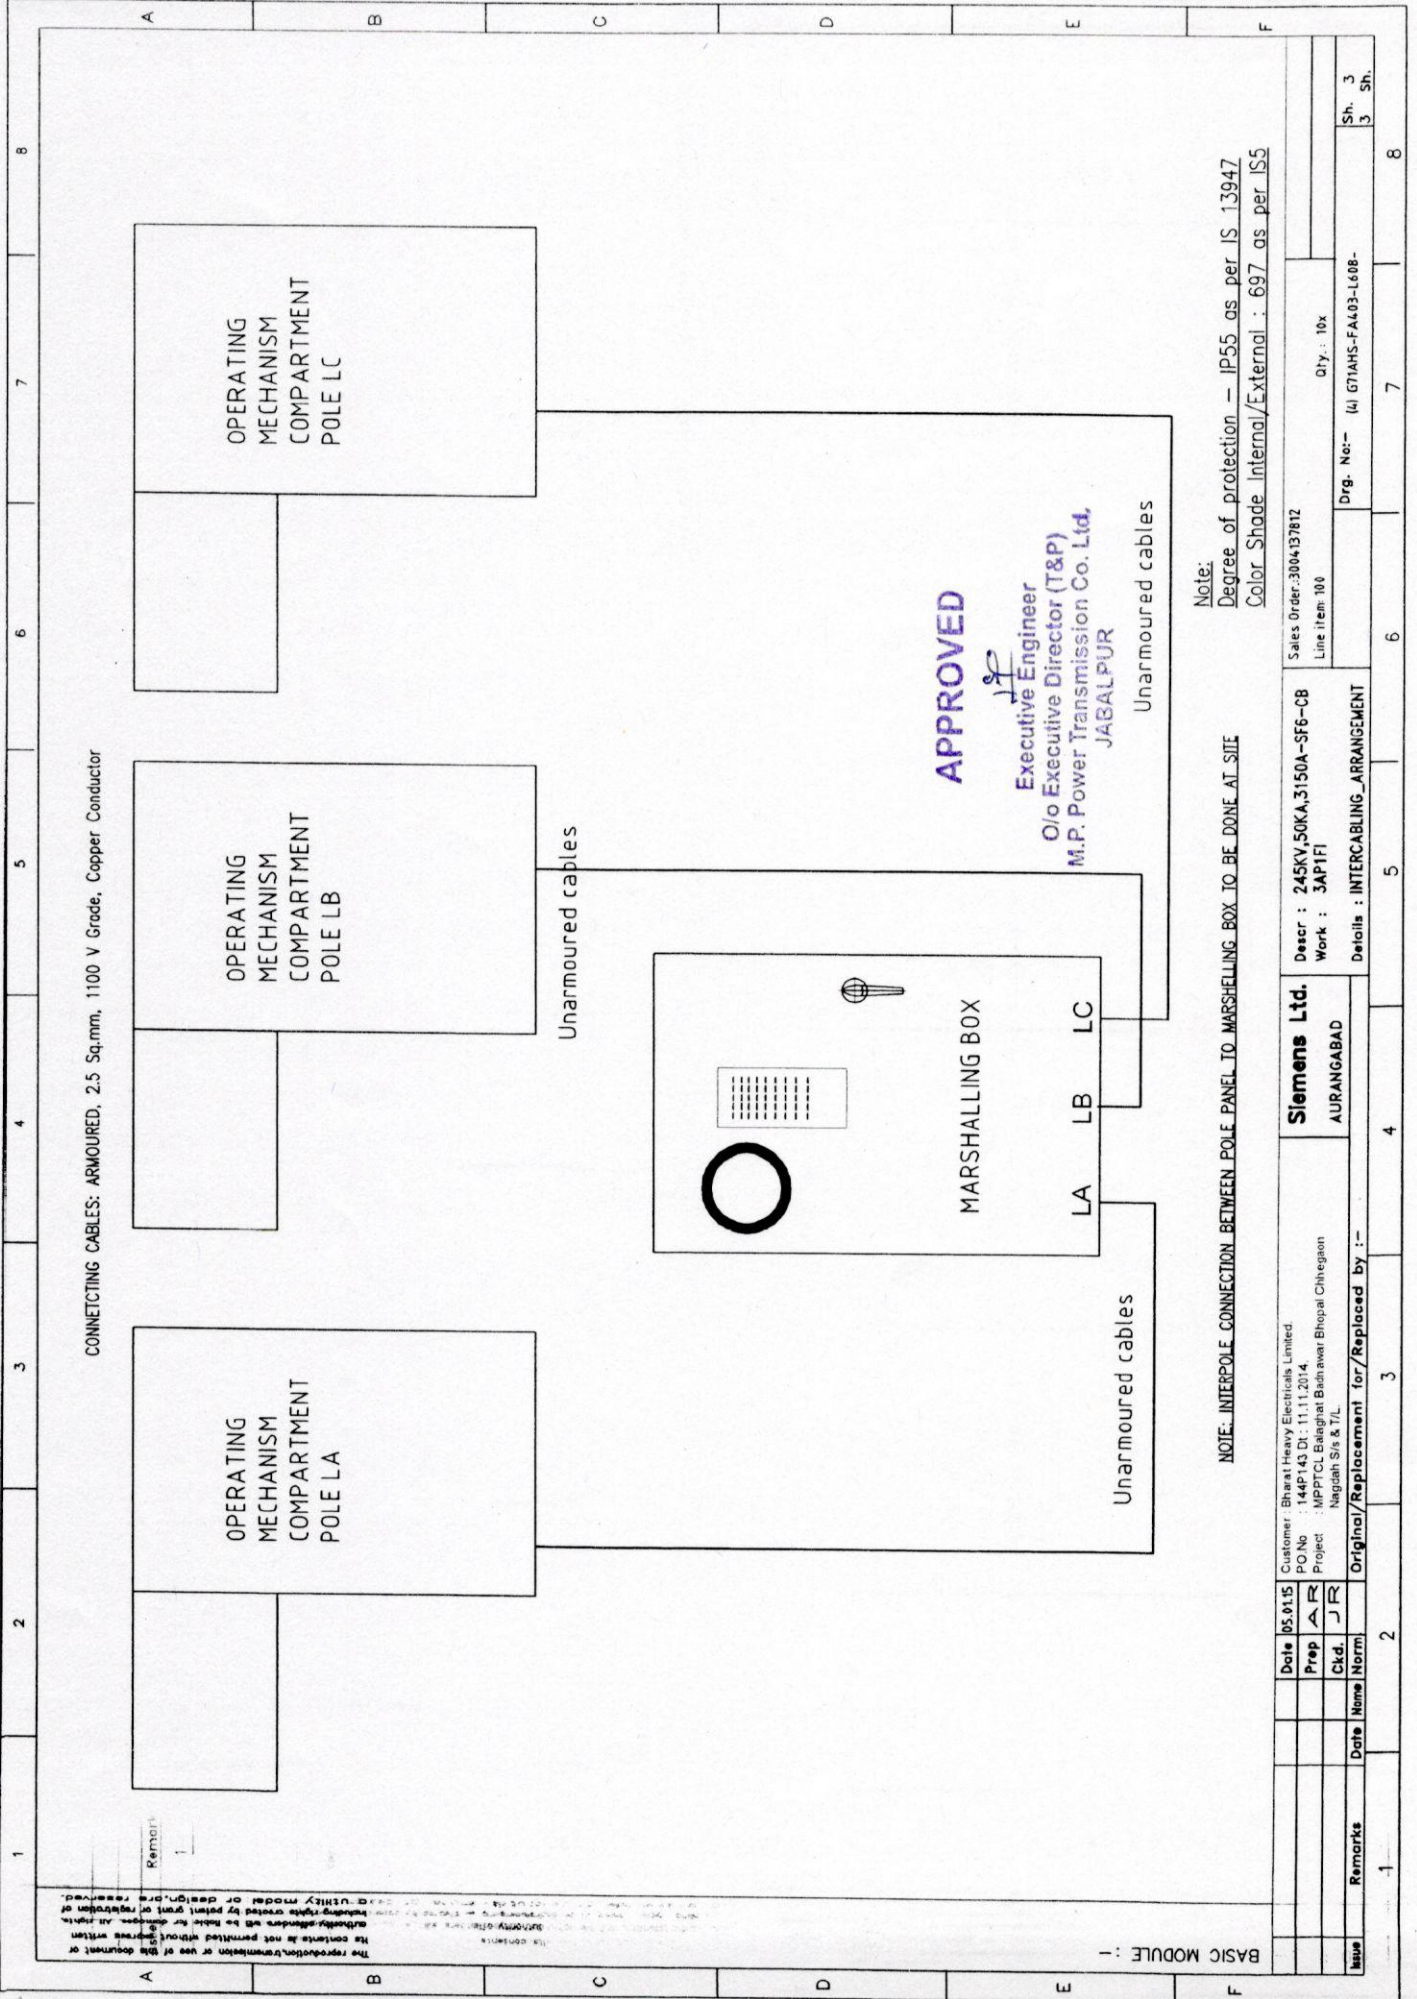

NOTE: INTERPOLE CONNECTION BETWEEN POLE PANEL TO MARCELLING BOX TO BE DONE AT SITE

Note:
Degree of protection — IP55 as per IS 13947
Color Shade Internal/External : 697 as per IS5

Sales Order: 3004/137812		Line item 100		Qty: 10x		Sh. 3	
Descr : 24KV, 50KA, 3150A-SF6-CB		Work : 3AP1FI		Drig. No:- (u) 671AHS-FA403-L608-		Sh. 3	
Details : INTERCABLING ARRANGEMENT							
Customer: Bharat Heavy Electricals Limited		Date: 05.01.15		Prep: AR		Ckd: JR	
PO No: 144P143 Dt: 11.11.2014		Project: MPPTCL Balaghat Buhawar Bhopal Chhlegoon		Original/Replacement for/Replaced by :-			
Project: Nagdah S/s & T/L		Date: 05.01.15		Prep: AR		Ckd: JR	
Remarks		Date: 05.01.15		Prep: AR		Ckd: JR	
Issue		Date: 05.01.15		Prep: AR		Ckd: JR	


BASIC MODULE :-

The reproduction, transmission or use of this document or its contents is not permitted without written permission. Its contents are not to be distributed, copied, or otherwise used in any form without the prior written permission of the copyright owner. The copyright owner shall not be liable for any damages or losses arising from the use of this document.

1. Die Bedeutung der Sprache
 2. Die Entwicklung der Sprache
 3. Die Funktion der Sprache
 4. Die Struktur der Sprache
 5. Die Semantik der Sprache
 6. Die Pragmatik der Sprache
 7. Die Linguistik der Sprache
 8. Die Literatur der Sprache
 9. Die Philosophie der Sprache
 10. Die Psychologie der Sprache
 11. Die Soziologie der Sprache
 12. Die Anthropologie der Sprache
 13. Die Biologie der Sprache
 14. Die Geographie der Sprache
 15. Die Historie der Sprache
 16. Die Ethnologie der Sprache
 17. Die Religionswissenschaft der Sprache
 18. Die Kunst der Sprache
 19. Die Pädagogik der Sprache
 20. Die Medizin der Sprache
 21. Die Rechtswissenschaft der Sprache
 22. Die Politik der Sprache
 23. Die Ökonomie der Sprache
 24. Die Soziologie der Sprache
 25. Die Anthropologie der Sprache
 26. Die Biologie der Sprache
 27. Die Geographie der Sprache
 28. Die Historie der Sprache
 29. Die Ethnologie der Sprache
 30. Die Religionswissenschaft der Sprache
 31. Die Kunst der Sprache
 32. Die Pädagogik der Sprache
 33. Die Medizin der Sprache
 34. Die Rechtswissenschaft der Sprache
 35. Die Politik der Sprache
 36. Die Ökonomie der Sprache
 37. Die Soziologie der Sprache
 38. Die Anthropologie der Sprache
 39. Die Biologie der Sprache
 40. Die Geographie der Sprache
 41. Die Historie der Sprache
 42. Die Ethnologie der Sprache
 43. Die Religionswissenschaft der Sprache
 44. Die Kunst der Sprache
 45. Die Pädagogik der Sprache
 46. Die Medizin der Sprache
 47. Die Rechtswissenschaft der Sprache
 48. Die Politik der Sprache
 49. Die Ökonomie der Sprache
 50. Die Soziologie der Sprache
 51. Die Anthropologie der Sprache
 52. Die Biologie der Sprache
 53. Die Geographie der Sprache
 54. Die Historie der Sprache
 55. Die Ethnologie der Sprache
 56. Die Religionswissenschaft der Sprache
 57. Die Kunst der Sprache
 58. Die Pädagogik der Sprache
 59. Die Medizin der Sprache
 60. Die Rechtswissenschaft der Sprache
 61. Die Politik der Sprache
 62. Die Ökonomie der Sprache
 63. Die Soziologie der Sprache
 64. Die Anthropologie der Sprache
 65. Die Biologie der Sprache
 66. Die Geographie der Sprache
 67. Die Historie der Sprache
 68. Die Ethnologie der Sprache
 69. Die Religionswissenschaft der Sprache
 70. Die Kunst der Sprache
 71. Die Pädagogik der Sprache
 72. Die Medizin der Sprache
 73. Die Rechtswissenschaft der Sprache
 74. Die Politik der Sprache
 75. Die Ökonomie der Sprache
 76. Die Soziologie der Sprache
 77. Die Anthropologie der Sprache
 78. Die Biologie der Sprache
 79. Die Geographie der Sprache
 80. Die Historie der Sprache
 81. Die Ethnologie der Sprache
 82. Die Religionswissenschaft der Sprache
 83. Die Kunst der Sprache
 84. Die Pädagogik der Sprache
 85. Die Medizin der Sprache
 86. Die Rechtswissenschaft der Sprache
 87. Die Politik der Sprache
 88. Die Ökonomie der Sprache
 89. Die Soziologie der Sprache
 90. Die Anthropologie der Sprache
 91. Die Biologie der Sprache
 92. Die Geographie der Sprache
 93. Die Historie der Sprache
 94. Die Ethnologie der Sprache
 95. Die Religionswissenschaft der Sprache
 96. Die Kunst der Sprache
 97. Die Pädagogik der Sprache
 98. Die Medizin der Sprache
 99. Die Rechtswissenschaft der Sprache
 100. Die Politik der Sprache
 101. Die Ökonomie der Sprache
 102. Die Soziologie der Sprache
 103. Die Anthropologie der Sprache
 104. Die Biologie der Sprache
 105. Die Geographie der Sprache
 106. Die Historie der Sprache
 107. Die Ethnologie der Sprache
 108. Die Religionswissenschaft der Sprache
 109. Die Kunst der Sprache
 110. Die Pädagogik der Sprache
 111. Die Medizin der Sprache
 112. Die Rechtswissenschaft der Sprache
 113. Die Politik der Sprache
 114. Die Ökonomie der Sprache
 115. Die Soziologie der Sprache
 116. Die Anthropologie der Sprache
 117. Die Biologie der Sprache
 118. Die Geographie der Sprache
 119. Die Historie der Sprache
 120. Die Ethnologie der Sprache
 121. Die Religionswissenschaft der Sprache
 122. Die Kunst der Sprache
 123. Die Pädagogik der Sprache
 124. Die Medizin der Sprache
 125. Die Rechtswissenschaft der Sprache
 126. Die Politik der Sprache
 127. Die Ökonomie der Sprache
 128. Die Soziologie der Sprache
 129. Die Anthropologie der Sprache
 130. Die Biologie der Sprache
 131. Die Geographie der Sprache
 132. Die Historie der Sprache
 133. Die Ethnologie der Sprache
 134. Die Religionswissenschaft der Sprache
 135. Die Kunst der Sprache
 136. Die Pädagogik der Sprache
 137. Die Medizin der Sprache
 138. Die Rechtswissenschaft der Sprache
 139. Die Politik der Sprache
 140. Die Ökonomie der Sprache
 141. Die Soziologie der Sprache
 142. Die Anthropologie der Sprache
 143. Die Biologie der Sprache
 144. Die Geographie der Sprache
 145. Die Historie der Sprache
 146. Die Ethnologie der Sprache
 147. Die Religionswissenschaft der Sprache
 148. Die Kunst der Sprache
 149. Die Pädagogik der Sprache
 150. Die Medizin der Sprache
 151. Die Rechtswissenschaft der Sprache
 152. Die Politik der Sprache
 153. Die Ökonomie der Sprache
 154. Die Soziologie der Sprache
 155. Die Anthropologie der Sprache
 156. Die Biologie der Sprache
 157. Die Geographie der Sprache
 158. Die Historie der Sprache
 159. Die Ethnologie der Sprache
 160. Die Religionswissenschaft der Sprache
 161. Die Kunst der Sprache
 162. Die Pädagogik der Sprache
 163. Die Medizin der Sprache
 164. Die Rechtswissenschaft der Sprache
 165. Die Politik der Sprache
 166. Die Ökonomie der Sprache
 167. Die Soziologie der Sprache
 168. Die Anthropologie der Sprache
 169. Die Biologie der Sprache
 170. Die Geographie der Sprache
 171. Die Historie der Sprache
 172. Die Ethnologie der Sprache
 173. Die Religionswissenschaft der Sprache
 174. Die Kunst der Sprache
 175. Die Pädagogik der Sprache
 176. Die Medizin der Sprache
 177. Die Rechtswissenschaft der Sprache
 178. Die Politik der Sprache
 179. Die Ökonomie der Sprache
 180. Die Soziologie der Sprache
 181. Die Anthropologie der Sprache
 182. Die Biologie der Sprache
 183. Die Geographie der Sprache
 184. Die Historie der Sprache
 185. Die Ethnologie der Sprache
 186. Die Religionswissenschaft der Sprache
 187. Die Kunst der Sprache
 188. Die Pädagogik der Sprache
 189. Die Medizin der Sprache
 190. Die Rechtswissenschaft der Sprache
 191. Die Politik der Sprache
 192. Die Ökonomie der Sprache
 193. Die Soziologie der Sprache
 194. Die Anthropologie der Sprache
 195. Die Biologie der Sprache
 196. Die Geographie der Sprache
 197. Die Historie der Sprache
 198. Die Ethnologie der Sprache
 199. Die Religionswissenschaft der Sprache
 200. Die Kunst der Sprache
 201. Die Pädagogik der Sprache
 202. Die Medizin der Sprache
 203. Die Rechtswissenschaft der Sprache
 204. Die Politik der Sprache
 205. Die Ökonomie der Sprache
 206. Die Soziologie der Sprache
 207. Die Anthropologie der Sprache
 208. Die Biologie der Sprache
 209. Die Geographie der Sprache

MARSHALING BOX

MARSHALING BOX

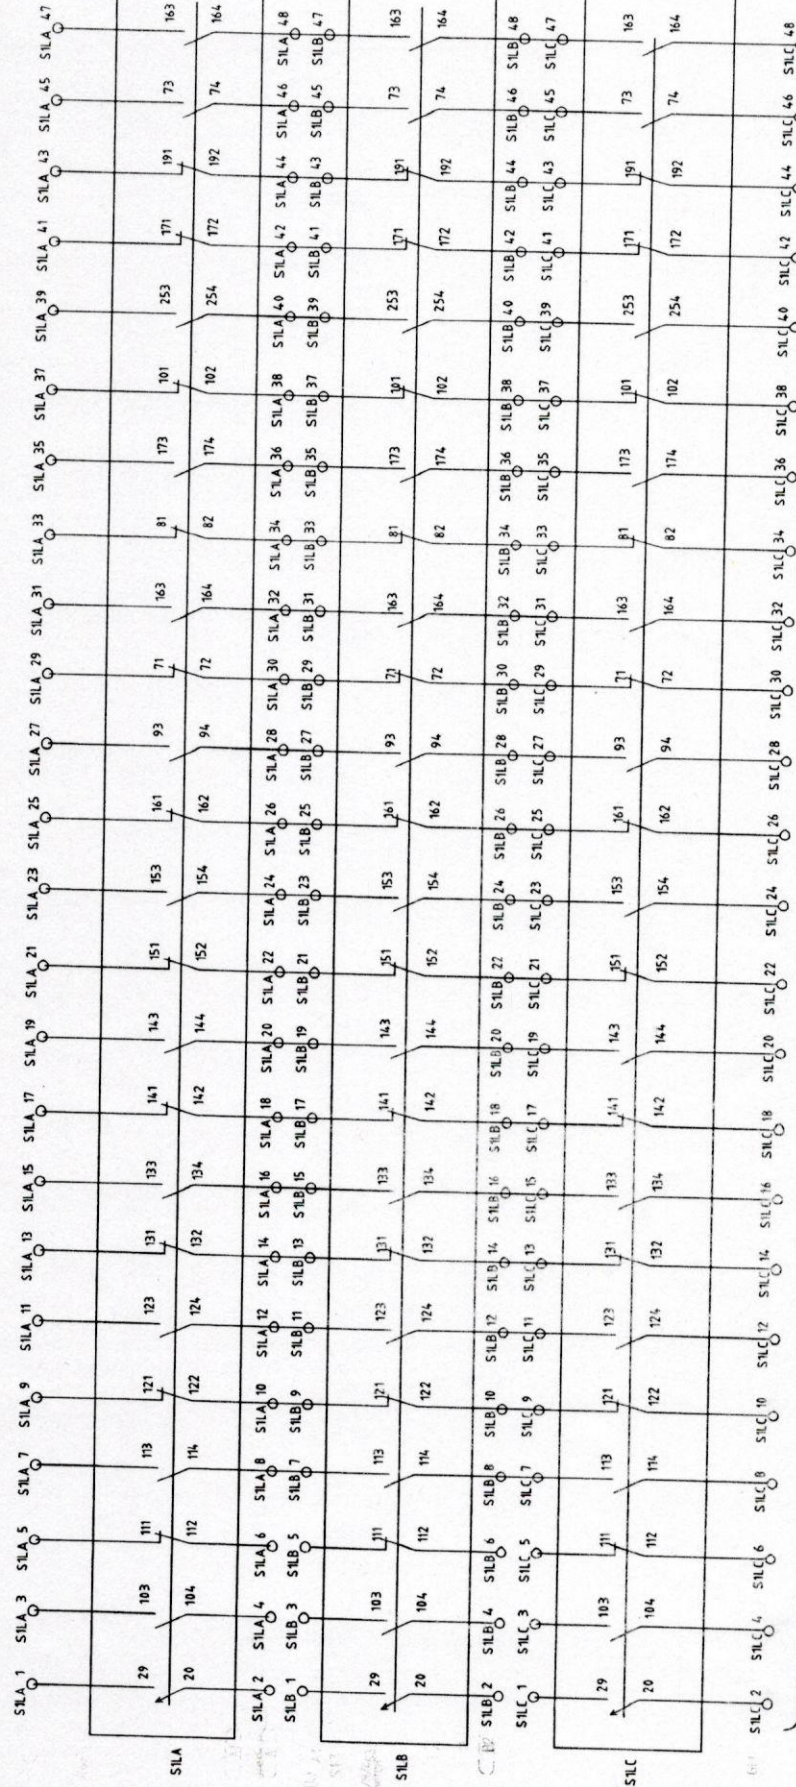

APPROVED

Executive Engineer
O/o Executive Director (T&P)
Jabalpur
M.P. Power Transmission Co. Ltd.


- NOTES :-
1. ALL AUXILIARY CONTACTS SHOWN WITH CIRCUIT DE-ENERGISED.
 2. ALL CONTACTS OF PR SWITCH SHOWN WITH THE SWITCH IN LOW PR CONDITION
 3. CONTACTS OF LIMIT SWITCH OF SPRING CHARGING MOTOR SHOWN WITH SPRING DISCHARGED.

NOTE: WIRING IN THE DOTTED LINES INDICATE THE WIRING CIRCUIT INSIDE THE CONTROL CUBICLE (LA, LB, LC).

MAXIMUM SPARE CONTACTS 12NO/11NC OF CB AUXILIARY SWITCH

Date: 15.01.15		Customer: Bharat Heavy Electricals Limited		Sales Order: 3004.171812	
Prep: AR	PO No: 144P143 Dt: 11.11.2014	Project: NPPTCL Balaghat Badnawar Bhopal Chhindigarh		Line Item: 100	
Ckd: JR	Original/Replacement for/Replaced by :-	W.O.:		Qty: 10x	
Date: 25.01.15	Remarks:	Details: WIRING DRAWING		Dwg. No: (4)G71AHS-FM03-W608-	
Issue		Siemens Ltd. AURANGABAD		Sh. 4	
25		26		27	
28		29		30	
31		32		33	

BASIC MODULE :-

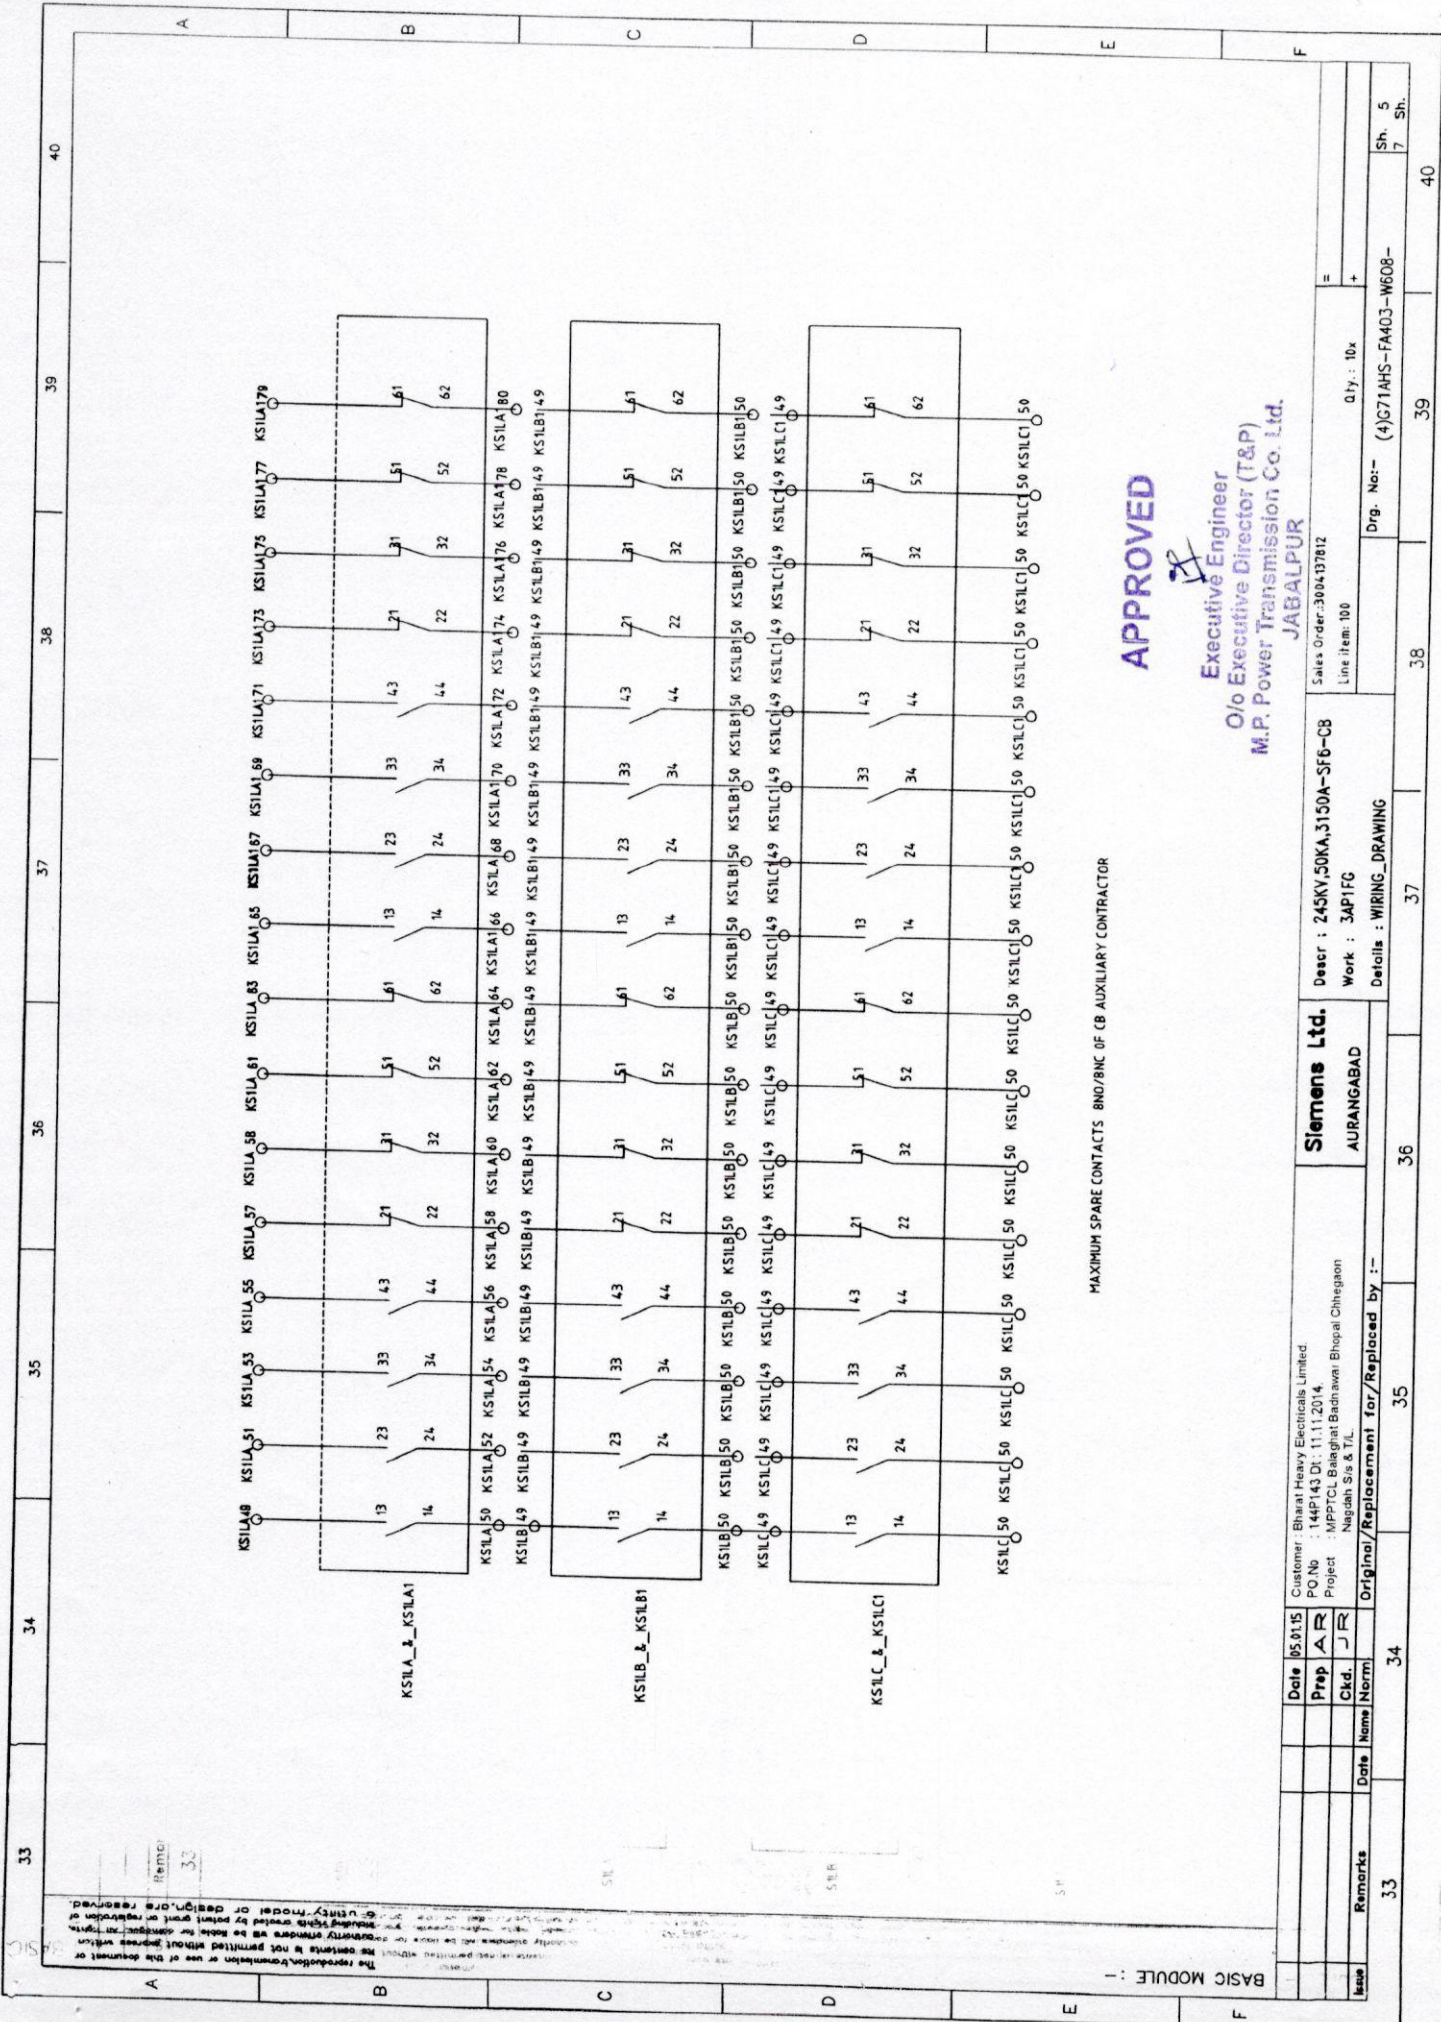


APPROVED

Executive Engineer
O/o Executive Director (T&P)
M.P. Power Transmission Co. Ltd.
JABALPUR

MAXIMUM SPARE CONTACTS BNO/BNC OF CB AUXILIARY CONTRACTOR

Siemens Ltd. AURANGABAD		Desor : 24SKY,50KA,3150A-SF6-CB Work : 3AP1FG Details : WIRING DRAWING		Sales Order: 3004-137812 Line item: 100 Qty : 10x +	
Customer : Bharat Heavy Electricals Limited PO No : 144P143 DT: 11.11.2014 Project : MPPCL Bagmati Badnari Bhopal Chhigaon Nagda Sis & TL		Date : 05.01.15 Prep : AR Ckd : JR Original/Replacement for/Replaced by :-		34 35 36 37 38 39 40	
Remarks		33		Sh. 5 7 Sh.	

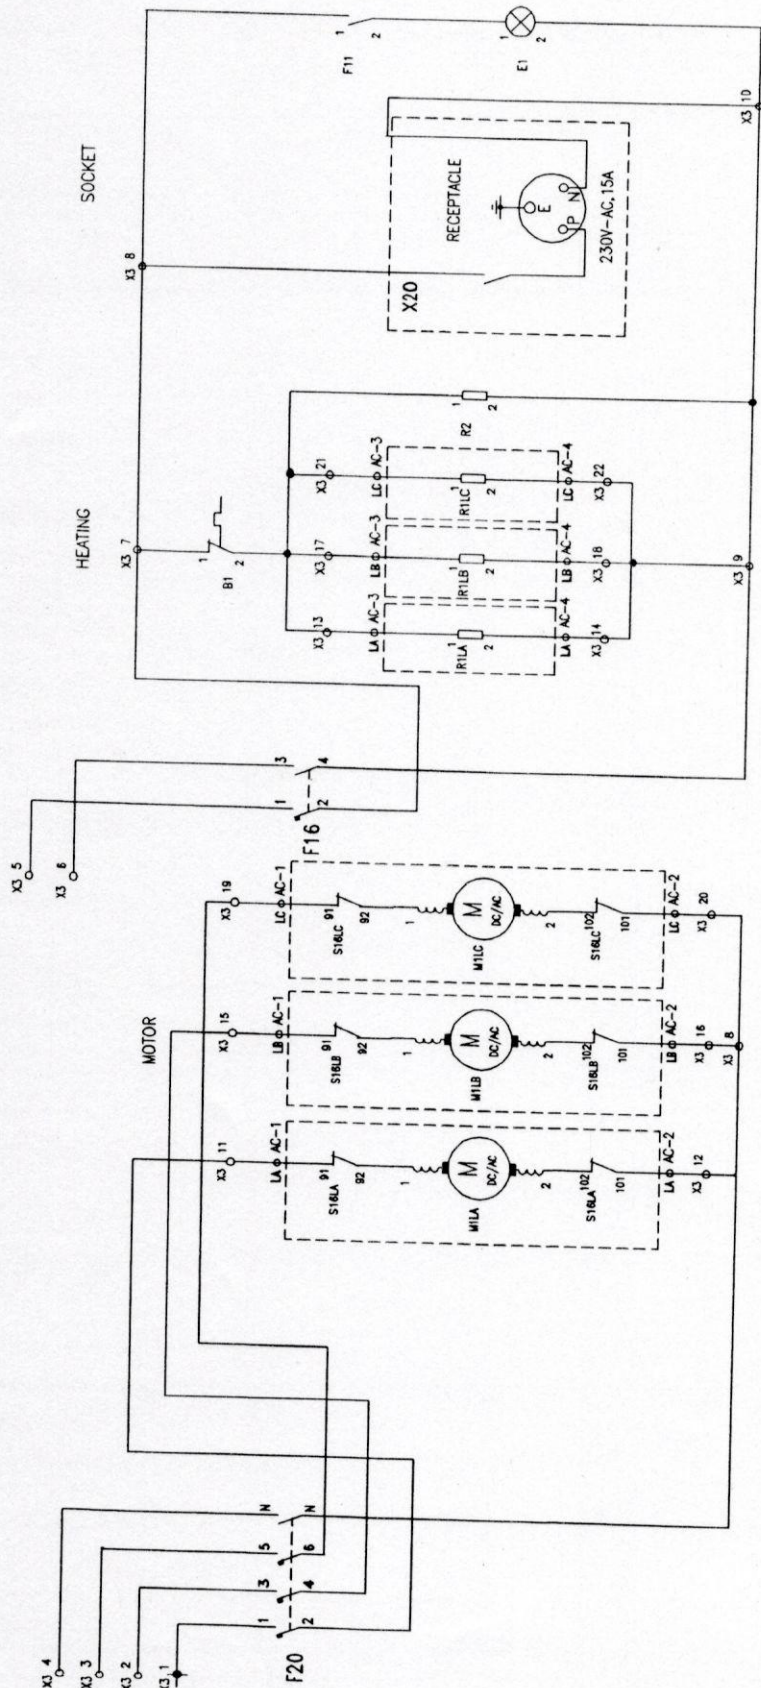
MARSHALING BOX

APPROVED

Executive Engineer
C/o Executive Director (T&P)
M.P. Power Transmission Co. Ltd.

JABALPUR

NOTE: WIRING IN THE DOTTED LINES INDICATE THE WIRING CIRCUIT INSIDE THE CONTROL CUBICLE (LA, LB, LC)

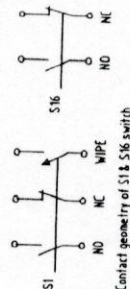

- NOTES :-
1. ALL AUXILIARY CONTACTS SHOWN WITH CIRCUIT DE-ENERGISED.
 2. ALL CONTACTS OF PR. SWITCH SHOWN WITH THE SWITCH IN LOW PR. CONDITION.
 3. CONTACTS OF LIMIT SWITCH OF SPRING CHARGING MOTOR SHOWN WITH SPRING DISCHARGED.

[illegible]

Main Sign	Terminal No.	Strip Joint	Terminal No.	Equipment Main Sign	Equipment Terminal No.	Main Sign	Terminal No.	Strip Joint	Terminal No.	Equipment Main Sign	Equipment Terminal No.	Main Sign	Terminal No.	Strip Joint	Terminal No.	Equipment Main Sign	Equipment Terminal No.	
		X1						S1LA										
220V DC (+)		1	F19	1				1	S1LA	29						S1LC		
220V DC (-)		2	F19	3				2	S1LA	20						1	S1LC	29
220V DC (+)		1A	F21	1				3	S1LA	103						2	S1LC	20
220V DC (-)		2A	F21	3				4	S1LA	104						3	S1LC	103
		3	K61	13				5	S1LA	111						4	S1LC	104
		4	K77	13				6	S1LA	112						5	S1LC	111
		5	K77	43				7	S1LA	113						6	S1LC	112
		6	K77	53				8	S1LA	114						7	S1LC	113
		7	K81	63				9	S1LA	121						8	S1LC	114
REMOTE TRIP		8	K88	13				10	S1LA	122						9	S1LC	121
REMOTE TRIP		9	K88	43				11	S1LA	123						10	S1LC	122
REMOTE TRIP		10	K88	53				12	S1LA	124						11	S1LC	123
REMOTE TRIP		11	S13	A1				13	S1LA	131						12	S1LC	124
REMOTE TRIP		12	S13	A2				14	S1LA	132						13	S1LC	131
REMOTE TRIP		13	S13	B2				15	S1LA	133						14	S1LC	132
REMOTE TRIP		14	S13	C2				16	S1LA	134						15	S1LC	133
REMOTE CLOSE		15	S20	4				17	S1LA	141						16	S1LC	134
PERMISSIBLE VL		16						18	S1LA	142						17	S1LC	141
		17						19	S1LA	143						18	S1LC	142
		18						20	S1LA	144						19	S1LC	143
TRIP CKT SUP.		19	S1LA	191				21	S1LA	151						20	S1LC	144
TRIP CKT SUP.		20	S1LA	194				22	S1LA	152						21	S1LC	151
TRIP CKT SUP.		21	S1LB	191				23	S1LA	153						22	S1LC	152
TRIP CKT SUP.		22	S1LB	194				24	S1LA	154						23	S1LC	153
TRIP CKT SUP.		23	S1LC	191				25	S1LA	161						24	S1LC	154
TRIP CKT SUP.		24	S1LC	194				26	S1LA	162						25	S1LC	161
TRIP CKT SUP.		25	S1LA	221				27	S1LA	93						26	S1LC	162
TRIP CKT SUP.		26	S1LA	224				28	S1LA	94						27	S1LC	93
TRIP CKT SUP.		27	S1LB	221				29	S1LA	71						28	S1LC	94
TRIP CKT SUP.		28	S1LB	224				30	S1LA	72						29	S1LC	71
TRIP CKT SUP.		29	S1LC	221				31	S1LA	163						30	S1LC	72
TRIP CKT SUP.		30	S1LC	224				32	S1LA	164						31	S1LC	163
		31	K11	21				33	S1LA	81						32	S1LC	164
		32	K11	31				34	S1LA	82						33	S1LC	81
		33	K10	54				35	S1LA	173						34	S1LC	82
		34						36	S1LA	174						35	S1LC	173
		35	K10	A2				37	S1LA	101						36	S1LC	174
		36						38	S1LA	102						37	S1LC	101
		37	K75	22				39	S1LA	223						38	S1LC	102
		38	B4LA	22				40	S1LA	224						39	S1LC	223
GENERAL LOCKOUT		39	K10	22				41	S1LA	171						40	S1LC	224
		40	K10	21				42	S1LA	172						41	S1LC	171
LOSS OF SF6		41	B4LA	11												42	S1LC	172
		42	B4LA	13				S1LB										
SPRING CHARGE STATUS		43	S16LA	33				1	S1LB	29								
		44	S16LC	34				2	S1LB	20								
AUTO RECLOSER I		45						3	S1LB	103								
		46						4	S1LB	104								
POLE DISCREPANCY ALARM		47	K16	28				5	S1LB	111								
		48	K16	25				6	S1LB	112								
		49						7	S1LB	113								
DC SUPPLY 1 & 2 MONITORING		50						8	S1LB	114								
		51						9	S1LB	121								
		52						10	S1LB	122								
		53						11	S1LB	123								
		54						12	S1LB	124								
Protection Trip		55						13	S1LB	131								
		56						14	S1LB	132								
		57						15	S1LB	133								
		58						16	S1LB	134								
SPARES		59						17	S1LB	141								
SPARES		60						18	S1LB	142								
SPARES		61						19	S1LB	143								
SPARES		62						20	S1LB	144								
SPARES		63						21	S1LB	151								
SPARES		64						22	S1LB	152								
SPARES		65						23	S1LB	153								
SPARES		66						24	S1LB	154								
SPARES		67						25	S1LB	161								
SPARES		68						26	S1LB	162								
								27	S1LB	83								
								28	S1LB	94								
								29	S1LB	71								
								30	S1LB	72								
								31	S1LB	163								
								32	S1LB	164								
								33	S1LB	81								
								34	S1LB	82								
								35	S1LB	173								
								36	S1LB	174								
								37	S1LB	101								
								38	S1LB	102								
								39	S1LB	223								
								40	S1LB	224								
								41	S1LB	171								
								42	S1LB	172								

Customer : Bharat Heavy Electricals Limited.
 PO.No : 144P143 Dt : 11.11.2014
 Project : MPPTCL Balaghat Badnawar Bhopal Chhegaon
 Nagdah S/s & T/L.

Date: 05.01.15		Description: 245KV, 50KA, 3150A, SF6 CB		Sh. 7
Prep: AR		Type Ref: 3AP1FI		
Check: JR		Detail: Terminal Plan		7 Sh.
Siemens Ltd. Aurangabad		Drawing No: (4) G71AHS-FA403-W508		

Index	Remarks	Date	Name
Original Replacement for Replaced by:-			

HS/SD/COORD/IE 01-90

APPROVED

Executive Engineer
 O/o Executive Director (T&P)
 M.P. Power Transmission Co. Ltd.
 JABALPUR