
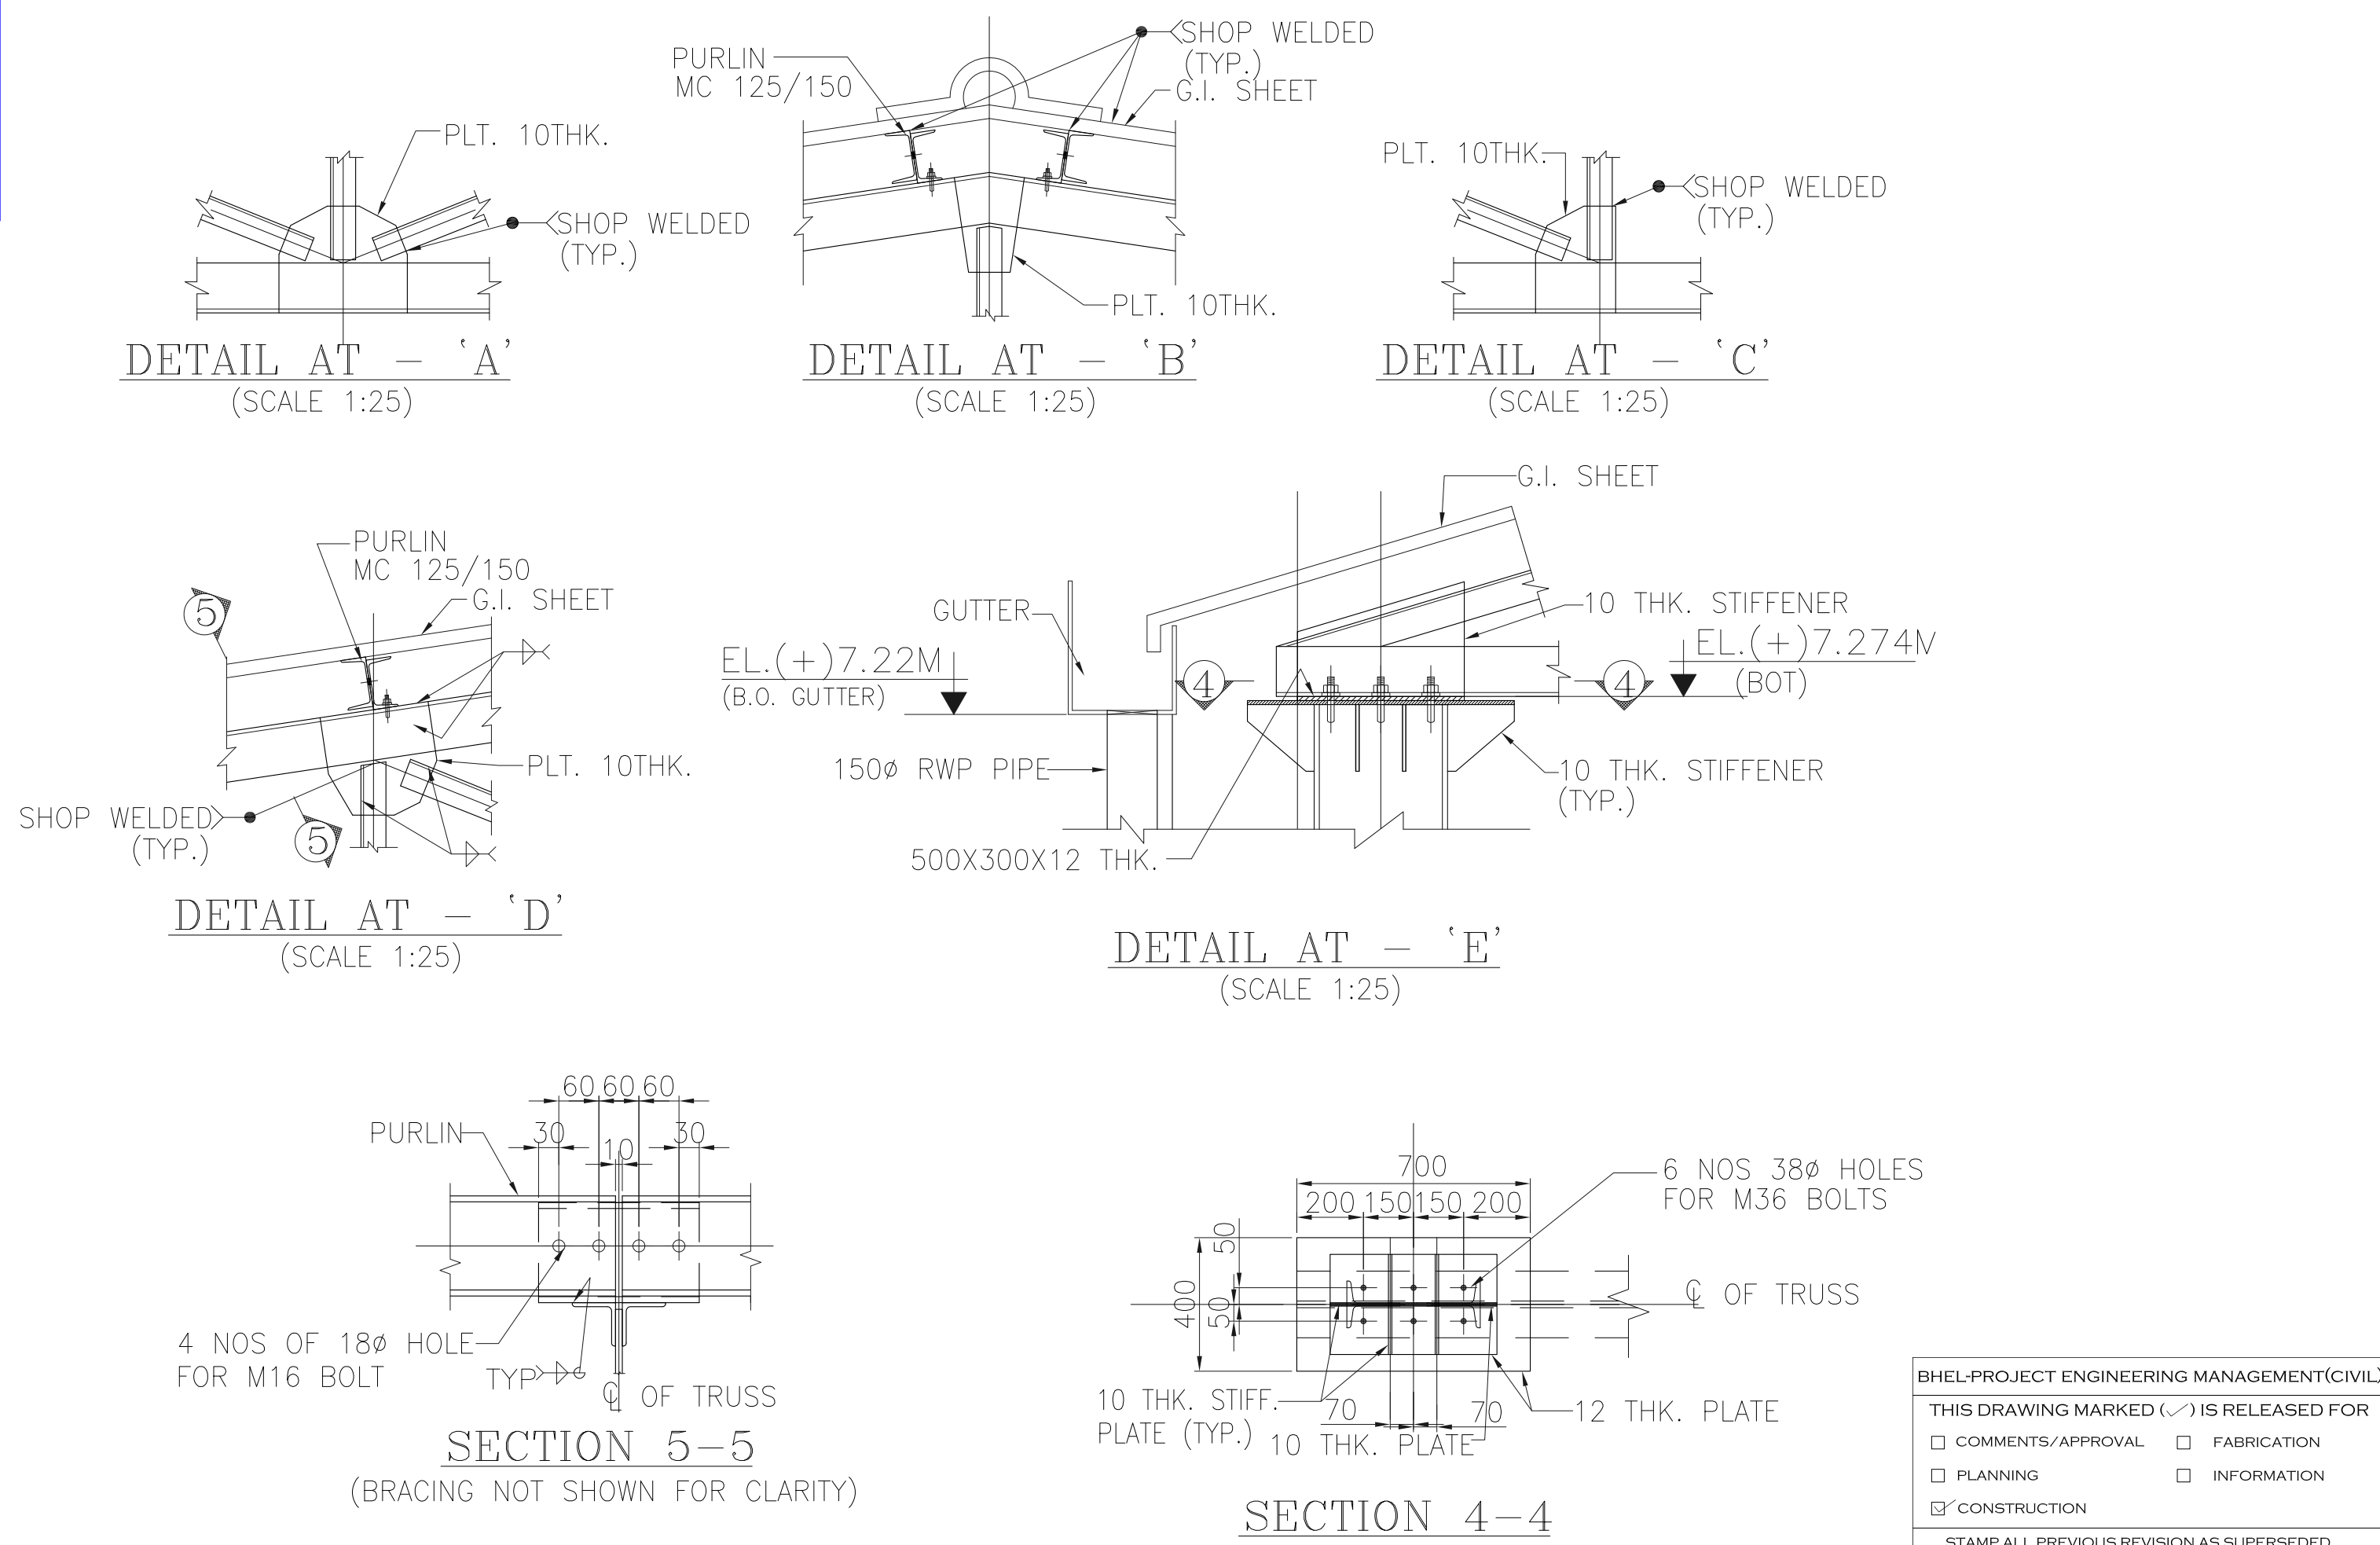
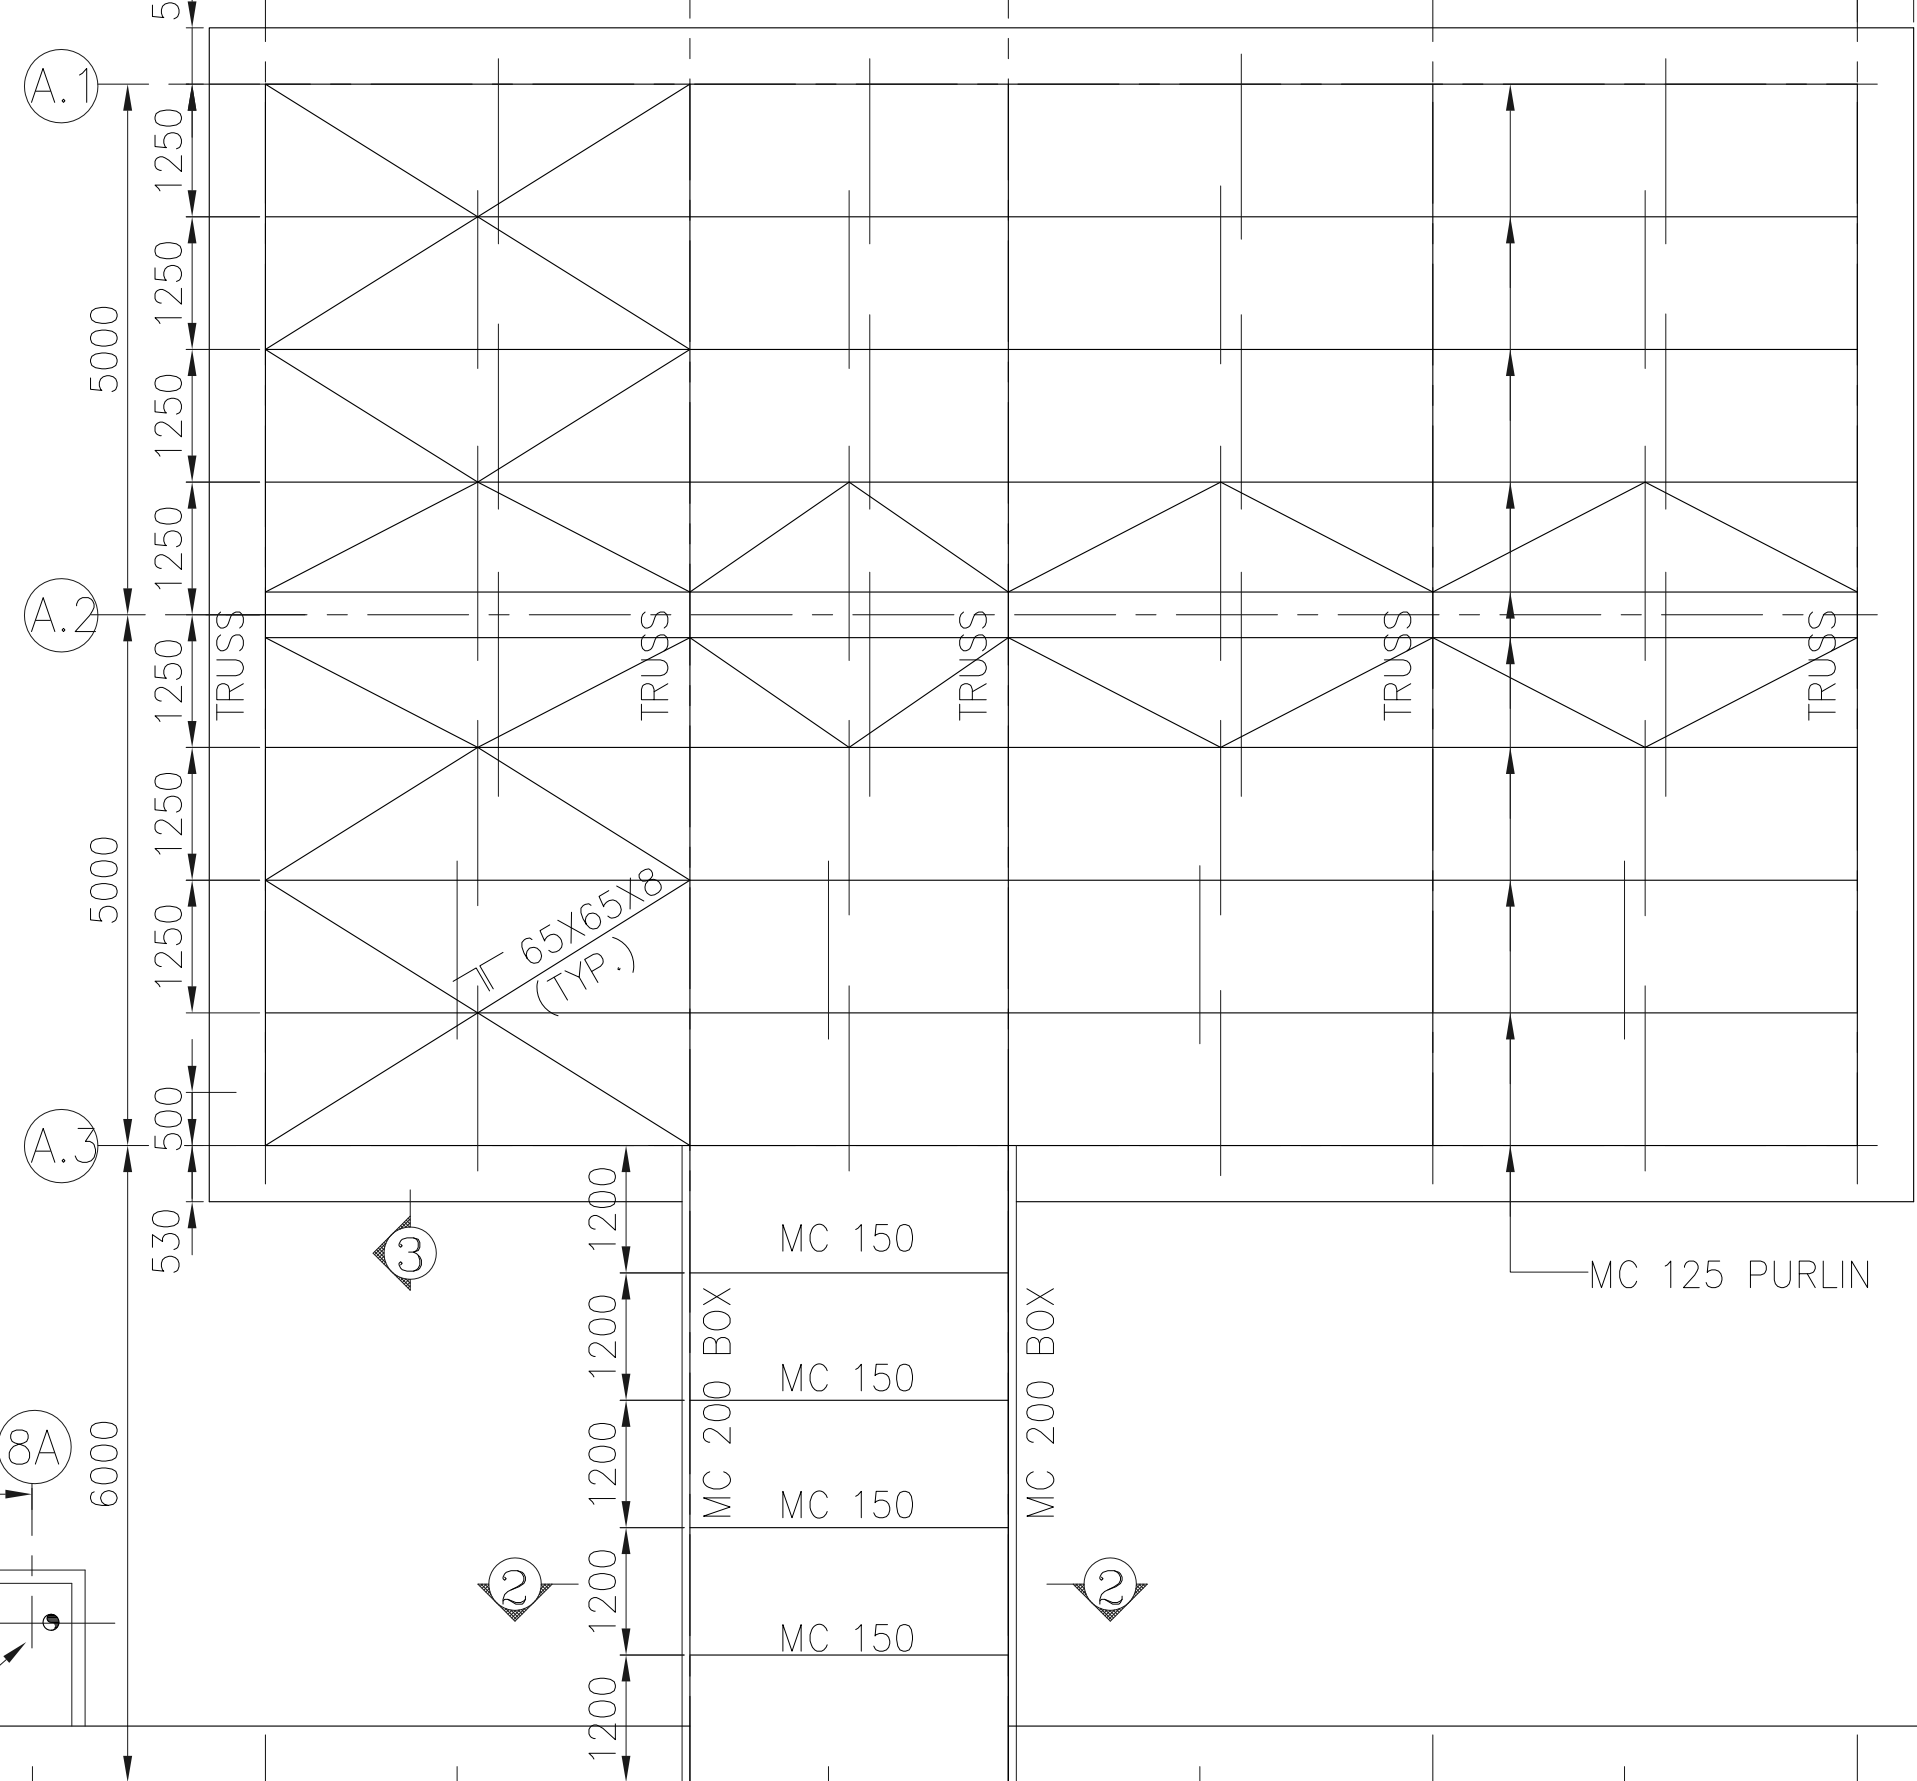
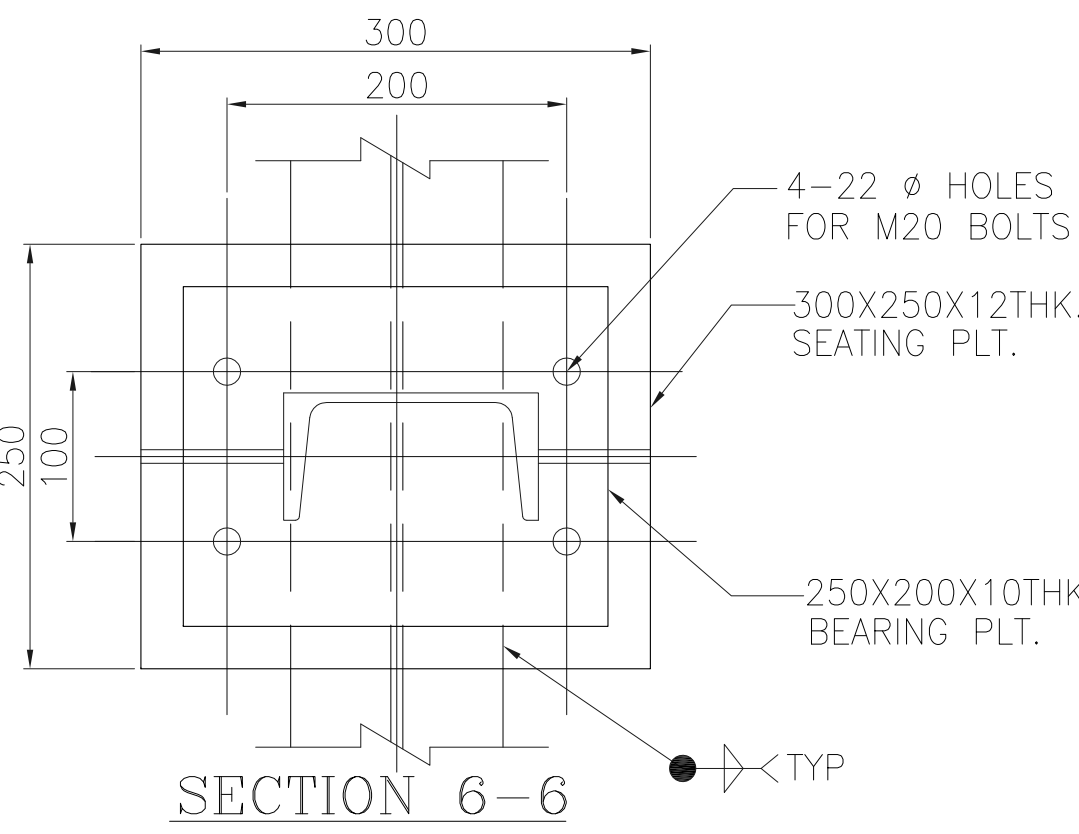
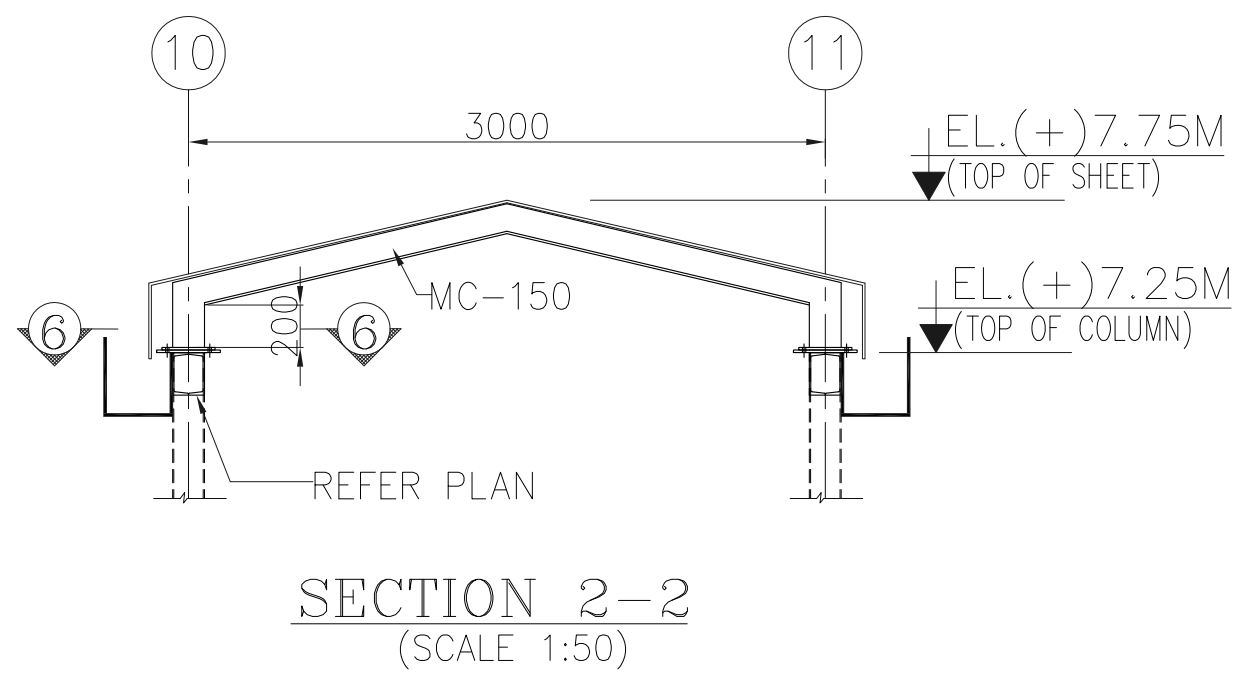


Customer Office\_RFI# 96101/ 001

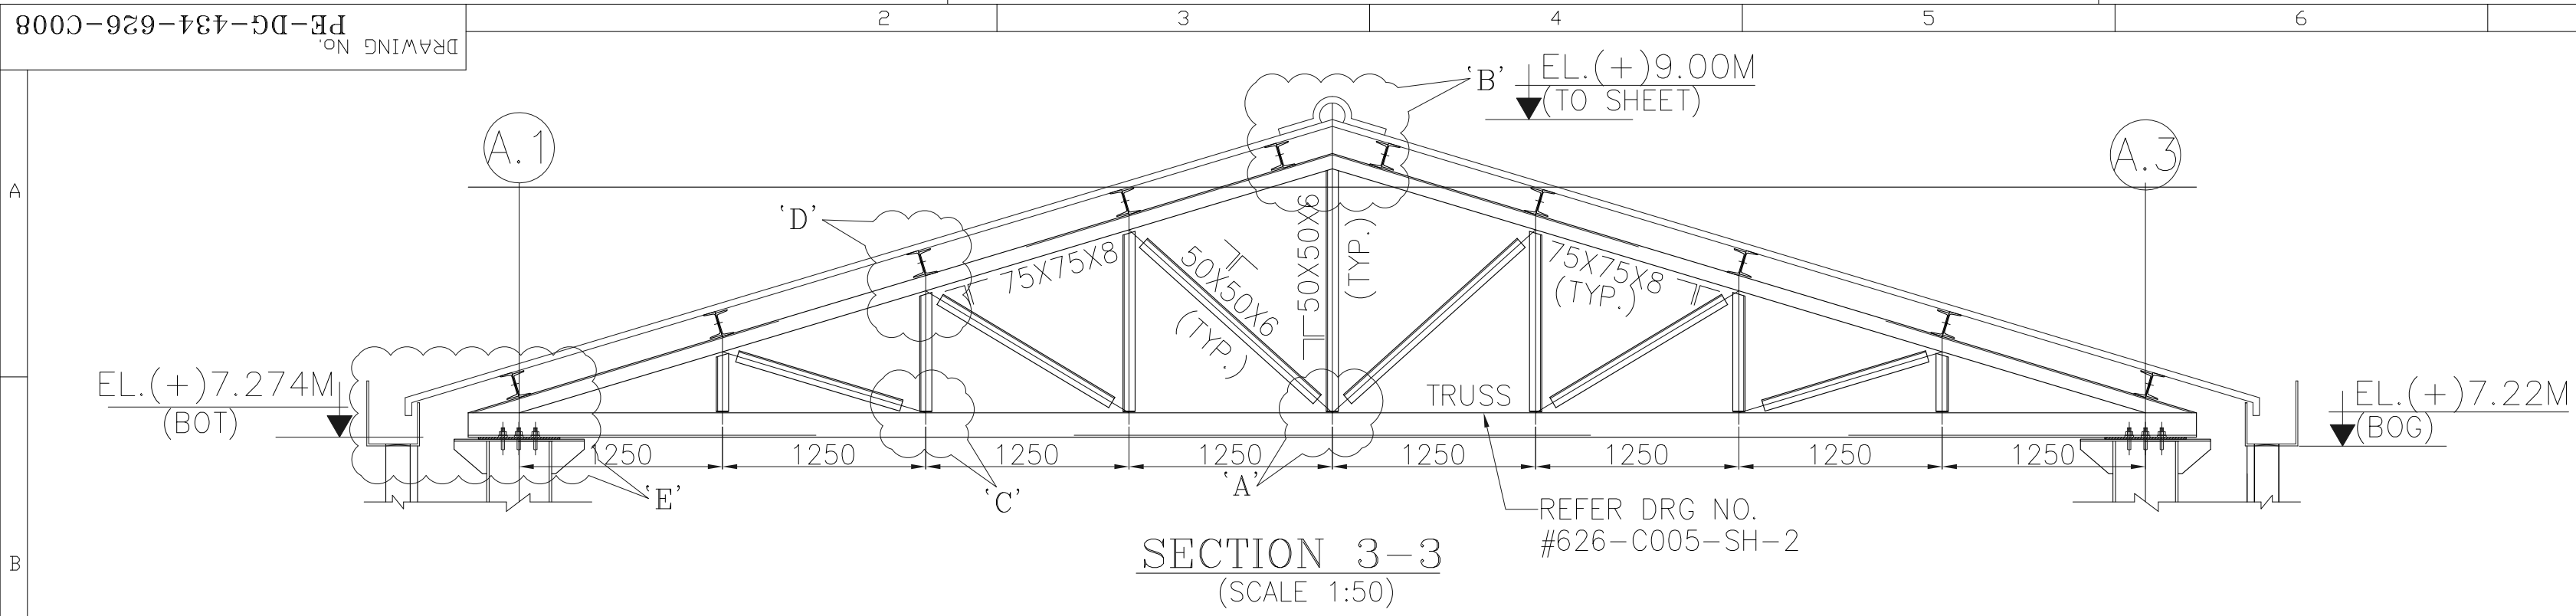

BHEL-PROJECT ENGINEERING MANAGEMENT(CIVIL)	
THIS DRAWING MARKED (✓) IS RELEASED FOR	
<input type="checkbox"/> COMMENTS/ APPROVAL	<input type="checkbox"/> FABRICATION
<input type="checkbox"/> PLANNING	<input type="checkbox"/> INFORMATION
<input type="checkbox"/> CONSTRUCTION	
STAMP ALL PREVIOUS REVISION AS SUPERSEDED	
ISSUED BY	
NAME	ABHAY KUMAR
SIGNATURE	For
DATE	06/03/2018

- NOTES:-**
- THIS DRAWING SHALL BE READ IN CONJUNCTION WITH CONTRACT TERMS AND CONDITIONS, TECHNICAL SPECIFICATIONS AND SCHEDULE OF ITEMS
  - ALL DIMENSIONS ARE IN MM & ELEVATIONS IN METERS UNLESS STATED OTHERWISE.
  - ALL ELEVATIONS ARE REFERRED TO THE FINISHED FLOOR LEVEL OF POWER HOUSE BUILDING AS EL. 0.00 M WHICH CORRESPONDS TO RL.(+) 375.50 M.
  - FOR OTHER NOTES AND STD. DETAILS REF. DRG. PE-DG-434-600-C002 (NTPC DRG NO. 9585-001-315-PVC-C-0089A)
  - FOR EP & IP DETAILS REF. DWG. NO. PE-DG-434-600-C001. (NTPC DRG NO. 9585-001-315-PVC-C-0451B)
  - NO DIMENSIONS FROM THIS DRAWING ARE TO BE SCALED OFF AND ONLY FIGURED DIMENSIONS SHALL BE FOLLOWED.
  - CHECK ALL DIMENSIONS, CO-ORDINATES & ELEVATIONS IMMEDIATELY. REPORT ANY DISCREPANCIES CONFLICTS OR ERROR FOR CLARIFICATION PRIOR TO COMMENCING WORK.
  - CONNECTION OF ALL TRUSS & BRACING MEMBERS SHALL BE DESIGNED TO DEVELOP FULL TENSILE STRENGTH OF MEMBER.
  - GRADE OF STEEL SHALL BE E250 FOR ALL ROLLED SECTIONS.

**ENGINEERING REFERENCE DRAWINGS :-**

PE-DG-434-100-M001 - PLOT PLAN  
(NTPC NO. 9585-001-999-POC-F-001)  
9585-001-POC-002 NTPC DRG. - CONSTRUCTION OFFICE ARCH. DETAILS

- STRUCTURAL REFERENCE DRAWINGS :-**
- PE-DG-434-626-C004 - OWNER'S CONS. OFFICE-G.A & RC DETAIL OF PEDESTAL & FOUNDATIONS (9585-001-301-PVC-C-127)
  - PE-DG-434-626-C005(SH-1) - OWNER'S CONS. OFFICE- DETAILS OF BASE PLATE (9585-001-301-PVC-C-128)
  - PE-DG-434-626-C005(SH-2) - OWNER'S OFFICE-STRUCTURAL DETAILS OF ROOF TRUSS (9585-001-301-PVC-C-128)
  - PE-DG-434-626-C007 - OWNER'S OFFICE-SIDE CLADDING DETAILS (9585-001-301-PVC-C-130)

- ARCHITECTURAL DRAWINGS :-**
- PE-DG-434-626-C001 - OWNER'S CONS. OFFICE-ARCHITECTURAL PLAN & FINISH SCHEDULE (9585-001-301-PVC-C-106A)
  - PE-DG-434-626-C002 - OWNER'S CONS. OFFICE- ARCHITECTURAL ELEVATIONS & SECTIONS (9585-001-301-PVC-C-106B)

- LEGENDS:-**
- CL - CENTER LINE  
EL - ELEVATION  
FFL - FINISHED FLOOR LEVEL  
TYP - TYPICAL  
TOS - TOP OF STEEL  
TOC - TOP OF CONCRETE
- EL.(+).XXXX - LEVEL TAG  
UNO - UNLESS NOTED OTHERWISE  
BOT - BOTTOM OF TRUSS

THIS DRAWING SHALL BE READ IN CONJUNCTION WITH DRAWING NO. PE-DG-434-626-C005(SH1 & 2)

BILL OF MATERIAL		
S NO	MEMBER	QTY(MT)
1.	ISA 50X50X6	1.25
2.	ISA 65X65X6	0.15
3.	ISA 75X75X8	1.0
4.	ISA 90X90X8	3.70
5.	MC 150	14.0
6.	MC 125	2.0
TOTAL		22.0

BHEL-PROJECT ENGINEERING MANAGEMENT(CIVIL)	
THIS DRAWING MARKED (✓) IS RELEASED FOR	
<input checked="" type="checkbox"/> COMMENTS/ APPROVAL	<input type="checkbox"/> FABRICATION
<input type="checkbox"/> PLANNING/ INFORMATION	<input type="checkbox"/> CONSTRUCTION
STAMP ALL PREVIOUS REVISION AS SUPERSEDED	
ISSUED BY	
NAME	ABHAY KUMAR
SIGNATURE	For
DATE	12/07/2018

NTPC NO.- 9585-001-301-PVC-C-138  
CUSTOMER PATRATU VIDYUT UTPADAN NIGAM LIMITED (A SUBSIDIARY OF NTPC LTD)

3x800MW PATRATU SUPER THERMAL POWER PROJECT

BHARAT HEAVY ELECTRICALS LTD  
POWER SECTOR  
PROJECT ENGINEERING MANAGEMENT  
NOIDA

COPY RIGHT AND CONFIDENTIAL	
The information on this document is the property of BHARAT HEAVY ELECTRICALS LIMITED & must not be used directly or indirectly in any way detrimental to the interest of the company.	
REV	DATE
01	12/07/18
02	12/07/18
03	12/07/18

OWNER'S CONS. OFFICE	
STRUCTURAL DETAILS OF ROOF TRUSS	
DRAWING NO. PE-DG-434-626-C008	
SHEET 1 OF 1	

**Q-2:**


We have maintained the truss extension as 250mm from center are of column. Please confirm else please provide the low point elevation of truss.

**Q-1:**

We assumed to follow Top of steel elevation as 9820mm by assuming thickness of sheeting as 40mm, purlin offset dimension as 10mm & purlin depth as 150mm (over all 200mm) as shown in snapshot. Please confirm the top truss elevation.

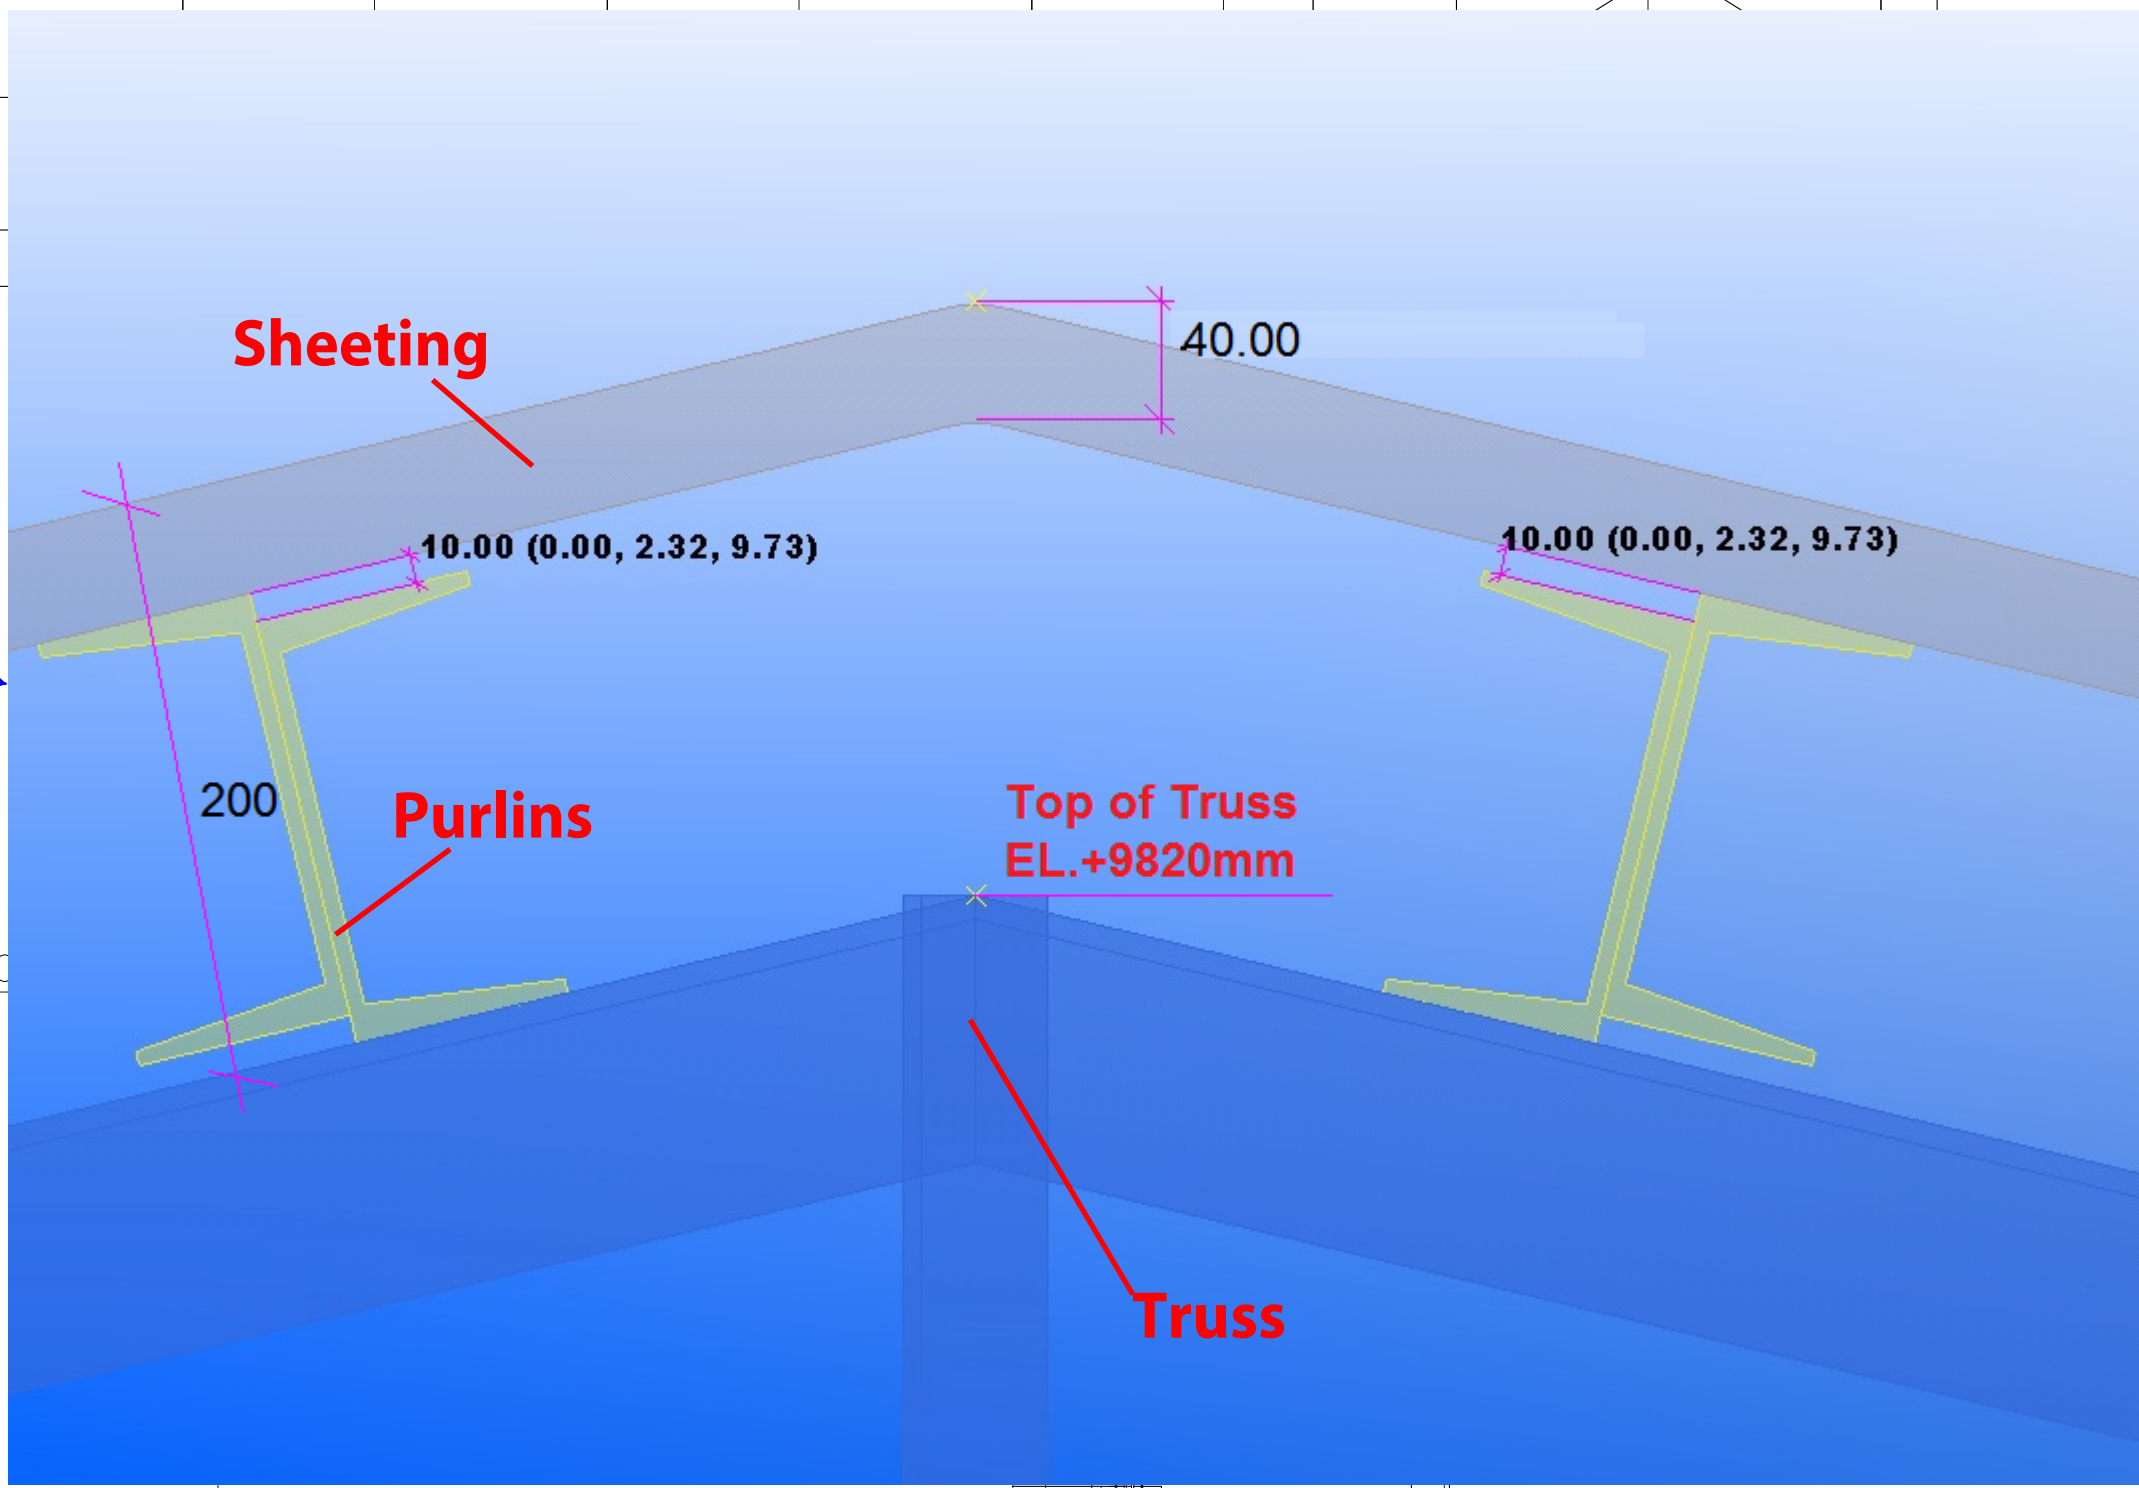

FRAMING PLAN AT RAFTER LEVEL (TOP CHORD)  
(SCALE 1:100)

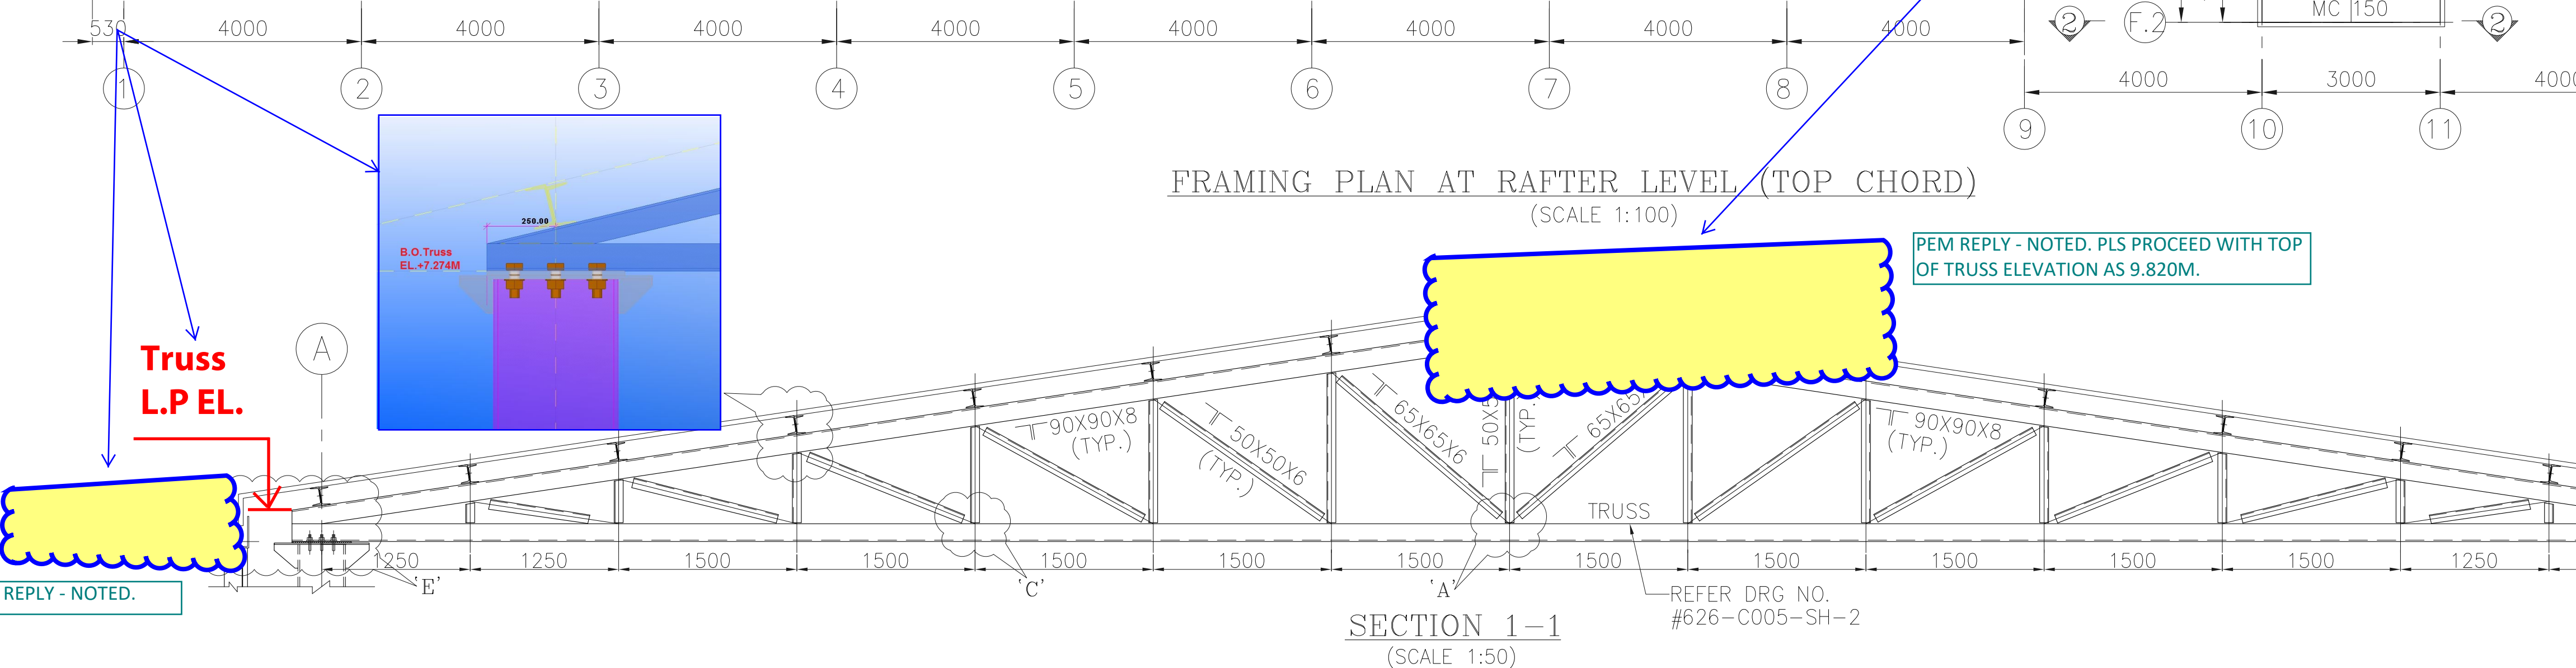

TYP. DETAIL OF SAG ROD  
CONNECTION AT RAFTER LEVEL

JOB NO.	434
STATUS	
DISTRIBUTION	

REV	DATE	ALTD	CHD	APPD
01	12/07/18	DEEPAK	SS	AK
DRAWING REVISED AS PER NTPC COMMENTS DATED 23.06.18				

OWNER'S CONS. OFFICE	
STRUCTURAL DETAILS OF ROOF TRUSS	
DRAWING NO. PE-DG-434-626-C008	
SHEET 1 OF 1	