

पावर सेक्टर- पश्चिमी क्षेत्र Power Sector-Western Region
श्रीमोहिनी कॉम्प्लेक्स, 345 किंग्सवे, नागपुर Shreemohini complex, 345 Kingsway Nagpur - 440 001
फोन / Phone 0712- 3048600, फैक्स FAX: 0712- 3048699 www.bhelpswr.co.in

BHEL PAN: AAACB4146P

Ref.: PW/NGP/PUR/1906070/Corrigendum-04

DT: 22-08-2019

To,

ALL BIDDERS

Sub: Corrigendum-04 for issuance of separate Sketch and detailed Drawing for better understanding of dimension of container.

Job: Design, manufacture and supply of 01 No. Prefabricated container at 2 X 800 MW NTPC Ramagundam Site on F.O.R. destination basis

Ref:- Tender Enquiry Number: 1906070

Bidders to kindly take note of the following: -

=====

In addition to the drawings provided in NIT, following drawings shall become part of the tender documents:

1. Pre -fab Container Sketch
2. Drawing reference No.: 9591-102-102-PVE-Y-029 for Electrical Equipment & Cabling Layout in Aux. Boiler MCC Room

Note: Separate sketch of container along with detailed drawing (9591-102-102-PVE-Y-029) is being issued herewith. Separate sketch is provided only for better understanding of dimension of container for bidder. However detailed engineering and fabrication including doors, windows, toilet and other accessories etc. is to be done as per drawing number 9591-102-102-PVE-Y-029. Based on this input drawing (9591-102-102-PVE-Y-029), detailed engineering including GA drawing needs to be submitted by bidder to BHEL/NTPC for approval as per TCC.

=====

All other Terms and conditions of the Tender Specification shall remain unaltered unless expressly amended by BHEL in writing.


Bidders are requested to submit as a part of their offer, a copy of this corrigendum duly Digitally countersigned by the authorized signatory as a token of Bidder's unqualified acceptance of this corrigendum.

BIDDERS MAY PLEASE NOTE THAT SUBJECT TENDER IS E-TENDER AND THE OFFER IS TO BE SUBMITTED ONLY IN E-PROCUREMENT PORTAL <https://bhel.abcpurchase.com>

BIDDERS WHO HAVE ALREADY SUBMITTED THEIR OFFERS PRIOR TO ISSUANCE OF THIS CORRIGENDUM IN E-TENDER PORTAL ARE REQUIRED TO RE-SUBMIT THEIR OFFER AFTER TAKING COGNIZANCE OF THIS CORRIGENDUM.


Thanking you,
Yours faithfully,

AGM/Purchase

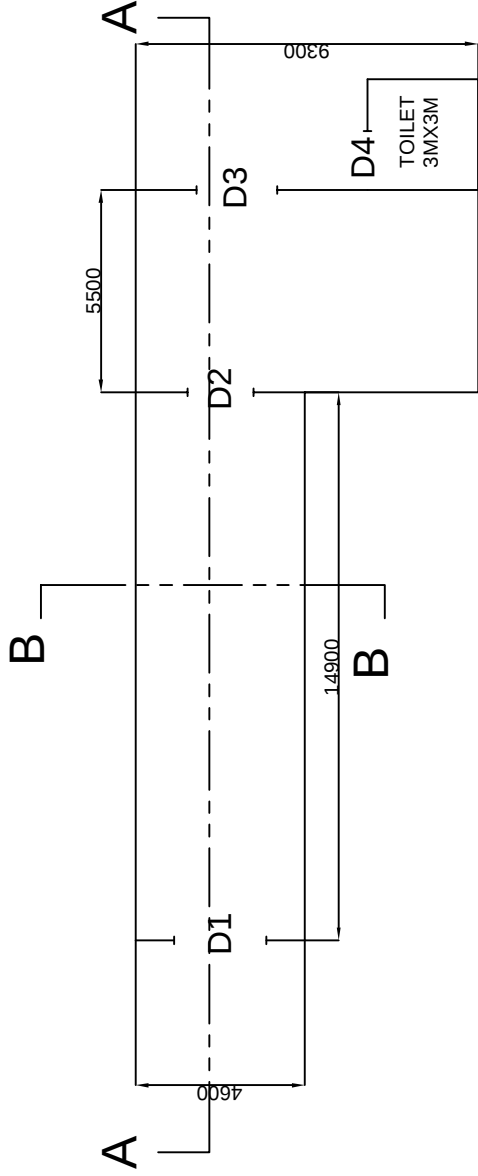

PLAN

DOOR OPENINGS	
D1	2500MM
D2	1800MM
D3	2200MM
D4	1600MM

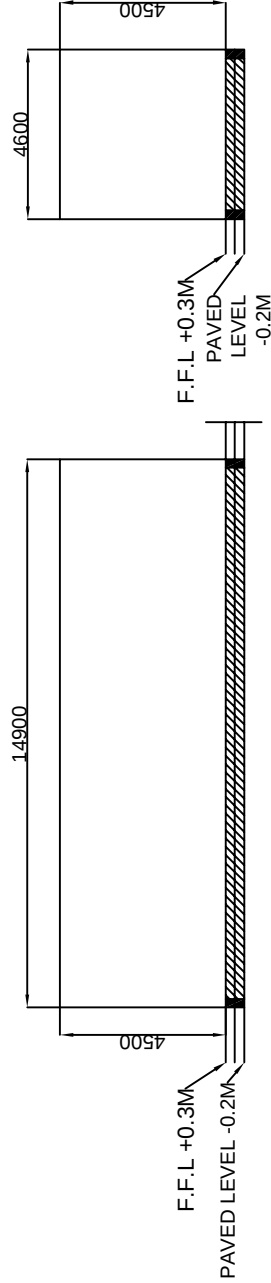

SECTION A-A

SECTION B-B

PRE-FAB CONTAINER SKETCH


(ALL DIMENSIONS ARE IN MM.)

DTD. 26.07.2019		
2X800MW TELANGANA PROJECT (KARIMNAGAR)		
	NTPC DRG NO.- 9591-102-102-PVE-Y-029 R4 (Electrical Equipment & Cabling Layout in AUXILIARY BOILER AREA)	
	NTPC COMMENTS DTD.11.07.19 REF NO. 102/25601 on REV 04	
	<u>NTPC COMMENT</u>	<u>BHEL REPLY</u>
1	INDicate depth of Pull pit and please ensure thattop of pull pit shall be sand filled and covered with PCC after completion of cabling job.	Depth of Pull Pit is 1200MM & we ensuer that top of pull pit shall be sand filled and covered with PCC after completion of cabling job.
2	Please submit the contained GA drawing before submission of this drawing	This drawing is input for vendor to develop GA drawing of container. Therefore customer is requested to approve the document so that subsequently container drawing may be submitted.
4	As commented previously for better aesthetic and movement of people please provide PVD pies in RCC	Revised in Layout Drwaing (refer Section K-K).




470X470 (H) MM OPENING IN
CONTAINER AT EL:3.5M FROM
FFL FOR GRAVITY DAMPER


REF. POINT
2748.92 (E)
754.60(N)

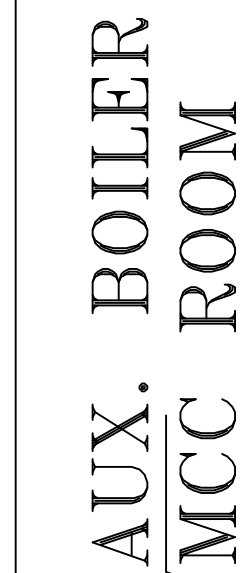


500WX300D CABLE SLIT
SECTION G-G

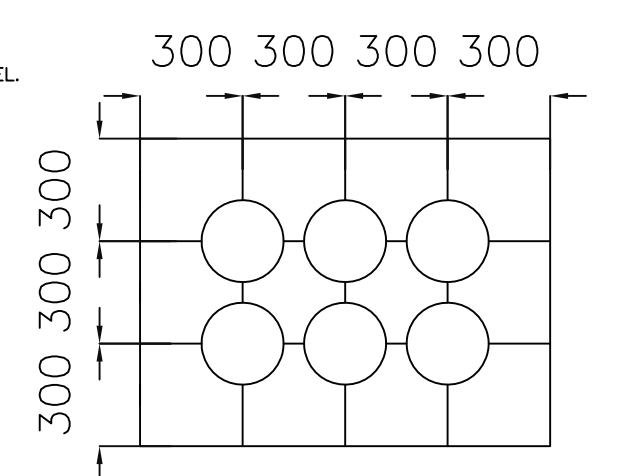

3X2X200DIA 
PVC PIPE DUCT BANK
SECTION: F-F

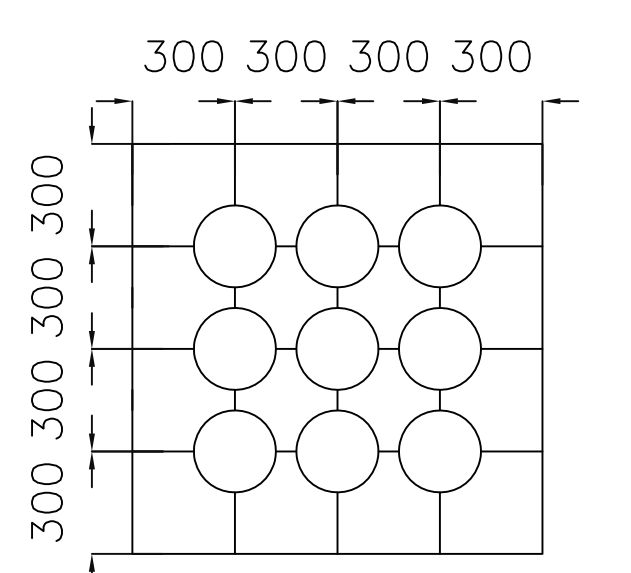

3X3X200DIA
PVC PIPE DUCT BANK
SECTION: E-E 

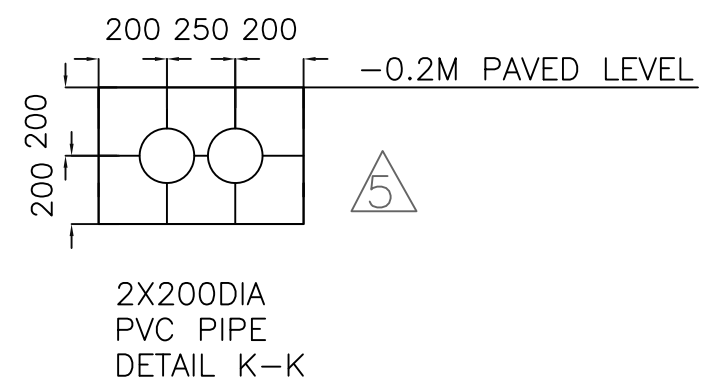

LEGENDS	
	PANEL OPERATING FRONT
	FIRE BARRIER WALL
	FIXED TYPE FENCING
	DUCT BANK
	CABLE TRENCH
	FLOOR CUTOUT IN CONTAINER

REV. 05	DATE	ALTD. MRS	CHD HK	APPO PD	REV. 04	DATE	ALTD. MRS	CHD HK	APPO PD	REV. 03	DATE	ALTD. MRS	CHD HK	APPO PD	REV. 02	DATE	ALTD. MRS	CHD HK	APPO PD	REV. 01	DATE	ALTD. MRS	CHD HK	APPO PD
	06.07.19	03.07.19	03.07.19	03.07.19		03.07.19	03.07.19	03.07.19	03.07.19		02.05.19	02.05.19	02.05.19	02.05.19		14.02.19	14.02.19	14.02.19	14.02.19		06.12.18	10.12.18	10.12.18	10.12.18
1.	DRAWING REVISED AS PER CUSTOMER COMMENTS VIDE LETTER REF. NO. 102/25601 DATED 11.07.19.				1.	DRAWING REVISED AS PER CUSTOMER COMMENTS VIDE LETTER REF. NO. 102/24683 DATED 03.06.19.				1.	DRAWING REVISED AS PER CUSTOMER COMMENTS VIDE LETTER REF. NO. 102/22358 DATED 05.03.19.				1.	14.02.19	14.02.19	14.02.19	14.02.19	1.	DRAWING REVISED AS PER CUSTOMER COMMENTS VIDE LETTER REF. NO. 102/18538 DATED 06.11.18.			
2.	REVISION MARKED AS SHOWN. 				2.	REVISION MARKED AS SHOWN. 				2.	REVISION MARKED AS SHOWN. 				2.	REVISION MARKED AS SHOWN. 				2.	REVISION MARKED AS SHOWN. 			


BHARAT HEAVY ELECTRICALS LTD
 POWER SECTOR
 PROJECT ENGINEERING MANAGEMENT
 NOIDA

Manufacturing Company	NIGRA					
COPY RIGHT AND CONFIDENTIAL The information on this document is the property of BHARAT HEAVY ELECTRICALS, LIMITED it must not be used directly or indirectly in any way detrimental to the interest of the company.	DEPT CODE	E	NAME	SIGN	DATE	
			DRN	MRS	-SD-	24.10.18
			DESN	MRS	-SD-	24.10.18
			CHD	HK	-SD-	24.10.18
			APPD	PD	-SD-	24.10.18

TITLE												
ELECTRICAL EQUIPMENT & CABLING LAYOUT IN AUX. BOILER MCC ROOM												
								DEPT.	SCALE 1:100	DRAWING NO.		
								SIGN		PE-DG-424-100-E019		
										SHEET 1	OF 1	REV. 05