



BHARAT HEAVY ELECTRICALS LIMITED
PROJECT ENGINEERING MANAGEMENT, NOIDA

Date-8-May-20

CORRIGENDUM- 05

PROJECT	:	3X660 MW NPGCPL NABINAGAR STPP (FGD PKG)
PACKAGE	:	MISC. TANKS(SITE FABRICATED)
ENQUIRY NO	:	PE/PG/NB2/E-6402/2019 Dated. 05.03.2020
SUBJECT	:	PRE- BID CLARIFICATION

Type of Corrigendum			
Technical Corrigendum -	☒	Commercial Corrigendum -	☐

In reference to the above mentioned tender enquiry for **MISC. TANKS(SITE FABRICATED)** package

Please note the following.

1. All bidders are requested to go through the attached pre-bid clarification please.

All the other terms and conditions of the tender enquiry remain unchanged. All the bidders are requested to quote accordingly.

Yours faithfully,

For and on behalf of BHEL

Guru Das
Dy. Manager

2555/2020/PS-PEM-MAX

MISC. TANKS (SITE FABRICATED) at 3 X 660 MW NPGCL NABINAGAR STPP (FGD PKG)			Tender No. PE/PG/NB2/E-6402/2019	
Pre Bid Clarifications Reply				
S.No.	Section/Clause/ Page No.	Statement of the referred clause	Clarification required	BHEL Reply
1	PE-TS-457-167-A101 Part2 / CI 1.4 of pg 2	The scope of works shall also include supply and installation of special accessories including agitator supporting arrangements, agitator platform, baffle plates etc. as indicated in FGD Tank schedule(SectionIII, Annexure-8) and GA drawing forMiscellaneous FGD tanks. The necessary fixtures andother accessories for mounting these special accessories shall be inclu ded in the scope of work of the bidder.	Please provide agitator datasheets & weights and also provide the static & dynamic loads. So that we accordingly design and consider its supporting platforms and respective accessories. Also note that baffle plates details are not furnished in the GAD's,provide the same.	For static and dynamic load please refer Annexure -I attached herewith. Further details like data sheet of Agitators shall be furnished during detail engineering. For baffle plate details refer Section-III, Annexure-8 TANK SCHEDULE & GA DRAWING (TYPICAL) WITH AGITATOR PLATFORM AND FIELD QUALITY PLAN (refer annexure-II attached herewith).
2	PE-TS-457-167-A101Part2 / CI 1.5 of pg 2	Baffle plates for the agitators shall be mounted on the tank. The supply and erection of the baffleplates shall be in bidder's scope of work. The minimum no. of b affle plates and minimum dimension of the baffle plates have been in dicated in the drawing attached with the tank schedule (Section-III, Annexure-8). The final quantity and dimensions of the baffle plates shall be decided during detail engineering.	Please note that baffle plates details are not furnished in the Section-III,Annexure-8, provide the same.	For baffle plate details refer Section-III, Annexure-8 TANK SCHEDULE & GA DRAWING (TYPICAL) WITH AGITATOR PLATFORM AND FIELD QUALITY PLAN (refer annexure-II attached herewith).
3	PE-TS-457-167-A101Part2 / CI 2.4 of pg 4	Minor civil work like chipping of foundation, groutingbelow base plateforall structures, equipment, grouting of pockets, ex cavation & filling of earth for buried MS pipes if and as required.	Please note that excavation & filling of earth for buried MS pipes are not in our scope	Noted, the excavation & filling of earth for buried MS pipes is excluded from bidder's scope.
4	PE-TS-457-167-A101Part2 / CI 3.1 of pg 4	Design of roof and roof structures for vertical storage tanks along with agitators & agitator platforms shall be designed based on guidelines given in the book titled "Process equipment design"by Brownell and Young.	Please provide agitator datasheets and weights. Also provide the static and dynamic loads of the agitators	Please refer S.No. 1.
5	PE-TS-457-167-A101Part2 / CI 3.17 of pg 6	Raw material of fastener must undergo Inter-Granular Corrosion test as per ISO-3651, Part-1 for Nitric Acid test.	Please clariffy	All fasteners used in wetted condition must be of Alloy 926 or better material so that even if it comes in contact with liquid by swelling of rubber, thread remains unaffected. Raw material of such fastener must undergo Inter-Granular Corrosion test as per ISO-3651, Part-1 for Nitric Acid test.
6	PE-TS-457-167-A101Part2 / CI 3.17 of pg 6	Code conformance for bolts and nuts shall be SA 193 & 194 respectively.	As per drawings the bolts and nuts are given as IS 1367, Please confirm what to be consider.	The code for bolts and nuts shall be IS: 1367 inline with the GA Drawings of the tanks(Section-I, Sub-Section-D, Annexure-III). Further, all fasteners used in wetted condition must be of Alloy 926 or better material so that even if it comes in contact with liquid by swelling of rubber, thread remains unaffected. Raw material of fastener must undergo Inter-Granular Corrosion test as per ISO-3651, Part-1 for Nitric Acid test.
7	PE-TS-457-167-A101Part2 / CI 3.18 of pg 6	Nozzles are tentative	Please confirm at this stage only.	All the requirements shown under GA drawing are bare minimum, further final sizes, additional quantity and any other additional items if found applicable during detailed engineering as per technical specification/ design code/ functional requirement shall be supplied by bidder without any commercial implication to BHEL.
8	PE-TS-457-167-A101Part2 / CI 5.2 of pg 6	DPT / MPI on all welds (100%).	Please note that DPT considered.	Either of DPT or MPI on all the welds is acceptable to BHEL.
9	PE-TS-457-167-A101Part2 / CI 5.3 of pg 7	Radiography as per applicable joint efficiency	Please note that as per GAD'S joint efficiency is 0.7, radiography will not be considered. Please confirm.	The requirement of radiography shall be as per the applicable joint efficiency as per IS: 803. For tanks having joint efficiency of 0.7 (refer GA drawings of tanks, Section-I, Sub-Section-D, Annexure-III), no radiography to be considered inline with IS:803.
10	PE-TS-457-167-A101Part2 / CI 7.0 of pg 7	List of commissioning spares Any other item required for successful commissioning of the tanks including rubber lining (to be specified clearly by bidder)	Please mention at this stage only.	List of commissioning spares indicated are minimum requirement. Bidder shall specify in their offer, the list of commissioning spares as required(if applicable) over and above the spares indicated in the technical specification.
11	PE-TS-457-167-A101Par8 / sl. No. 42 of pg 42	Painting spec for FGD tanks	Please note that we have considered Sl. No 41 kindly confirm	Bidder refer the Painting specification. Further outside of bottom surface of the tanks shall have 2 coats of high build coal tar epoxy suitably pigmented, DFT:80-100 microns each coat.

2555/2020/PS-PEM-MAX



MISC. TANKS (SITE FABRICATED) at 3 X 660 MW NPGCPL NABINAGAR STPP (FGD PKG)			Tender No. PE/PG/NB2/E-6402/2019	
Pre Bid Clarifications Reply				
S.No.	Section/Clause/ Page No.	Statement of the referred clause	Clarification required	BHEL Reply
12	PE-TS-457-167-A101Part1 / Cl 1.3 of pg 42	All vent valves are in bidder scope of supply,as per cl 9.0 (4) All valves are excluded from bidder's scope of work.	Both the statements are contradicting please clarify	Supply of all valves are excluded from bidder scope. Vent valves are not applicable as per GA drawing of tanks, bidder shall provide vent with suitable bird screen.
13	PE-TS-457-167-A101Part1 / as per cl 9.0 (4) of pg 42	All valves are excluded from bidder's scope of work.		
14	PE-TS-457-167-A101Part2 / Cl 7.0 of pg 7	As per commisiong spare 7.0 gasket material is CAF	Please Clarify, the gasket material	The gasket material shall be Butyl Rubber inline with the GA Drawings of the tanks(Section-I, Sub-Section-D, Annexure-III).
15	PE-TS-457-167-A101Part9 / drwng nos.Sketch-1, Sketch-2, Sketch-3, Sketch-4, Sketch-5, Sketch-6, Sketch-7, Sketch-8, Sketch-9	As per the drawings the gasket material is Butyl Rubber and bolts and nuts are IS1367		
16	PE-TS-457-167-A101Part9 / drwng nos.Sketch-1, Sketch-2, Sketch-3, Sketch-4, Sketch-5, Sketch-6, Sketch-7, Sketch-8, Sketch-9	As per the drawings the bolts and nuts are IS1367	Please Clarify, the bolts and nuts material	Refer reply to point no.6.
17	PE-TS-457-167-A101Part2 / Cl 7.0 of pg 7	as per cl. 3.17 bolts and nuts material is A 193 & 194		
18	PE-TS-457-167-A101Part9 / drwng nos.Sketch-1, Sketch-2, Sketch-3, Sketch-4, Sketch-5, Sketch-6, Sketch-7, Sketch-8, Sketch-9	Anchor bolts	Please confirm the number and size of anchor bolts	Please refer Civil details given under GA drawing for Anchor Bolts. All the requirements shown under GA drawing are bare minimum, further final sizes, additional quantity and any other additional items if found applicable during detailed engineering as per technical specification/ design code/ functional requirement shall be supplied by bidder without any commercial implication to BHEL.
19	PE-TS-457-167-A101Part10 /Annexure - 8 pg 46	TANK SCHEDULE		
			As per tank schedule rectangular tanks are not in our scope but rubber lining and agitator erection for the same are in our scope, kindly provide the drawings of tanks and agitator datasheet	The rectangular tanks mentioned by the bidder are actually RCC sumps. Further bidder's understanding regarding scope of rubber lining and agitator erection is correct. The typical drawings of the sump along with agitator mounting arrangement has been provided in SECTION-I, Sub Section-D, Annexure-III. The supply and erection of the rubber lining on the RCC sump, supply and erection mounting arrangement of the agitator including the erection of agitators in the sumps shall be in bidder's scope. Further the sumps are of RCC construction and is excluded from bidder's scope.
20	PE-TS-457-167-A101Part10 pg No. 48	Typical arrangement of vertical mounted agitator and agitator platform	Please confirm that this drawing is applicable for all the vertical agitator mounted all tanks.	Noted and confirm.
21	PE-TS-457-167-A101Part9 / drwng nos. Sketch-1, Sketch-2, Sketch-3, Sketch-4, Sketch-5, Sketch-6, Sketch-7, Sketch-8, Sketch-9	corrosion allowance for roof plate is not given.	We have not considered and corrosion allowance . Kindly confirm it.	Corrosion allowance shall be 1.5 mm refer clause 3.3 (a), SECTION –I, SUB SECTION –C1-A of technical specification.
22	PE-TS-457-167-A101Part9 / drwng nos. Sketch-1, Sketch-2, Sketch-3, Sketch-4, Sketch-5, Sketch-6, Sketch-7, Sketch-8, Sketch-9	Drpdown pipe for nozzels.	As there are agitators in the tanks,we feel dropdown pipe need not be considered . Please confirm regarding dropdown pipe for all the tanks.	The dropdown pipe for the inlet nozzle shall be considered by bidder in their offer. The applicability of the same shall be decided during detail engineering.
23	PE-TS-457-167-A101Part9 / drwng nos. Sketch-1, Sketch-2, Sketch-3, Sketch-4, Sketch-5, Sketch-6, Sketch-7, Sketch-8, Sketch-9	Anchor bolts,Anchor plate	Please confirm the number and size of anchor bolts.Thickness of anchor plate is not given . Kindly mention the thickness	Please refer BHEL's reply of S.no.18

2555/2020/PS-PEM-MAX

MISC. TANKS (SITE FABRICATED) at 3 X 660 MW NPGCPL NABINAGAR STPP (FGD PKG)			Tender No. PE/PG/NB2/E-6402/2019	
Pre Bid Clarifications Reply				
S.No.	Section/Clause/ Page No.	Statement of the referred clause	Clarification required	BHEL Reply
24	PE-TS-457-167-A101Part9 / drwng nos. Sketch-6	In the given drawing for Auxillary Absorbent tank , only one number of agitator is shown	Both this statement is contradicting. Please clarify regarding quantity of agitator need to be considered per tank for Auxillary Absorbent tank.	Please refer the revised GAD of Aux Absorbent Tank indicating horizontal/ side entry Agitator (annexure-III attached herewith). Please refer Annexure -IV for the revised Foundation Loading Drawing no Sketch-1 Sheet 2 of 2, Sketch-2 Sheet 2 of 2, Sketch-3 Sheet 2 of 2, Sketch-4 Sheet 2 of 2, Sketch-5 Sheet 2 of 2, Sketch-6, Sheet 2 of 2, Sketch- 7 Sheet 2 of 2, Sketch-8 Sheet 2 of 2, Sketch-9 Sheet 2 of 2.
25	PE-TS-457-167-A101Part10 /Annexure - 8 pg 46	For Auxillary Absorbent tank ,Quantity of agitator quired is 3 no. per tank		


AGITATOR LOADS (ANNEXURE-I)										
Sl.no.	Description	Primary Hydrocyclone feed tank	Filtrate water tank	Secondary Hydrocyclone feed tank	Waste water Tank	Limestone Slurry Storage tank	Auxiliary Absorbent Tank	Absorber Area Drain Pit	Gypsum Dewatering Area Drain Pits	Ball Mill Area Drain Pit
1	Tank SI No.	1	2	3	4	5	6	10	11	12
2	Type of agitator	Vertical Type – (Center Mounted)	Vertical Type – (Center Mounted)	Vertical Type – (Center Mounted)	Vertical Type – (Center Mounted)	Vertical Type – (Center Mounted)	Marine Propeller – Horizontal Type (Side Entry),	Vertical Type – (Center Mounted)	Vertical Type – (Center Mounted)	Vertical Type – (Center Mounted)
	Dimension (in m)									
a)	Diameter	7.0	5.5	6.0	7.0	13.5	12.5	-	-	-
b)	Height	7.5	6.2	6.2	8.0	15.4	13.8	4 m(h) X 4m(w) X 4m (ht)	4 m(h) X 4m(w) X 4m (ht)	4 m(h) X 4m(w) X 4m (ht)
3	Quantity of Agitator per tank	1	1	1	1	1	3	1	1	1
4	Total no. of tanks	1	1	1	1	2	1	3	1	1
5	Loads									
a)	Static Load (assembly wt./agitator assembly) (in Tonnes)	2.3	0.98	0.98	2.3	5.8	1.35	0.5	0.5	0.5
b)	Dynamic load (per agitator assembly) (in Tonnes)	4.6	2.0	2.0	4.6	11.6	2.7	1.1	1.1	1.1
Notes										
1 The loads furnished above is tentative and for tender purpose only. The final loads shall be furnished during detail engineering.										
2 The above details shall be read in conjunction with the GA drawing of tanks, tank schedule etc. furnished along with the technical specification.										

ANNEXURE-III

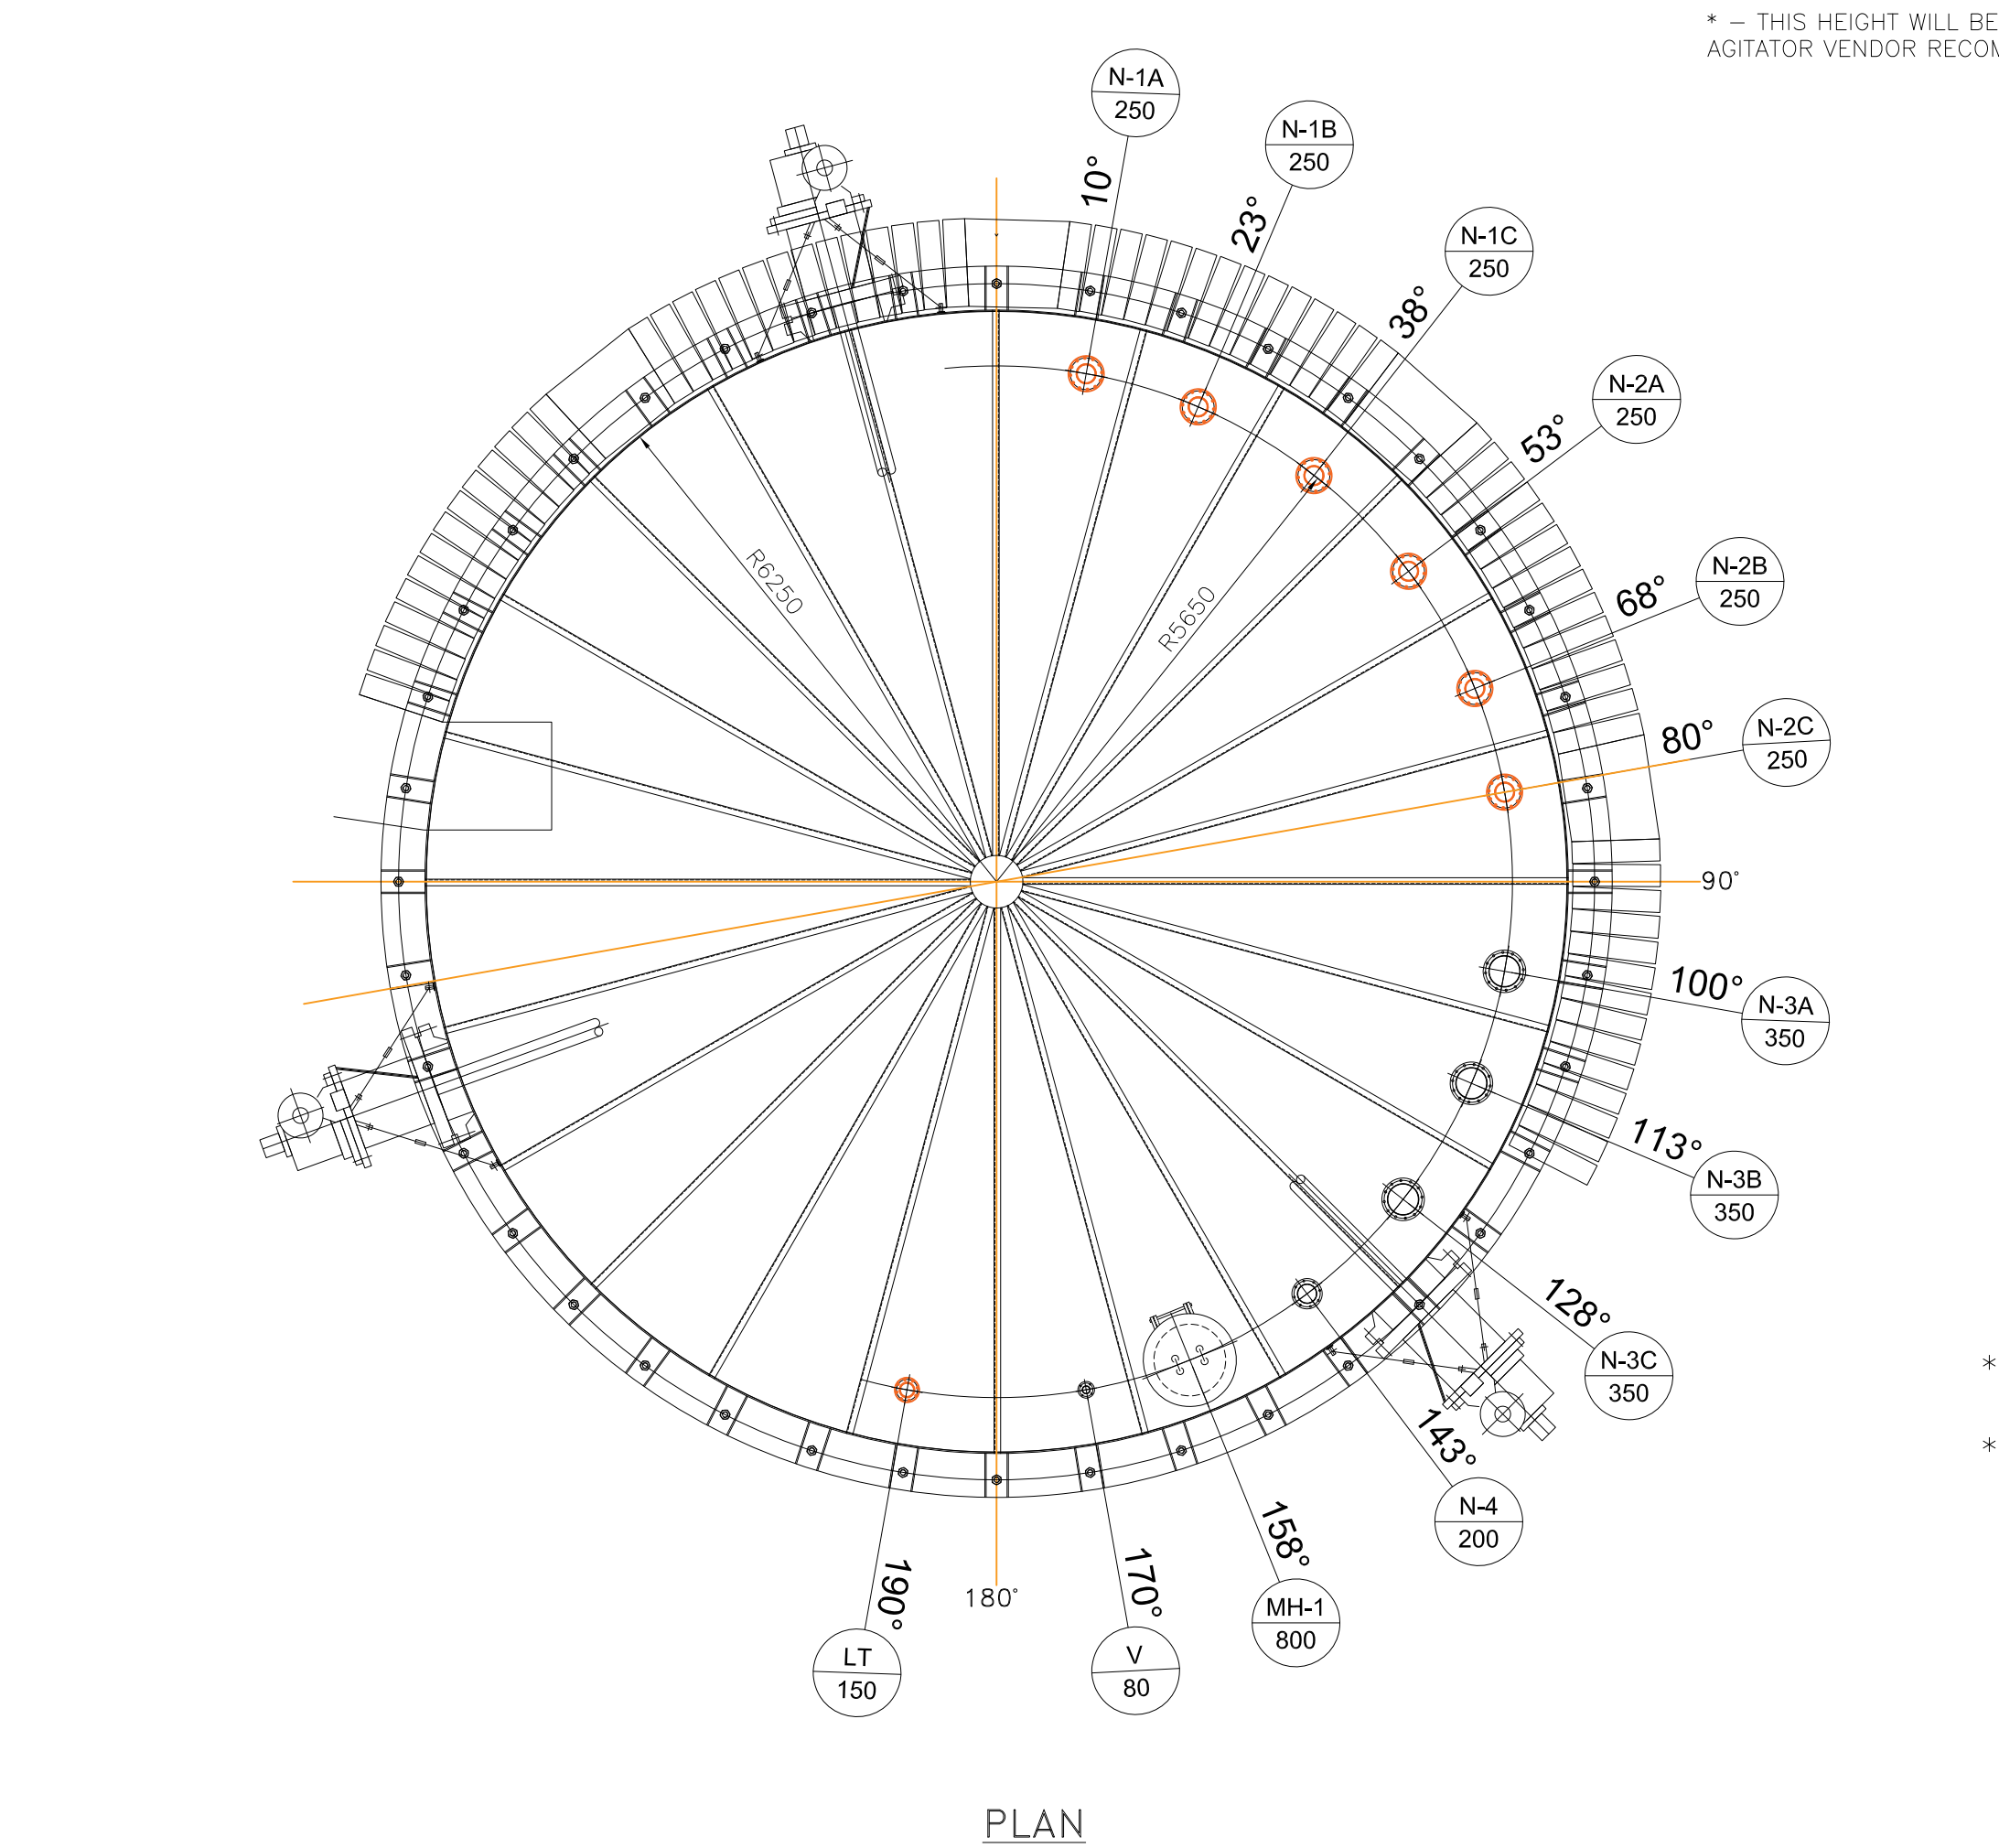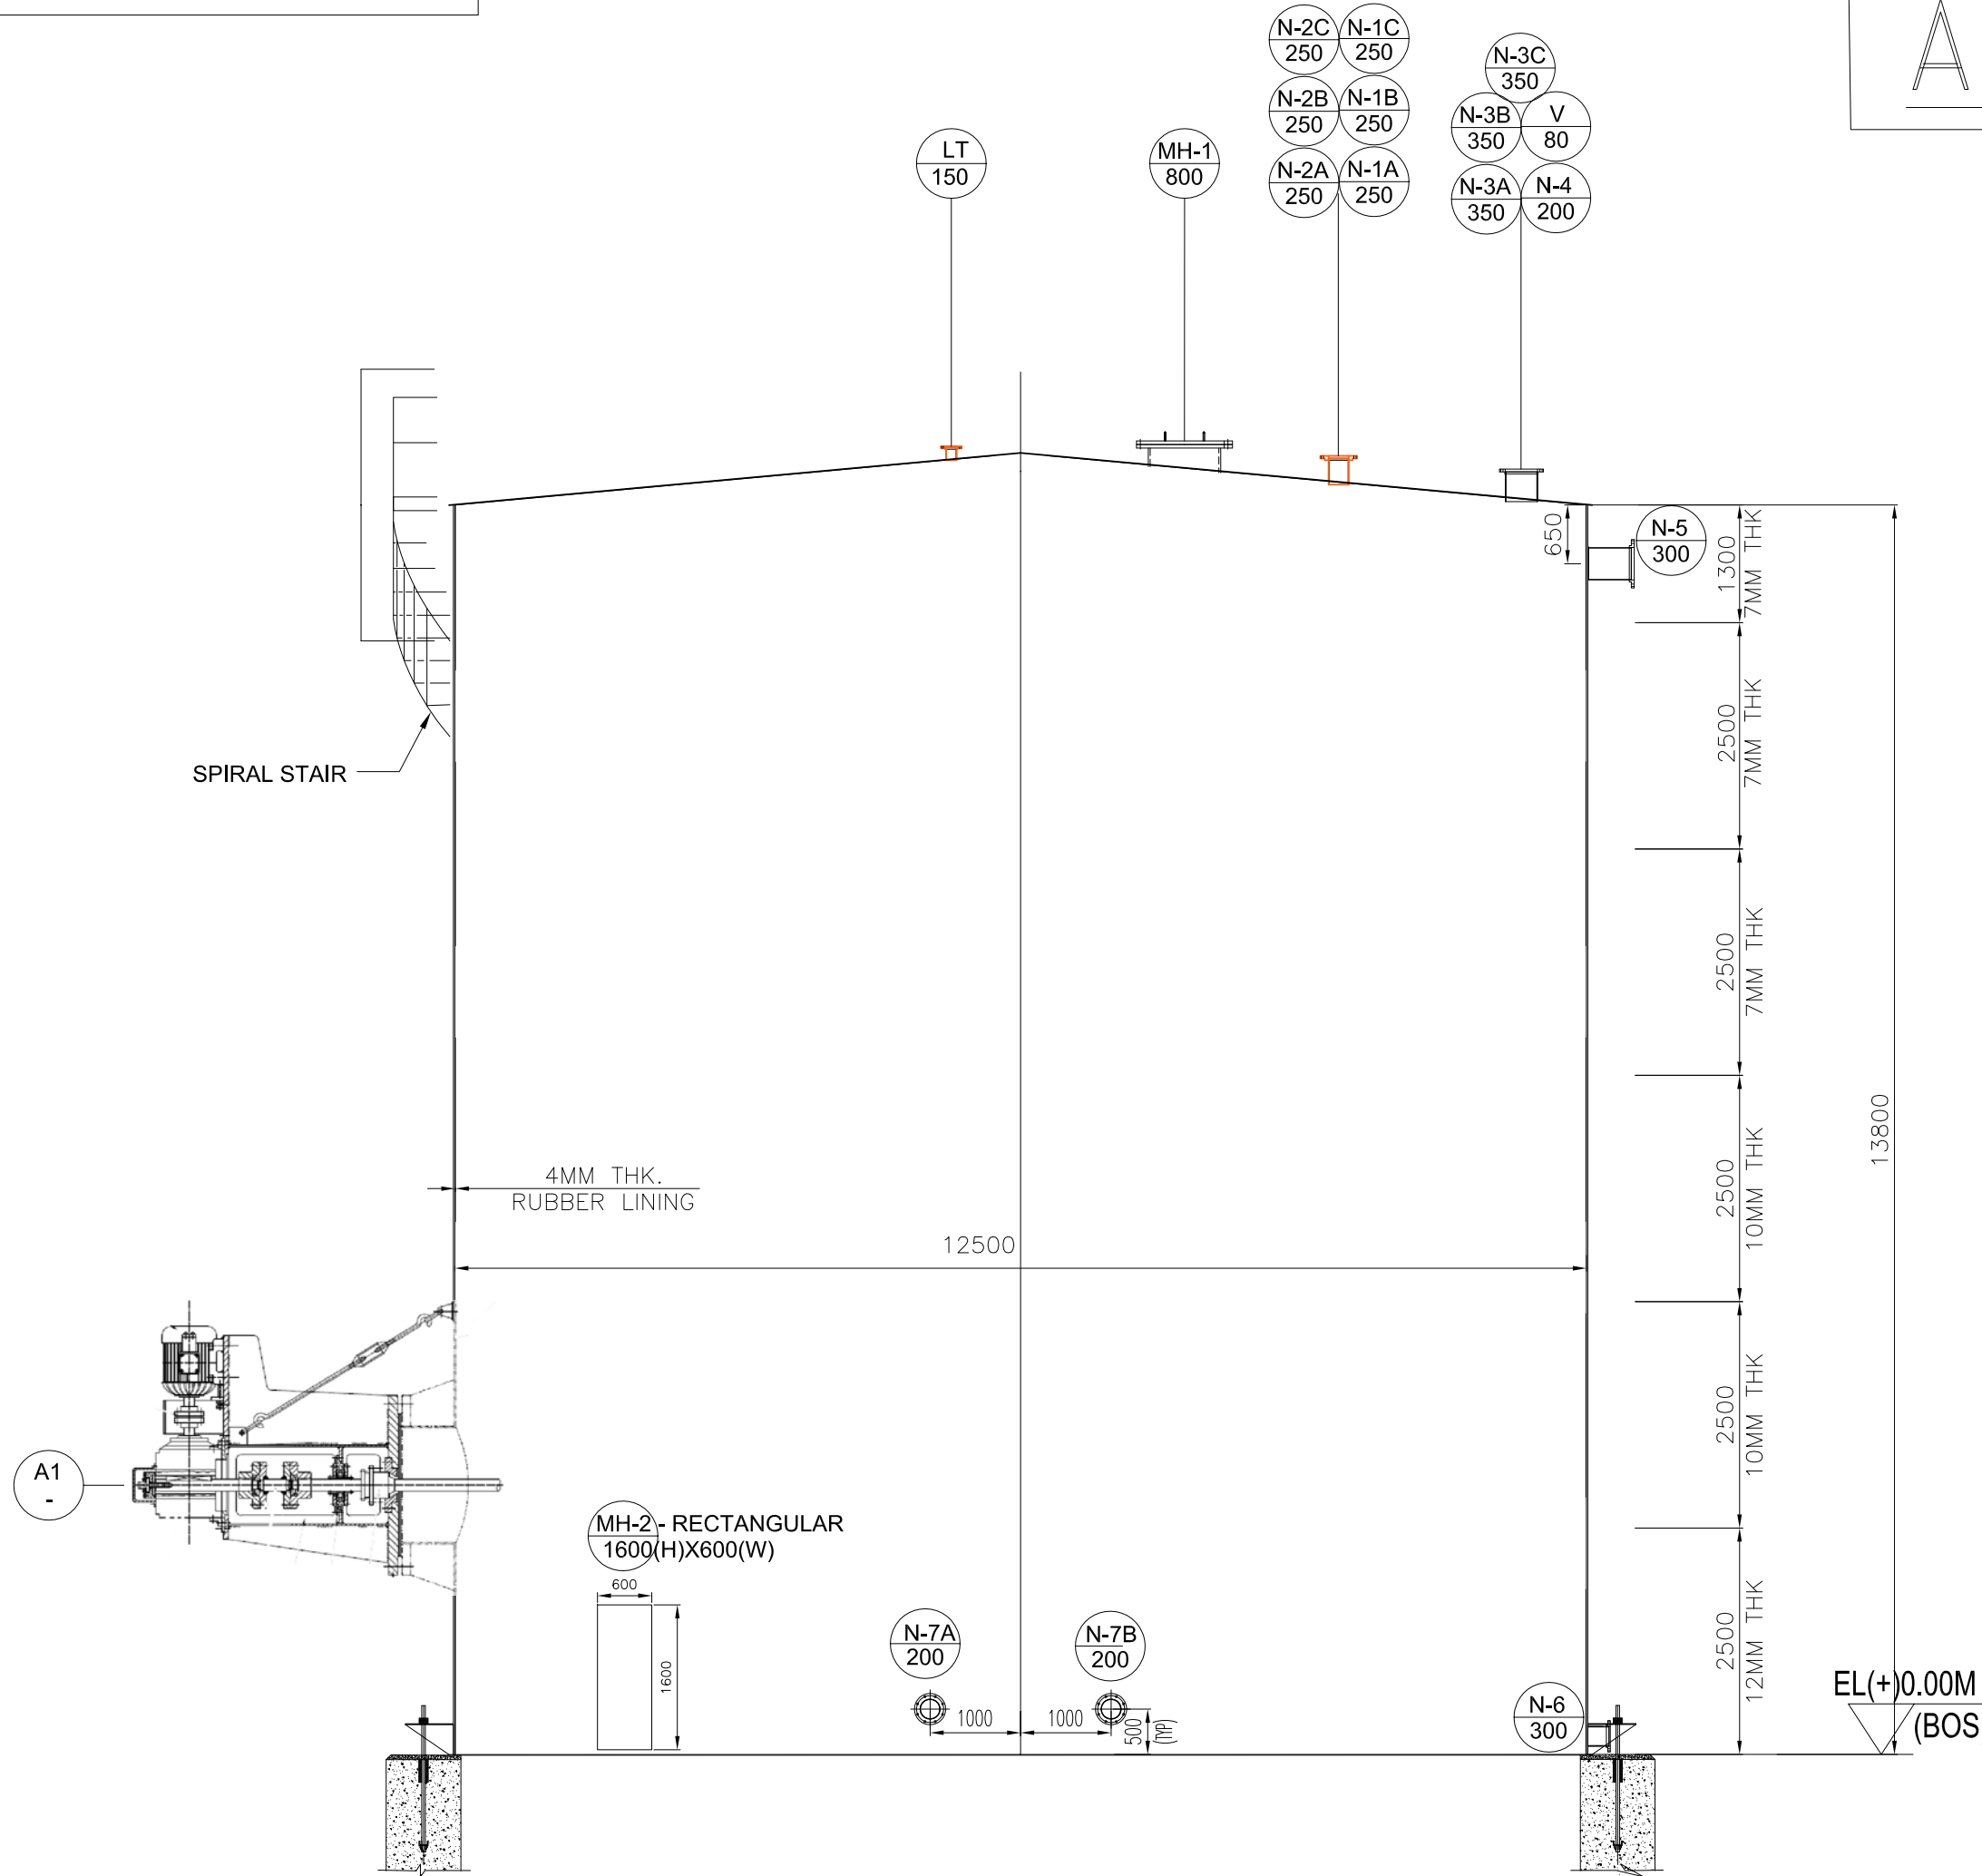

DESIGN DATA		
DESIGN CODE	—	IS:803 1976 (REAFFIRMED 2013)
STORAGE PRODUCT	—	GYP SUM BLEED/SLURRY
TANK CAPACITY (HOLD VOLUME)	M ³	1595
TANK CAPACITY (EFFECTIVE)	M ³	1570
TYPE OF TANK	—	VERTICAL CYLINDRICAL FIXED CONE ROOF
ROOF SLOPE	—	5°
DESIGN PRESSURE	—	HYDROSTATIC HEAD
OPERATING PRESSURE	—	ATMOSPHERIC
OPERATING TEMPERATURE	°C	63
HYDOR TESTING	—	WATER FILLED HEAD UPTO OVERFLOW NOZZLE
JOINT EFFECIENCY	—	0.7
RADIOGRAPHY	—	NO APPLICABLE
CORROSION ALLOWANCE	MM	1.5MM FOR SHELL AND BOTTOM PLATE
WIND CODE	—	AS PER CONTRACT SPECIFICATION
SEISMIC CODE	—	AS PER CONTRACT SPECIFICATION
NO. OF TANK	NO.	01
DIAMETER (I.D)	MM	12500
HEIGHT	MM	13800
ROOF PLATE THICKNESS	MM	8
SHELL PLATE THICKNESS	MM	12,10,8,7 (REFER ELEVATION)
BOTTOM PLATE THICKNESS	MM	8
INSULATION	—	NOT APPLICABLE
INSIDE LINING	—	4MM THICK OF BEST QUALITY BROMINE BUTYL RUBBER LINING WITH HARDNESS 55±5 (SHORE A HARDNESS)

MATERIAL SPECIFICATION	
ITEM	MATERIAL
SHELL, ROOF, BASE AND BAFFLE PLATE	IS:2062 E250 GRADE BR
STRUCTURES	IS:2062 E250 GRADE A/BR
STAIRWAYS & PLTFs	IS:2062 E250 GRADE A/BR
MANHOLE	IS:2062 E250 GRADE BR
NOZZLE	A106 Gr B
NOZZLE FLANGES	IS:2062 E250 GRADE BR
NOZZLE REINFORCEMNT	IS:2062 E250 GRADE BR
NOZZLE NECKS	IS:1239
HAND RAILING	IS:1161
GASKETS	BUTYL RUBBER
BOLT	IS: 1367 CLASS 4.4
FITTINGS	A-105
EARTHING LUG	IS:2062 E250 GRADE BR
ANCHOR BOLT	IS:2062 E250 GRADE BR

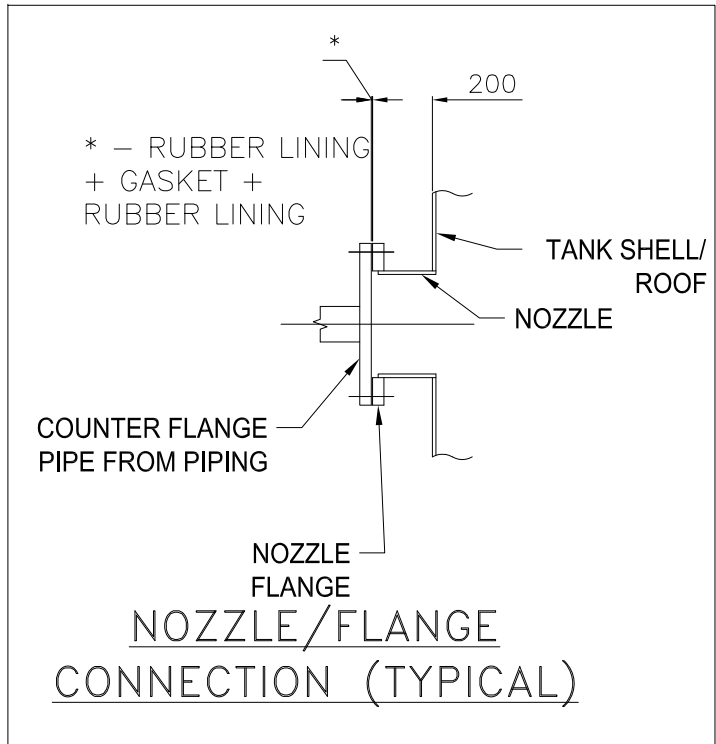

NOZZLE SCHEDULE								
NOZZLE			QTY	FLANGE			SERVICE	REMARKS
MARK	SIZE	Sch. No.		RATING	FACING	STANDARD		
A-1	—	—	3	—	—	—	AGITATOR	
MH-1	NB800	—	1	—	SOFF	PLATE	MANHOLE	WITH HINGE
MH-2	1600(H)X 600(W)	—	1	PLATE	SOFF	—	MANHOLE	FOR ENTRY WITH WHEELBARROW
N-1A/B/C	NB250	—	3	150	SOFF	ANSI B16.5	LIQUID INLET	
N-2A/B/C	NB250	—	3	150	SOFF	ANSI B16.5	LIQUID INLET	
N-3A/B/C	NB350	—	3	150	SOFF	ANSI B16.5	LIQUID INLET	
LT	NB150	—	1	150	SOFF	ANSI B16.5	LEVEL TRANSMITTER	
V	NB80	—	1	150	SOFF	ANSI B16.5	VENT	
N-4	NB200	—	1	150	SOFF	ANSI B16.5	MINIMUM FLOW	
N-5	NB300	—	1	150	SOFF	ANSI B16.5	OVER FLOW	
N-6	NB300	—	1	150	SOFF	ANSI B16.5	BOTTOM DRAIN	
N-7A/B	NB200	—	2	150	SOFF	ANSI B16.5	PUMP SUCTION	


- NOTES:
- ALL DIMENSIONS ARE IN MM, UNLESS SPECIFIED OTHERWISE.
 - OUTSIDE NOZZLE PROJECTION IS 200MM UNLESS OTHERWISE SPECIFIED.
 - NOZZLE REINFORCEMENTS SHALL BE AS PER IS:803.
 - NOZZLE PROJECTIONS ARE MEASURED FROM TANK SHELL INNER TO THE FLANGE FACE AS APPLICABLE.
 - ALL REINFORCEMENT PADS SHALL BE PROVIDED WITH 6MM TELLTALE HOLE.
 - NOZZLE AND FLANGE DETAILS SHALL BE AS PER IS:803.
 - ALL BOLT HOLES SHALL STRADDLE VERTICAL CENTERLINES ON SHELL AND RADIAL CENTERLINES ON ROOF.
 - ALL PROTRUSIONS, SHARP EDGES AND SPATTER, ETC. SHALL BE REMOVED FROM THE SURFACE AND ALL WELDS GROUND SMOOTH WITHOUT ANY CAVITIES AND IMPERFECTION BEFORE LINING.
 - HYDRO TEST SHALL BE AS PER IS:803. LINING SHALL BE CARRIED-OUT AFTER HYDRO TEST.
 - ALL LONGITUDINAL JOINTS SHALL BE STAGGERED.
 - BOTTOM PLATE SHALL UNIFORMLY REST ON THE FOUNDATION.
 - THE MINIMUM SIZE OF WELD SHALL BE EQUAL TO THE THICKNESS OF THINNER MEMBER JOINT UNLESS SPECIFIED OTHERWISE.
 - EARTHING LUG SHALL BE WELDED TO TANK BODY AT SITE TO SUIT SITE REQUIREMENT.
 - NO OF AGITATOR SHALL BE IN LINE WITH THE AGITATOR SCHEDULE.


REV.	DATE	ALTD.	OKD.	APPD.
—	—	—	—	—
—	—	—	—	—

PROJECT:	3X660MW NABINAGAR STPP (SYSTEM : FLUE GAS DESULPHURIZATION)		
CUSTOMER:	NTPC LIMITED. (A GOVERNMENT OF INDIA ENTERPRISE)		
DEPT. CODE:	DRN	NAME	SIGN
M	CHD		
APPD.			
TITLE:	GENERAL ARRANGEMENT AND DATA SHEET OF AUXILIARY ABSORBENT (STORAGE) TANK		
DRAWING NO.	SKETCH-06	SH 01 OF 02	REV.00

SCALE : NTS




ANNEXURE-IV

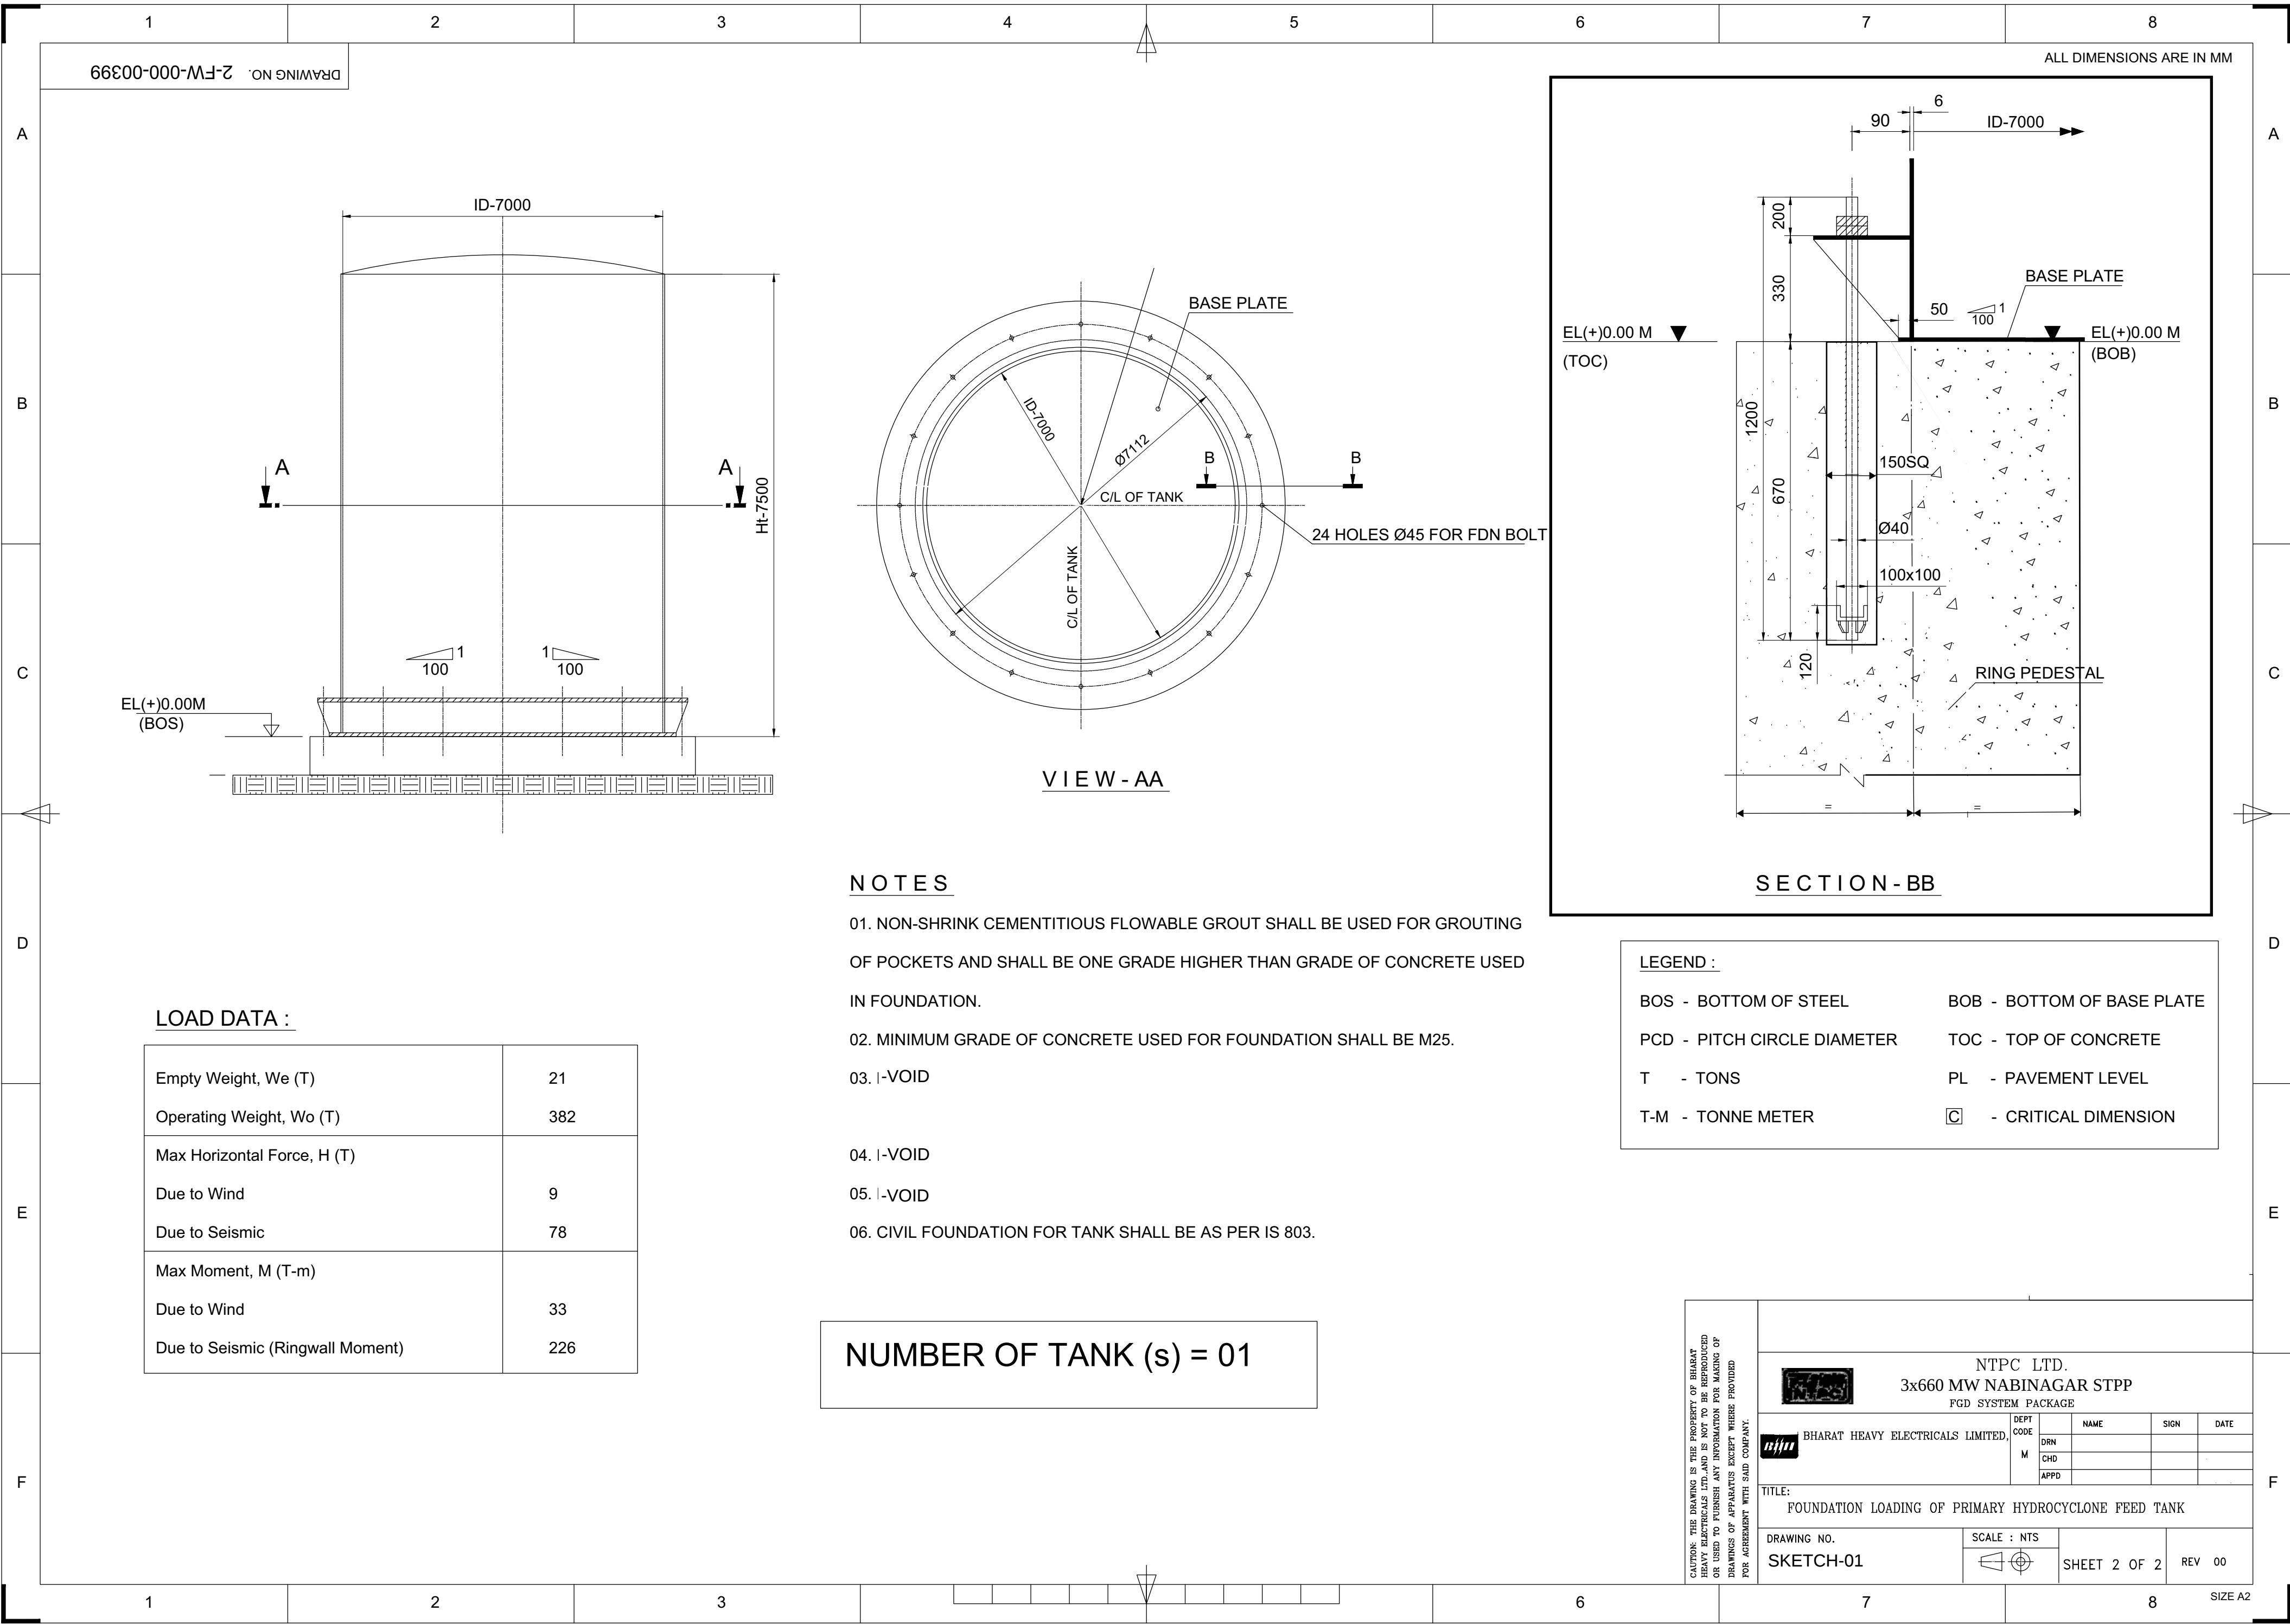

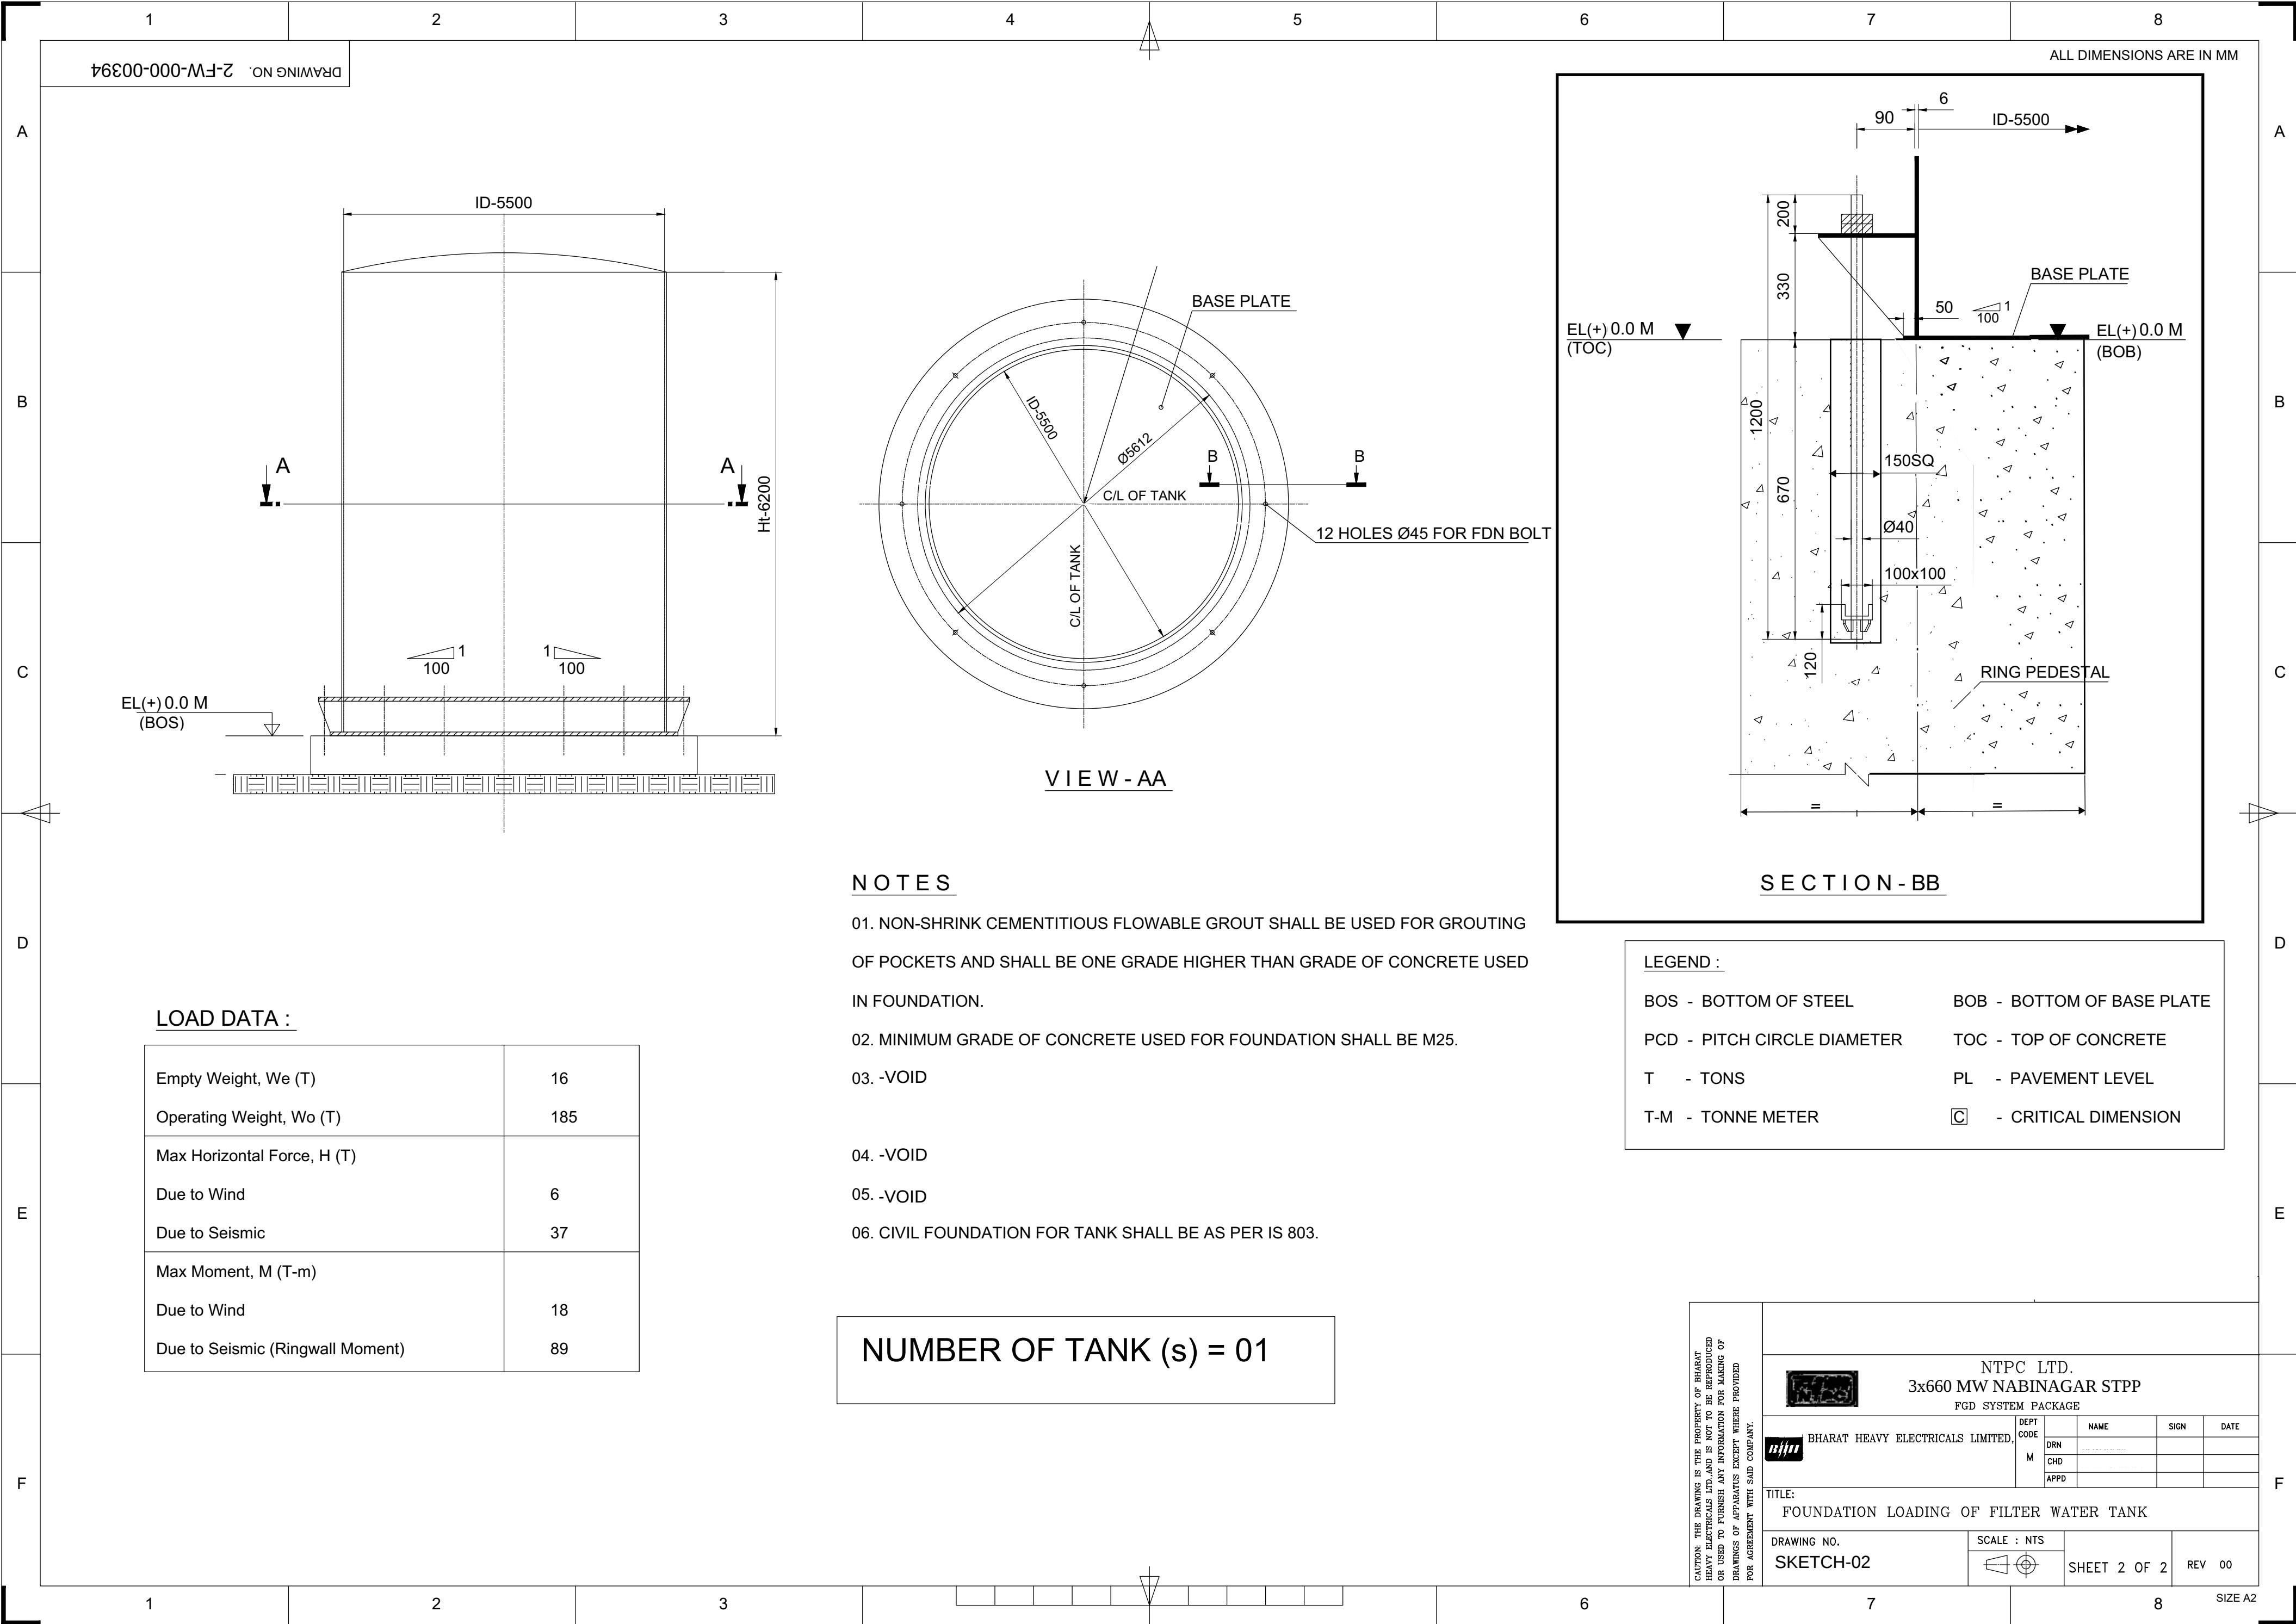

DRAWING NO. 2-FW-000-00394

ALL DIMENSIONS ARE IN MM

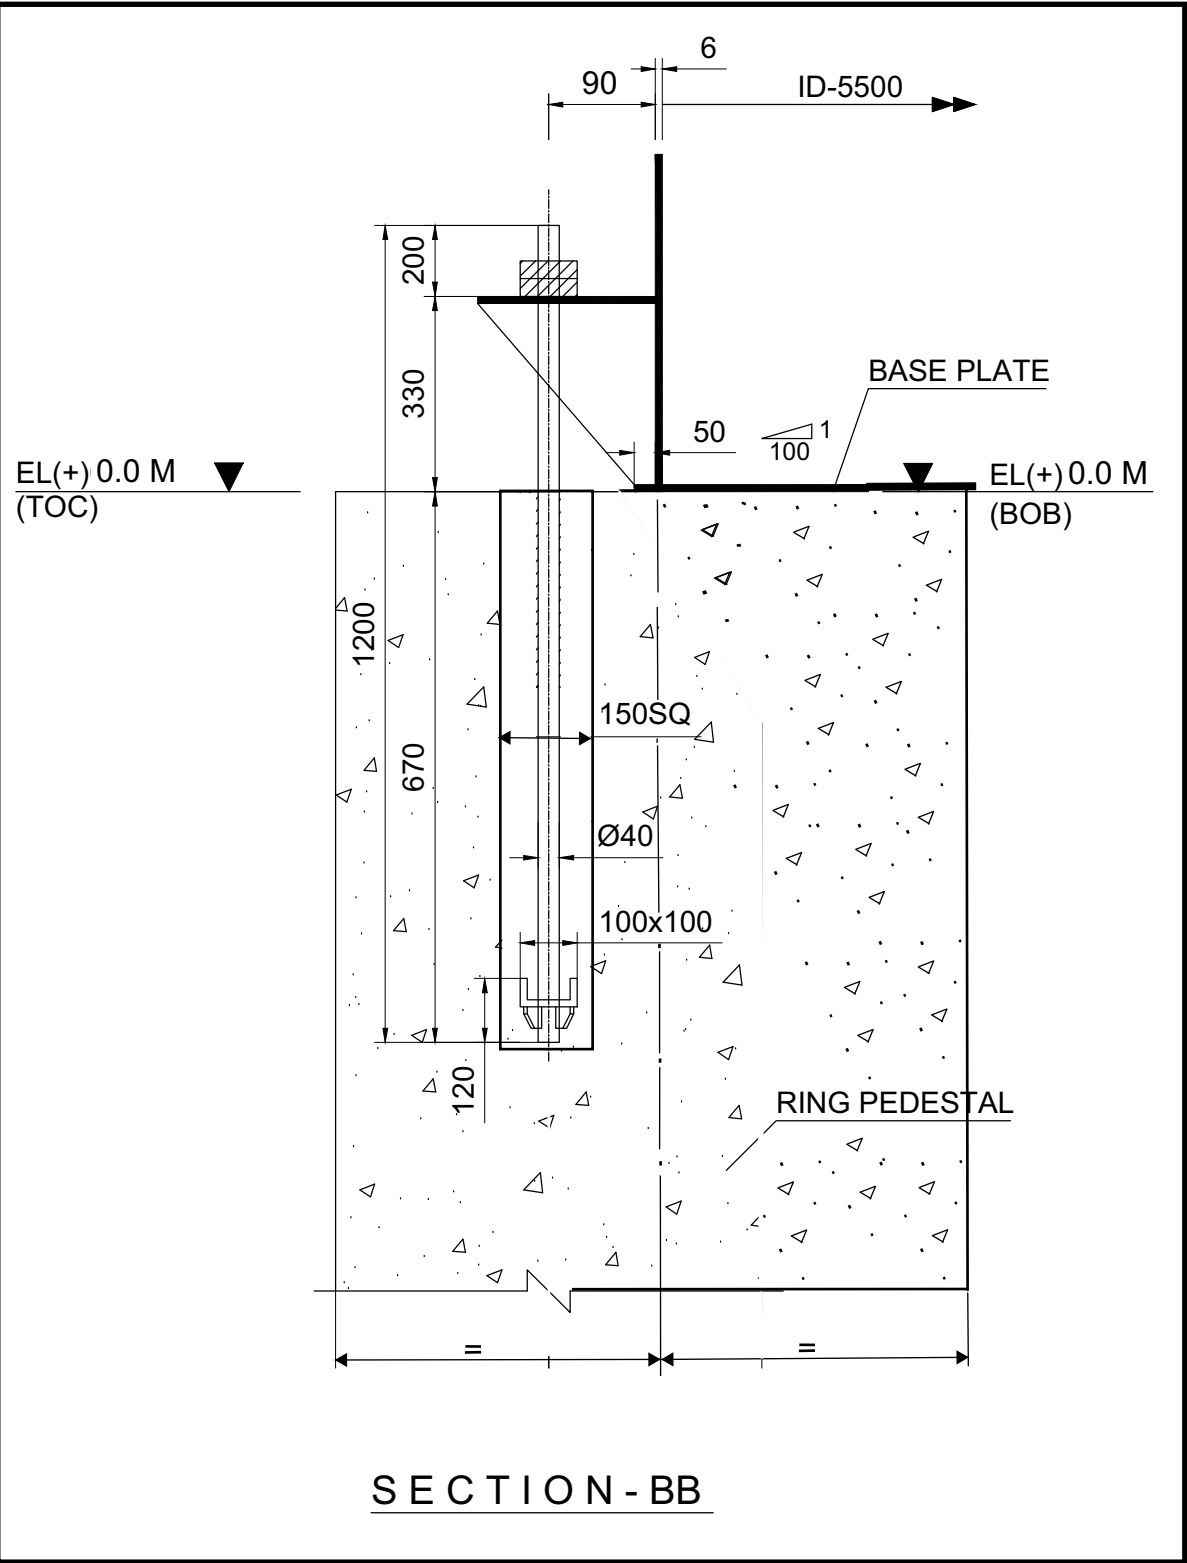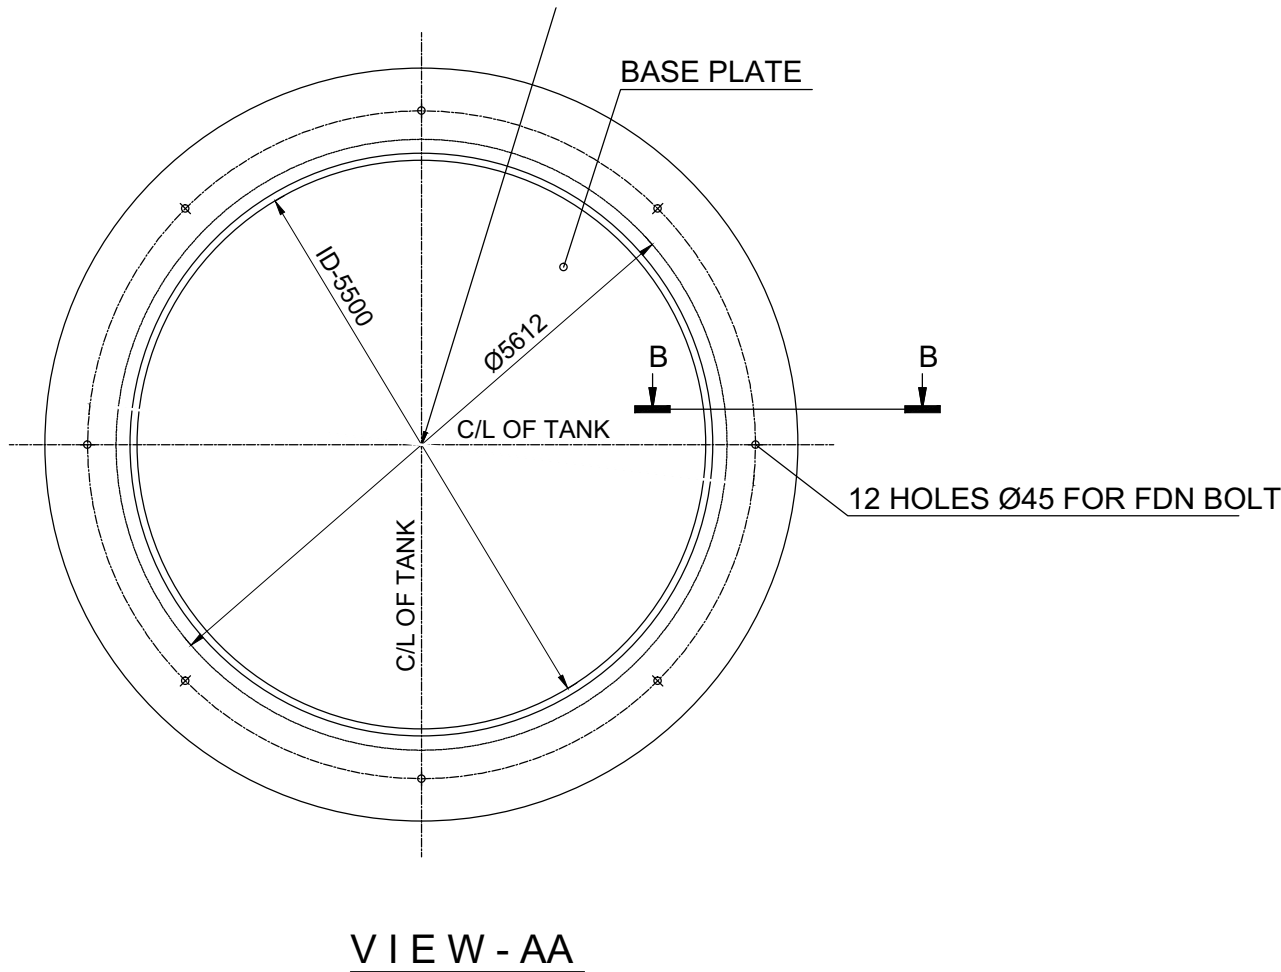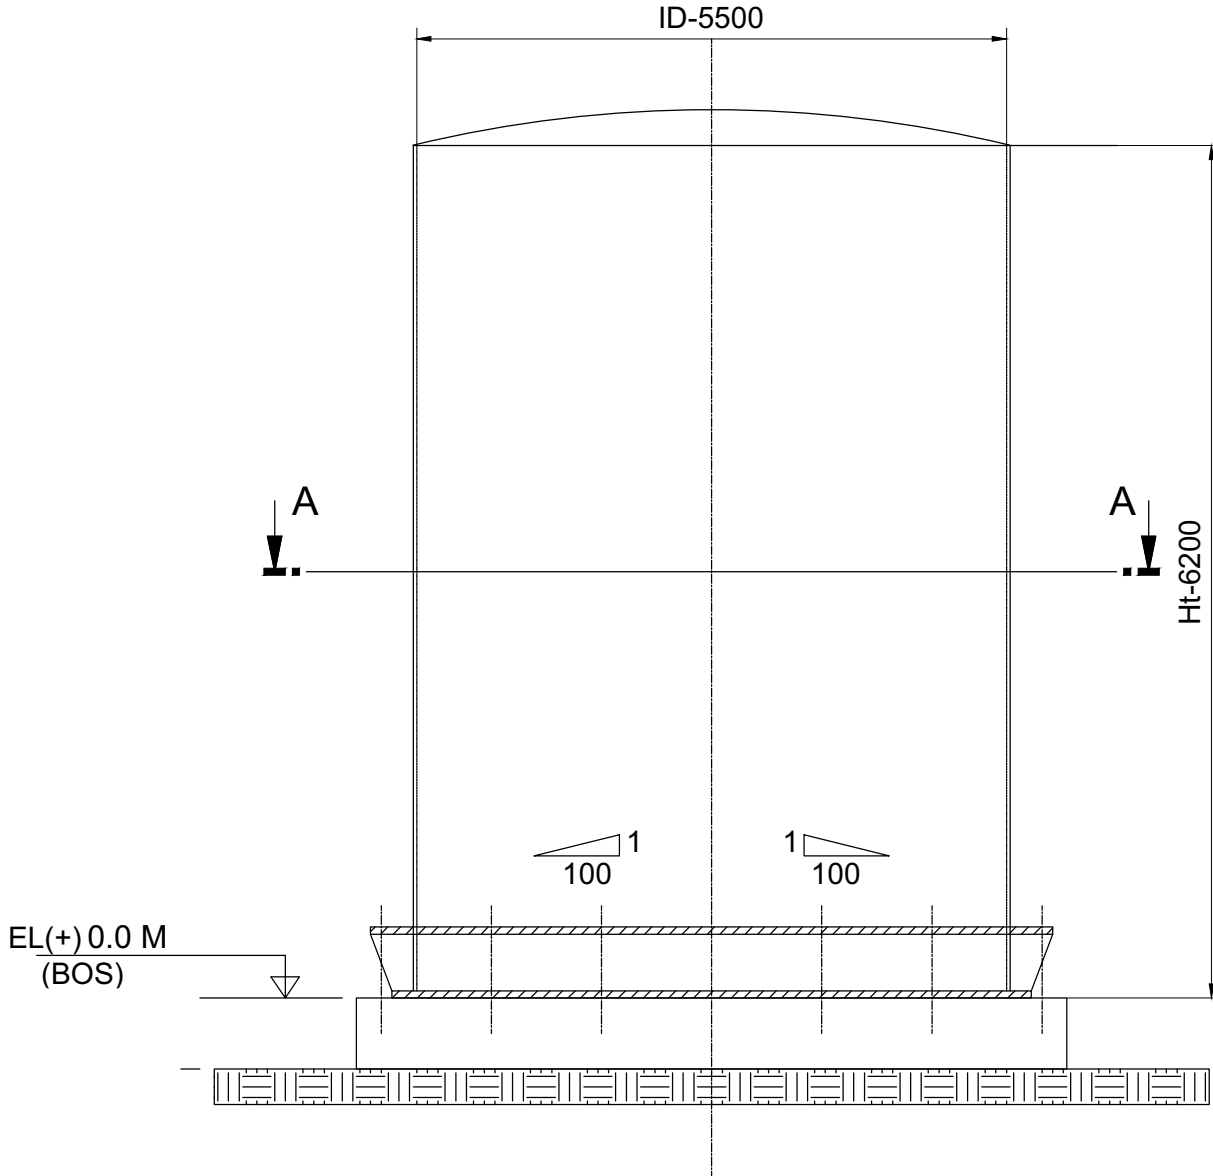

LOAD DATA :

Empty Weight, We (T)	16
Operating Weight, Wo (T)	185
Max Horizontal Force, H (T)	
Due to Wind	6
Due to Seismic	37
Max Moment, M (T-m)	
Due to Wind	18
Due to Seismic (Ringwall Moment)	89

NOTES

01. NON-SHRINK CEMENTITIOUS FLOWABLE GROUT SHALL BE USED FOR GROUTING OF POCKETS AND SHALL BE ONE GRADE HIGHER THAN GRADE OF CONCRETE USED IN FOUNDATION.
02. MINIMUM GRADE OF CONCRETE USED FOR FOUNDATION SHALL BE M25.
03. -VOID
04. -VOID
05. -VOID
06. CIVIL FOUNDATION FOR TANK SHALL BE AS PER IS 803.

NUMBER OF TANK (s) = 01


LEGEND :

- BOS - BOTTOM OF STEEL BOB - BOTTOM OF BASE PLATE
PCD - PITCH CIRCLE DIAMETER TOC - TOP OF CONCRETE
T - TONS PL - PAVEMENT LEVEL
T-M - TONNE METER [C] - CRITICAL DIMENSION

CAUTION: THE DRAWING IS THE PROPERTY OF BHARAT HEAVY ELECTRICALS LTD. AND IS NOT TO BE REPRODUCED OR USED TO FURNISH ANY INFORMATION FOR MAKING OF DRAWINGS OF APPARATUS EXCEPT WHERE PROVIDED FOR AGREEMENT WITH SAID COMPANY.

NTPC LTD. 3x660 MW NABINAGAR STPP FGD SYSTEM PACKAGE				
BHARAT HEAVY ELECTRICALS LIMITED.	DEPT CODE	NAME	SIGN	DATE
	M	DRN		
	CHD			
	APPD			
TITLE: FOUNDATION LOADING OF FILTER WATER TANK				
DRAWING NO. SKETCH-02		SCALE : NTS	SHEET 2 OF 2	REV 00

SIZE A2

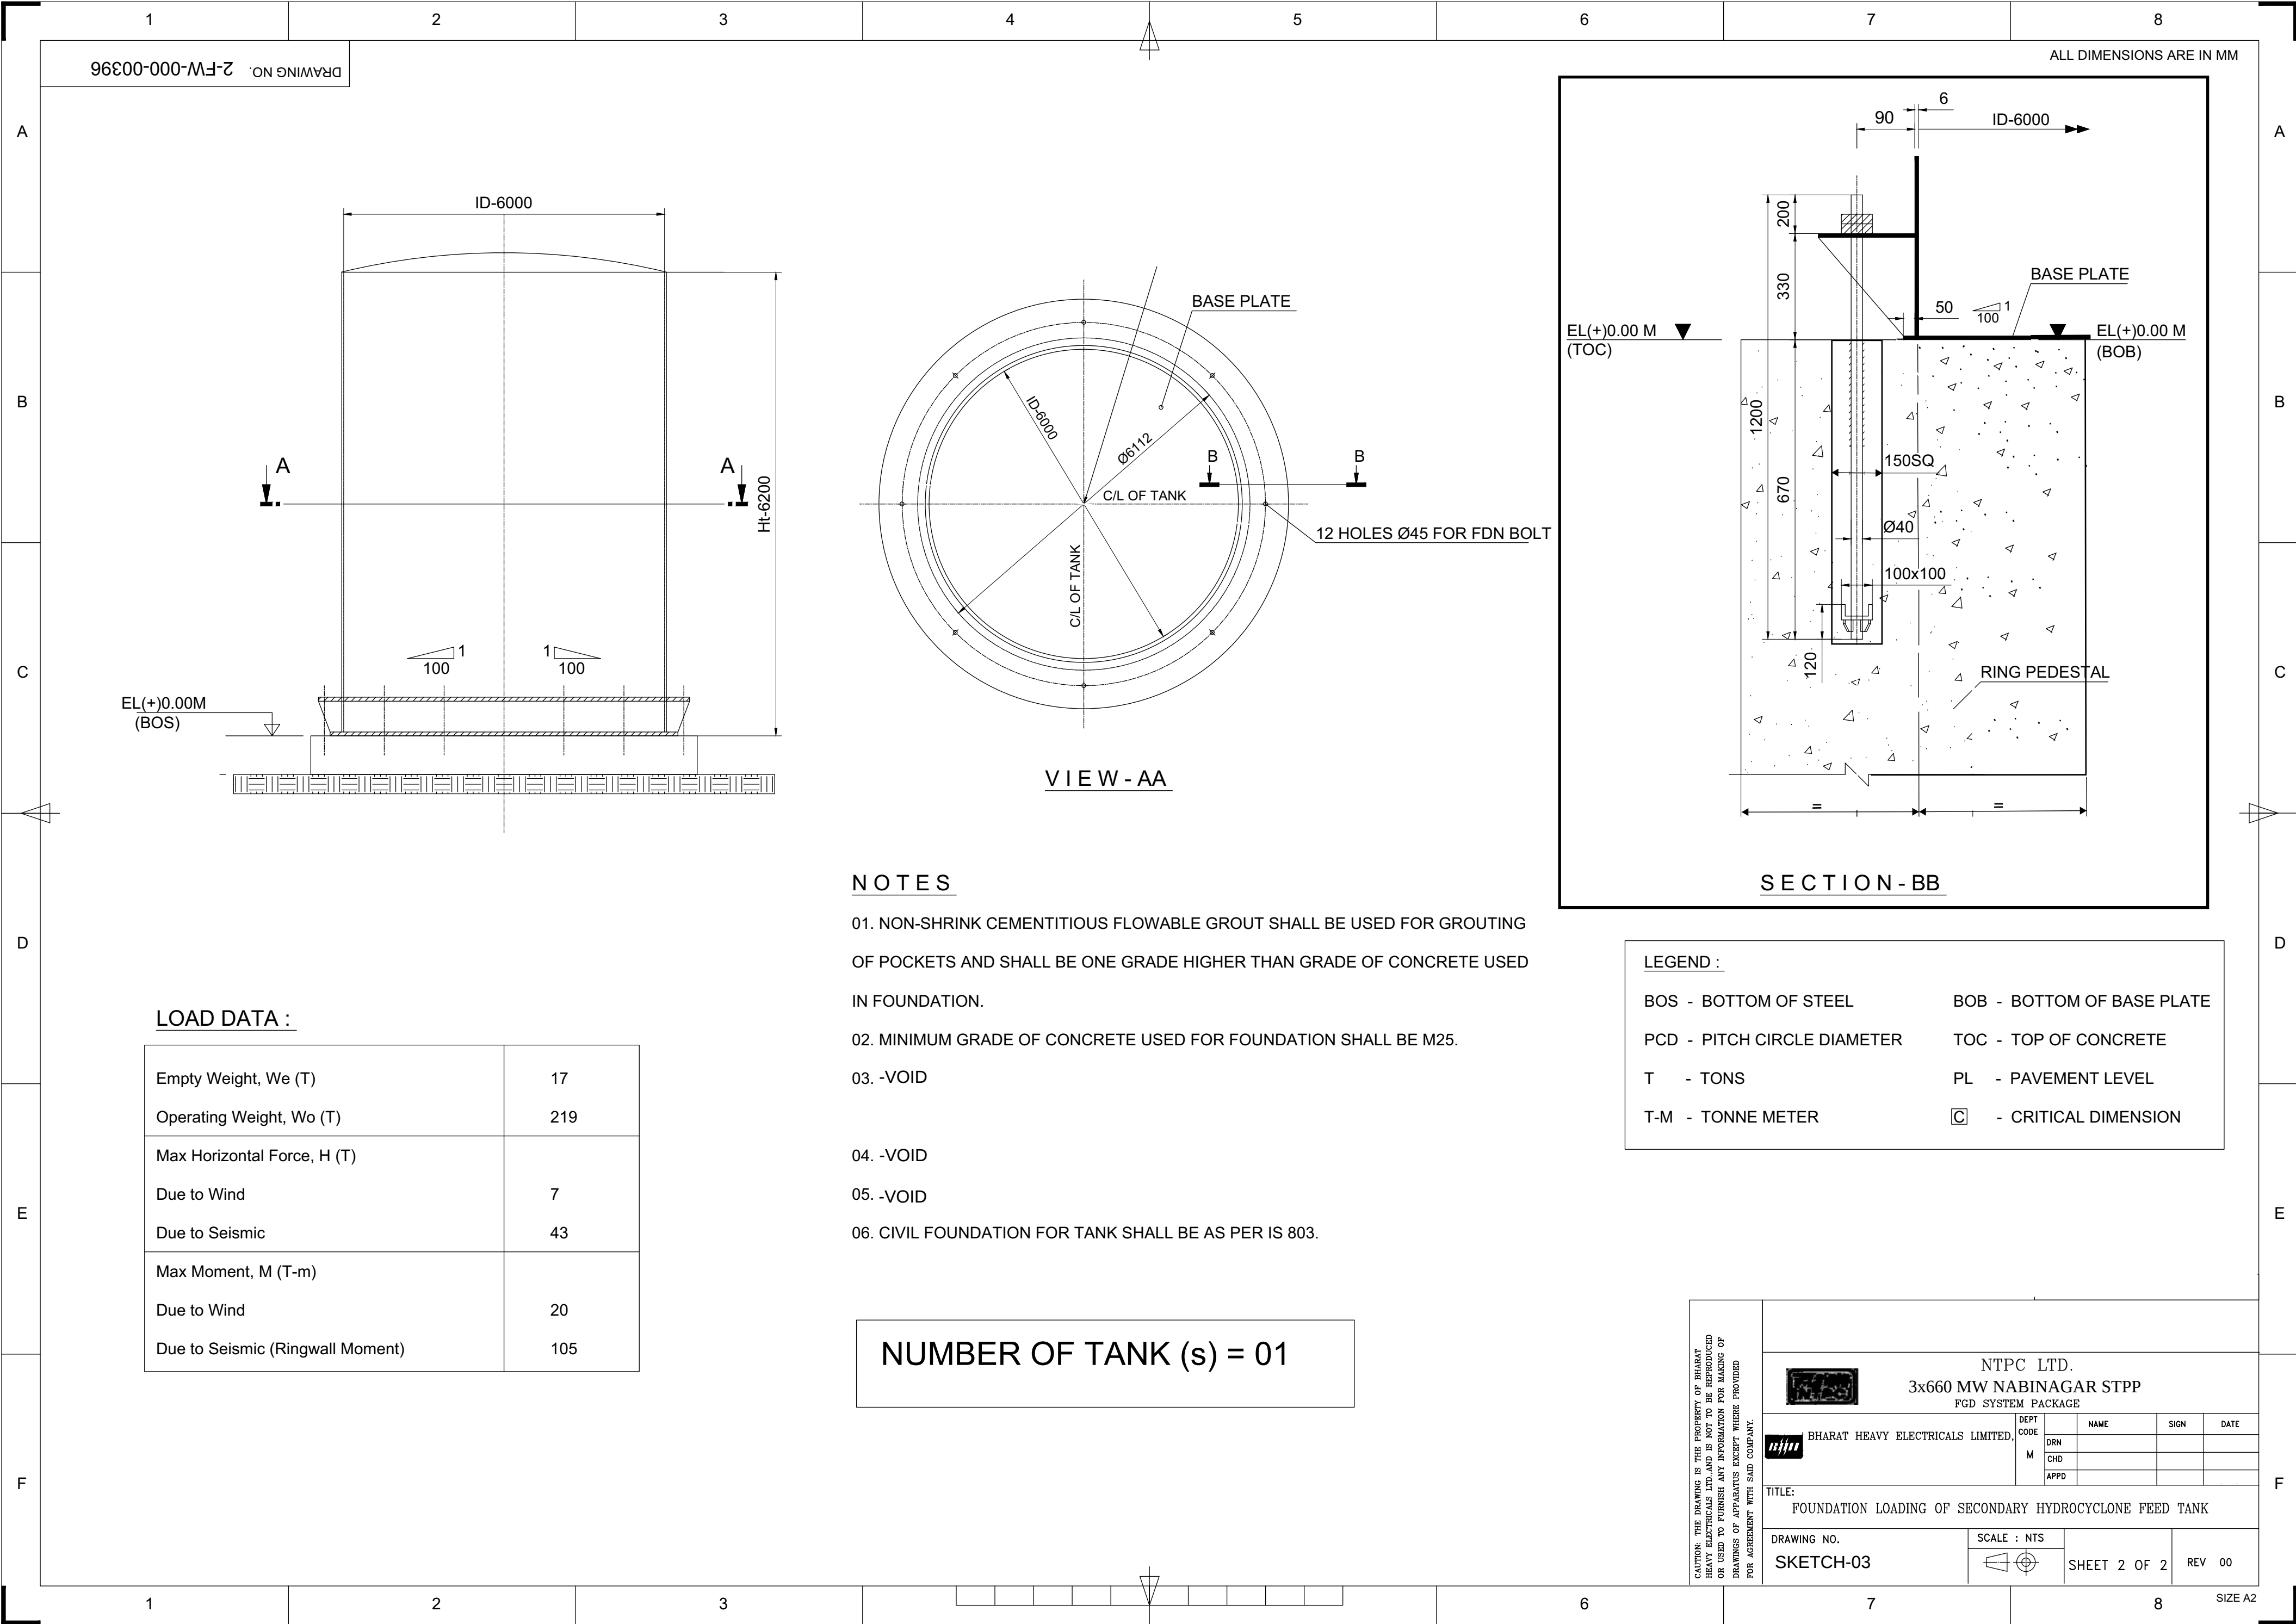

DRAWING NO. 2-FW-000-00396

ALL DIMENSIONS ARE IN MM

VIEW - AA

SECTION - BB

NOTES

01. NON-SHRINK CEMENTITIOUS FLOWABLE GROUT SHALL BE USED FOR GROUTING OF POCKETS AND SHALL BE ONE GRADE HIGHER THAN GRADE OF CONCRETE USED IN FOUNDATION.
02. MINIMUM GRADE OF CONCRETE USED FOR FOUNDATION SHALL BE M25.
03. -VOID
04. -VOID
05. -VOID
06. CIVIL FOUNDATION FOR TANK SHALL BE AS PER IS 803.

LEGEND :

- | | |
|-----------------------------|----------------------------|
| BOS - BOTTOM OF STEEL | BOB - BOTTOM OF BASE PLATE |
| PCD - PITCH CIRCLE DIAMETER | TOC - TOP OF CONCRETE |
| T - TONS | PL - PAVEMENT LEVEL |
| T-M - TONNE METER | ☐ - CRITICAL DIMENSION |

LOAD DATA :


Empty Weight, We (T)	17
Operating Weight, Wo (T)	219
Max Horizontal Force, H (T)	
Due to Wind	7
Due to Seismic	43
Max Moment, M (T-m)	
Due to Wind	20
Due to Seismic (Ringwall Moment)	105


NUMBER OF TANK (s) = 01

CAUTION: THE DRAWING IS THE PROPERTY OF BHARAT HEAVY ELECTRICALS LTD. AND IS NOT TO BE REPRODUCED OR USED TO FURNISH ANY INFORMATION FOR MAKING OF DRAWINGS OF APPARATUS EXCEPT WHERE PROVIDED FOR AGREEMENT WITH SAID COMPANY.

NTPC LTD. 3x660 MW NABINAGAR STPP FGD SYSTEM PACKAGE					
	DEPT	NAME	SIGN	DATE	
	CODE				
	DRN				
	CHD				
	APPD				
TITLE: FOUNDATION LOADING OF SECONDARY HYDROCYCLONE FEED TANK					
DRAWING NO. SKETCH-03		SCALE : NTS 	SHEET 2 OF 2	REV 00	

SIZE A2

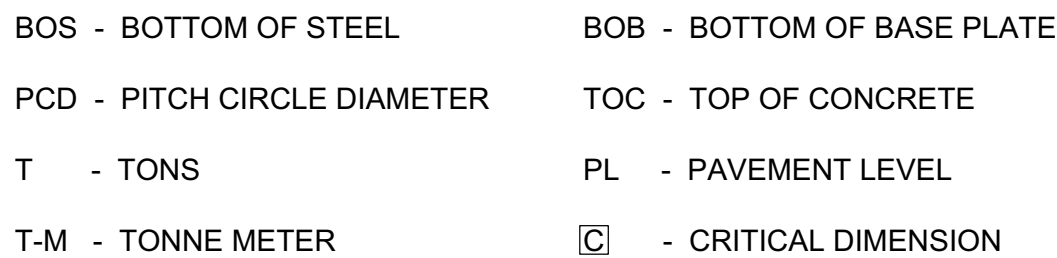

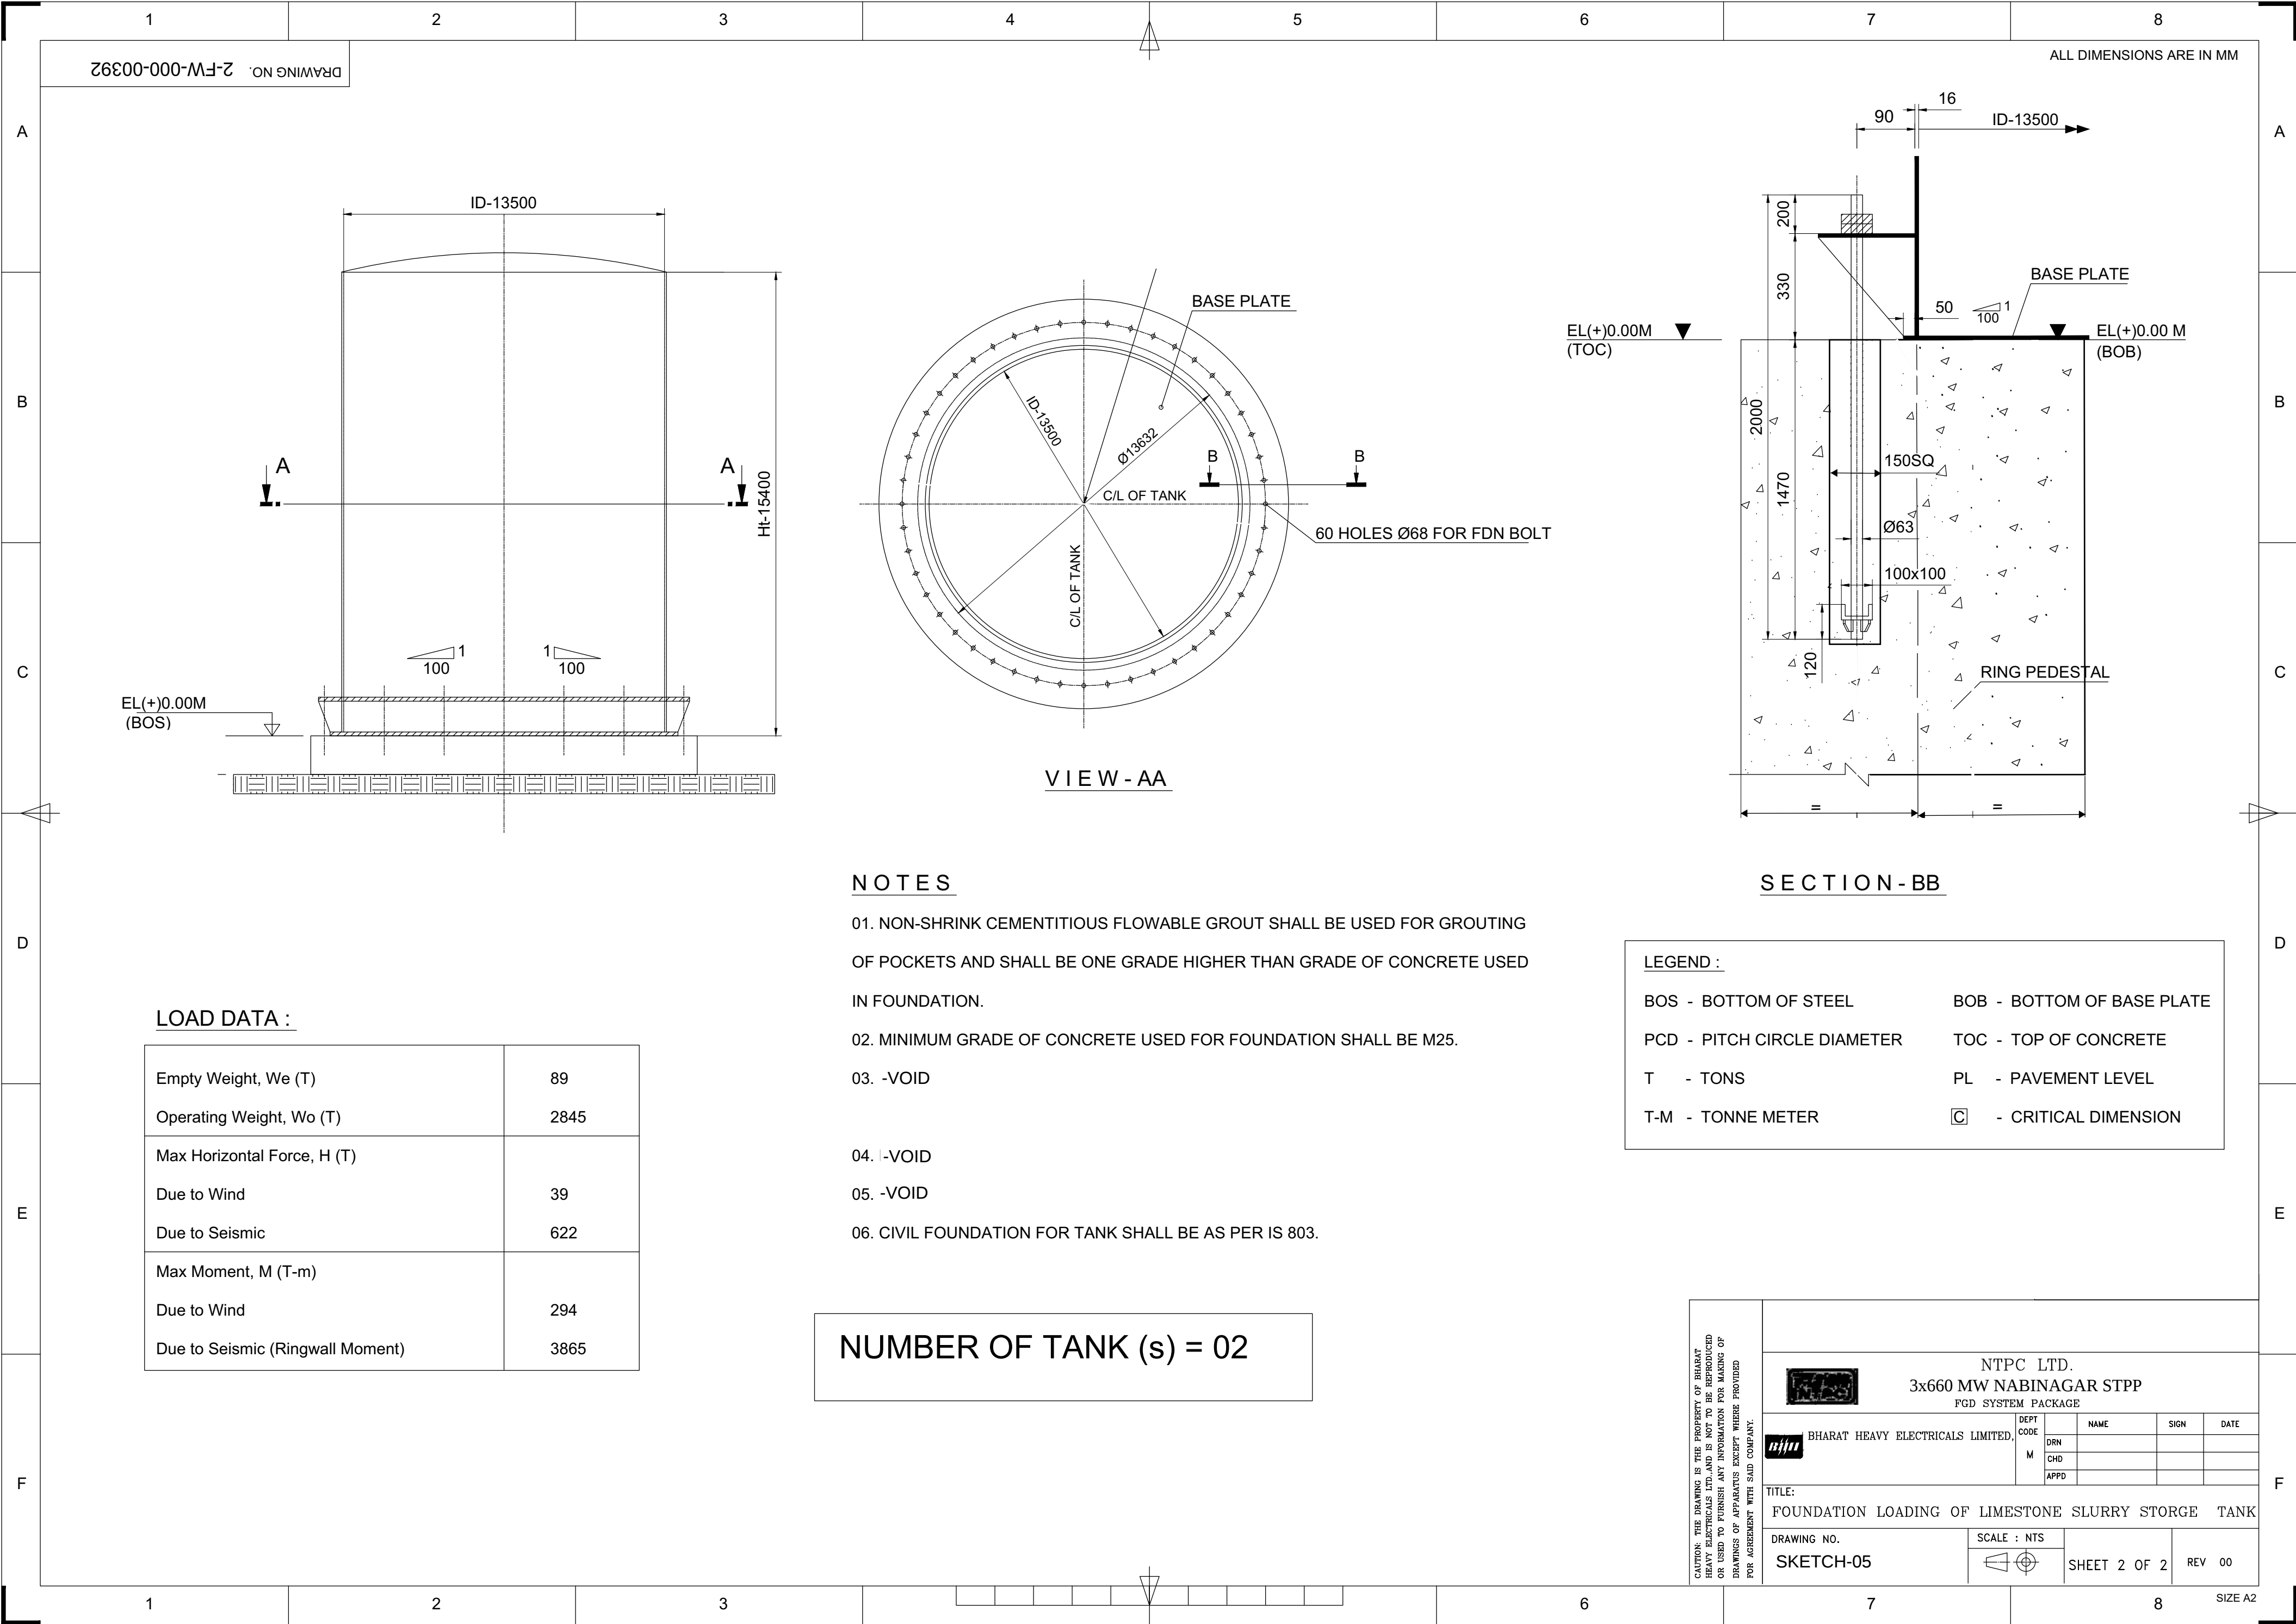

DRAWING NO. 2-FW-000-00392

ALL DIMENSIONS ARE IN MM

VIEW - AA

SECTION - BB

NOTES

- 01. NON-SHRINK CEMENTITIOUS FLOWABLE GROUT SHALL BE USED FOR GROUTING OF POCKETS AND SHALL BE ONE GRADE HIGHER THAN GRADE OF CONCRETE USED IN FOUNDATION.
- 02. MINIMUM GRADE OF CONCRETE USED FOR FOUNDATION SHALL BE M25.
- 03. -VOID
- 04. -VOID
- 05. -VOID
- 06. CIVIL FOUNDATION FOR TANK SHALL BE AS PER IS 803.

LOAD DATA :

Empty Weight, We (T)	89
Operating Weight, Wo (T)	2845
Max Horizontal Force, H (T)	
Due to Wind	39
Due to Seismic	622
Max Moment, M (T-m)	
Due to Wind	294
Due to Seismic (Ringwall Moment)	3865

LEGEND :


- BOS - BOTTOM OF STEEL
- BOB - BOTTOM OF BASE PLATE
- PCD - PITCH CIRCLE DIAMETER
- TOC - TOP OF CONCRETE
- T - TONS
- PL - PAVEMENT LEVEL
- T-M - TONNE METER
- C - CRITICAL DIMENSION

NUMBER OF TANK (s) = 02


CAUTION: THE DRAWING IS THE PROPERTY OF BHARAT HEAVY ELECTRICALS LTD. AND IS NOT TO BE REPRODUCED OR USED TO FURNISH ANY INFORMATION FOR MAKING OF DRAWINGS OF APPARATUS EXCEPT WHERE PROVIDED FOR AGREEMENT WITH SAID COMPANY.


NTPC LTD. 3x660 MW NABINAGAR STPP FGD SYSTEM PACKAGE					
	DEPT CODE	NAME	SIGN	DATE	
	M	DRN			
	CHD				
	APPD				
TITLE: FOUNDATION LOADING OF LIMESTONE SLURRY STORGE TANK					
DRAWING NO. SKETCH-05		SCALE : NTS	SHEET 2 OF 2	REV 00	


SIZE A2

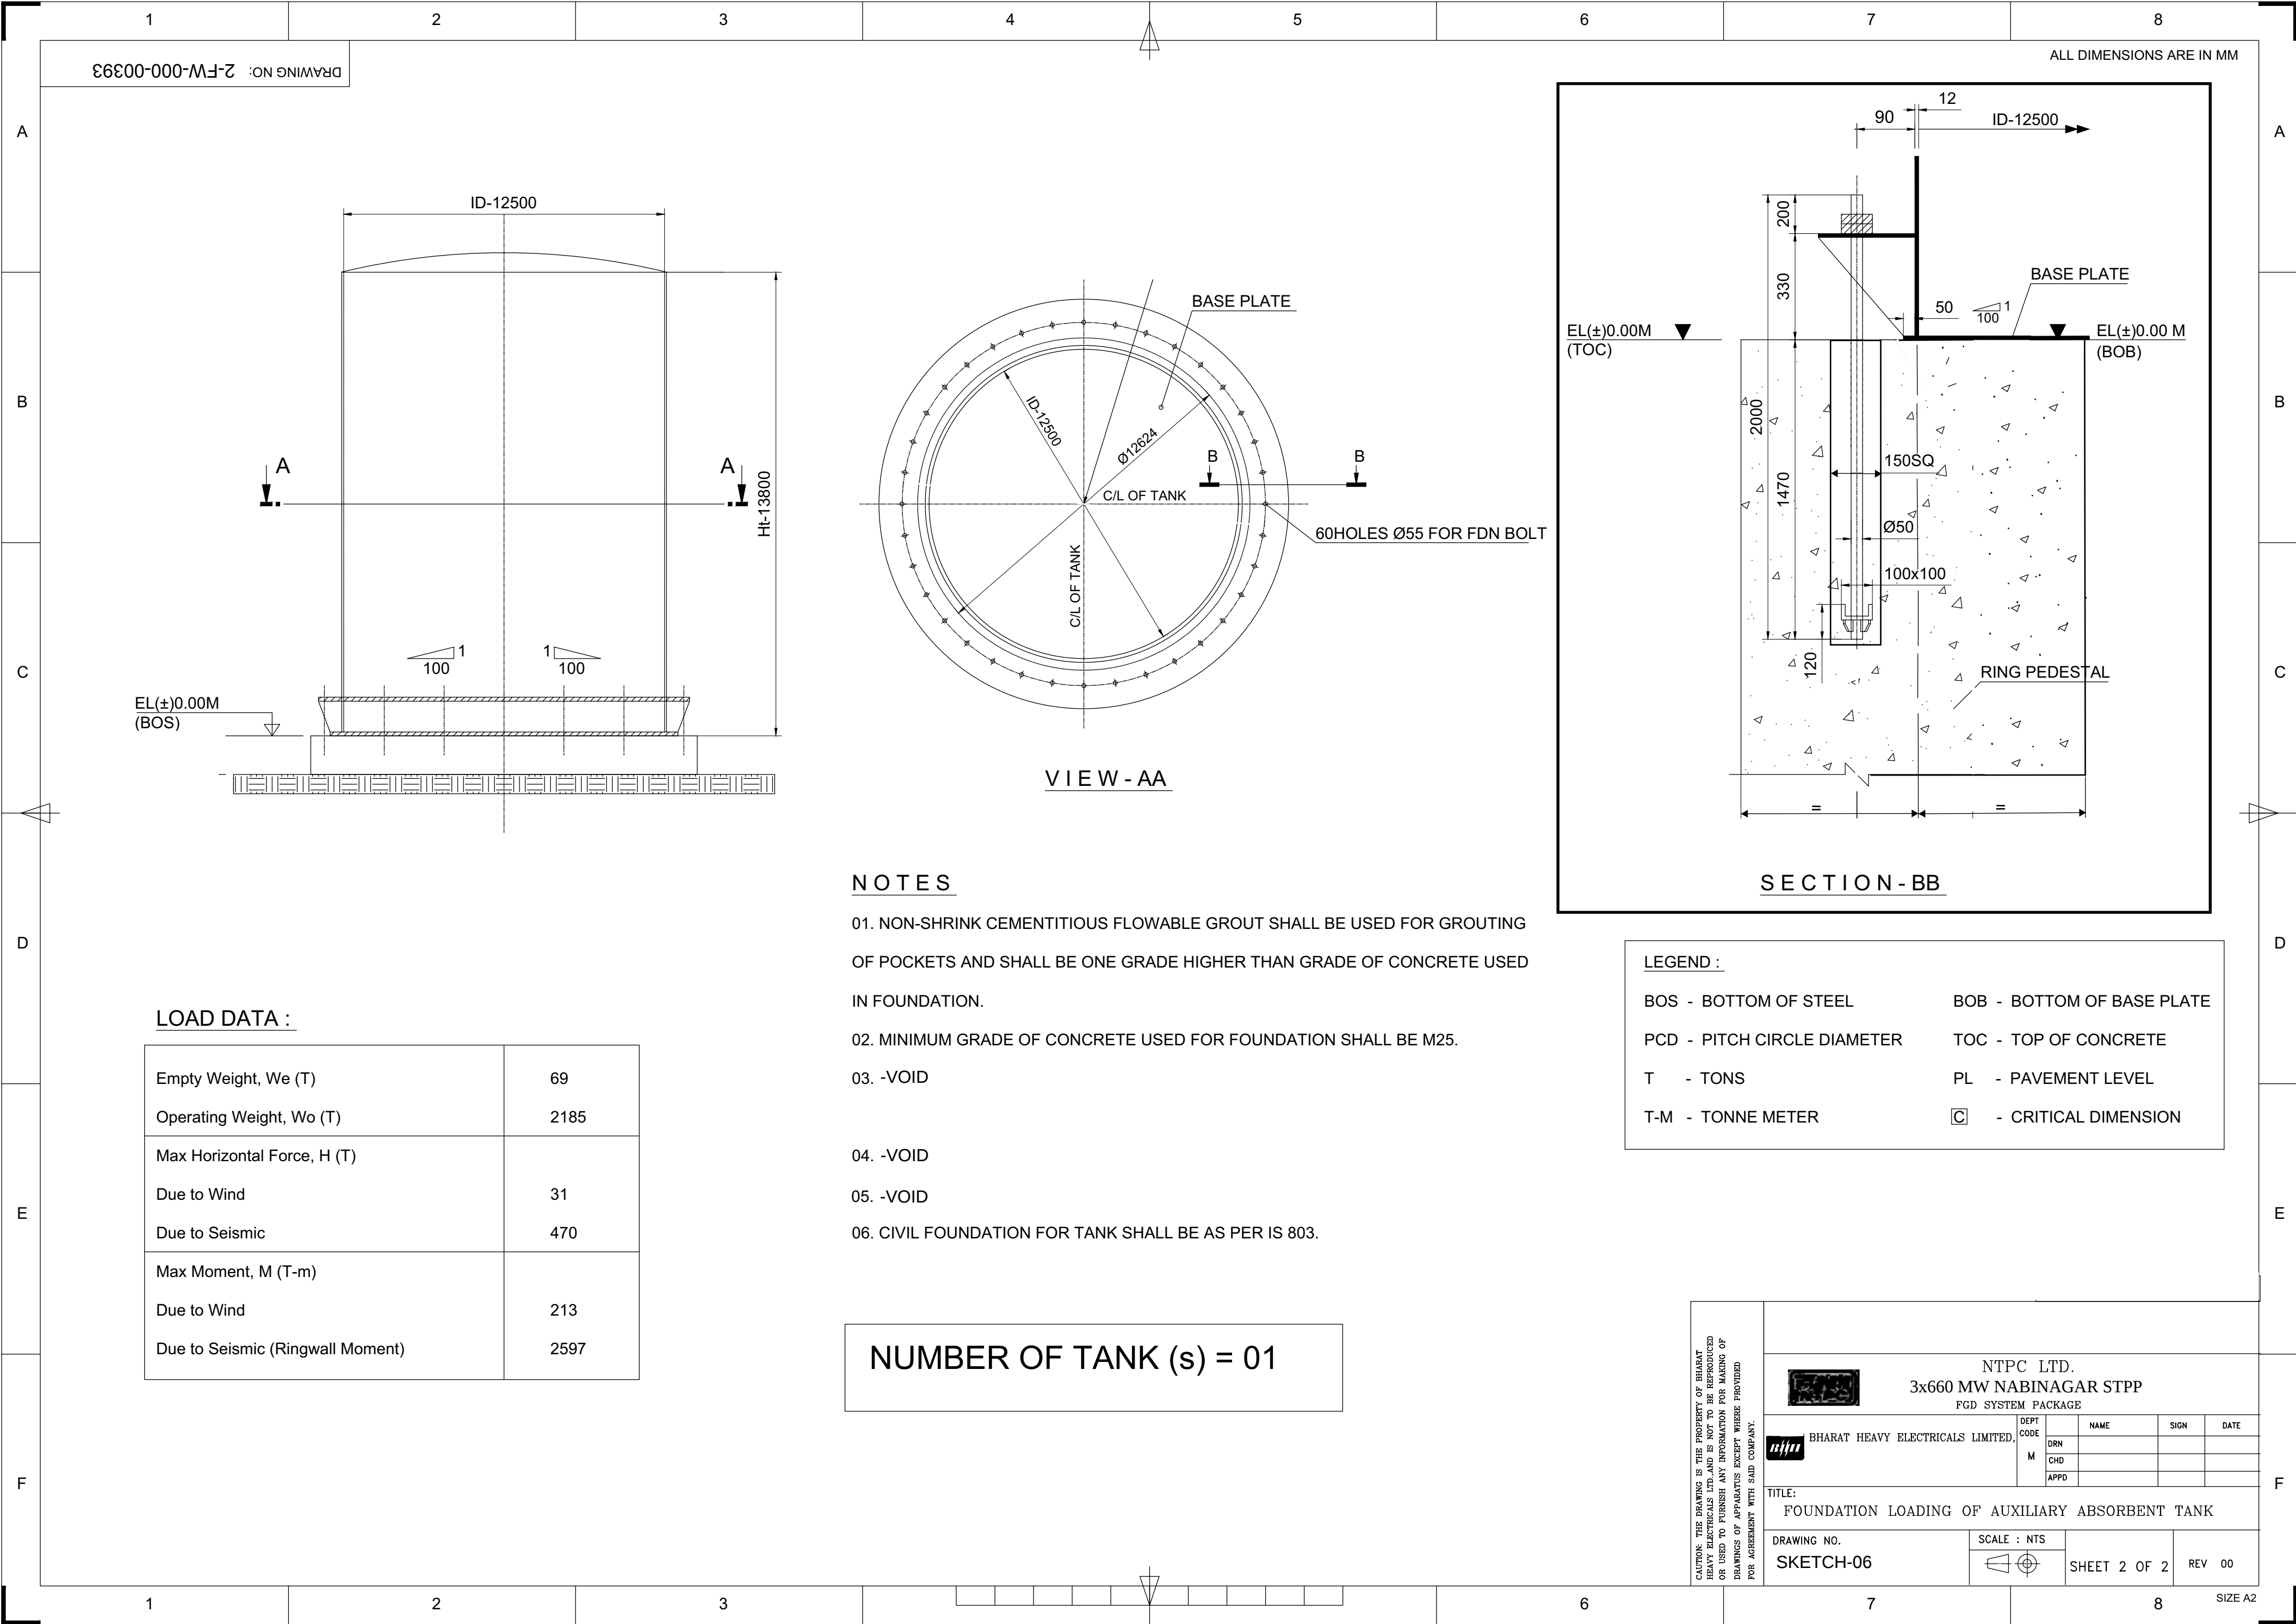



CAUTION: THE DRAWING IS THE PROPERTY OF BHARAT HEAVY ELECTRICALS LTD. AND IS NOT TO BE REPRODUCED OR USED TO FURNISH ANY INFORMATION FOR MAKING OF DRAWINGS OF APPARATUS EXCEPT WHERE PROVIDED FOR AGREEMENT WITH SAID COMPANY.	NTPC LTD. 3x660 MW NABINAGAR STPP FGD SYSTEM PACKAGE				
		DEPT CODE	NAME	SIGN	DATE
		M	DRN		
		CHD			
		APPD			
TITLE: FOUNDATION LOADING OF AUXILIARY ABSORBENT TANK					
DRAWING NO. SKETCH-06		SCALE : NTS 	SHEET 2 OF 2	REV 00	

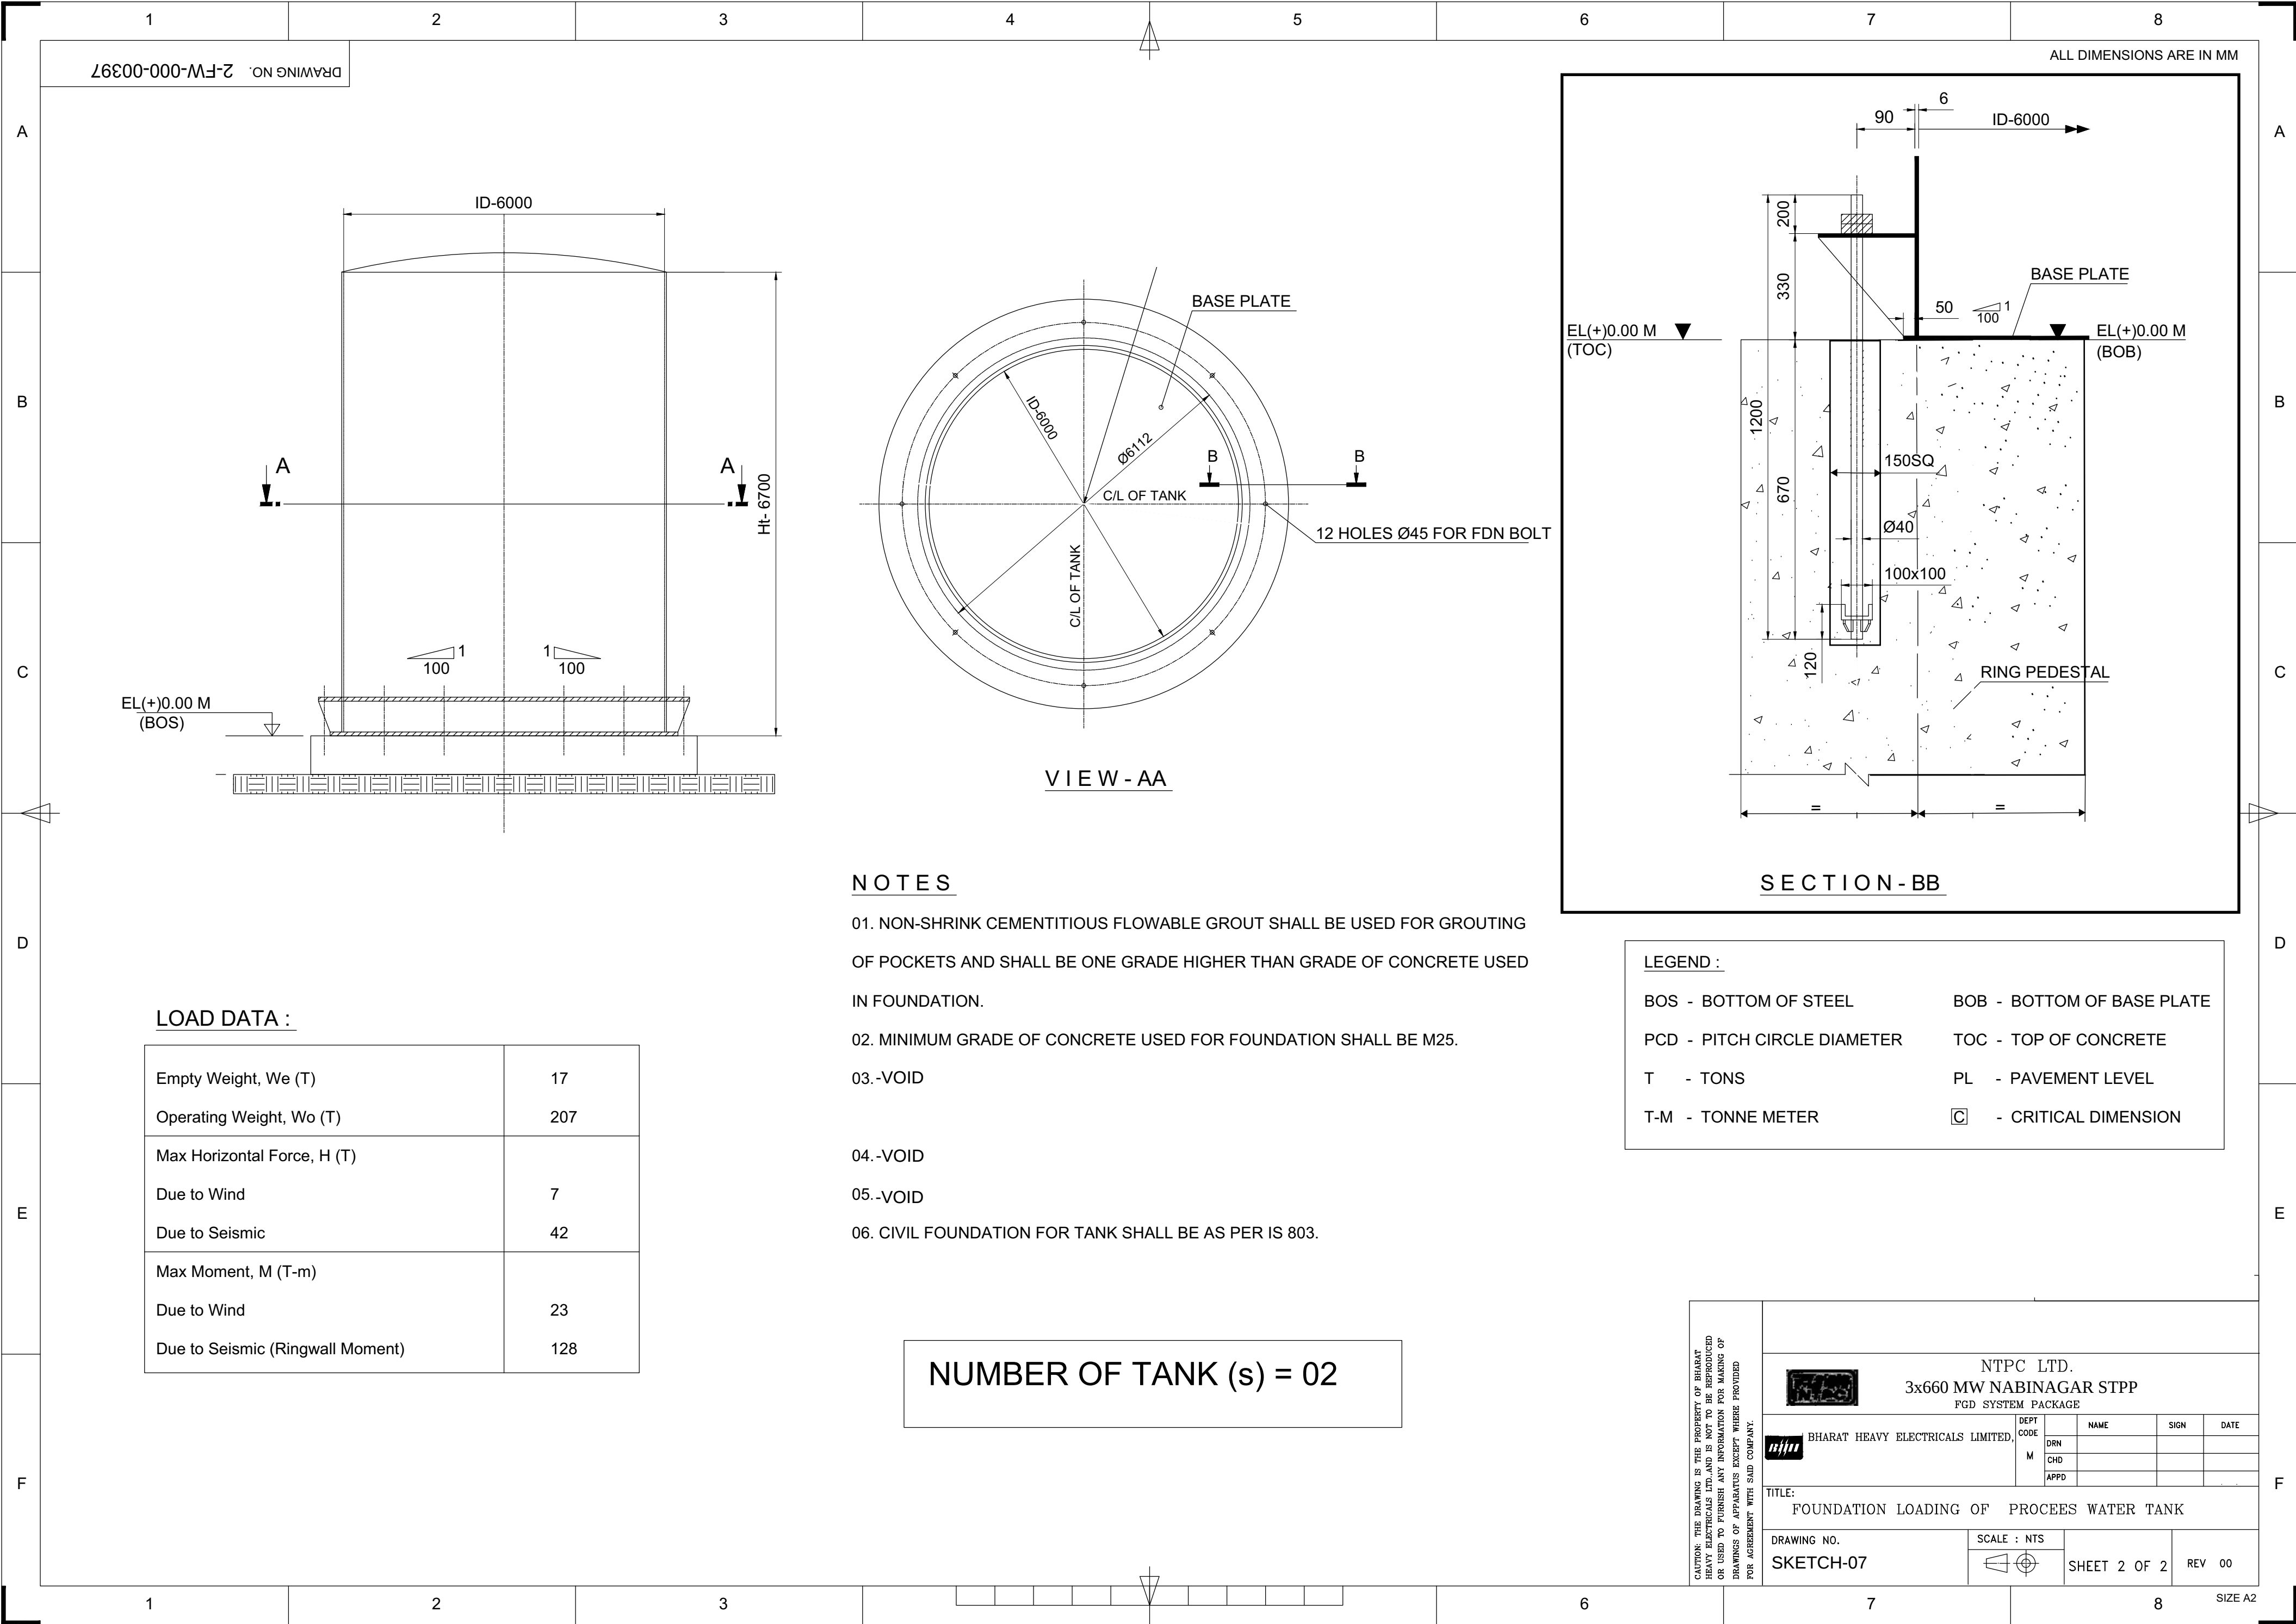

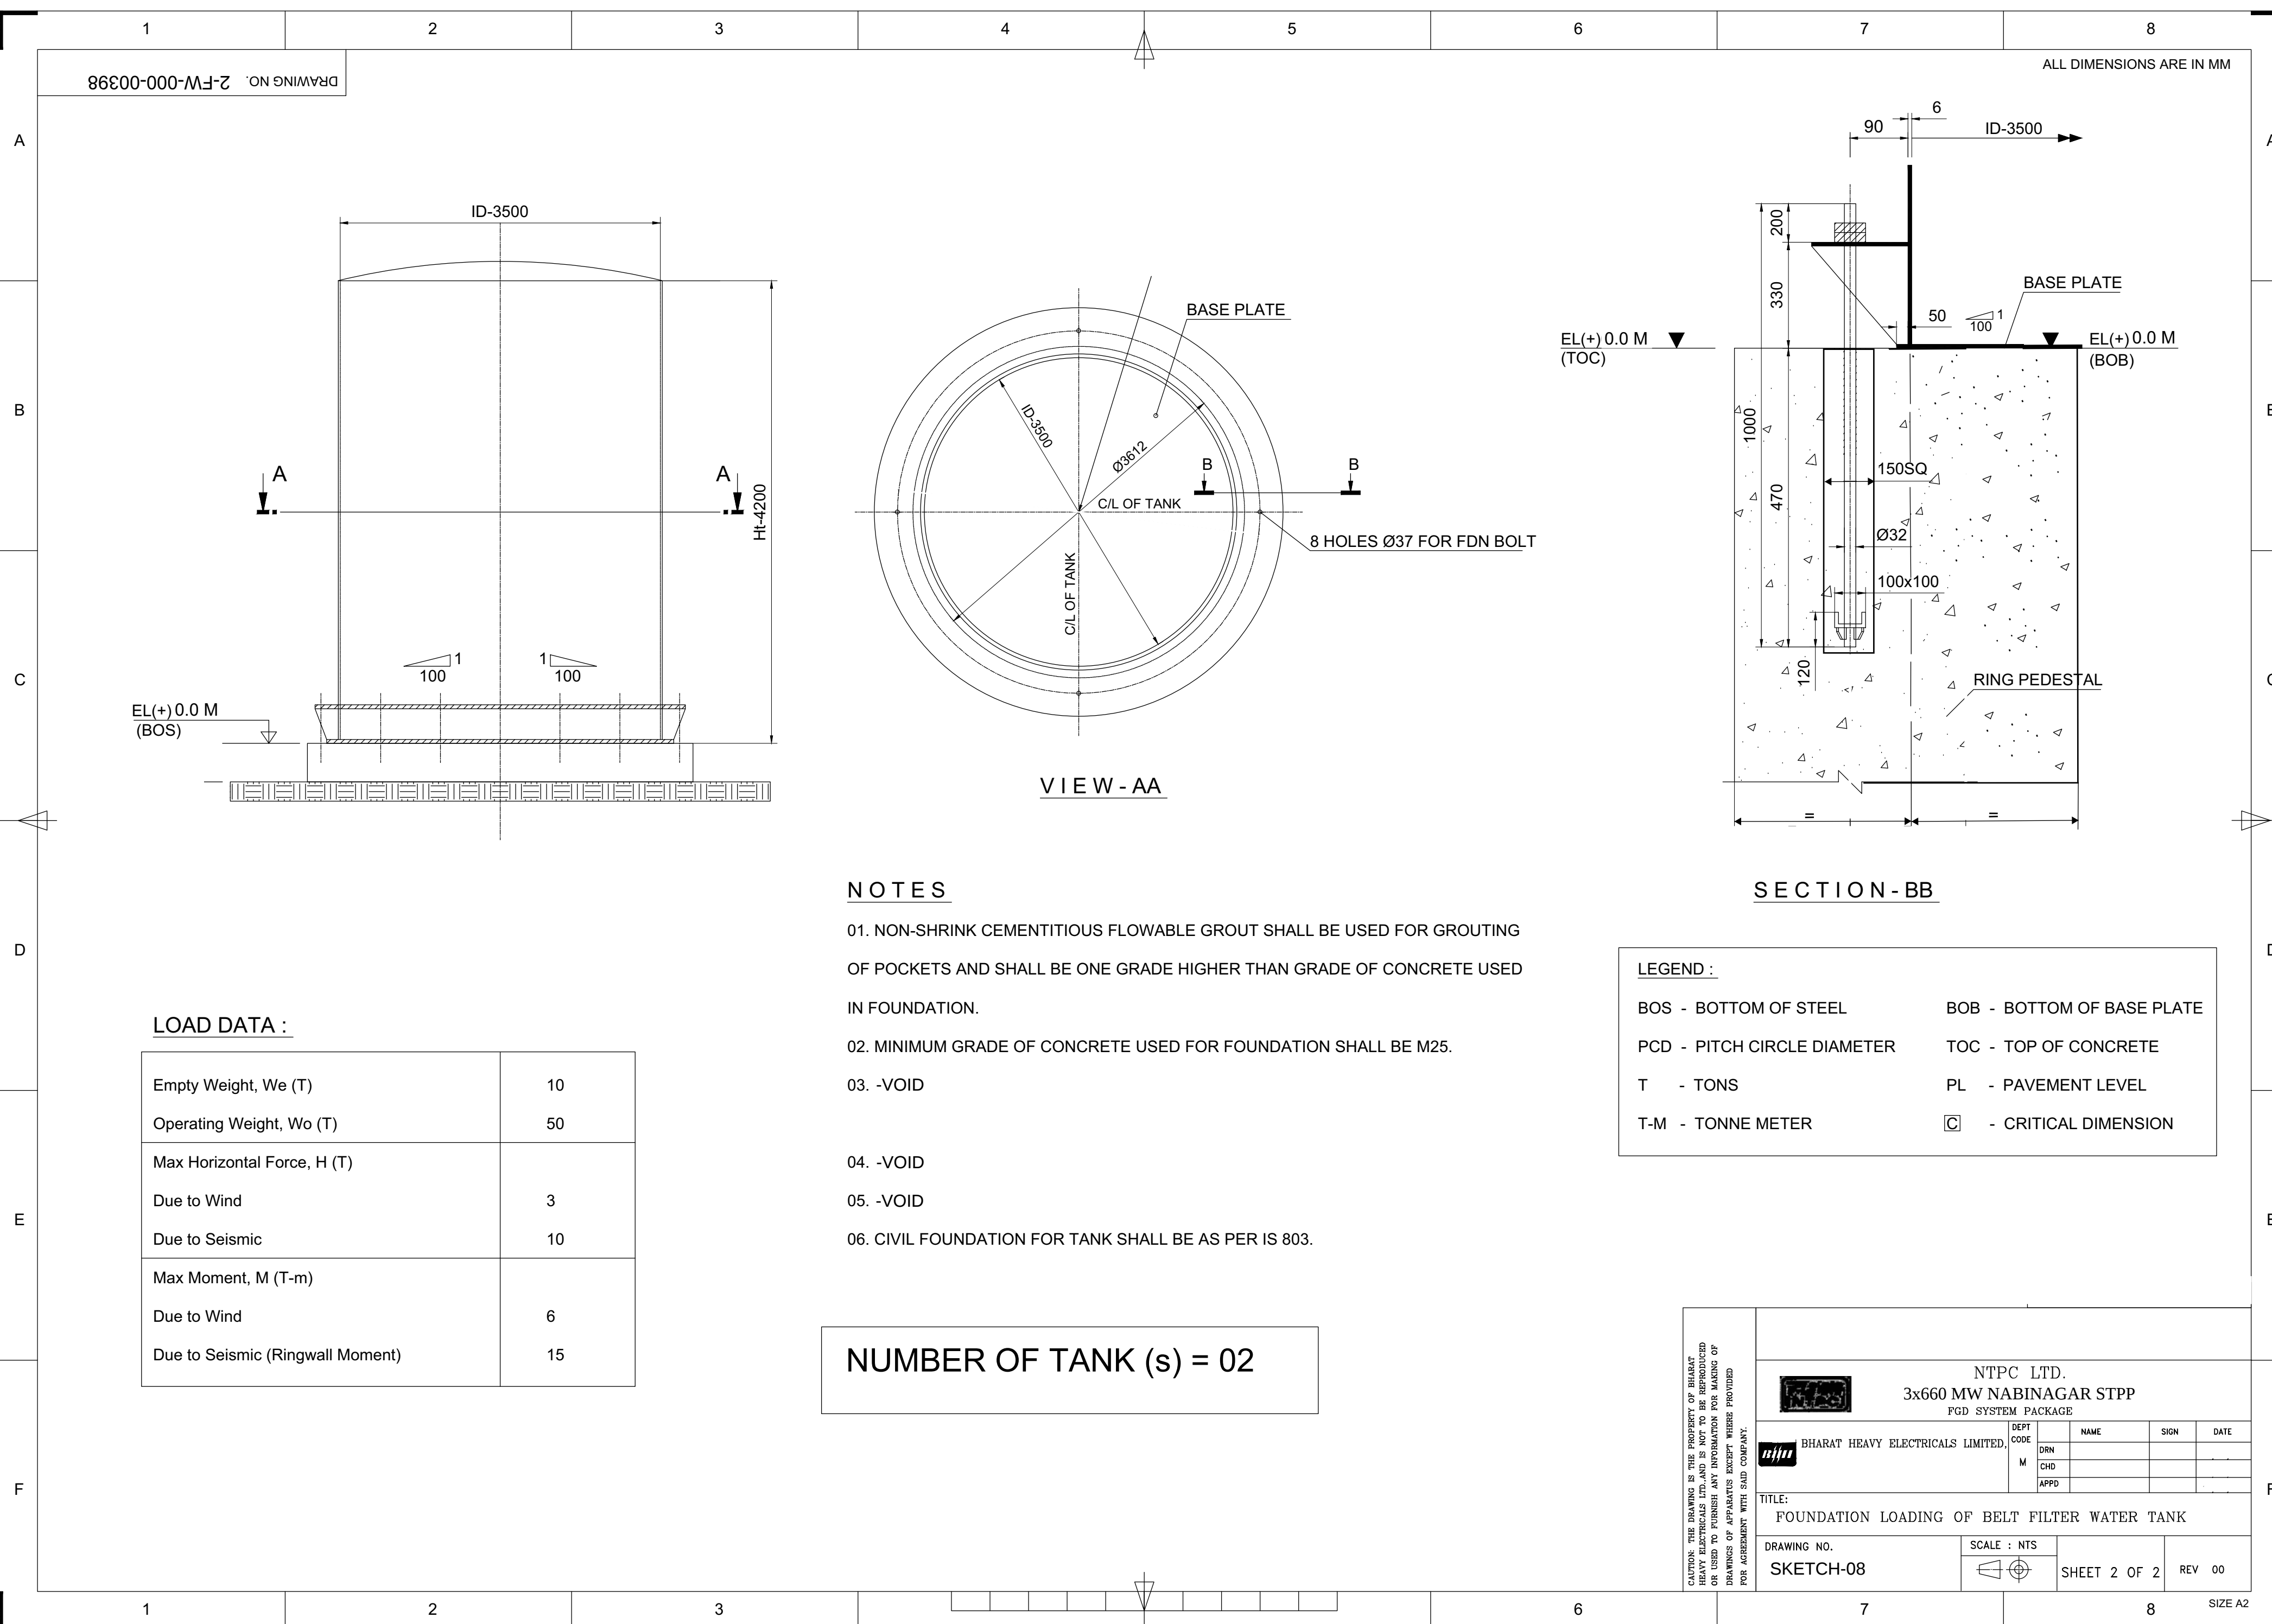

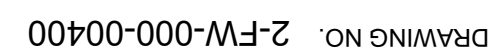

ALL DIMENSIONS ARE IN MM

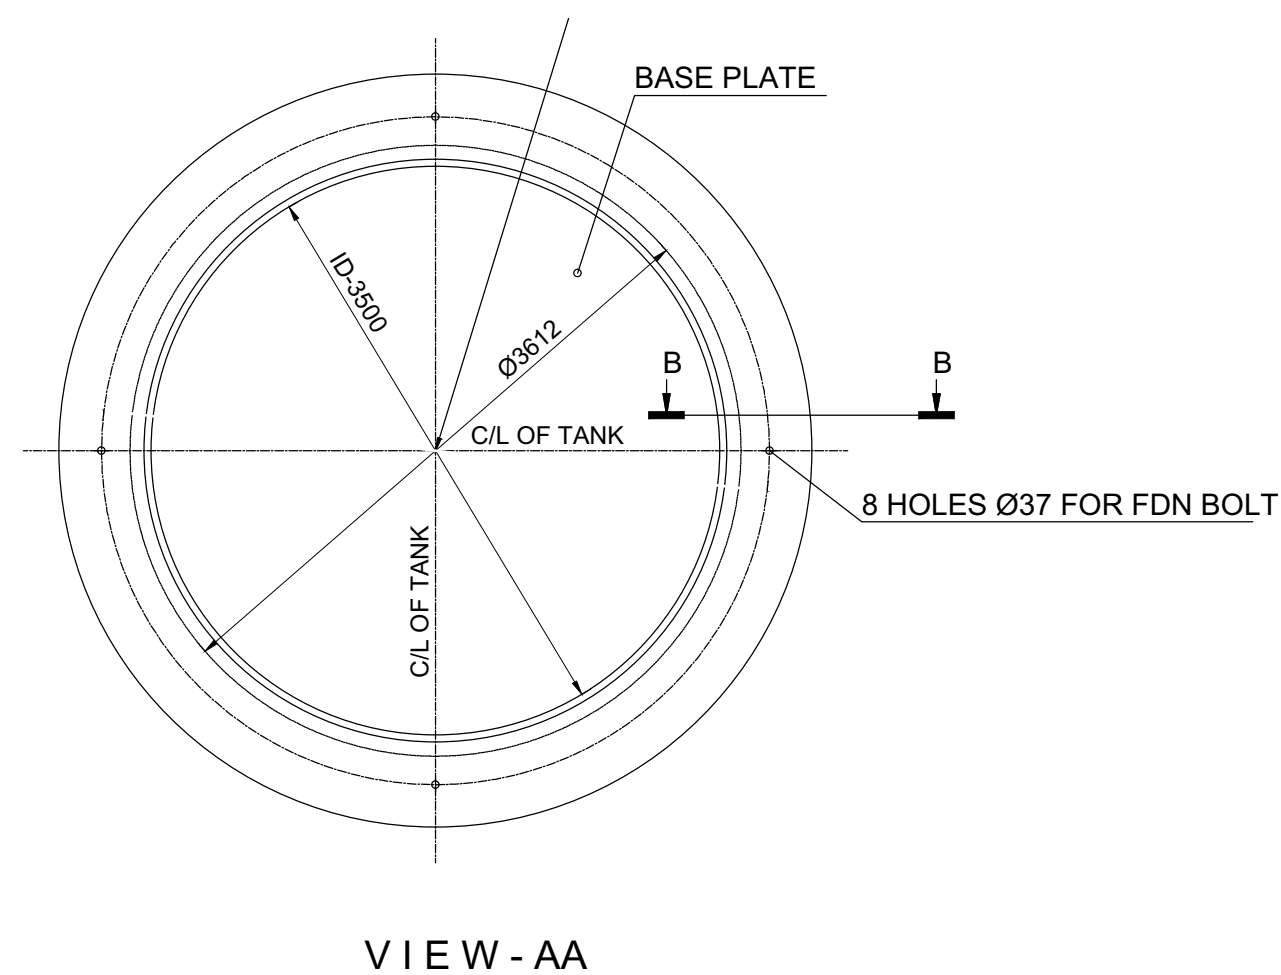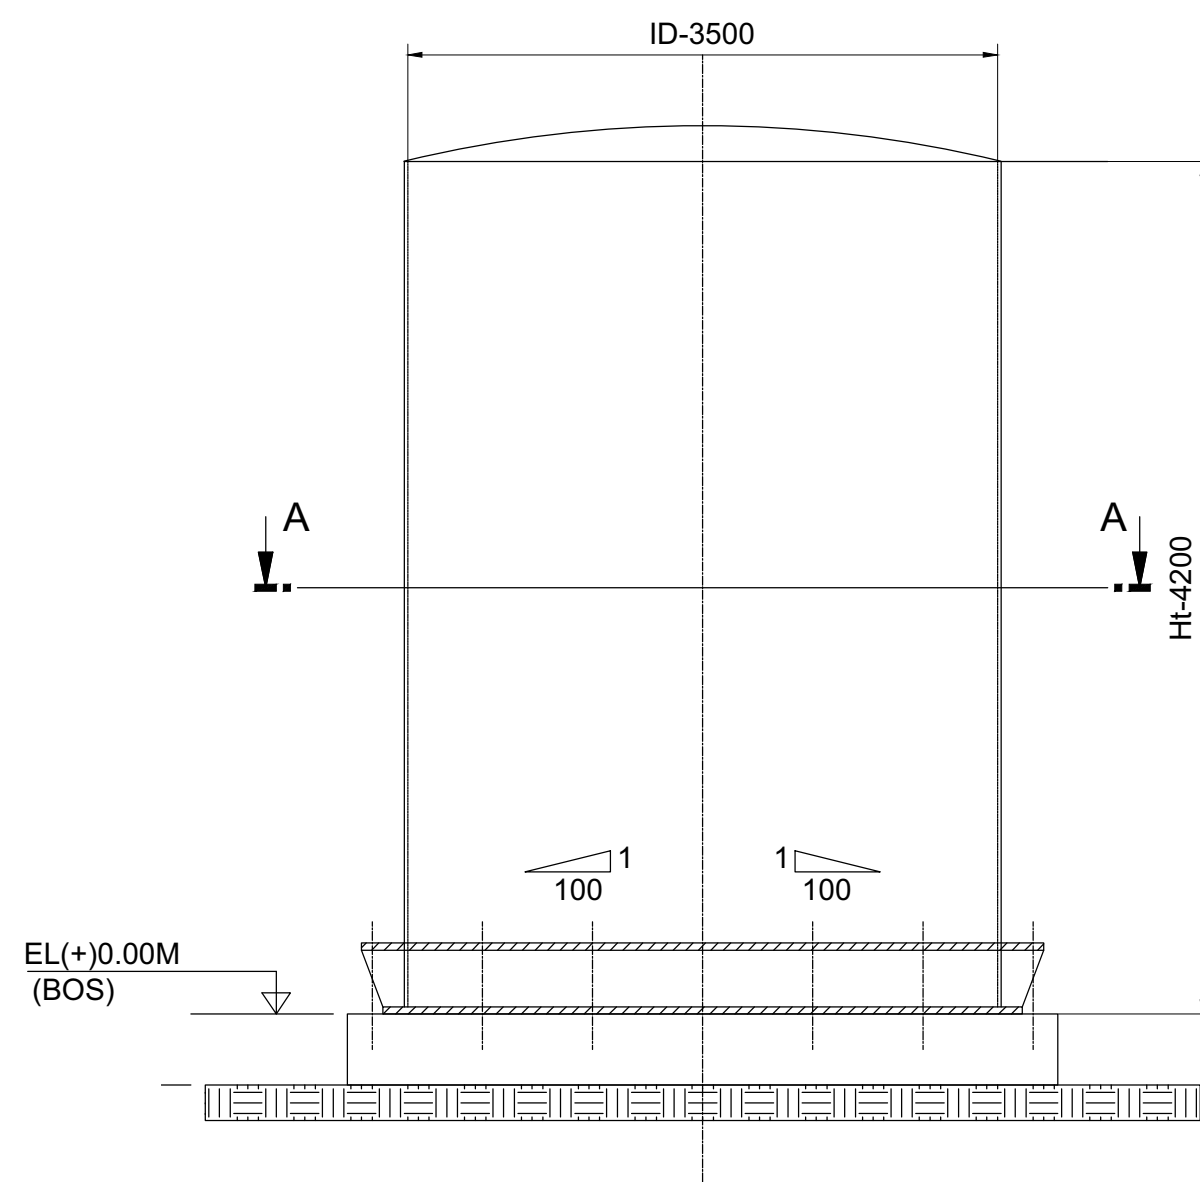

NOTES

01. NON-SHRINK CEMENTITIOUS FLOWABLE GROUT SHALL BE USED FOR GROUTING OF POCKETS AND SHALL BE ONE GRADE HIGHER THAN GRADE OF CONCRETE USED IN FOUNDATION.

02. MINIMUM GRADE OF CONCRETE USED FOR FOUNDATION SHALL BE M25.


03. -VOID

04. -VOID

05. -VOID

06. CIVIL FOUNDATION FOR TANK SHALL BE AS PER IS 803.

NUMBER OF TANK (s) = 02

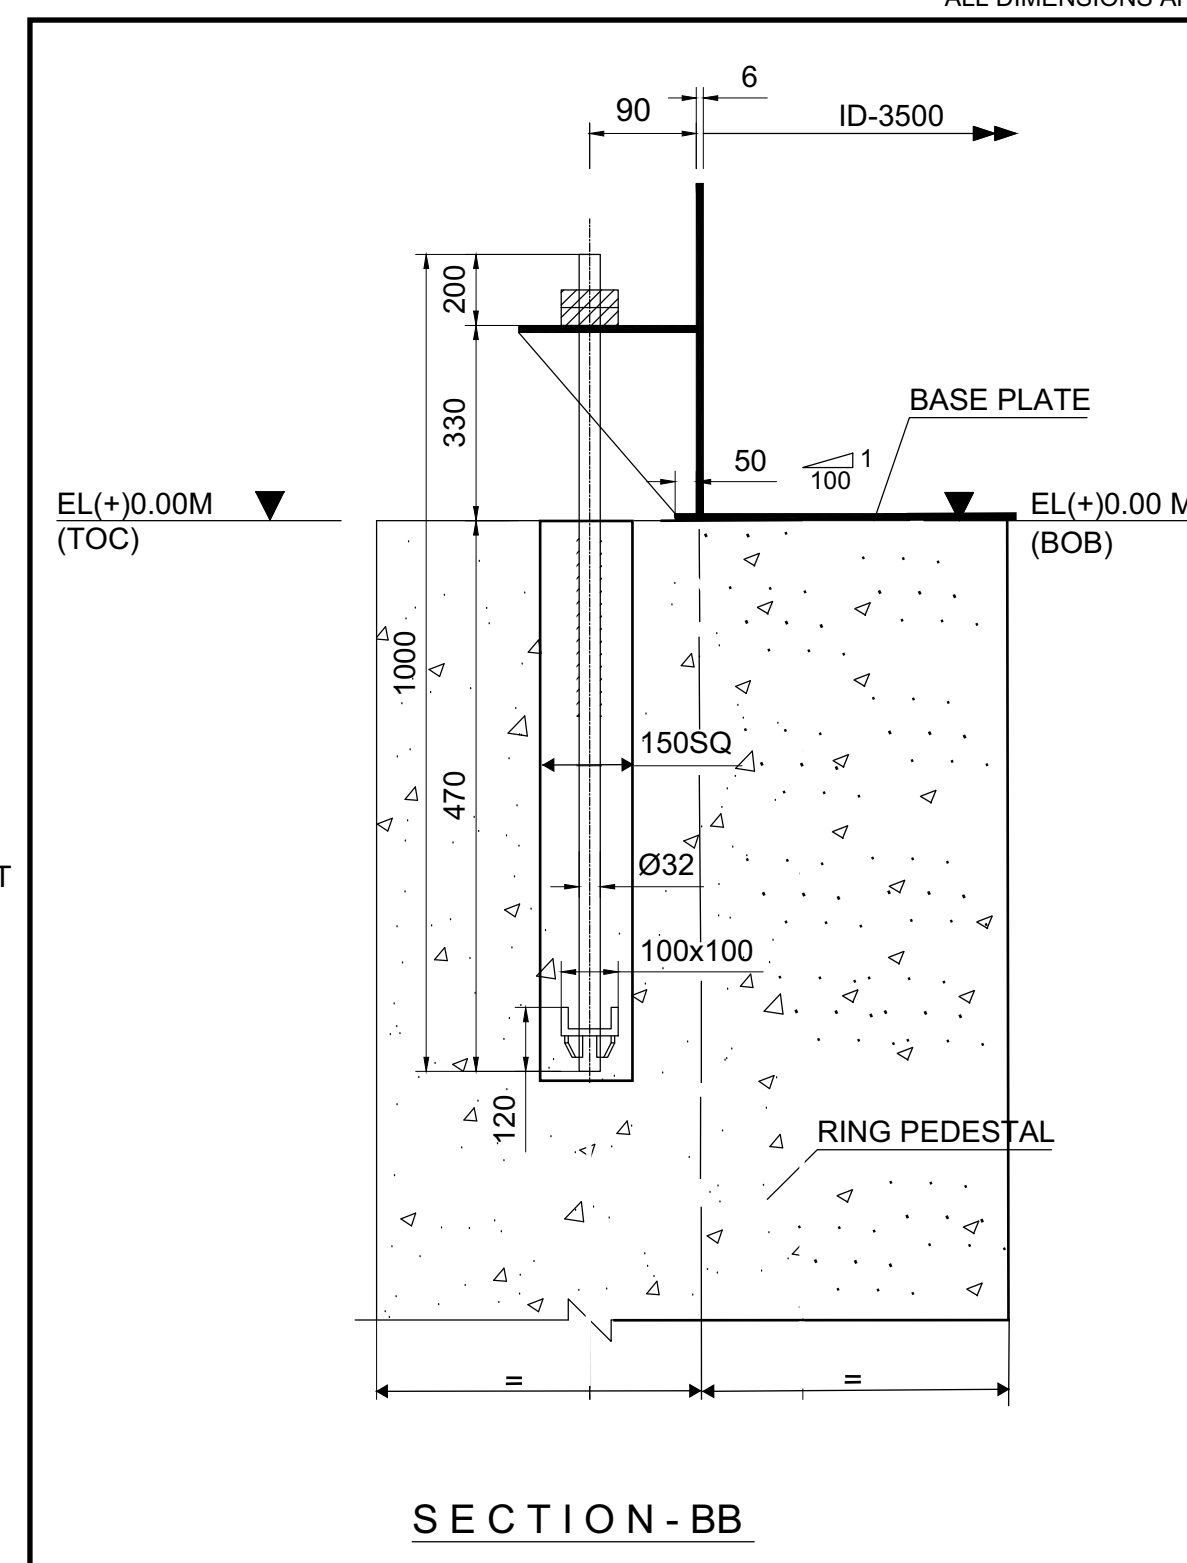

LEGEND :

BOS - BOTTOM OF STEEL

BOB - BOTTOM OF BASE PLATE

PCD - PITCH CIRCLE DIAMETER

TOC - TOP OF CONCRETE

T - TONS

PL - PAVEMENT LEVEL

T-M - TONNE METER

C - CRITICAL DIMENSION

LOAD DATA :

Empty Weight, W_e (T)	10
Operating Weight, W_o (T)	50
Max Horizontal Force, H (T)	
Due to Wind	3
Due to Seismic	10
Max Moment, M (T-m)	
Due to Wind	6
Due to Seismic (Ringwall Moment)	15

CAUTION: THE DRAWING IS THE PROPERTY OF BHARAT HEAVY ELECTRICALS LTD., AND IS NOT TO BE REPRODUCED OR USED TO FURNISH ANY INFORMATION FOR MAKING OF DRAWINGS OF APPARATUS EXCEPT WHERE PROVIDED FOR AGREEMENT WITH SAID COMPANY.



3x660 MW NABINAGAR STPP
FGD SYSTEM PACKAGE

BHARAT HEAVY ELECTRICALS LIMITED

	NAME	SIGN	DATE

TITLE:	FOUNDATION LOADING OF CLARIFIED WATER TANK

DRAWING NO.
SKETCH-09

SCALE : NTS

2 REV 00

SIZE A2