

VAR. NO.	TYPE	BIN CODE	ØD	B	O	MdxP	ASSY WEIGHT (kg)	A	C	E	F	G	H	L	S	Y	Z	K	t1-1/2V+W1Δ	t2Δ	t3Δ	t4 Δ-P(Q)
01	SAT 1-80	948210461002	113.9	204	1255	M14x2	6.1	156	70	750	1184	5	11	1134	24	5	10	717	4-1/2V+4Δ	4Δ	4Δ	3Δ-20(25)
02	SAT 2-80	948210462002	166.5	201	1255	M14x2	9.2	155	70	755	1184	6	11	1134	23	5	10	722	4-1/2V+5Δ	4Δ	4Δ	3Δ-20(40)
03	SAT 3-80	948210463002	113.9	271	1338	M14x2	7.9	156	80	766	1267	5	11	1217	24	5	10	733	4-1/2V+4Δ	4Δ	4Δ	3Δ-15(20)
04	SAT 4-80	948210464002	113.9	288	1339	M14x2	9.1	156	80	750	1268	5	11	1218	24	5	10	717	4-1/2V+4Δ	4Δ	4Δ	3Δ-20(25)
05	SAT 5-80	948210465002	166.5	298	1331	M27x3	16.3	173	80	725	1294	6	13	1219	23	7	14	679	4-1/2V+5Δ	5Δ	4Δ	3Δ-20(35)
06	SAT 6-80	948210466002	166.5	298	1333	M27x3	17.5	172	80	728	1296	6	13	1221	23	7	14	682	5-1/2V+5Δ	6Δ	5Δ	3Δ-20(35)
07	SAT 7-80	948210467002	219.1	305	1424	M27x3	30	190	90	725	1319	7	15	1244	24	9	18	675	6-1/2V+6Δ	8Δ	5Δ	3Δ-30(50)
08	SAT 8-80	948210468002	166.5	397	1531	M27x3	33	205	110	725	1427	6	17	1352	25	10	20	671	5-1/2V+5Δ	8Δ	5Δ	3Δ-25(35)
09	SAT 9-80	948210469002	219.1	460	1590	M27x3	55.6	202	110	725	1486	7	17	1411	24	10	20	671	6-1/2V+6Δ	8Δ	6Δ	3Δ-30(40)
10	SAT 10-80	948210470002	219.1	493	1671	M27x3	76.4	227	130	725	1555	7	20	1480	35	13	26	654	6-1/2V+6Δ	7Δ	6Δ	3Δ-30(50)
11	SAT 11-80	948210471002	323.9	473	1675	M27x3	125.6	253	150	725	1559	9	23	1484	33	16	32	648	8-1/2V+8Δ	8Δ	8Δ	3Δ-40(80)
12	SAT 12-80	948210472002	355.6	530	1801	M36x3	221.2	296	200	725	1665	9	29	1590	39	21	42	616	8-1/2V+8Δ	10Δ	8Δ	3Δ-40(80)
13	SAT 13-80	948210473002	406.4	639	1943	M48x3	331.1	328	200	725	1807	11	33	1732	40	25	50	608	10-1/2V+10Δ	15Δ	8Δ	3Δ-50(80)

**NOTES:**  
**GENERAL:**

- FOR SPRING RATE AND SELECTION CHART REFER DRG.NO. 4-80-999-99068.
- DIMENSIONS INDICATED IN THIS DRAWING ARE BASED ON THE INITIAL PRECOMPRESSION OF 56 MM. FOR ALL TYPES. DIMENSIONS E,F,L,O,K MAY CHANGE IN LINE WITH THE TOLERANCES/CHARACTERISTICS OF THE SPRING IN THE ASSEMBLY.

**FOR SHOPS:**

- TRAVEL SCALE (ITEM-12) SHALL BE FIXED AT A POSITION, SUCH THAT THE POINTER (ITEM-10) READS 40MM IN THE TRAVEL SCALE AT THE MID LOAD (CORRESPONDING TO LOAD AT 40MM TRAVEL GIVEN IN THE DRG 4-80-999-99068).
- LOCKING:**
  - ALL TYPES OF SPRING HANGERS SHALL BE PRECOMRESSED TO THE COLD POSITION INDICATED IN THE CONTRACT DOCUMENTS FOR INDIVIDUAL HANGERS. AT THIS PRECOMPRESSION, HANGERS SHALL BE LOCKED USING ITEM Nos.06 & 07 PRIOR TO DESPATCH.
- MARKING:**
  - FOR ALL TYPES OF SPRING HANGERS, HANGER TAG No., TYPE No., OPERATING LOAD AND MOVEMENT SHALL BE PUNCHED IN THE NAME PLATE (ITEM No.13), BASED ON THE DETAILS INDICATED IN THE CONTRACT DOCUMENTS.
  - FOR ALL TYPES OF SPRING HANGERS, COLD AND HOT MOVEMENT POSITIONS SHALL BE MARKED ON THE TRAVEL SCALE (ITEM No.12) WITH GREEN AND RED PAINTS RESPECTIVELY.
- POINTERS (ITEM No.10) ARE TO BE WELDED TO SPRING PLATE (ITEM No.08) SUCH THAT THEY PROTRUDE BY 2 TO 4 MM OUTSIDE THE HOUSING (ITEM No.01).
- TOP & BOTTOM TIE RODS (ITEM Nos. 04 & 18) ARE TO BE MATCH DRILLED WITH COUPLING (ITEM No.21) ALSO BOTTOM TIE ROD (ITEM No.18) IS TO BE MATCH DRILLED WITH NUT (ITEM No.16) HOLE SIZES FOR THESE MATCH DRILLING ARE GIVEN BELOW.

TYPE	HOLE SIZE
SAT1-80 TO SAT7-80	DIA 4.5 MM
SAT8-80 TO SAT9-80	DIA 5.5 MM
SAT10-80 TO SAT15-80	DIA 7.0 MM

- THE SLOTS ON TOP ARE TO BE FREE FROM WELD METAL (i.e). AFTER WELDING ALL ROUND, THE SLOTS SHALL BE DRESSED TO HAVE A SMOOTH SURFACE IN LINE WITH THE TOP SURFACE OF THE TOP PLATE.
- PAINTING SCHEME SHALL BE AS PER APPLICABLE QUALITY PLAN.

**FOR SITE:**

- DURING ERECTION:**
  - THE SPRING HANGERS SHALL BE ERECTED SUCH THAT THE BEARING PLATE ASSY. (ITEM No.09) RESTS PERFECTLY ON TOP OF SUPPORTING STRUCTURE. AT THIS CONDITION THE BEARING PLATE ASSY IS TO BE WELDED TO THE SUPPORTING STRUCTURE.
- BEFORE HYDRAULIC TEST:**
  - ALL TYPES OF SPRING HANGERS SHALL BE CHECKED FOR LOCKED CONDITION AT THE COLD SET LOAD ALREADY DONE AT SHOPS.
- AFTER HYDRAULIC TEST:**
  - ALL HANGERS SHALL BE UNLOCKED BY LOOSENING ITEM Nos.06&07) AS PER THE FOLLOWING STEPS
    - REMOVE NUT (ITEM No.22 AT THE TOP) FROM THE TOP TIE ROD (ITEM No.04)
    - LOOSEN HYD. LOCK NUT (ITEM No.07) AND THEN CENTERING NUT (ITEM No.06)
    - REMOVE HYD. LOCK NUT AND CENTERING NUT (ITEM No.07 & 06) FROM THE TOP TIE ROD (ITEM No.04)
    - THEN ASSEMBLE CENTERING NUT, HYD. LOCK NUT AND NUT (ITEM No.06,07 & 22) IN THE SAME SEQUENCE, SUCH THAT THE HYD. LOCK NUT IS HELD BETWEEN CENTERING NUT AND TOP NUT AND THE DISTANCE BETWEEN THE FREE END OF TOP TIE ROD AND TOP OF NUT SHALL BE APPROXIMATELY 5MM

ITEM NUMBER	DESCRIPTION	STD	DRAWING NUMBER	ITEM NO	MATERIAL CODE	UNIT	UNIT WEIGHT	QTY	ZONE
22	NUT	STANDARD						2	
21	COUPLING	3-80-999-99188						1	
20	SPHERICAL WASHER	3-80-999-99187						1	
19	HAMMER DRIVEN SCREW	STANDARD						8	
18	BOTTOM TIE ROD	3-12-000-06351						1	
17	SPLIT PIN	STANDARD						3	
16	NUT	3-80-999-99152						1	
15	TURN BUCKLE	2-12-000-01853						1	
14	INNER PIPE GUIDE	3-80-999-99154						1	
13	NAME PLATE	3-80-999-99118						1	
12	TRAVEL SCALE	3-80-999-99117						2	
11	SPRING	2-80-999-99117						1	
10	POINTER	4-80-999-99047						2	
09	BEARING PLATE ASSY	3-80-999-99183						1	
08	SPRING PLATE	3-80-999-99182						1	
07	HYD.LOCK NUT	3-80-999-99153						1	
06	CENTERING NUT	2-80-999-99131						1	
05	BOTTOM SOCKET	2-80-999-99136						1	
04	TOP TIE ROD	3-80-999-99181						1	
03	TOP PLATE	3-80-999-99180						1	
02	BOTTOM PLATE	3-80-999-99179						1	
01	HOUSING	3-80-999-99175						1	

CAUTION: The information on this document is the property of BHARAT HEAVY ELECTRICALS LTD. It must not be used directly or indirectly in any way without the prior written consent of the company.

TYPE OF PRODUCT OR NAME OF CUSTOMER/PROJECT

Bharat Heavy Electricals Ltd  
UNIT: HIGH PRESSURE BOILER PLANT  
TIRUCHIRAPALLI - 620014

DRN R.GOBI  
CHD THINESH KUMAR  
APPD R.T.

DATE 15.12.2014  
DATE 15.12.2014  
DATE 16.12.2014

355-053  
PP ALL DIMENSIONS ARE IN MM  
CODE 121


PROJECTION  
SCALE NTS  
WEIGHT (Kg)

REF TO ASSY / OLD DWG  
1-80-999-99006

TITLE  
VARIABLE LOAD HANGERS  
(TYPE SAT 80)

DRAWING NO :  
1-12-000-01482

REV  
00

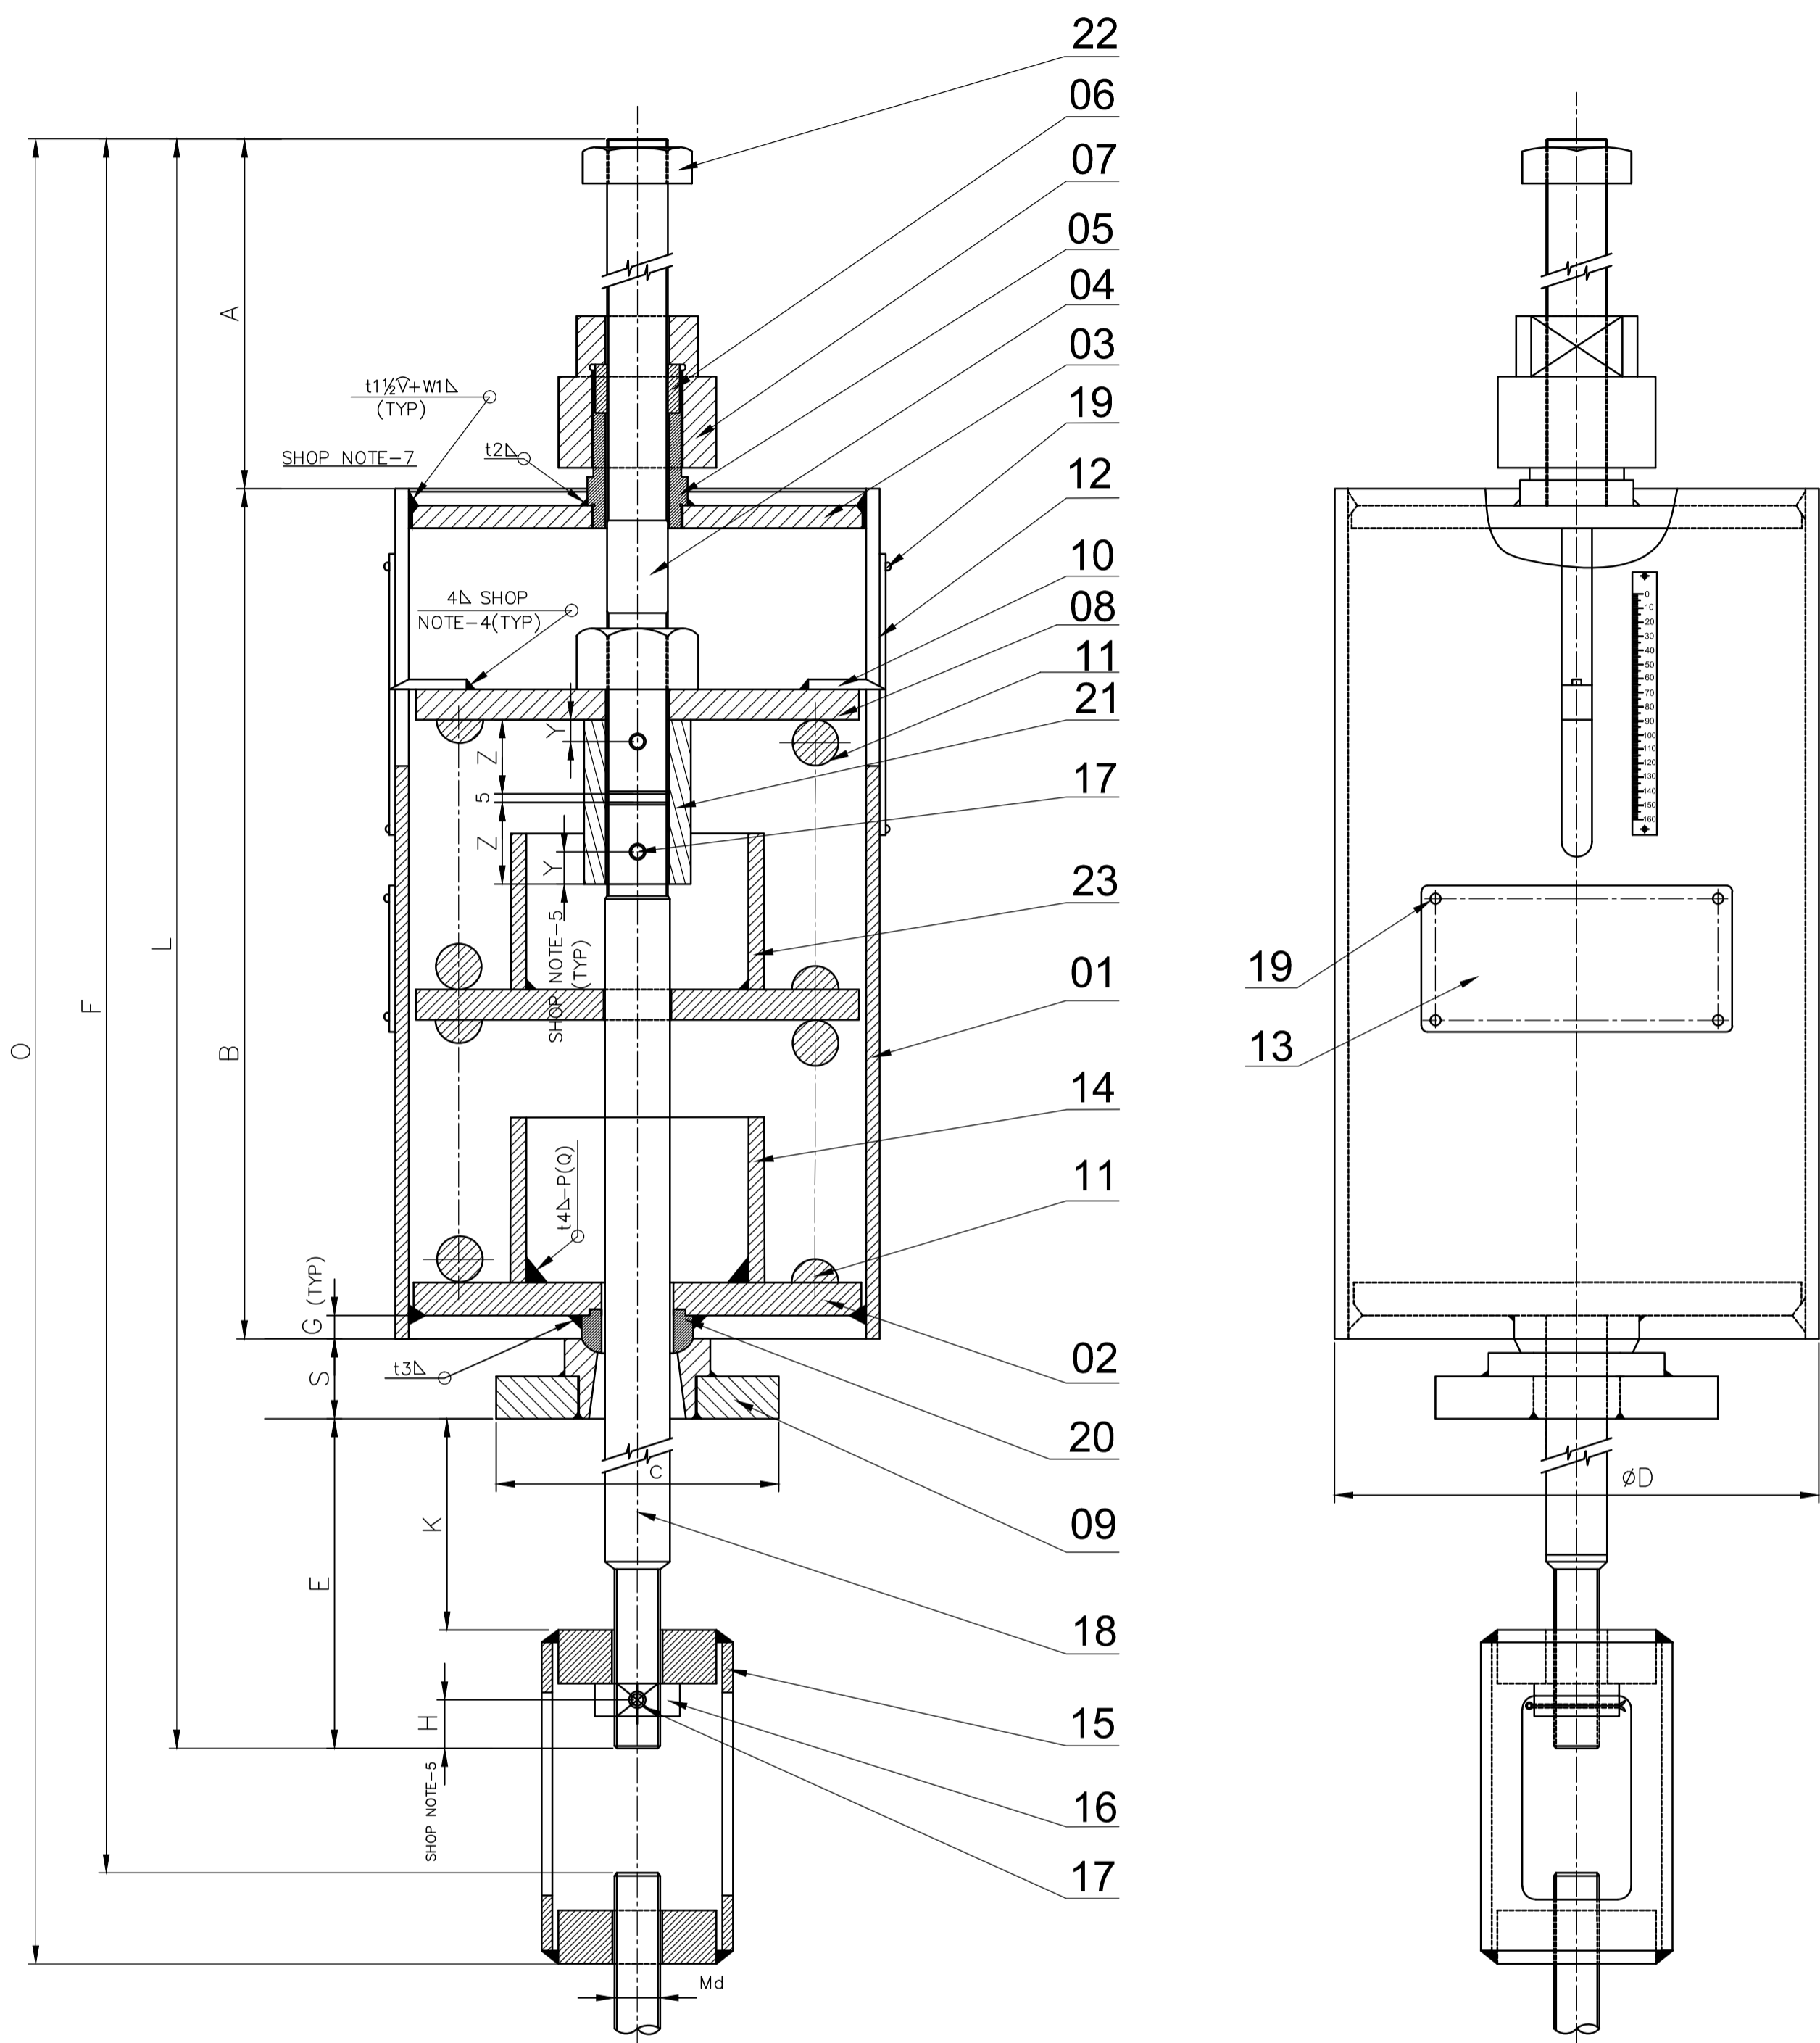

VAR. NO.	TYPE	BIN CODE	ØD	B	O	MdxP	ASSY WEIGHT (kg)	A	C	E	F	G	H	L	S	Y	Z	K	t1-1/2V+W1Δ	t2Δ	t3Δ	t4Δ-P(Q)
01	SAT 1-160	948210476002	113.9	378	1525	M14x2	9.1	252	70	750	1454	5	11	1404	24	5	10	717	4-1/2V+4Δ	4Δ	4Δ	3Δ-20(25)
02	SAT 2-160	948210477002	166.5	370	1525	M14x2	14.7	251	70	760	1454	6	11	1404	24	5	10	727	4-1/2V+5Δ	4Δ	4Δ	3Δ-20(40)
03	SAT 3-160	948210478002	113.9	512	1692	M14x2	12.8	252	80	783	1621	5	11	1571	24	5	10	750	4-1/2V+4Δ	4Δ	4Δ	3Δ-15(20)
04	SAT 4-160	948210479002	113.9	546	1693	M14x2	15.3	252	80	750	1622	5	11	1572	24	5	10	717	4-1/2V+4Δ	4Δ	4Δ	3Δ-20(25)
05	SAT 5-160	948210480002	166.5	561	1690	M27x3	26.6	269	80	725	1653	6	13	1578	23	7	14	679	4-1/2V+5Δ	5Δ	4Δ	3Δ-20(35)
06	SAT 6-160	948210481002	166.5	557	1692	M27x3	28.4	268	80	732	1655	6	13	1580	23	7	14	686	5-1/2V+5Δ	6Δ	5Δ	3Δ-20(35)
07	SAT 7-160	948210482002	219.1	564	1779	M27x3	48.9	286	90	725	1674	7	15	1599	24	9	18	675	6-1/2V+6Δ	8Δ	5Δ	3Δ-30(50)
08	SAT 8-160	948210483002	166.5	743	1973	M27x3	54.9	301	110	725	1869	6	17	1794	25	10	20	671	5-1/2V+5Δ	8Δ	5Δ	3Δ-25(35)
09	SAT 9-160	948210484002	219.1	863	2089	M27x3	95.9	298	110	725	1985	7	17	1910	24	10	20	671	6-1/2V+6Δ	8Δ	6Δ	3Δ-30(40)
10	SAT 10-160	948210485002	219.1	916	2190	M27x3	126.4	323	130	725	2074	7	20	1999	35	13	26	654	6-1/2V+6Δ	7Δ	6Δ	3Δ-30(50)
11	SAT 11-160	948210486002	323.9	867	2165	M27x3	220.9	349	150	725	2049	9	23	1974	33	16	32	648	8-1/2V+8Δ	8Δ	8Δ	3Δ-40(80)
12	SAT 12-160	948210487002	355.6	964	2331	M36x3	364.9	392	200	725	2195	9	29	2120	39	21	42	616	8-1/2V+8Δ	10Δ	8Δ	3Δ-40(80)
13	SAT 13-160	948210488002	406.4	1166	2566	M48x3	554.4	424	200	725	2430	11	33	2355	40	25	50	608	10-1/2V+10Δ	15Δ	8Δ	3Δ-50(80)

**NOTES:**  
**GENERAL:**

- FOR SPRING RATE AND SELECTION CHART REFER DRG.No. 4-80-999-99068.
- DIMENSIONS INDICATED IN THIS DRAWING ARE BASED ON THE INITIAL PRECOMPRESSION OF 56 MM, FOR ALL TYPES. DIMENSIONS E,F,L,O,K MAY CHANGE IN LINE WITH THE TOLERANCES/CHARACTERISTICS OF THE SPRING IN THE ASSEMBLY.

**FOR SHOPS:**

- TRAVEL SCALE (ITEM No.12) SHALL BE FIXED AT A POSITION, SUCH THAT THE POINTER (ITEM.No.10) READS 40MM IN THE TRAVEL SCALE AT THE MID LOAD (CORRESPONDING TO LOAD AT 40MM TRAVEL GIVEN IN THE DRG.No. 4-80-999-99068).

**2.LOCKING:**

- ALL TYPES OF SPRING HANGERS SHALL BE PRECOMRESSED TO THE COLD POSITION INDICATED IN THE CONTRACT DOCUMENTS FOR INDIVIDUAL HANGERS. AT THIS PRECOMPRESSION, HANGERS SHALL BE LOCKED USING ITEM Nos.06 & 07 PRIOR TO DESPATCH.

**3.MARKING:**

- FOR ALL TYPES OF SPRING HANGERS, HANGER TAG No., TYPE No., OPERATING LOAD AND MOVEMENT SHALL BE PUNCHED IN THE NAME PLATE (ITEM No.13), BASED ON THE DETAILS INDICATED IN THE CONTRACT DOCUMENTS.
  - FOR ALL TYPES OF SPRING HANGERS, COLD AND HOT MOVEMENT POSITIONS SHALL BE MARKED ON THE TRAVEL SCALE (ITEM No.12) WITH GREEN AND RED PAINTS RESPECTIVELY.
- POINTERS (ITEM No.10) ARE TO BE WELDED TO SPRING PLATE (ITEM No.08) SUCH THAT THEY PROTRUDE BY 2 TO 4 MM OUTSIDE THE HOUSING (ITEM No.01).
  - TOP & BOTTOM TIE RODS (ITEM No.04&18)ARE TO BE MATCH DRILLED WITH COUPLING (ITEM No 21) ALSO BOTTOM TIE ROD (ITEM No.18) IS TO BE MATCH DRILLED WITH NUT(ITEM No.16) HOLE SIZES FOR THESE MATCH DRILLING ARE GIVEN BELOW.

TYPE	HOLE SIZE
SAT1-160 TO SAT7-160	DIA 4.5 MM
SAT8-160 TO SAT9-160	DIA 5.5 MM
SAT10-160 TO SAT15-160	DIA 7.0 MM

- THE SLOTS ON TOP ARE TO BE FREE FROM WELD METAL (i.e). AFTER WELDING ALL ROUND THE SLOTS SHALL BE DRESSED TO HAVE A SMOOTH SURFACE IN LINE WITH THE TOP SURFACE OF THE TOP PLATE.

- PAINTING SCHEME SHALL BE AS PER APPLICABLE QUALITY PLAN.

**FOR SITE:**

**1. DURING ERECTION:**

- THE SPRING HANGERS SHALL BE ERECTED SUCH THAT THE BEARING PLATE ASSY. (ITEM No.09) RESTS PERFECTLY ON TOP OF SUPPORTING STRUCTURE. AT THIS CONDITION THE BEARING PLATE ASSY IS TO BE WELDED TO THE SUPPORTING STRUCTURE.

**2. BEFORE HYDRAULIC TEST:**

- ALL TYPES OF SPRING HANGERS SHALL BE CHECKED FOR LOCKED CONDITION AT THE COLD SET LOAD ALREADY DONE AT SHOPS.

**3. AFTER HYDRAULIC TEST:**

- ALL HANGERS SHALL BE UNLOCKED BY LOOSENING (ITEM Nos.06&07) AS PER THE FOLLOWING STEPS
  - REMOVE NUT (ITEM No.22 AT THE TOP) FROM THE TOP TIE ROD(ITEM No.04)
  - LOOSEN HYD.LOCK NUT (ITEM No.07) AND THEN CENTERING NUT (ITEM No.06)
  - REMOVE HYD. LOCK NUT AND CENTERING NUT (ITEM No.07 & 06) FROM THE TOP TIE ROD (ITEM No.04)
  - THEN ASSEMBLE CENTERING NUT, HYD.LOCK AND NUT (ITEM No.06,07&22) IN THE SAME SEQUENCE, SUCH THAT THE HYD. LOCK NUT IS HELD BETWEEN CENTERING NUT AND TOP NUT AND THE DISTANCE BETWEEN THE FREE END OF TOP TIE ROD AND TOP OF NUT SHALL BE APPROXIMATELY 5MM.

ITEM NO.	DESCRIPTION	STD	DRAWING NUMBER	ITEM NO	MATERIAL CODE	UNIT	UNIT WEIGHT	QTY	ZONE
23	MIDDLE PLATE ASSY		2-80-999-99129					1	
22	NUT		STANDARD					2	
21	COUPLING		3-80-999-99188					1	
20	SPHERICAL WASHER		3-80-999-99187					1	
19	HAMMER DRIVEN SCREW		STANDARD					8	
18	BOTTOM TIE ROD		3-12-000-06486					1	
17	SPLIT PIN		STANDARD					3	
16	NUT		3-80-999-99152					1	
15	TURN BUCKLE		2-12-000-01853					1	
14	INNER PIPE GUIDE		3-80-999-99154					1	
13	NAME PLATE		3-80-999-99118					1	
12	TRAVEL SCALE		3-80-999-99119					2	
11	SPRING		2-80-999-99117					1	
10	POINTER		4-80-999-99047					2	
09	BEARING PLATE ASSY		3-80-999-99183					1	
08	SPRING PLATE		3-80-999-99182					1	
07	HYD.LOCK NUT		3-80-999-99153					1	
06	CENTERING NUT		2-80-999-99131					1	
05	BOTTOM SOCKET		2-80-999-99136					1	
04	TOP TIE ROD		3-80-999-99189					1	
03	TOP PLATE		3-80-999-99180					1	
02	BOTTOM PLATE		3-80-999-99179					1	
01	HOUSING		3-80-999-99176					1	

REV	DATE	ALTERED :
01		CHD & APPD :

CAUTION: The information on this document is the property of BHARAT HEAVY ELECTRICALS LTD. It must not be used directly or indirectly in any way without the prior written consent of the company.

TYPE OF PRODUCT OR NAME OF CUSTOMER/PROJECT

Bharat Heavy Electricals Ltd  
UNIT: HIGH PRESSURE BOILER PLANT  
TIRUCHIRAPALLI - 620014

DRN R.GOBI  
CHD THINESH KUMAR  
APPD R.T

DATE 15.12.2014  
DATE 15.12.2014  
DATE 16.12.2014

DEPT PP  
CODE 121

SCALE NTS

WEIGHT (Kg)

REF TO ASSY / OLD DWG 1-80-999-99007

TITLE VARIABLE LOAD HANGERS (TYPE SAT 160)


DRAWING NO : 1-12-000-01483

REV 00



20066-666-08-1

CAUTION: THE INFORMATION ON THIS DRAWING IS THE PROPERTY OF BHARAT HEAVY ELECTRICALS LTD. IT MUST NOT BE USED BY ANY OTHER PARTY WITHOUT THE WRITTEN PERMISSION OF BHARAT HEAVY ELECTRICALS LTD. IN ANY MANNER THAT IS DETRIMENTAL TO THE INTEREST OF THE COMPANY.

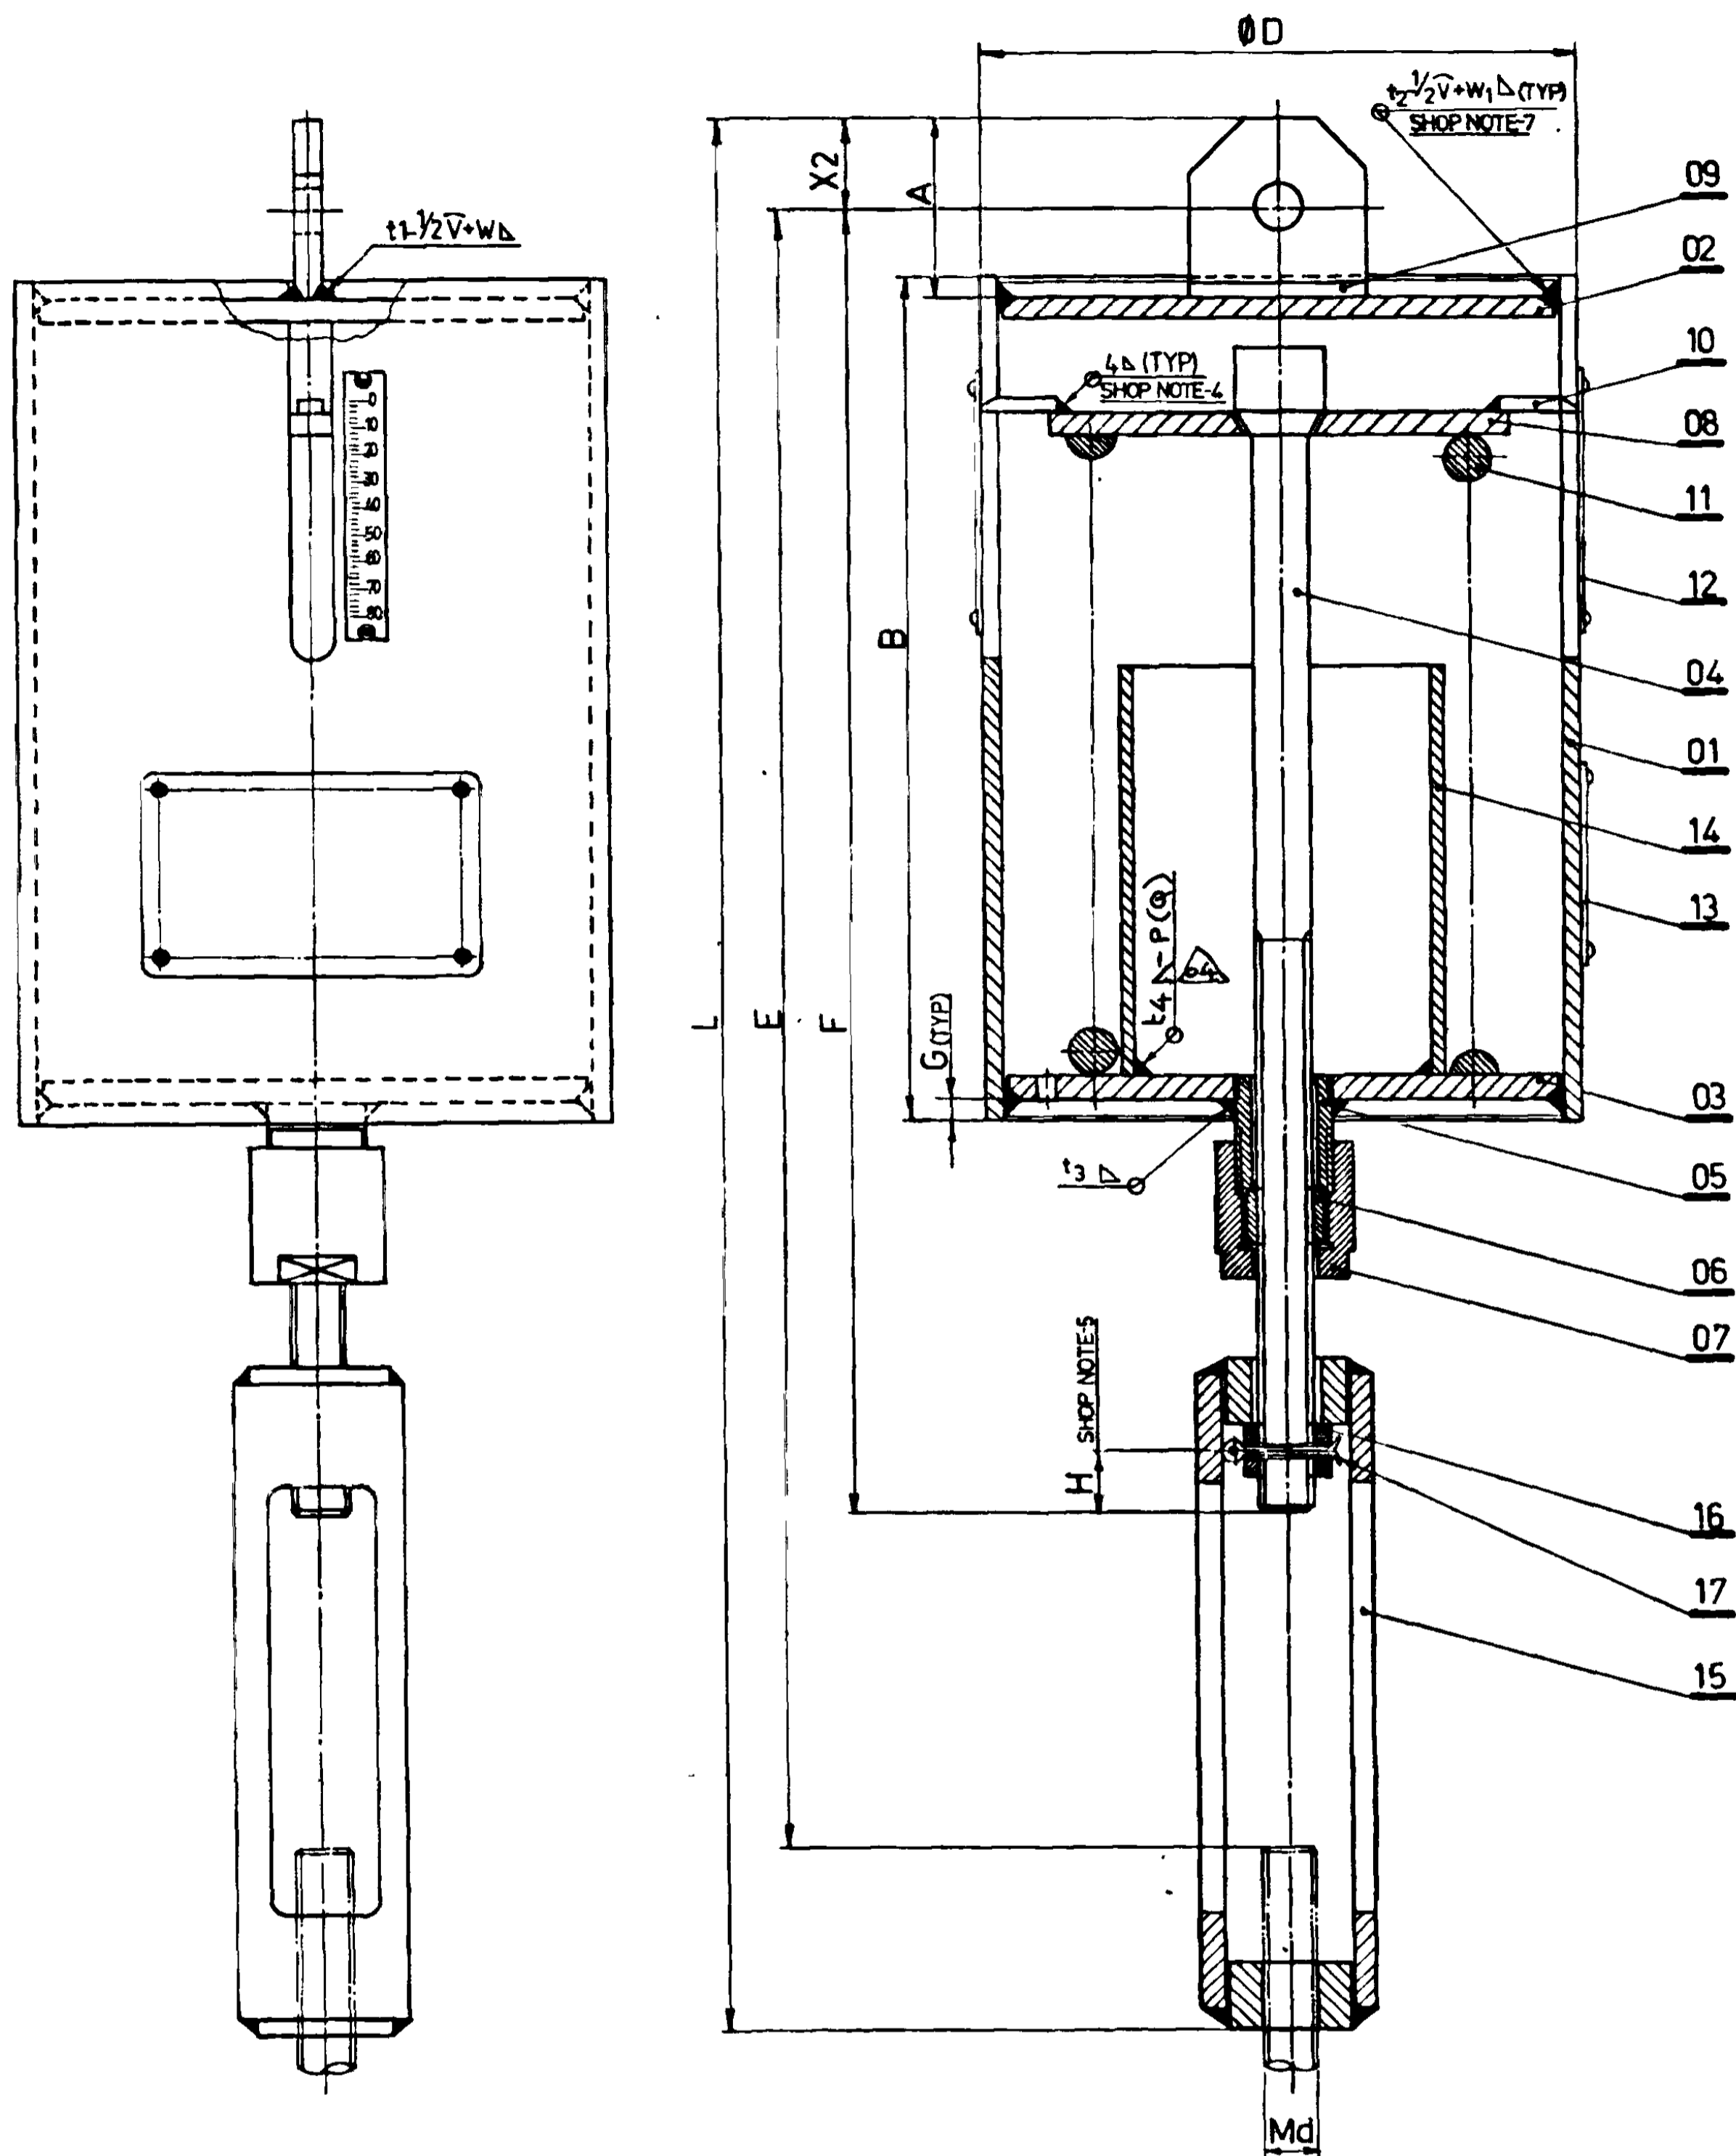

VAR NO	TYPE	BIN CODE	D	B	L	Md	SSY WEIGHT (Kg)	R	F	K	G	H	X2	t3b	t1-1/2V+WB	t2-1/2V+WB	t4D-P(Q)	REMARKS
01	SH 1-80	94-821-401-00	113.9	219	477	M12x1.75	5.157	50	336	386	5.0	11	20	4b	2.5-1/2 V+4b	4-1/2 V+4b	3b-20(25)	
02	SH 2-80	94-821-402-00	186.5	216	472	M12x1.75	8.874	50	331	381	6.0	11	20	4b	2.5-1/2 V+4b	4-1/2 V+5b	3b-20(40)	
03	SH 3-80	94-821-403-00	113.9	286	544	M12x1.75	6.926	50	403	453	5.0	11	20	4b	2.5-1/2 V+4b	4-1/2 V+4b	3b-15(20)	
04	SH 4-80	94-821-404-00	113.9	303	561	M12x1.75	8.165	50	420	470	5.0	11	20	4b	2.5-1/2 V+4b	4-1/2 V+4b	3b-20(25)	
05	SH 5-80	94-821-405-00	186.5	310	608	M16x2.0	14.806	80	448	498	6.0	13	30	5b	3-1/2 V+5b	4-1/2 V+5b	3b-20(35)	
06	SH 6-80	94-821-406-00	186.5	310	608	M16x2.0	16.055	80	448	498	6.0	13	30	5b	3-1/2 V+5b	5-1/2 V+5b	3b-20(35)	
07	SH 7-80	94-821-407-00	219.1	314	701	M20x2.5	27.612	70	486	561	7.0	15	35	8b	4-1/2 V+8b	6-1/2 V+8b	3b-30(50)	
08	SH 8-80	94-821-408-00	166.5	403	822	M24x3.0	29.246	80	602	677	6.0	17	40	8b	5-1/2 V+8b	5-1/2 V+8b	3b-25(35)	
09	SH 9-80	94-821-409-00	219.1	466	883	M24x3.0	51.936	80	663	738	7.0	17	40	8b	5-1/2 V+8b	6-1/2 V+8b	3b-30(40)	
10	SH10-80	94-821-410-00	219.1	434	989	M30x3.5	69.563	100	748	823	7.0	20	50	7b	8-1/2 V+8b	6-1/2 V+8b	3b-30(50)	
11	SH11-80	94-821-411-00	323.9	469	1012	M36x4.0	122.552	120	761	836	9.0	23	80	8b	8-1/2 V+8b	8-1/2 V+8b	3b-40(80)	
12	SH12-80	94-821-412-00	355.6	517	1193	M48x5.0	200.531	154	905	980	9.0	29	77	10b	10-1/2 V+8b	8-1/2 V+8b	3b-40(80)	
13	SH13-80	94-821-413-00	408.4	619	1363	M56x4.0	303.837	180	1062	1137	11.0	33	90	15b	12.5-1/2 V+8b	10-1/2 V+10b	3b-50(80)	

**NOTES :**

**GENERAL :**

- FOR SPRING RATE AND SELECTION CHART REFER DRG. NO. 4-80-999-99068
- FOR DIMENSIONS OF THE SPRING REFER DRG. NO. 4-80-999-99068
- DIMENSIONS INDICATED IN THIS DRAWING ARE BASED ON THE INITIAL PRECOMPRESSION OF 50 MM FOR ALL TYPES. DIMENSIONS L, E, F MAY CHANGE IN LINE WITH THE TOLERANCES/CHARACTERISTICS OF THE SPRING, IN THE ASSEMBLY.

**FOR SHOPS :**

- TRAVEL SCALE (ITEM 12) SHALL BE FIXED AT A POSITION, SUCH THAT THE POINTER (ITEM 10) READS 40MM IN THE TRAVEL SCALE AT THE MID LOAD (CORRESPONDING TO LOAD AT 40MM TRAVEL - GIVEN IN DRG 4-80-999-99068).

**2. LOCKING :**

- TYPES SH1-80 TO SH9-80 SHALL BE LOCKED IN 'ZERO' POSITION USING ITEM NO. 06 & 07 PRIOR TO DESPATCH. (i.e. WITH POINTER AT '0' READING)
- TYPES SH10-80 & ABOVE SHALL BE PRECOMPRESSIONED TO THE COLD POSITION INDICATED IN THE CONTRACT DOCUMENTS FOR INDIVIDUAL HANGERS. AT THIS PRECOMPRESSION, HANGERS SHALL BE LOCKED USING ITEM NOS. 06 & 07 PRIOR TO DESPATCH.

**3. MARKING :**

- FOR TYPES SH10-80 & ABOVE, HANGER TAG NO., OPERATING LOAD AND MOVEMENT SHALL BE PUNCHED IN THE NAME PLATE (ITEM NO. 13), BASED ON THE DETAILS INDICATED IN THE CONTRACT DOCUMENTS.
- FOR TYPES SH10-80 & ABOVE, COLD AND HOT SETTING POSITIONS SHALL BE MARKED ON THE TRAVEL SCALE (ITEM NO. 12) WITH GREEN AND RED PAINTS RESPECTIVELY.
- TYPE NUMBERS SHALL BE PUNCHED ON ALL HANGERS.

- POINTERS (ITEM NO. 10) ARE TO BE WELDED TO SPRING PLATE (ITEM NO. 08) SUCH THAT THEY PROTRUDE BY 3MM OUTSIDE THE HOUSING (ITEM NO. 01).

- SPINDLE BOLT AND NUT (ITEM NOS. 04 & 05) SHALL BE MATCH-DRILLED, FOR EACH AND EVERY ASSEMBLY, TO THE HOLE SIZE INDICATED BELOW :

TYPE	HOLE SIZE
SH1-80 TO SH7-80	DIA 4.5 MM
SH8-80 & SH9-80	DIA 5.5 MM
SH10-80 TO SH13-80	DIA 7.0 MM

- THE SLOTS ON TOP ARE TO BE FREE FROM WELDMETAL (i.e.) AFTER WELDING ALL ROUND, THE SLOTS SHALL BE DRESSED TO HAVE A SMOOTH SURFACE IN LINE WITH THE TOP SURFACE OF THE TOP PLATE.

**FOR SITE :**

**1. BEFORE HYDRAULIC TEST :**

- TYPES SH1-80 TO SH9-80 : HANGERS SHALL BE ADJUSTED TO THE COLD SET LOAD INDICATED IN THE CONTRACT DOCUMENTS FOR THE RESPECTIVE HANGER TAG NOS. PRIOR TO ERECTION. AT THIS SET LOAD, HANGERS SHALL BE LOCKED USING ITEM NOS. 06 & 07.
- TYPES SH10-80 & ABOVE : HANGERS SHALL BE CHECKED FOR LOCKED CONDITION AT THE COLD SET LOAD ALREADY DONE AT SHOPS.

**2. AFTER HYDRAULIC TEST :**

- ALL HANGERS SHALL BE UNLOCKED BY LOOSENING ITEM NOS. 06 & 07 UNTIL THEY ARE SEATED ON TURN BUCKLE (ITEM NO. 06).

**3. MARKING FOR SH1-80 TO SH9-80 :**

- HANGER TAG NO., OPERATING LOAD AND MOVEMENT SHALL BE PUNCHED IN THE NAME PLATE (ITEM NO. 13), BASED ON DETAILS INDICATED IN THE CONTRACT DOCUMENTS.
- COLD AND HOT SETTING POSITIONS SHALL BE MARKED ON THE TRAVEL SCALE WITH GREEN AND RED PAINTS RESPECTIVELY.

**NOTES FOR SHOPS (CONTD)**

- ITEM NO. 13 SHALL BE WELDED TO ITEM NO. 3 AND THE WELD SHALL BE WELDED TO ITEM NO. 1. THIS SHALL BE CONSISTENT WITH ITEM NO. 13. ITEM NO. 13 SHALL BE ELECTROLYTICALLY GALVANIZED TO A DEPTH OF 15MM FROM BOTH SIDES OF THE HOUSING. SIMILARLY ITEM NO. 13 SHALL BE ELECTROLYTICALLY GALVANIZED TO A DEPTH OF 15MM FROM BOTH SIDES OF THE HOUSING.
- THE ASSEMBLED VARIABLE LOAD HANGER SHALL BE PAINTED WITH EPOXY ZINC DUST PRIMER WITH AN OVER COAT OF ENAMEL PAINT. DUE CARE SHALL BE TAKEN TO PROTECT SUITABLY THE GALVANIZED/CHROMIATED COMPONENTS FROM PAINTING.
- PAINTING SCHEME SHALL BE AS PER APPLICABLE QUALITY PLAN.

**REFERENCE DRAWINGS:-**

ITEM NO.	DESCRIPTION	DRAWING NO.	QTY
18	HAMMER DRIVEN SCREW	STANDARD	8
17	SPLIT PIN	STANDARD	1
16	NUT	3-80-999-99152	1
15	TURN BUCKLE	2-80-999-99140	1
14	INNER PIPE GUIDE	3-80-999-99154	1
13	NAME PLATE	3-80-999-99118	1
12	TRAVEL SCALE	3-80-999-99117	2
11	SPRING	2-80-999-99117	1
10	POINTER	4-80-999-99047	2
09	LUG PLATE	2-80-999-99138	1
08	SPRING PLATE	2-80-999-99133	1
07	HYD. LOCK NUT	3-80-999-99153	1
06	CENTERING NUT	2-80-999-99131	1
05	BOTTOM SOCKET	2-80-999-99136	1
04	SPINDLE BOLT	2-80-999-99137	1
03	BOTTOM PLATE	2-80-999-99135	1
02	TOP PLATE	2-80-999-99130	1
01	HOUSING	3-80-999-99157	1

TYPE OF PRODUCT OR NAME OF CUSTOMER/PROJECT: **STANDARD**

**BHARAT HEAVY ELECTRICALS LTD.**  
PIPING CENTRE, MADRAS

DATE: 01.07.88  
APPROVED: 220788

ITEM NO. 07

**VARIABLE LOAD HANGERS (Type: SH 80)**



1-80-999-99002

REV	DATE	ALTERED BY	APPROVED BY	REV	DATE	ALTERED BY	APPROVED BY	REV	DATE	ALTERED BY	APPROVED BY
07	11/19/2007	APPR. AMK-SL	06/2/2008	05	12/11/2007	05/12/2007	05/12/2007	02	27/6/07	CHECKED SA-	
<p>GENERAL NOTE 3 ALTERED.</p> <p>SHOP NOTES 1, 2a, 2b ALTERED.</p> <p>TITLE CHANGED FROM "VARIABLE SPRING HANGERS" TO "VARIABLE LOAD HANGERS".</p> <p>SHOP NOTE 4 ALTERED FOR POINTERS.</p> <p>SHOP NOTE 8 ALTERED FOR PAINTING.</p> <p>GENERAL NOTE NO. 2 DELETED.</p> <p>NOTE NO. 6 (FOR SHOPS) DELETED.</p> <p>NOTE NO. 8 (FOR SHOPS) CHANGED.</p> <p>WELD LENGTH ALTERED FOR WELDING ITEM NO. 03 &amp; 4 AND INCLUDED IN THE TABLE.</p> <p>FOR VAR. NO. 03 - DIMENSIONS B, L, E, F AND WEIGHT ALTERED. NOTE 6 (FOR SHOPS) REVISED.</p> <p>REV. DATE 12/11/07.</p> <p>NOTE 8 ADDED UNDER SHOP NOTES.</p>											

E0066-666-08-1

CS-227/C

CAUTION THE INFORMATION ON THIS DOCUMENT IS THE PROPERTY OF BHARAT HEAVY ELECTRICALS LTD. IT MUST NOT BE USED, REPRODUCED, COPIED, EITHER DIRECTLY OR INDIRECTLY IN ANY MANNER WITHOUT THE WRITTEN PERMISSION OF THE COMPANY.

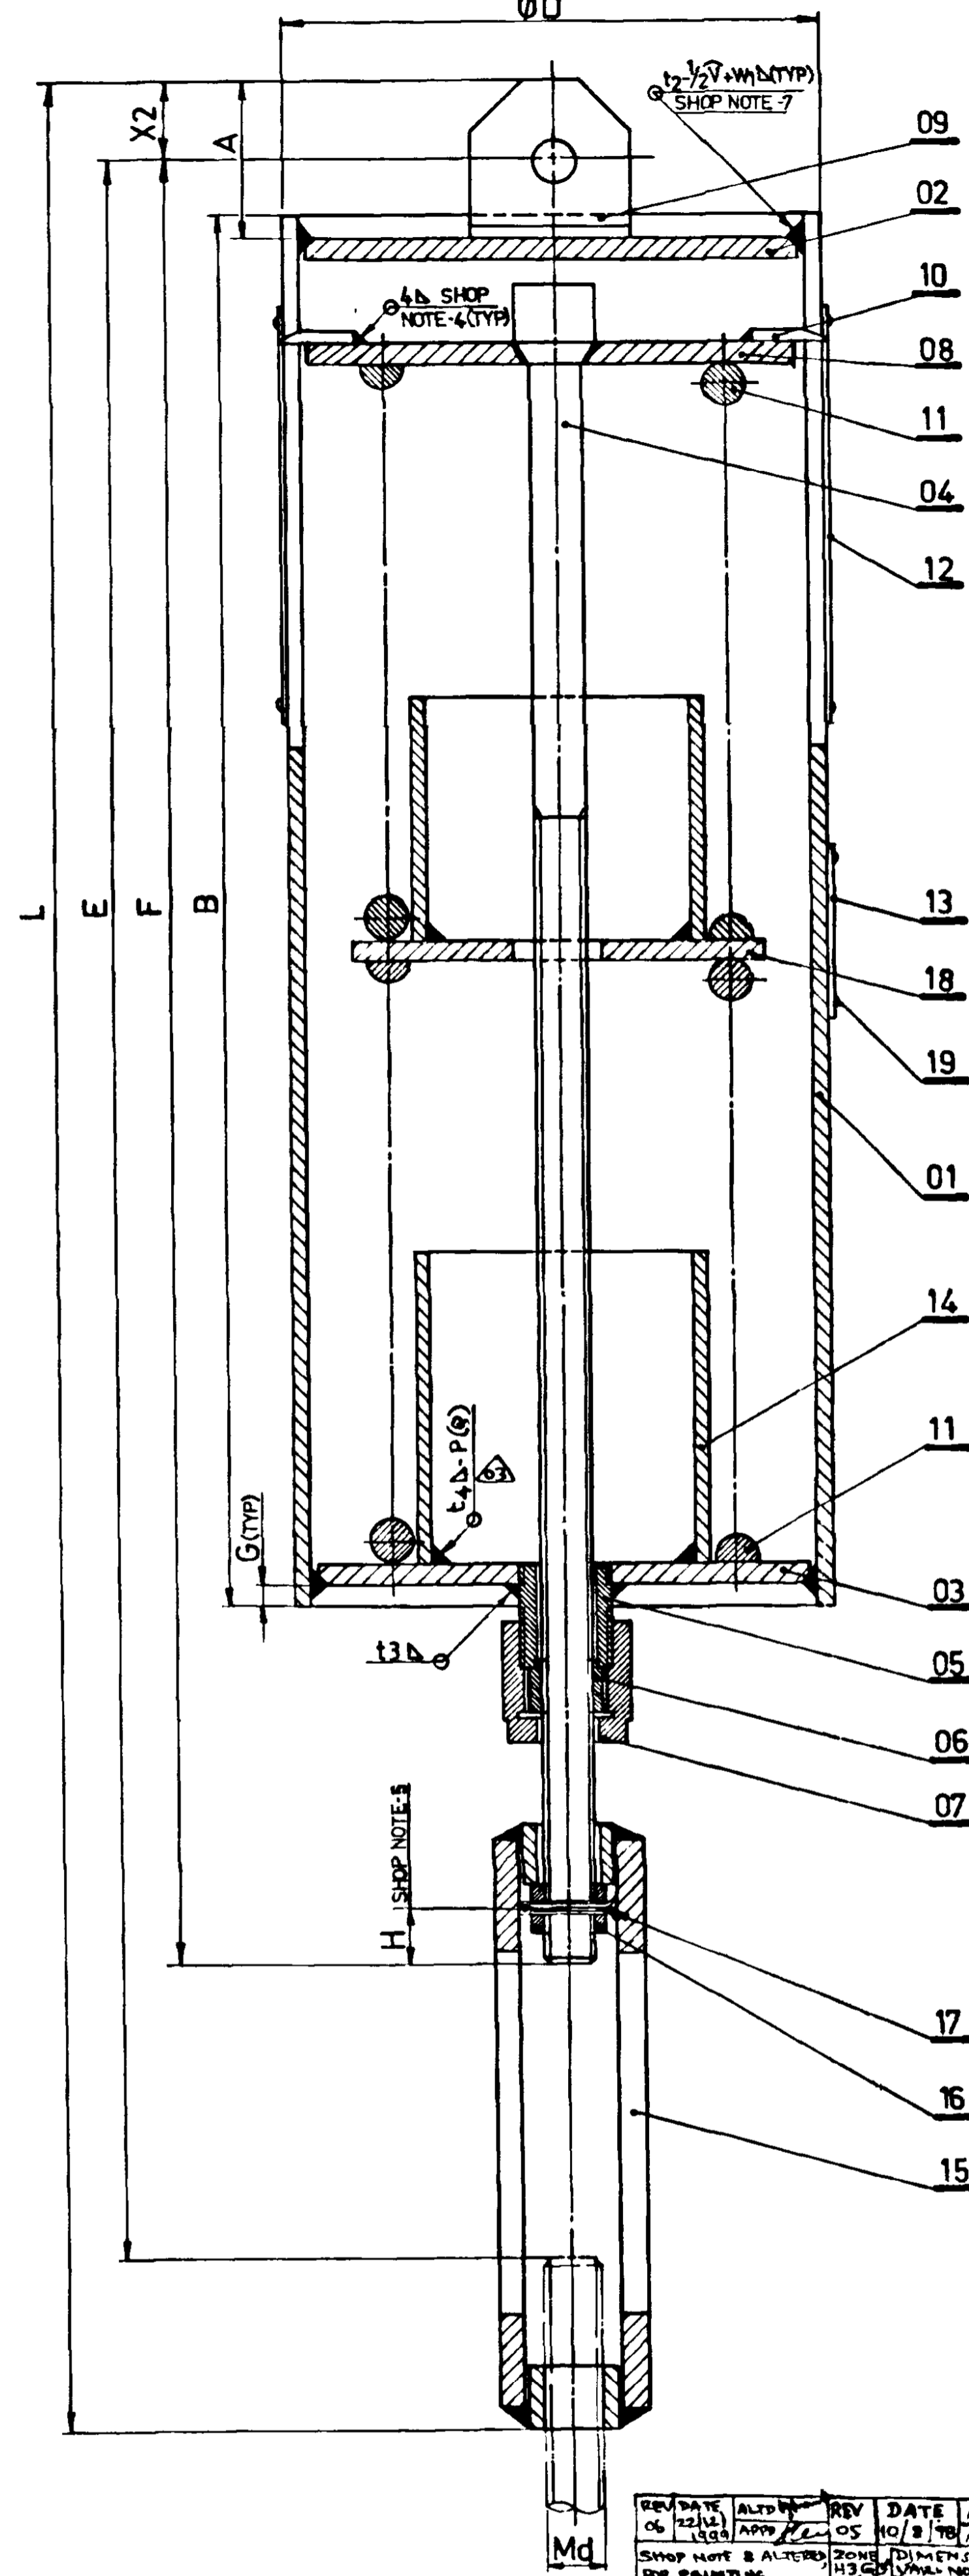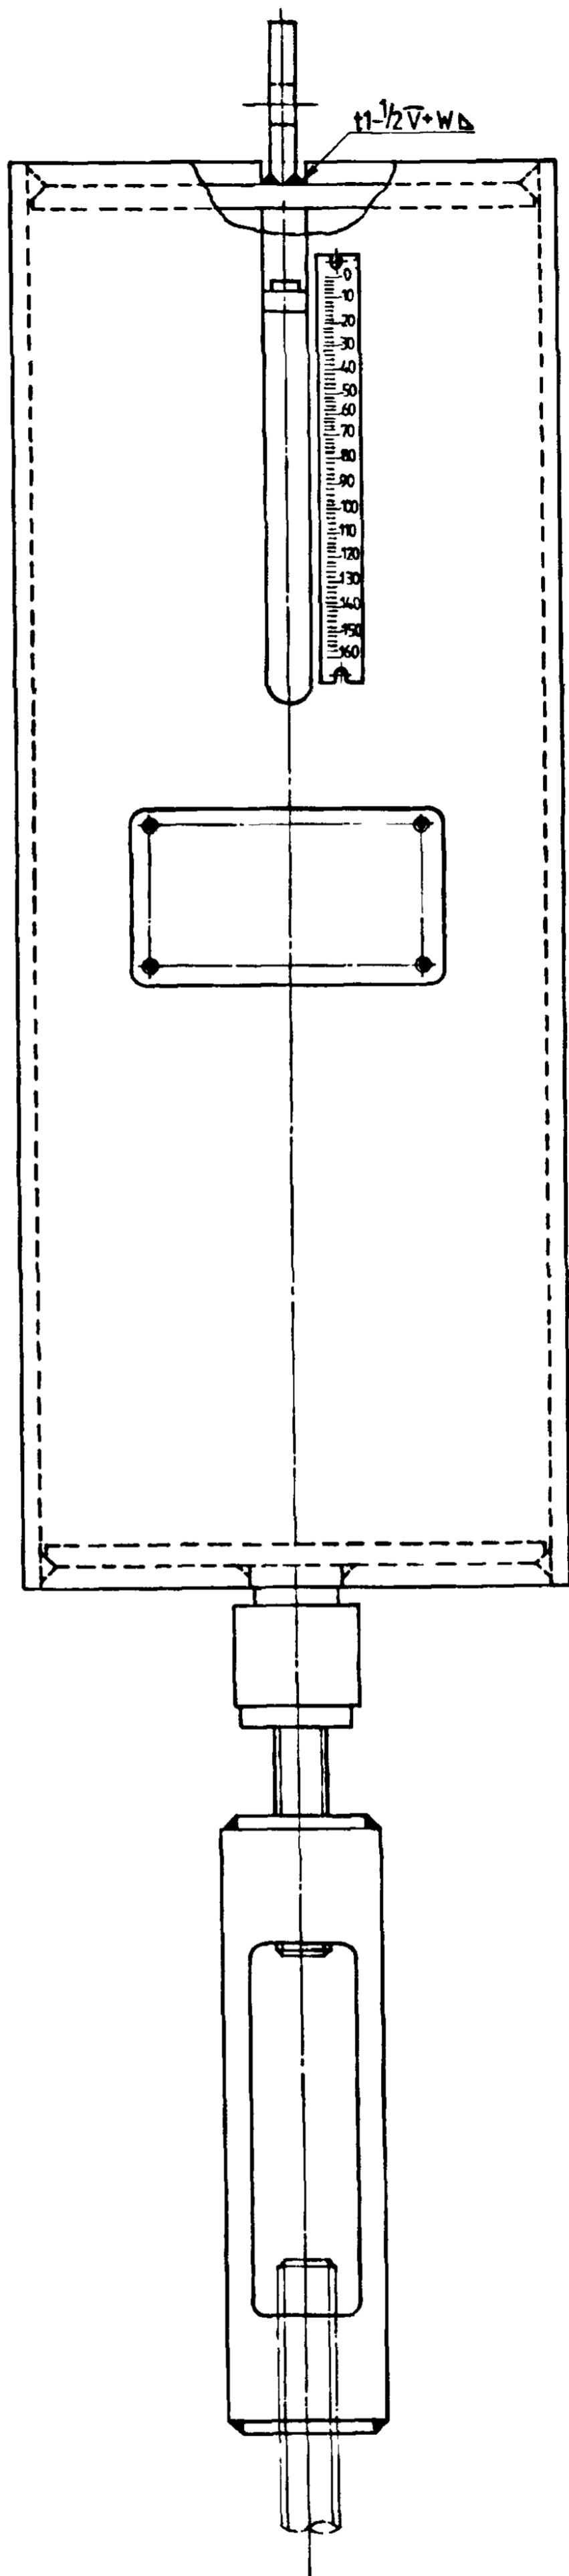

VAR NO	TYPE	BIN CODE	D	B	L	Md	ASSY WEIGHT (kg)	A	F	E	G	H	X2	3D	1-1/2 V+4b	2-1/2 V+4b	3-1/2 V+4b	4-1/2 V+4b	5-1/2 V+4b	6-1/2 V+4b	7-1/2 V+4b	8-1/2 V+4b	9-1/2 V+4b	10-1/2 V+4b	11-1/2 V+4b	12-1/2 V+4b	13-1/2 V+4b	
01	SH 1-160	94-821-418-00	113.9	393	659	M12x1.75	8,156	50	518	568	5	11	20	4b	2.5-1/2 V+4b	4-1/2 V+4b	3b-20(25)											
02	SH 2-160	94-821-417-00	166.5	385	649	M12x1.75	14,226	50	508	558	6	11	20	4b	2.5-1/2 V+4b	4-1/2 V+4b	3b-20(40)											
03	SH 3-160	94-821-418-00	113.9	527	793	M12x1.75	11,080	50	652	702	5	11	20	4b	2.5-1/2 V+4b	4-1/2 V+4b	3b-15(25)											
04	SH 4-160	94-821-419-00	113.9	561	827	M12x1.75	14,169	50	686	736	5	11	20	4b	2.5-1/2 V+4b	4-1/2 V+4b	3b-20(25)											
05	SH 5-160	94-821-420-00	188.5	573	861	M16x2.0	25,018	60	719	769	6	13	30	5b	3-1/2 V+5b	4-1/2 V+5b	3b-20(35)											
06	SH 6-160	94-821-421-00	166.5	569	875	M16x2.0	26,839	60	715	765	6	13	30	6b	3-1/2 V+5b	5-1/2 V+5b	3b-20(35)											
07	SH 7-160	94-821-422-00	219.1	573	968	M20x2.5	46,336	70	753	828	7	15	35	8b	4-1/2 V+6b	6-1/2 V+6b	3b-30(50)											
08	SH 8-160	94-821-423-00	166.5	769	1176	M24x3.0	50,848	80	956	1031	6	17	40	8b	5-1/2 V+6b	5-1/2 V+6b	3b-25(35)											
09	SH 9-160	94-821-424-00	219.1	869	1234	M24x3.0	92,043	80	1076	1149	7	17	40	8b	5-1/2 V+6b	6-1/2 V+6b	3b-30(40)											
10	SH10-160	94-821-425-00	219.1	917	1420	M30x3.5	118,865	100	1179	1254	7	20	50	7b	6-1/2 V+6b	6-1/2 V+6b	3b-30(50)											
11	SH11-160	94-821-426-00	323.9	863	1414	M36x4.0	210,309	120	1183	1238	9	23	60	8b	8-1/2 V+8b	8-1/2 V+8b	3b-40(80)											
12	SH12-160	94-821-427-00	355.6	951	1635	M48x5.0	342,994	154	1347	1422	5	29	77	10b	10-1/2 V+8b	8-1/2 V+8b	3b-40(80)											
13	SH13-160	94-821-428-00	408.4	1146	1898	M56x4.0	525,352	180	1597	1672	11	33	90	15b	12.5-1/2 V+8b	10-1/2 V+8b	3b-50(80)											

NOTES

GENERAL

1. FOR SPRING RATE AND SELECTION CHART REFER DRG. NO. 4-80-999-99068.

2. DIMENSIONS INDICATED IN THIS DRAWING ARE BASED ON THE INITIAL PRECOMPRESSION OF 112 MM. FOR ALL TYPES, DIMENSIONS L, E, F MAY CHANGE IN LINE WITH THE TOLERANCES / CHARACTERISTICS OF THE SPRING, IN THE ASSEMBLY.

3. DIMENSIONS INDICATED IN THIS DRAWING ARE BASED ON THE INITIAL PRECOMPRESSION OF 112 MM. FOR ALL TYPES, DIMENSIONS L, E, F MAY CHANGE IN LINE WITH THE TOLERANCES / CHARACTERISTICS OF THE SPRING, IN THE ASSEMBLY.

FOR SHOPS

1. TRAVEL SCALE (ITEM 12) SHALL BE FIXED AT A POSITION, SUCH THAT THE POINTER (ITEM 10) READS 80 MM IN THE TRAVEL SCALE AT THE MID LOAD (CORRECTING TO LOAD AT 80 MM TRAVEL - GIVEN IN DRG 4-80-999-99068).

2. LOCKING

a. TYPES SH1-160 TO SH9-160 SHALL BE LOCKED IN ZERO POSITION USING ITEM NO. 06 & 07 PRIOR TO DESPATCH (i.e. WITH POINTER AT "0" READING).  
b. TYPES SH10-160 & ABOVE SHALL BE PRECOMRESSED TO THE COLD POSITION INDICATED IN THE CONTRACT DOCUMENTS FOR INDIVIDUAL HANGERS. AT THIS PRECOMPRESSION, HANGERS SHALL BE LOCKED USING ITEM NOS. 06 & 07 PRIOR TO DESPATCH.

3. MARKING

a. FOR TYPES SH10-160 & ABOVE, HANGER TAG NO., OPERATING LOAD AND MOVEMENT SHALL BE PUNCHED IN THE NAME PLATE (ITEM NO. 13), BASED ON THE DETAILS INDICATED IN THE CONTRACT DOCUMENTS.  
b. FOR TYPES SH10-160 & ABOVE, COLD AND HOT SETTING POSITIONS SHALL BE MARKED ON THE TRAVEL SCALE (ITEM NO. 12) WITH GREEN AND RED PRINTS RESPECTIVELY.  
c. TYPE NUMBERS SHALL BE PUNCHED ON ALL HANGERS.

4. POINTERS (ITEM NO. 10) ARE TO BE WELDED TO SPRING PLATE (ITEM NO. 08) SUCH THAT THEY PROTRUDE BY 2 TO 4 MM OUTSIDE THE HOUSING (ITEM NO. 01).

5. SPINDLE BOLT AND NUT (ITEM NOS. 04 & 18) SHALL BE MATCH-DRILLED FOR EACH AND EVERY ASSEMBLY TO THE HOLE SIZE INDICATED BELOW:  
TYPE HOLE SIZE  
SH1-160 TO SH7-160 DIA 4.5 MM  
SH8-160 & SH9-160 DIA 5.5 MM  
SH10-160 TO SH13-160 DIA 7.0 MM

6. THE SLOTS ON TOP ARE TO BE FREE FROM WELDMETAL (i.e.) AFTER WELDING ALL ROUND, THE SLOTS SHALL BE DRESSED TO HAVE A SMOOTH SURFACE IN LINE WITH THE TOP SURFACE OF THE TOP PLATE.

FOR SITE

1. BEFORE HYDRAULIC TEST

a. TYPES SH1-160 TO SH9-160 : HANGERS SHALL BE ADJUSTED TO THE COLD SET LOAD INDICATED IN THE CONTRACT DOCUMENTS FOR THE RESPECTIVE HANGER TAG NOS. PRIOR TO ERECTION. AT THIS SET LOAD, HANGERS SHALL BE LOCKED USING ITEM NOS. 06 & 07.  
b. TYPES SH10-160 & ABOVE : HANGERS SHALL BE CHECKED FOR LOCKED CONDITION AT THE COLD SET LOAD ALREADY DONE AT SHOPS.

2. AFTER HYDRAULIC TEST

a. ALL HANGERS SHALL BE UNLOCKED BY LOOSENING ITEM NOS. 06 & 07 UNTIL THEY ARE SEATED ON TURN BUCKLE (ITEM NO. 15).

3. MARKING FOR SH1-160 TO SH9-160

a. HANGER TAG NO., OPERATING LOAD AND MOVEMENT SHALL BE PUNCHED IN THE NAME PLATE (ITEM NO. 13), BASED ON DETAILS INDICATED IN THE CONTRACT DOCUMENTS.  
b. COLD AND HOT SETTING POSITIONS SHALL BE MARKED IN THE TRAVEL SCALE WITH GREEN AND RED PRINTS RESPECTIVELY.

NOTES FOR SHOP (CONTD)

ITEM NO. 03 AND THIS WELDED... SHALL BE WELDED... THIS FINAL ASS... SHALL... DEPTH OF... AND THEM... SIMILAR... THIS WELDED... SHALL... IS AN... CHROMIUM... CHROMIUM... CHROMIUM...

THE ASSEMBLY VARIABLE SPRING HANGER SHALL BE PAINTED WITH EPOXY ZINC DUST PRIMER WITH AN OVERCOAT OF ENAMEL PAINT. DUE CARE SHALL BE TAKEN TO PROTECT SUITABLY THE (ALUMINISED) CHROMIUM COMPONENTS WHILE PAINTING.

8. PAINTING SCHEME SHALL BE AS PER APPLICABLE QUALITY PLAN.

ITEM NO.	DESCRIPTION	DRAWING NO.	QTY
19	HANGER DRIVEN SCREW	STANDARD	8
18	MIDDLE PLATE ASSY	2-80-999-99129	1
17	SPLIT PIN	STANDARD	1
16	NUT	3-80-999-99152	1
15	TURN BUCKLE	2-80-999-99140	1
14	INNER PIPE GUIDE	3-80-999-99154	1
13	NAME PLATE	3-80-999-99118	1
12	TRAVEL SCALE	3-80-999-99119	2
11	SPRING	2-80-999-99117	2
10	POINTER	4-80-999-99047	2
09	LUG PLATE	2-80-999-99138	1
08	SPRING PLATE	2-80-999-99133	1
07	HYD. LOCK NUT	3-80-999-99153	1
06	CENTERING NUT	2-80-999-99131	1
05	BOTTOM SOCKET	2-80-999-99136	1
04	SPINDLE BOLT	2-80-999-99141	1
03	BOTTOM PLATE	2-80-999-99135	1
02	TOP PLATE	2-80-999-99130	1
01	HOUSING	3-80-999-99149	1

REV DATE ALT. BY APPD. BY  
06 14/03/99 APPD. J. JUDE  
07 24/03/99 APPD. J. JUDE  
08 24/03/99 APPD. J. JUDE  
TYPE OF PRODUCT OR NAME OF CUSTOMER/PROJECT

STANDARD

SHARAT HEAVY ELECTRICALS LTD., PIPING CENTRE, MADRAS

DR. P. SATHIYAMOORTHY  
ENGR. M. M. MANI  
APPD. J. JUDE

DEPT. GRADE OF UN TOL. DIM. CODE C/W/F

TITLE: VARIABLE LOAD HANGERS (Type: SH 160)

DATE: 07.07.88

SCALE: NTS

WEIGHT (KG): REF TO ASSY/CDG DRG

CARD CODE: U 01

DRAWING NO.: 1-80-999-99003

REV DATE ALT. BY APPD. BY  
06 14/03/99 APPD. J. JUDE  
07 24/03/99 APPD. J. JUDE  
08 24/03/99 APPD. J. JUDE  
REV DATE ALT. BY APPD. BY  
03 19/2/94 APPD. J. JUDE  
04 24/9/96 APPD. J. JUDE

REV DATE ALT. BY APPD. BY  
01 27/6/99 APPD. J. JUDE

REV DATE ALT. BY APPD. BY  
02 27/6/99 APPD. J. JUDE

REV DATE ALT. BY APPD. BY  
03 19/2/94 APPD. J. JUDE  
04 24/9/96 APPD. J. JUDE

REV DATE ALT. BY APPD. BY  
01 27/6/99 APPD. J. JUDE

REV DATE ALT. BY APPD. BY  
02 27/6/99 APPD. J. JUDE

REV DATE ALT. BY APPD. BY  
03 19/2/94 APPD. J. JUDE  
04 24/9/96 APPD. J. JUDE


REV DATE ALT. BY APPD. BY  
03 19/2/94 APPD. J. JUDE  
04 24/9/96 APPD. J. JUDE

REV DATE ALT. BY APPD. BY  
01 27/6/99 APPD. J. JUDE

REV DATE ALT. BY APPD. BY  
02 27/6/99 APPD. J. JUDE

REV DATE ALT. BY APPD. BY  
03 19/2/94 APPD. J. JUDE  
04 24/9/96 APPD. J. JUDE

90066-666-08-1

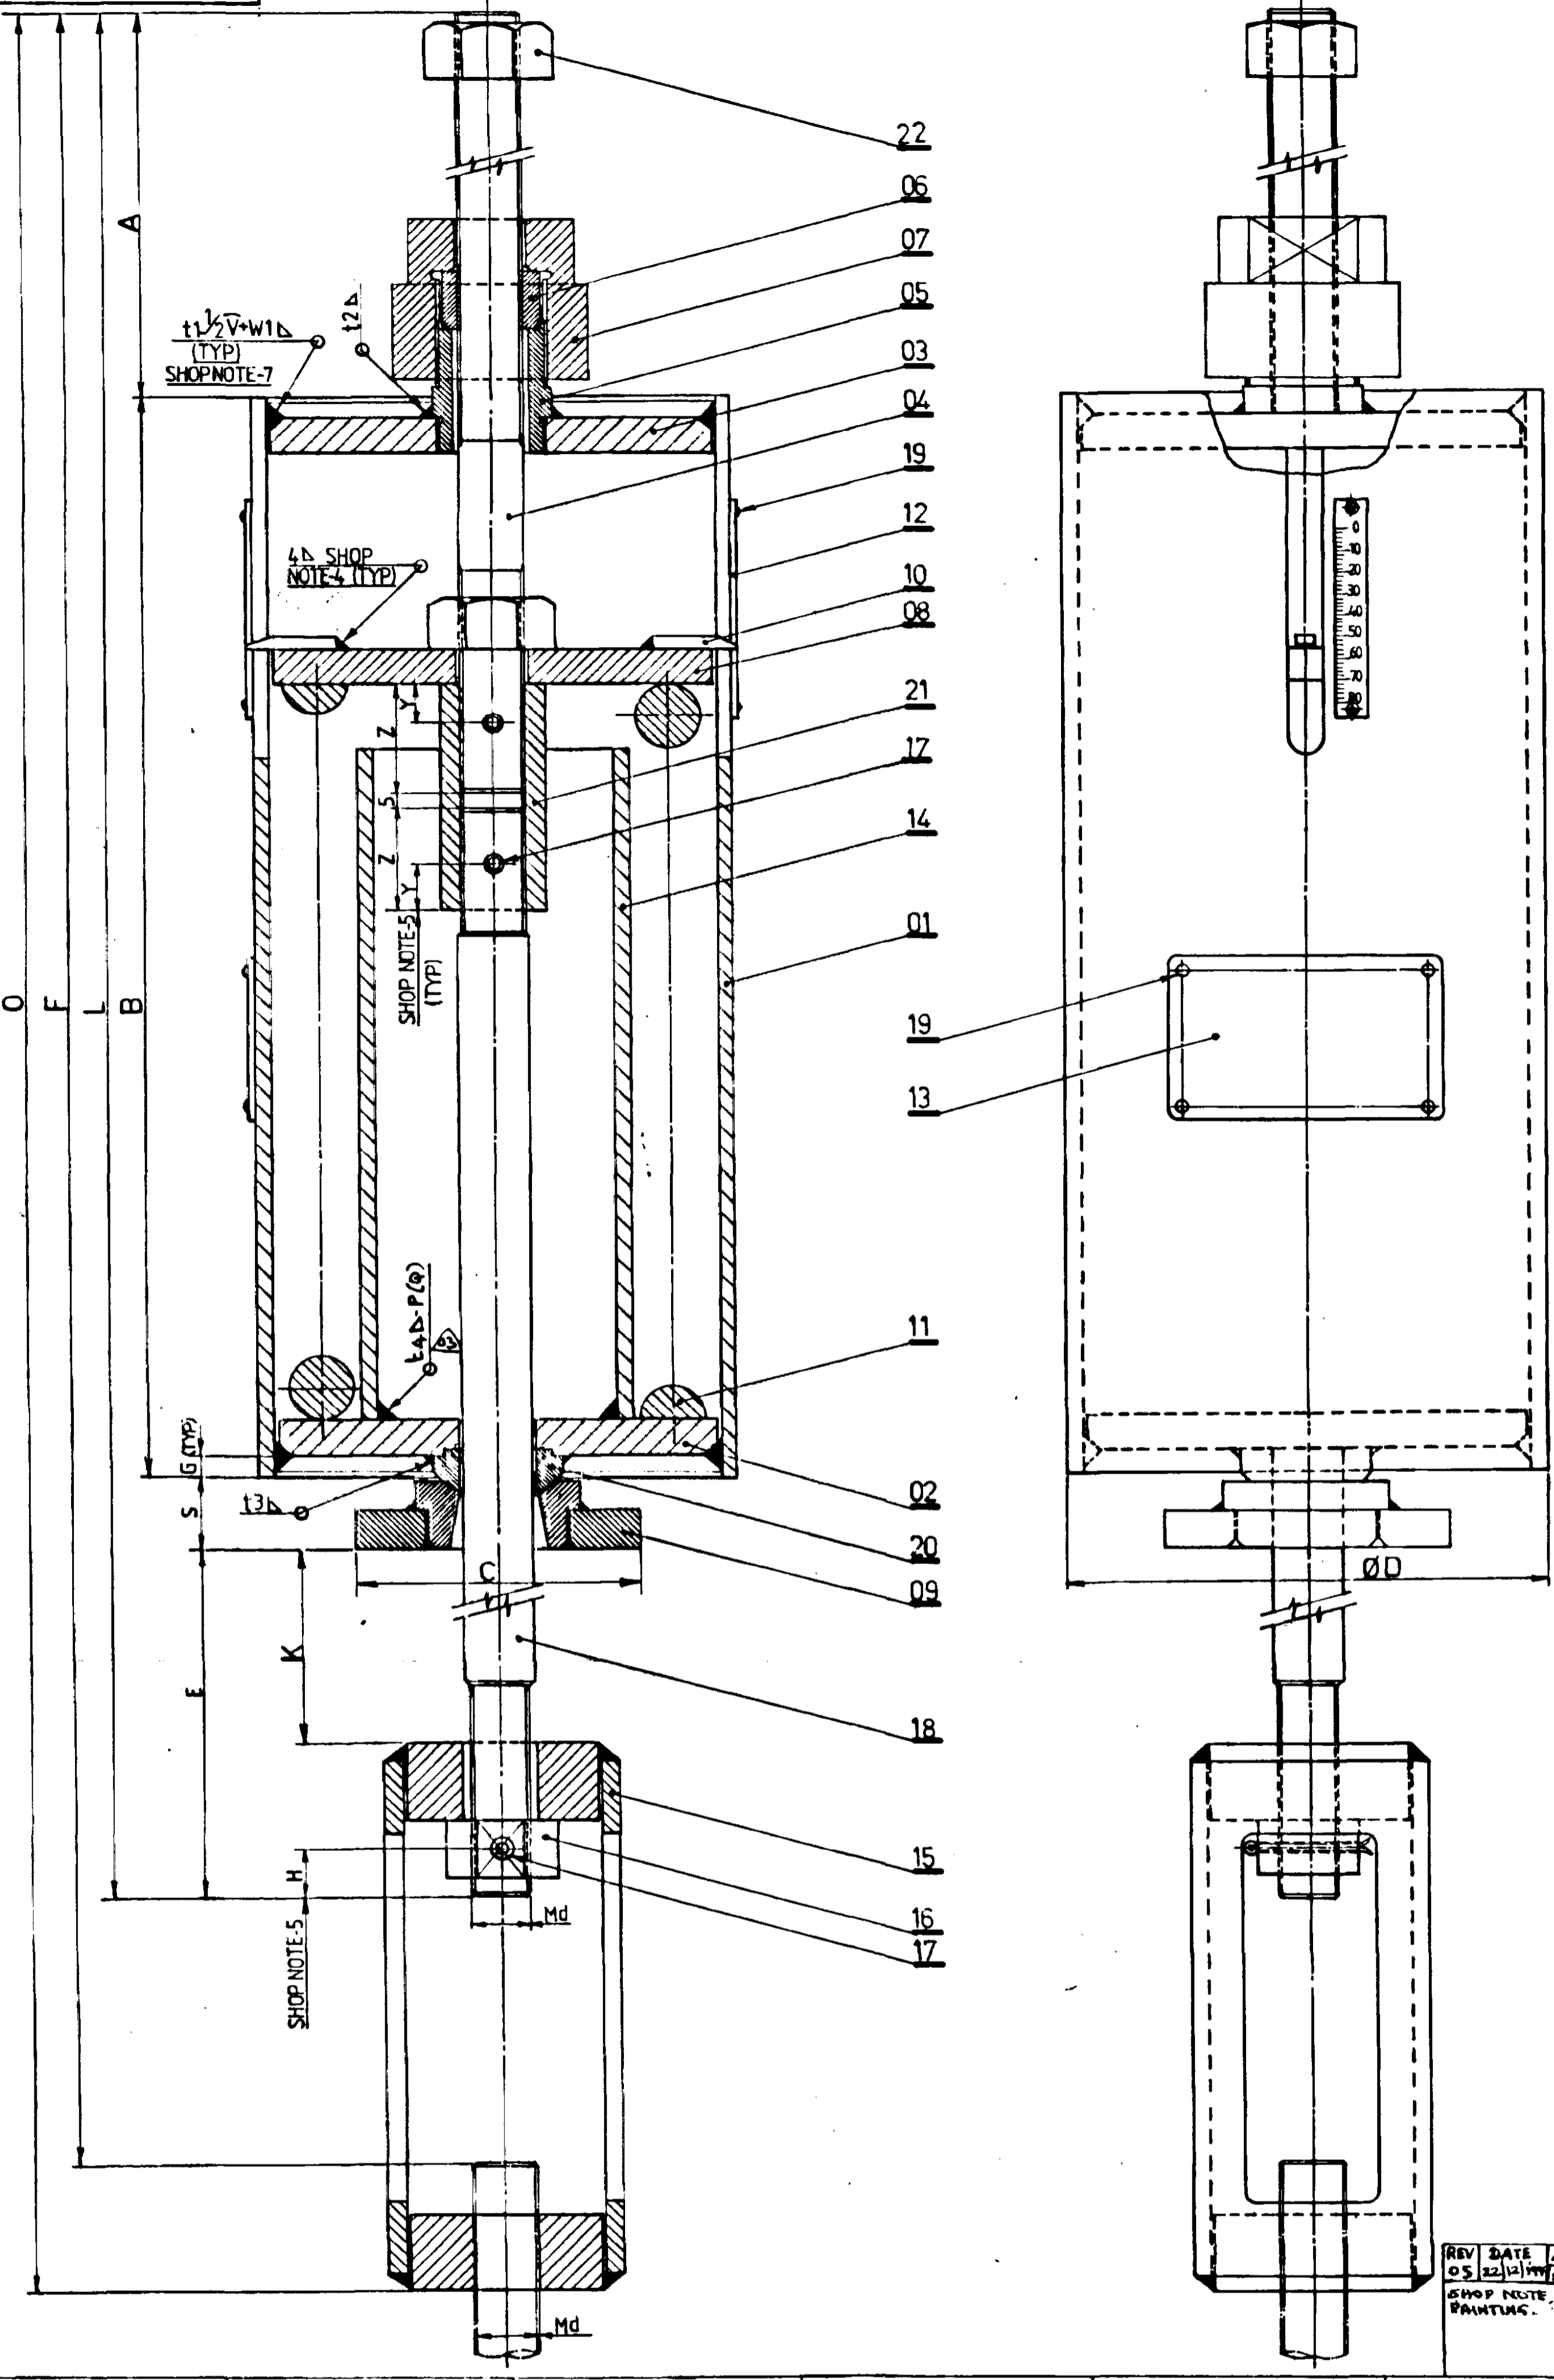

VAR NO.	TYPE	BIN CODE	Ø	B	O	Md	SSY. Vt (kg)	R	C	E	F	G	H	L	S	Y	Z	K	t1-1/2V+V1B	t2B	t3B	t4B-P(6)	REMARK
01	SA 1-80	94-821-461-00	113.9	204	638	M12x1.75	5.515	14.8	70	133	567	5	11	517	24	5	10	100	4-1/2V+4B	4B	4B	3B-20(25)	
02	SA 2-80	94-821-462-00	166.5	201	633	M12x1.75	8.631	14.7	70	133	562	6	11	512	23	5	10	100	4-1/2V+5B	4B	4B	3B-20(40)	
03	SA 3-80	94-821-463-00	113.9	271	755	M12x1.75	7.406	14.8	80	183	684	5	11	634	24	5	10	150	4-1/2V+4B	4B	4B	3B-15(20)	
04	SA 4-80	94-821-464-00	113.9	298	772	M12x1.75	8.641	14.8	80	189	701	5	11	651	24	5	10	150	4-1/2V+4B	4B	4B	3B-20(25)	
05	SA 5-80	94-821-465-00	166.5	298	866	M16x2.00	15.532	16.5	80	246	815	6	19	740	23	7	14	200	4-1/2V+5B	5B	4B	3B-20(35)	
06	SA 6-80	94-821-466-00	166.5	298	851	M16x2.00	16.764	16.4	80	246	814	6	19	739	23	7	14	200	5-1/2V+5B	5B	5B	3B-20(35)	
07	SA 7-80	94-821-467-00	219.1	305	949	M20x2.50	28.814	18.2	90	250	844	7	15	769	24	9	18	200	6-1/2V+6B	6B	5B	3B-30(50)	
08	SA 8-80	94-821-468-00	166.5	397	1111	M24x3.00	31.512	19.7	110	304	1007	6	17	932	25	10	20	250	5-1/2V+5B	6B	5B	3B-25(35)	
09	SA 9-80	94-821-469-00	219.1	460	1170	M24x3.00	54.087	19.4	110	304	1066	7	17	931	24	10	20	250	6-1/2V+6B	6B	6B	3B-30(40)	
10	SA10-80	94-821-470-00	219.1	493	1317	M30x3.50	74.479	21.9	130	371	1201	7	20	1126	35	13	26	300	6-1/2V+6B	7B	6B	3B-30(50)	
11	SA11-80	94-821-471-00	323.9	473	1327	M36x4.00	122.635	24.5	150	377	1211	9	23	1136	33	16	32	300	6-1/2V+8B	8B	8B	3B-40(80)	
12	SA12-80	94-821-472-00	355.6	530	1486	M48x5.00	216.674	28.8	200	409	1350	9	29	1275	39	21	42	300	6-1/2V+8B	10B	8B	3B-40(80)	
13	SA13-80	94-821-473-00	408.4	639	1685	M56x4.00	326.263	32.8	200	467	1549	11	33	1474	40	25	50	350	10-1/2V+10B	15B	8B	3B-50(80)	

NOTES 1

- GENERAL 1. FOR SPRING RATE AND SELECTION CHART REFER DRG. NO. 4-80-999-99068.  
 2. MATERIALS: SA 1-80 TO SA 13-80 REFER DRG. NO. 4-80-999-99068.  
 3. DIMENSIONS INDICATED IN THIS DRAWING ARE BASED ON THE INITIAL PRECOMPRESSION OF 56 MM. FOR ALL TYPES. DIMENSIONS E, F, L, O, K MAY CHANGE IN LINE WITH THE TOLERANCES/CHARACTERISTICS OF THE SPRING, IN THE ASSEMBLY.

FOR SHOPS 1

1. TRAVEL SCALE (ITEM 12) SHALL BE FIXED AT A POSITION, SUCH THAT THE POINTER (ITEM 10) READS 40mm IN THE TRAVEL SCALE AT THE MID LOAD (CORRESPONDING TO LOAD AT 40mm TRAVEL - GIVEN IN THE DRG 4-80-999-99068).  
 2. LOCKING:  
 a. ALL TYPES OF SPRING HANGERS SHALL BE PRECOMPRESSED TO THE COLD POSITION INDICATED IN THE CONTRACT DOCUMENTS FOR INDIVIDUAL HANGERS. AT THIS PRECOMPRESSION, HANGERS SHALL BE LOCKED USING ITEM NOS.06 & 07 PRIOR TO DESPATCH.  
 3. MARKING:  
 a. FOR ALL TYPES OF SPRING HANGERS, HANGER TAG NO., TYPE NO., OPERATING LOAD AND MOVEMENT SHALL BE PUNCHED IN THE NAME PLATE (ITEM NO.13), BASED ON THE DETAILS INDICATED IN THE CONTRACT DOCUMENTS.  
 b. FOR ALL TYPES OF SPRING HANGERS, COLD AND HOT MOVEMENT POSITIONS SHALL BE MARKED ON THE TRAVEL SCALE (ITEM NO.12) WITH GREEN AND RED PRINTS RESPECTIVELY.  
 4. POINTERS (ITEM NO.10) ARE TO BE WELDED TO SPRING PLATE (ITEM NO.08) SUCH THAT THEY PROTRUDE BY 2mm OUTSIDE THE HOUSING (ITEM NO.01).  
 5. TOP AND BOTTOM TIE RODS (ITEM NO. 04 & 18) ARE TO BE MATCH DRILLED WITH COUPLING (ITEM NO.21). ALSO BOTTOM TIE ROD (ITEM NO.18) IS TO BE MATCH DRILLED WITH NUT (ITEM NO. 16). HOLE SIZES FOR THESE MATCH DRILLING ARE GIVEN BELOW.  
 TYPE HOLE SIZE  
 SA1-80 TO SA7-80 DIA 4.5 MM  
 SA8-80 & SA9-80 DIA 5.5 MM  
 SA10-80 TO SA15-80 DIA 7.0 MM  
 7. THE SLOTS ON TOP ARE TO BE FREE FROM VELD METAL (I.e.) AFTER WELDING ALL ROUND, THE SLOTS SHALL BE DRESSED TO HAVE A SMOOTH SURFACE IN LINE WITH THE TOP SURFACE OF THE TOP PLATE.

FOR SITE:

1. DURING ERECTION:  
 a. THE SPRING HANGERS SHALL BE ERECTED SUCH THAT THE BEARING PLATE ASSY (ITEM NO.09) RESTS PERFECTLY ON TOP OF SUPPORTING STRUCTURE. AT THIS CONDITION THE BEARING PLATE ASSY IS TO BE WELDED TO THE SUPPORTING STRUCTURE.  
 2. BEFORE HYDRAULIC TEST:  
 a. ALL TYPES OF SPRING HANGERS SHALL BE CHECKED FOR LOCKED CONDITION AT THE COLD SET LOAD ALREADY DONE AT SHOPS.  
 3. AFTER HYDRAULIC TEST:  
 a. ALL HANGERS SHALL BE UNLOCKED BY LOOSENING ITEM NOS.06 & 07 AS PER THE FOLLOWING STEPS:  
 i) REMOVE NUT (ITEM NO.22 - AT THE TOP) FROM THE TOP TIE ROD (ITEM NO.04).  
 ii) LOOSEN HYD. LOCK NUT (ITEM NO.07) AND THEN CENTERING NUT (ITEM NO.06).  
 iii) REMOVE HYD. LOCK NUT AND CENTERING NUT (ITEM NO.07 & 06) FROM THE TOP TIE ROD (ITEM NO.04).  
 iv) THEN ASSEMBLE CENTERING NUT, HYD. LOCK NUT AND NUT (ITEM NO.06, 07 & 22) IN THE SAME SEQUENCE, SUCH THAT THE HYD. LOCK NUT IS HELD BETWEEN CENTERING NUT AND TOP NUT AND THE DISTANCE BETWEEN THE FREE END OF TOP TIE ROD AND TOP OF NUT SHALL BE APPROX. 5 MM.

NOTES FOR SHOPS (CONTD)

ITEM NO. 02 & 03 ARE TO BE WELDED TO ITEM NO. 08 AND THE WELDED AREA SHALL BE WELDED TO ITEM NO. 01. THE FINAL ASSEMBLY CONSISTING OF ITEM NOS. 01, 02 & 03 SHALL BE ELECTRO-GALVANIZED TO A THICKNESS OF 15 µm AND SHALL BE PAINTED WITH YELLOW CHROMATE. SIMILARLY ITEM NO. 05 IS TO BE WELDED TO ITEM NO. 02 AND THIS ASSEMBLY SHALL BE ELECTRO-GALVANIZED TO A DEPTH OF 15 µm AND SHALL BE PAINTED WITH YELLOW CHROMATE.

THE ASSEMBLED VARIABLE SPRING HANGER SHALL BE PAINTED WITH EPOXY ZINC DUST PRIMER WITH AN OVERCOAT OF ENAMEL PAINT. DUE CARE SHALL BE TAKEN TO PROTECT INITIALLY THE GALVANIZED CHROMITIZED COMPONENTS WHILE PAINTING.  
 8. PAINTING SCHEME SHALL BE AS PER APPLICABLE QUALITY PLAN.

ITEM NO.	DESCRIPTION	STANDARD	QTY
22	NUT	STANDARD	2
21	COUPLING	3-80-999-99188	1
20	SPHERICAL WASHER	3-80-999-99187	1
19	HAMMER DRIVEN SCREW	STANDARD	8
18	BOTTOM TIE ROD	3-80-999-99186	1
17	SPLIT PIN	STANDARD	3
16	NUT	3-80-999-99152	1
15	TURN BUCKLE	2-80-999-99140	1
14	INNER PIPE GUIDE	3-80-999-99154	1
13	NAME PLATE	3-80-999-99118	1
12	TRAVEL SCALE	3-80-999-99117	2
11	SPRING	2-80-999-99117	1
10	POINTER	4-80-999-99047	2
09	BEARING PLATE ASSY	3-80-999-99189	1
08	SPRING PLATE	3-80-999-99182	1
07	HYD. LOCK NUT	3-80-999-99153	1
06	CENTERING NUT	2-80-999-99131	1
05	BOTTOM SOCKET	2-80-999-99136	1
04	TOP TIE ROD	3-80-999-99181	1
03	TOP PLATE	3-80-999-99180	1
02	BOTTOM PLATE	3-80-999-99179	1
01	HOUSING	3-80-999-99175	1
00	DESCRIPTION	DRAWING NO.	QTY

REV DATE ALT. BY: 05/22/05 APPD: M.M. MANI  
 GENERAL NOTE NO. 2 DELETED.  
 NOTE NO. 5 (FOR SHOPS) DELETED.  
 NOTE NO. 8 (FOR SHOPS) CHANGED.  
 WELD LENGTH ALTERED FOR WELDING ITEM NO. 02 & 14 AND INCLUDED IN THE TABLE.


REV DATE ALT. BY: 03/19/04 APPD: M.M. MANI  
 GENERAL NOTE NO. 2 DELETED.  
 NOTE NO. 5 (FOR SHOPS) DELETED.  
 NOTE NO. 8 (FOR SHOPS) CHANGED.  
 WELD LENGTH ALTERED FOR WELDING ITEM NO. 02 & 14 AND INCLUDED IN THE TABLE.

REV DATE ALT. BY: 01/27/03 APPD: M.M. MANI  
 GENERAL NOTE NO. 2 DELETED.  
 NOTE NO. 5 (FOR SHOPS) DELETED.  
 NOTE NO. 8 (FOR SHOPS) CHANGED.  
 WELD LENGTH ALTERED FOR WELDING ITEM NO. 02 & 14 AND INCLUDED IN THE TABLE.

TYPE OF PRODUCT OR NAME OF CUSTOMER/PROJECT: STANDARD  
 BHARAT HEAVY ELECTRICALS LTD., PIPING CENTRE, MADRAS  
 PS.VEL. M.M. MANI  
 J. JUDE  
 DATE: 08-08-88  
 300888  
 DRAWING NO.: 1-80-999-99006  
 QTY: 07

CAUTION: THE INFORMATION ON THIS DOCUMENT IS THE PROPERTY OF BHARAT HEAVY ELECTRICALS LTD. IT MUST NOT BE REPRODUCED OR DISCLOSED TO ANY OTHER PARTY WITHOUT THE WRITTEN PERMISSION OF THE COMPANY.

L0066-666-08-1

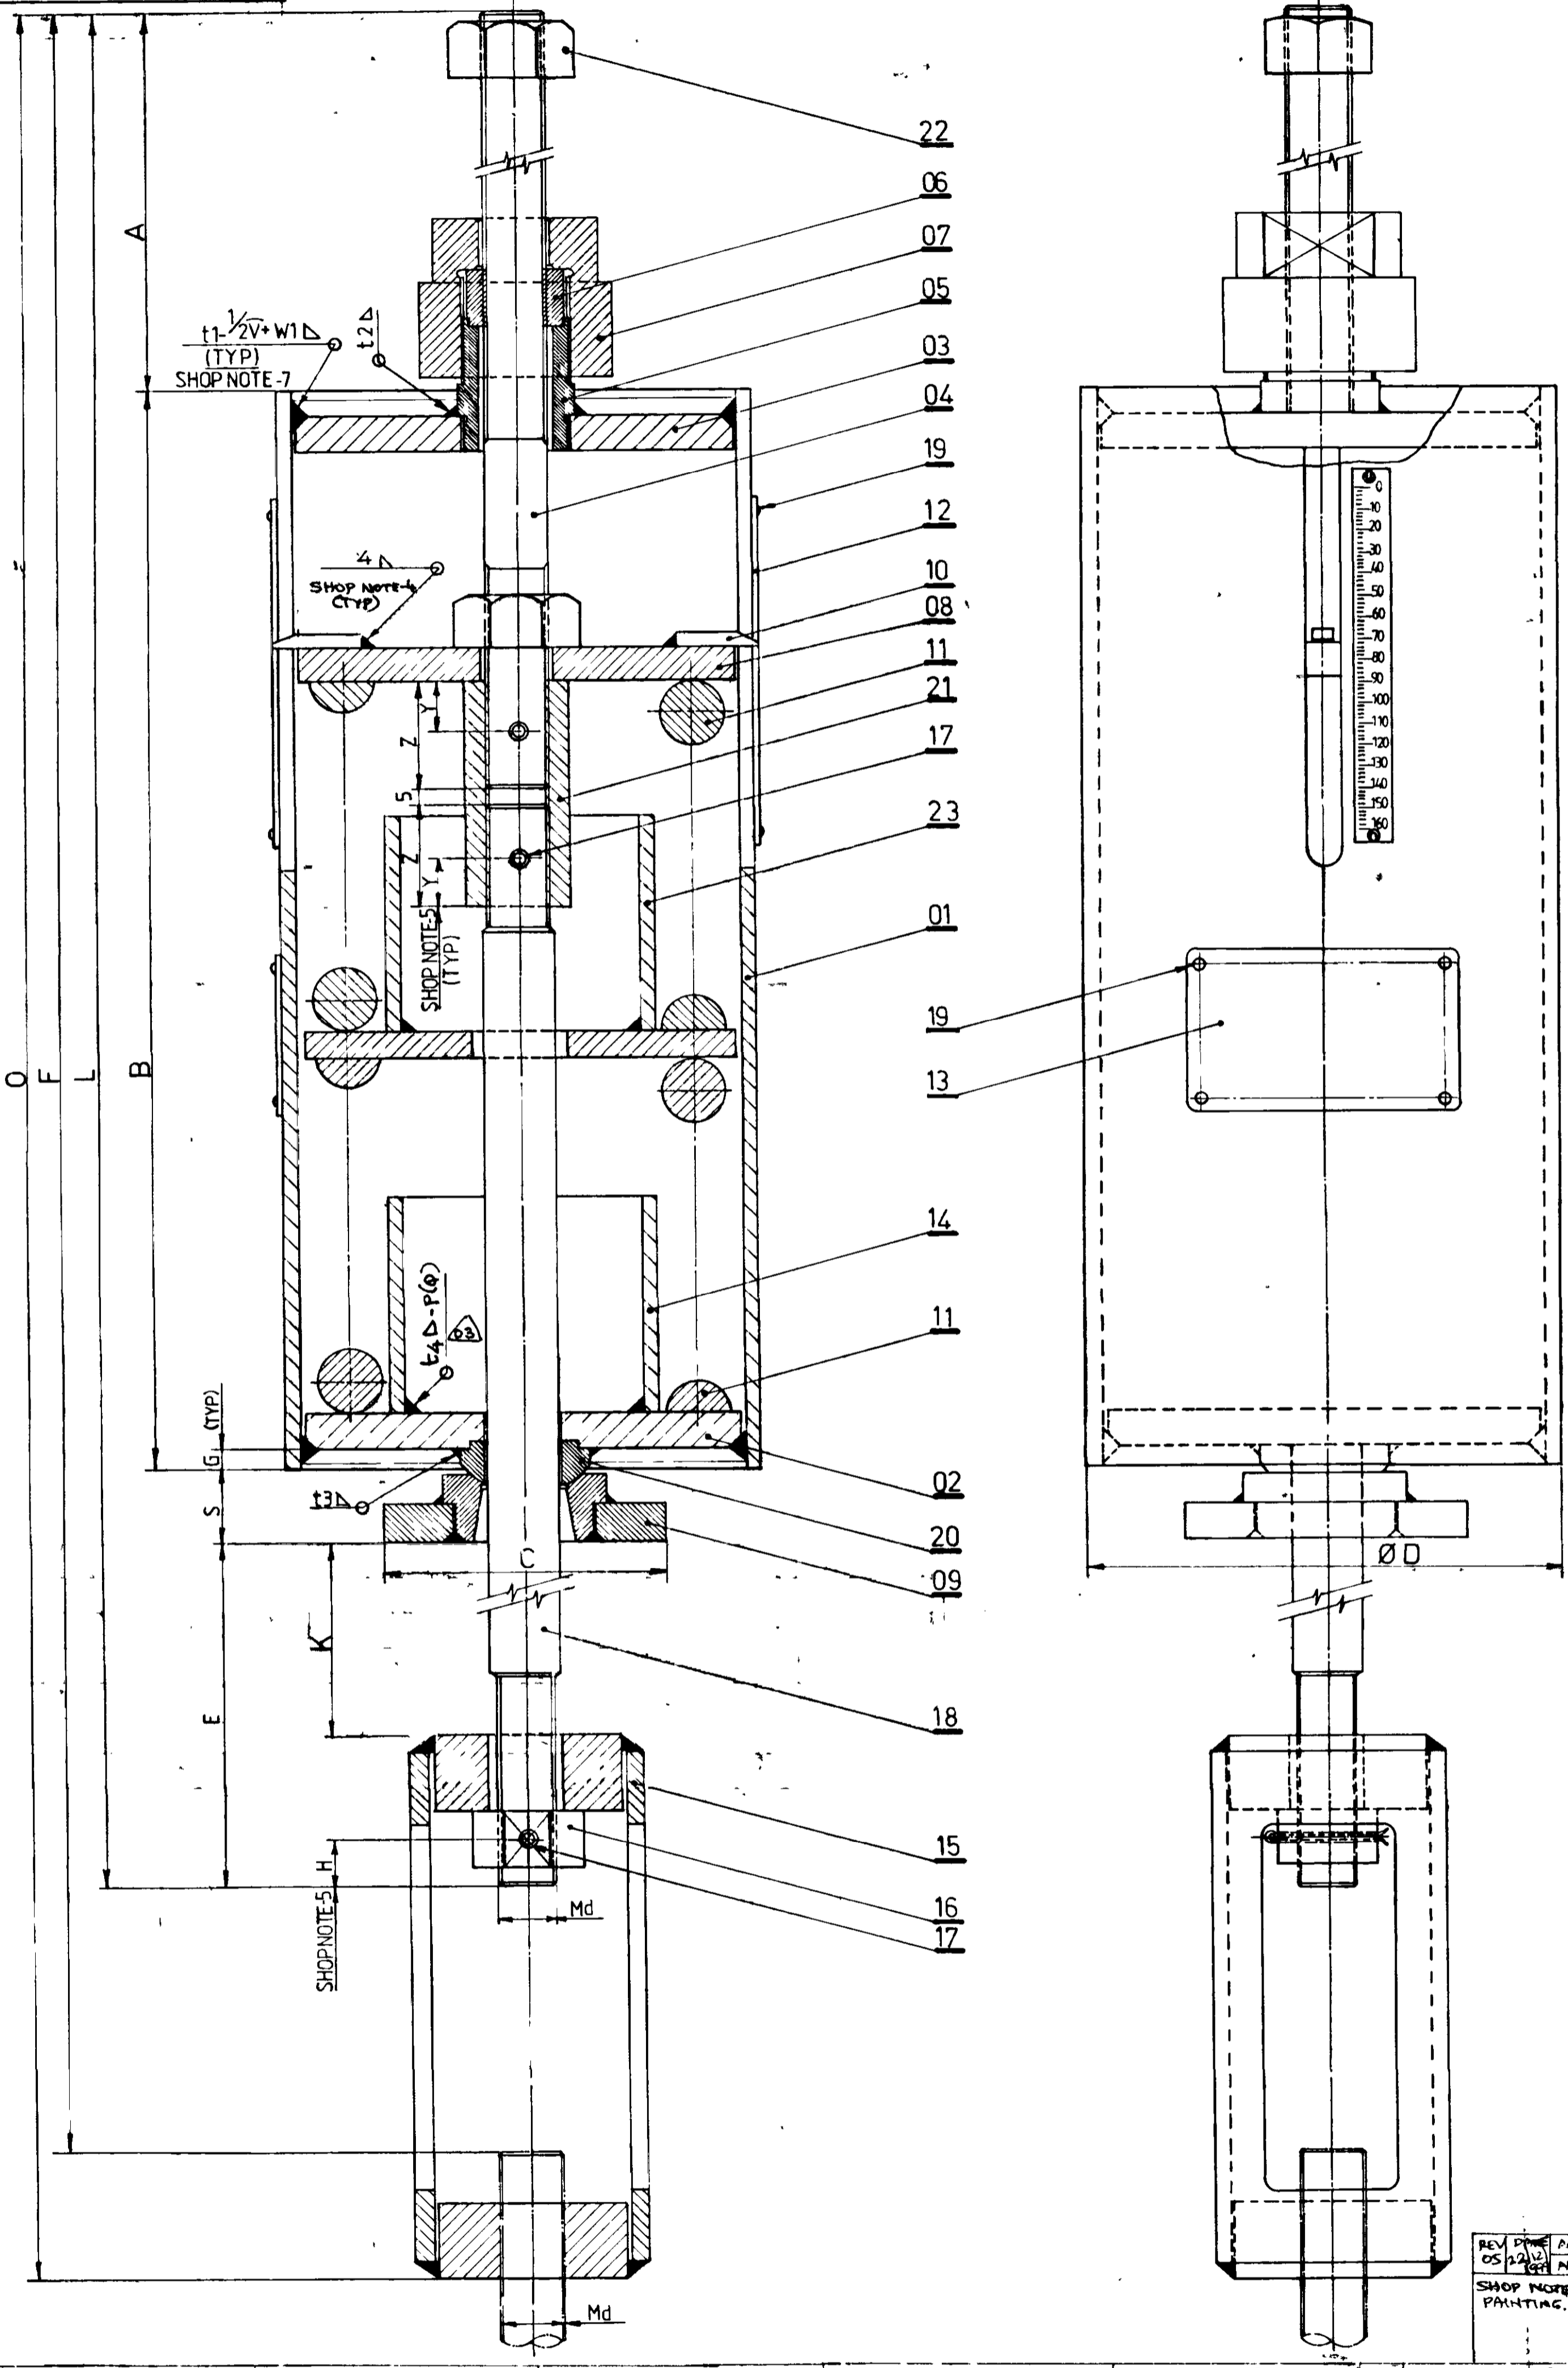

VAR NO.	TYPE	BIN CODE	ØD	B	D	Md	ASSY. Wt (kg)	A	C	E	F	G	H	L	S	Y	Z	K	t1-1/2V+W1D	t2D	t3D	t4D-P(6)	REMARKS
01	SA 1-160	94-821-476-00	113.9	378	908	M12x1.75	8594	252	70	133	837	5	11	787	24	5	10	100	4-1/2V+4D	4D	4D	3D-20(25)	
02	SA 2-160	94-821-477-00	166.5	370	898	M12x1.75	14.159	251	70	133	827	6	11	777	23	5	10	100	4-1/2V+5D	4D	4D	3D-20(40)	
03	SA 3-160	94-821-478-00	113.9	512	1092	M12x1.75	12.270	252	80	183	1021	5	11	971	24	5	10	150	4-1/2V+4D	4D	4D	3D-15(20)	
04	SA 4-160	94-821-479-00	113.9	546	1126	M12x1.75	14.716	252	80	183	1055	5	11	1005	24	5	10	150	4-1/2V+4D	4D	4D	3D-20(25)	
05	SA 5-160	94-821-480-00	166.5	561	1211	M16x2.00	25.862	269	80	246	1174	6	13	1099	23	7	14	200	4-1/2V+5D	5D	4D	3D-20(35)	
06	SA 6-160	94-821-481-00	166.5	557	1206	M16x2.00	27.656	268	80	246	1169	6	13	1094	23	7	14	200	5-1/2V+5D	5D	5D	3D-20(35)	
07	SA 7-160	94-821-482-00	219.1	564	1304	M20x2.50	47.756	286	90	250	1199	7	15	1124	24	9	18	200	6-1/2V+6D	6D	5D	3D-30(50)	
08	SA 8-160	94-821-483-00	166.5	743	1554	M24x3.00	53.381	301	110	304	1449	6	17	1374	25	10	20	250	5-1/2V+5D	6D	5D	3D-25(35)	
09	SA 9-160	94-821-484-00	219.1	863	1670	M24x3.00	94.440	298	110	304	1565	7	17	1430	24	10	20	250	6-1/2V+6D	6D	6D	3D-30(40)	
10	SA10-160	94-821-485-00	219.1	916	1836	M30x3.50	124.459	323	130	371	1720	7	20	1645	35	13	26	300	6-1/2V+6D	7D	6D	3D-30(50)	
11	SA11-160	94-821-486-00	323.9	867	1817	M36x4.00	218.165	349	150	377	1701	9	23	1626	33	16	32	300	8-1/2V+8D	6D	8D	3D-40(80)	
12	SA12-160	94-821-487-00	355.6	964	2016	M48x5.00	360.558	392	200	409	1880	9	29	1805	39	21	42	300	8-1/2V+8D	10D	8D	3D-40(80)	
13	SA13-160	94-821-488-00	406.4	1166	2308	M56x4.00	549.462	424	200	467	2172	11	33	2097	40	25	50	350	10-1/2V+10D	15D	8D	3D-50(80)	

**NOTES :**

- GENERAL :**
- FOR SPRING RATE AND SELECTION CHART REFER DRG. NO. 4-80-999-99068.
  - ALL MATERIALS SHALL BE AS PER SA-160. REFER DRG. NO. 4-80-999-99068.
  - DIMENSIONS INDICATED IN THIS DRAWING ARE BASED ON THE INITIAL PRECOMPRESSION OF 112 MM, FOR ALL TYPES. DIMENSIONS E, F, L, O, K MAY CHANGE IN LINE WITH THE TOLERANCES CHARACTERISTICS OF THE SPRING, IN THE ASSEMBLY.

**FOR SHOPS :**

- TRAVEL SCALE (ITEM NO. 12) SHALL BE FIXED AT A POSITION, SUCH THAT THE POINTER (ITEM NO. 10) READS 80 MM IN THE TRAVEL SCALE AT THE MID LOAD (CORRESPONDING TO LOAD AT 80 MM TRAVEL - GIVEN IN THE DRG. 4-80-999-99068).
- LOCKING :
  - ALL TYPES OF SPRING HANGERS SHALL BE PRECOMRESSED TO THE 'COLD POSITION' INDICATED IN THE CONTRACT DOCUMENTS FOR INDIVIDUAL HANGERS. AT THIS PRECOMPRESSION, HANGERS SHALL BE LOCKED USING ITEM NOS. 06 & 07 PRIOR TO DESPATCH.
- MARKING :
  - FOR ALL TYPES OF SPRING HANGERS, HANGER TAG NO., TYPE NO., OPERATING LOAD AND MOVEMENT SHALL BE PUNCHED IN THE NAME PLATE (ITEM NO. 13), BASED ON THE DETAILS INDICATED IN THE CONTRACT DOCUMENTS.
  - FOR ALL TYPES OF SPRING HANGERS, COLD AND HOT MOVEMENT POSITIONS SHALL BE MARKED ON THE TRAVEL SCALE (ITEM NO. 12) WITH GREEN AND RED PAINTS, RESPECTIVELY.
- POINTERS (ITEM NO. 10) ARE TO BE WELDED TO SPRING PLATE (ITEM NO. 08) SUCH THAT THEY PROTRUDE BY 2 TO 4 MM.
- TOP AND BOTTOM TIE RODS (ITEM NO. 04 & 18) ARE TO BE MATCH DRILLED WITH COUPLING (ITEM NO. 21). ALSO BOTTOM TIE ROD (ITEM NO. 18) IS TO BE MATCH DRILLED WITH NUT (ITEM NO. 16). HOLE SIZES FOR THESE MATCH DRILLING ARE GIVEN BELOW.
 

TYPE	HOLE SIZE
SA1-160 TO SA7-160	DIA 4.5 MM
SA8-160 & SA9-160	DIA 5.5 MM
SA10-160 TO SA13-160	DIA 7.0 MM
- THE SLOTS ON TOP ARE TO BE FREE FROM WELDMETAL (I.E.) AFTER WELDING ALL ROUND. THE SLOTS SHALL BE DRESSED TO HAVE A SMOOTH SURFACE IN LINE WITH THE TOP SURFACE OF THE TOP PLATE.

**FOR SITE :**

- DURING ERECTION :
  - THE SPRING HANGERS SHALL BE ERECTED SUCH THAT THE BEARING PLATE ASSY. (ITEM NO. 09) RESTS PERFECTLY ON TOP OF SUPPORTING STRUCTURE. AT THIS CONDITION THE BEARING PLATE ASSY IS TO BE WELDED TO THE SUPPORTING STRUCTURE.
- BEFORE HYDRAULIC TEST :
  - ALL TYPES OF SPRING HANGERS SHALL BE CHECKED FOR LOCKED CONDITION AT THE COLD SET LOAD ALREADY DONE AT SHOPS.
- AFTER HYDRAULIC TEST :
  - ALL HANGERS SHALL BE UNLOCKED BY LOOSENING ITEM NOS. 06 & 07 AS PER THE FOLLOWING STEPS..
    - REMOVE NUT (ITEM NO. 22 - AT THE TOP) FROM THE TOP TIE ROD (ITEM NO. 04).
    - LOOSEN HYD. LOCK NUT (ITEM NO. 07) AND THEN CENTERING NUT (ITEM NO. 06).
    - REMOVE HYD. LOCK NUT AND CENTERING NUT (ITEM NO. 07 & 06) FROM THE TOP TIE ROD (ITEM NO. 04).
    - THEN ASSEMBLE CENTERING NUT, HYD. LOCK NUT AND NUT (ITEM NO. 06, 07 & 22) IN THE SAME SEQUENCE, SUCH THAT THE HYD. LOCK NUT IS HELD BETWEEN CENTERING NUT AND TOP NUT AND THE DISTANCE BETWEEN THE FREE END OF TOP TIE ROD AND TOP OF NUT SHALL BE APPROX. 5 MM.

**NOTES FOR SHOPS (CONTD.)**

- ITEM NO. 14 & 20 ARE TO BE WELDED TO ITEM NO. 02 AND WELDED ASSY. SHALL BE WELDED TO ITEM NO. 01. THE FINAL HOUSING ASSY. CONSISTING OF ITEM NOS. 01, 02, 14 & 20 SHALL THEN BE ELECTRO GALVANISED TO A DEPTH OF 15 µm AND SHALL BE BLUE WELDED OVERCOATED. REMAINING ITEM NOS. 5 IS TO BE WELDED TO ITEM NO. 04 AND THIS SUB-ASSY. SHALL BE ELECTRO-GALVANISED TO A DEPTH OF 15 µm AND SHALL BE BLUE WELDED OVERCOATED.
- THE ASSEMBLED VARIABLE SPRING HANGER SHALL BE PAINTED WITH EPOXY ZINC RUST PRIMER WITH AN OVERCOAT OF ENAMEL PAINT. DUE CARE SHALL BE TAKEN TO PROTECT SURFACE OF THE GALVANISED COMPONENTS WHILE PAINTING.
- PAINTING SCHEME SHALL BE AS PER APPLICABLE QUALITY PLAN.

ITEM NO	DESCRIPTION	DRAWING NO.	QTY
23	MIDDLE PLATE ASSY	2-80-999-99129	1
22	NUT	STANDARD	2
21	COUPLING	3-80-999-99188	1
20	SPHERICAL WASHER	3-80-999-99187	1
19	HAMMER DRIVEN SCREW	STANDARD	8
18	BOTTOM TIE ROD	3-80-999-99190	1
17	SPLIT PIN	STANDARD	3
16	NUT	3-80-999-99152	1
15	TURN BUCKLE	2-80-999-99140	1
14	INNER PIPE GUIDE	3-80-999-99154	1
13	NAME PLATE	3-80-999-99118	1
12	TRAVEL SCALE	3-80-999-99119	2
11	SPRING	2-80-999-99117	2
10	POINTER	4-80-999-99047	2
09	BEARING PLATE ASSY	3-80-999-99183	1
08	SPRING PLATE	3-80-999-99182	1
07	HYD. LOCK NUT	3-80-999-99153	1
06	CENTERING NUT	2-80-999-99131	1
05	BOTTOM SOCKET	2-80-999-99136	1
04	TOP TIE ROD	3-80-999-99189	1
03	TOP PLATE	3-80-999-99180	1
02	BOTTOM PLATE	3-80-999-99179	1
01	HOUSING	3-80-999-99176	1

REV	DATE	ALTERED BY	CHD.	REV	DATE	ALTERED BY	CHD.
04	24/9/96	CHD: [Signature]		03	19/2/94	APPROVED: [Signature]	

GENERAL NOTE NO. 2 DELETED. NOTE NO. 6 FOR SHOPS DELETED. NOTE NO. 8 FOR SHOPS CHANGED. WELD LENGTH ALTERED FOR WELDING ITEM NO. 02, 14 AND INCLUDED IN THIS TABLE.

TYPE OF PRODUCT OR NAME OF CUSTOMER/PROJECT: **STANDARD**

DEPT: **PSVEL** NAME: **M.M. MANI** DATE: **06.09.88**

CHD: **J. JUDE** APPD: **J. JUDE** DATE: **14.8.88**


SCALE: **1:2** WEIGHT (kg): **12** REF TO ASSY/OLD DRG: **1-80-999-99007**

TITLE: **VARIABLE LOAD HANGERS (Type: SA-160)**

DRAWING NO: **1-80-999-99007**



DRAWING NO: 2-12-000-01853

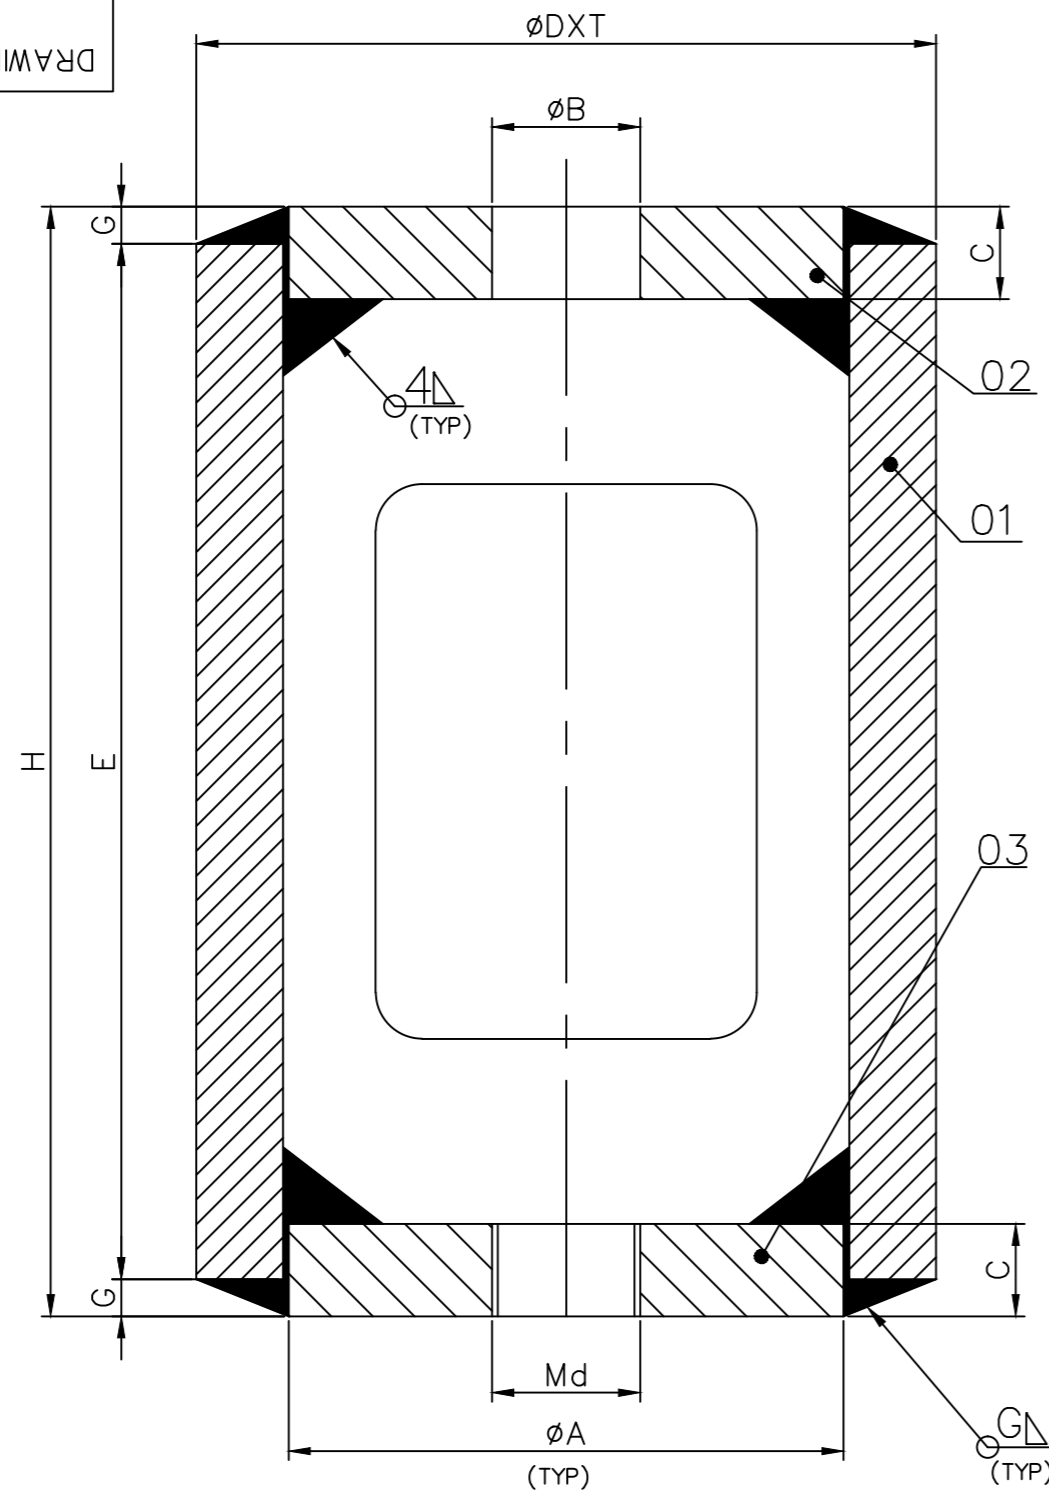

**NOTES:**

01. EACH VARIANT OF THIS ASSEMBLY SHALL CONTAIN CORRESPONDING VARIANT OF THE PARTS.
02. ELECTRODE TO BE USED- E7018.
03. ELECTRO GALVANISING TO A DEPTH OF 15  $\mu$ M TO BE DONE AFTER WELDING OF ITEM No 02&03 TO ITEM No.01. THREADED PART IS TO BE YELLOW CHROMOTISED TO 15  $\mu$ M & THREAD MATCHING SHALL BE DONE AFTERWARDS.
04. 'INSIDE WELDING' SHALL BE DONE CAREFULLY TO AVOID WELD SPATTER ETC, MAINLY ON THE INNER SURFACE OF ITEM No.02, ON WHICH THE NUT HAS TO BE ACCOMODATED, ALSO THE HOLE IN ITEM No.02 AND THE INTERNAL THREAD IN ITEM No.03 SHOULD NOT BE DISTURBED DURING 'INSIDE WELDING'.

VAR NO.	$\phi A$	B	C	MdxP	$\phi D \times T$	E	G	H	WEIGHT (kg)
01 to 04	33	14	16	M14x2	$\phi 44.5 \times 5$	144	5	154	0.745
05 & 06	50	18	25	M27x3	$\phi 63.5 \times 5.6$	146	6	158	1.708
07	50	22	25	M27x3	$\phi 63.5 \times 5.6$	218	6	230	2.009
08 & 09	60	27	25	M27x3	$\phi 76.1 \times 7.1$	222	6	234	1.995
10	76	33	36	M27x3	$\phi 88.9 \times 5.49$	246	8	262	6.494
11	91	40	36	M27x3	$\phi 108 \times 8$	252	8	268	6.433
12	109	52	56	M36x3	$\phi 127 \times 8$	296	12	320	13.160
13	109	60	56	M48x3	$\phi 127 \times 8$	304	12	328	13.033

VARIANT NUMBER	ITEM NUMBER	DESCRIPTION	STD	DRAWING NUMBER	ITEM NO	MATERIAL CODE	A/C/P	UNIT	UNIT WEIGHT	CS
					VAR NO	MATERIAL SPECN		DI	QUANTITY	
	03	PLATE-2		3-12-000-06295					1	
	02	PLATE-1		3-80-999-99150					1	
	01	TURN BUCKLE BODY		2-80-999-99139					1	
13 to 01		TURN BUCKLE		2-12-000-01853					1	
						WELDMENT				

REV	DATE	ALTERED :
01		CHD & APPD:
ZONE		

CAUTION: The information on this document is the property of BHARAT HEAVY ELECTRICALS LTD. It must not be used directly or indirectly in any way detrimental to the interest of the company.


TYPE OF PRODUCT OR NAME OF CUSTOMER/PROJECT			
	Bharat Heavy Electricals Ltd UNIT: HIGH PRESSURE BOILER PLANT TIRUCHIRAPALLI - 620014 355-055		
DEPT	ALL DIMENSIONS ARE IN MM	PROJECTION	SCALE
CODE		N.T.S	WEIGHT (Kg)
TITLE		REF TO ASSY / OLD DWG	
TURN BUCKLE		2-80-999-99140	
DRAWING NO :		REV	
2-12-000-01853		00	

CAUTION THE INFORMATION ON THIS DOCUMENT IS THE PROPERTY OF BHARAT HEAVY ELECTRICALS LTD. IT MUST NOT BE USED DIRECTLY OR INDIRECTLY IN ANY WAY DETRIMENTAL TO THE INTEREST OF THE COMPANY.

4166-666-08-Z

REV DATE 06 4/8/93	ALTERED 08	CHECKED R. ANANTH	REV DATE 07 24/3/94	ALTERED R. SRINIVASAN	CHECKED R. SRINIVASAN
IN NOTES 1, 3, 4 NOT TYPED CHANGES			NOTE NO. 1 DELETED		
IN NOTE 4 'PHOSPHATING' REMOVED			NOTE NO. 13 ADDED		

1.6

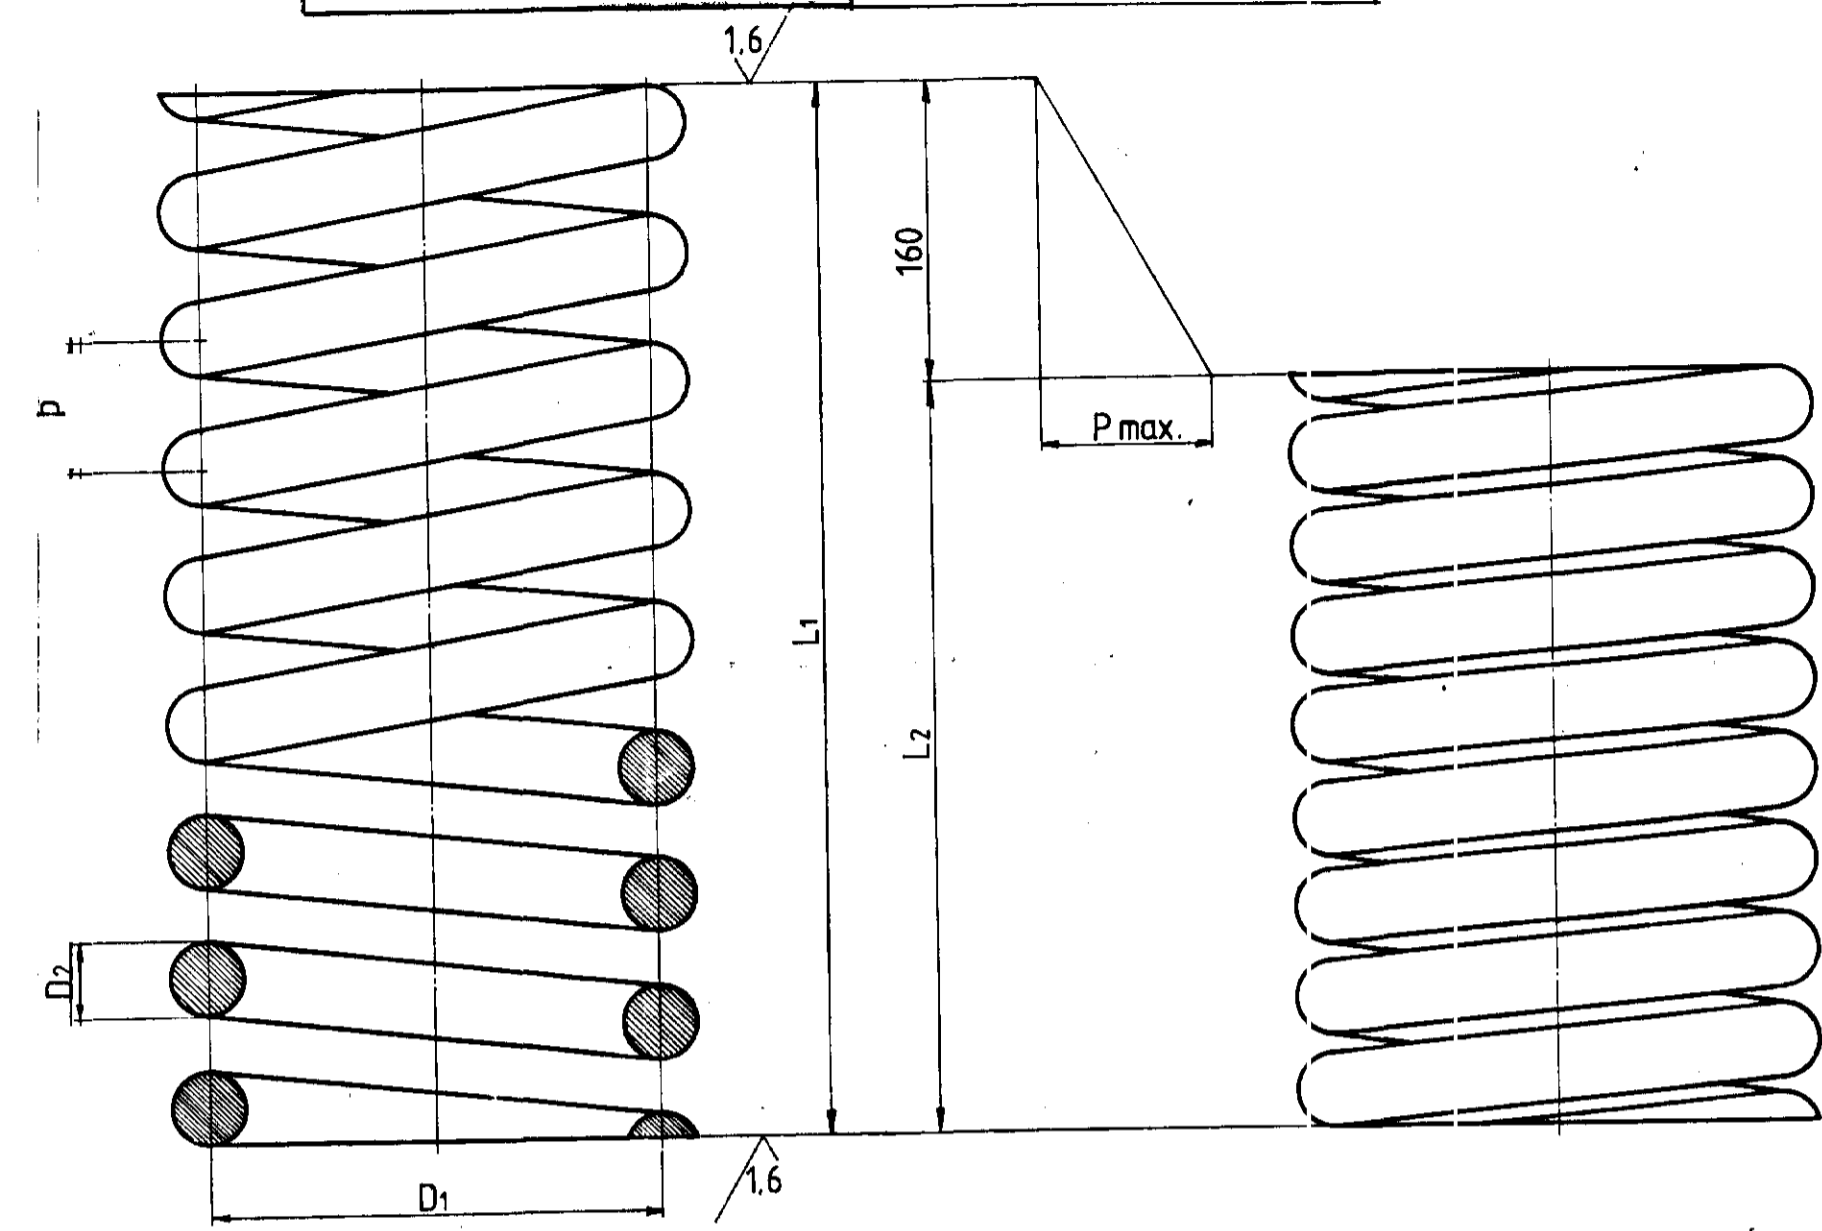

VAR. NO.	TYPE NO.	LOAD P max. (Kg)	D1	D2	p	L1	L <sub>BL</sub>	NO. OF EFFECTIVE COILS	TOTAL NO. OF COILS	DEVELOPED LENGTH OF ROD	WEIGHT (Kg)	RAW MATERIAL LENGTH (NOTE 12)	BIN CODE
01	63 / 160	63	78.0	6	31.54	217	50	6.5	8.5	2100	0.470	2400	
02	100 / 160	100	112.5	8	49.00	212	46	4.0	6.0	2141	0.840	2400	
03	160 / 160	160	70.0	8	23.30	284	108	11.5	13.5	2985	1.180	3300	
04	250 / 160	250	82.0	10	26.67	300	124	10.5	12.5	3237	2.000	3500	
05	400 / 160	400	100.5	12.5	31.11	305	129	9.0	10.5	3332	3.210	3600	
06	630 / 160	630	106.0	14	36.13	299	123	7.5	9.0	3015	3.640	3350	
07	1000 / 160	1000	140.0	18	47.45	297	121	5.5	7.0	3097	6.190	3400	
08	1600 / 160	1600	118.0	20	38.00	382	206	9.0	10.5	3913	9.650	4250	
09	2500 / 160	2500	142.0	25	44.63	435	231	8.0	9.5	4255	16.410	4800	
10	4000 / 160	4000	157.0	30	49.38	455	279	8.0	9.5	4709	26.130	5100	
11	6300 / 160	6300	232.0	40	69.20	426	250	5.0	6.5	4759	46.950	5200	
12	10000 / 160	10000	269.0	50	80.44	462	286	4.5	6.0	5094	78.510	5500	
13	16000 / 160	16000	284.0	60	86.00	550	374	5.0	6.5	5826	129.320	6300	
14	25000 / 160	25000	211.0	63	75.9	885	709	10.0	11.5	7673	187.760	8150	
15	40000 / 160	40000	252.0	80	92.00	1034	858	9.5	11.0	8767	345.940		

**NOTES**

- MATERIAL:-** (a) FOR ROD DIA BELOW 40mm.  
(i) SPRING ROD MATL.: BS: 970 EN 47 i.e. Gr.735 A50 OF BS: 970 PART-5: 1972 OR SAE 6150 OR IS: 1570 Gr. 50 Cr1V23 OR DIN: 50 CrV4.  
(ii) MATL.: BS: 970 EN 48A OR SAE 9254 OR DIN: 67 Si Cr5 OR IS: 3195/75 Gr50 Cr4V2 IS ACCEPTABLE AS SUBSTITUTE FOR SPRING ROD DIA UP TO & INCLUDING 25 MM.  
(b) FOR ROD DIA 40mm AND ABOVE: DIN 51 Cr Mo V4
- MANUFACTURE & WORKMANSHIP:-** SHALL BE IN ACCORDANCE WITH TDE:PC:IND:006 TECHNICAL DELIVERY CONDITION-TDG:14.
- TOLERANCE ON LOADING AND OTHER DIMENSIONS SHALL BE IN ACCORDANCE WITH TDE:PC:IND:006 TECHNICAL DELIVERY CONDITION-TDG:14.
- TOLERANCES ON OTHER DIMENSIONS NOT MENTIONED IN TDE:PC:IND:006 TDG:14 ARE LEFT TO THE CHOICE OF THE MANUFACTURER AND SHALL BE SO DETERMINED THAT THE TOLERANCE ON LOADING ARE ADHERED TO.
- THE SURFACE OF THE SPRINGS SHALL BE SHOT BLASTED AND THEN PHOSPHATED ON TO THE PHOSPHATED SURFACE A COATING OF ZINC DUST PRIMER SHALL BE APPLIED.
- THE TERMINAL COILS SHALL BE CLOSED, GROUND & SQUARED TO THE PLANE PERPENDICULAR TO THE AXIS OF THE SPRING.
- HEAT TREATMENT, METALLURGICAL REQUIREMENTS, END CONSTRUCTIONS, LOAD COMPRESSION CHARACTERISTICS, SCRAGGING TEST, CRAMP TEST, LOAD TEST, SURFACE TREATMENT, PROTECTIVE COATING ETC., SHALL BE IN ACCORDANCE WITH TDE:PC:IND:006 TECHNICAL DELIVERY CONDITION-TDG:14.
- TYPE NO. & BIN CODE SHALL BE PAINTED ON EACH SPRING.
- DIRECTION OF SPRING COILING: RIGHT.
- L<sub>2</sub> = MINIMUM PERMISSIBLE TEST LENGTH OF SPRING = (L<sub>1</sub> - 160) mm.
- L<sub>BL</sub> = SOLID LENGTH OF SPRING (CONDITION OF ADJACENT COILS IN CONTACT).
- RAW MATERIAL LENGTH GIVEN IN THE TABLE IS INDICATIVE ONLY. HOWEVER OPTIMUM LENGTH OF RAW MATERIAL SHALL BE USED.
- DIMENSIONAL TOLERANCES SHALL BE IN LINE WITH DIN 2095 AND 2096

VAR. NO.	ITEM No.	DESCRIPTION	STD	DRAWING No.	ITEM No.	MATL CODE	UNIT	WT	QTY

TYPE OF PRODUCT OR NAME OF CUSTOMER / PROJECT: **STANDARD**

**BHARAT HEAVY ELECTRICALS LTD.**  
PIPING CENTRE, MADRAS

DRN: R.Seshagiri, SIGN: R. Seshagiri, DATE: 24-09-87, No. OF VAR: 15  
CHD: M.Masilamani  
A\*PD: J. Jude

DEPT: PC, GRADE OF UN TOL. DIM: C/M/F, SCALE: NTS, WEIGHT (Kg): AS PER TABLE, REF TO ASSY/ OLD DRG: [ ]

REV 01: 01-01-88, ALTERED: R.S. Giri / R. Seshagiri, CHECKED: M.M. Mani  
REV 02: 18-04-88, ALTERED: R. SRINIVASAN, CHECKED: [ ]  
REV 05: 04-05-89, ALTERED: R. SRINIVASAN, CHECKED: R. ANANTH  
REV 03: 09-05-88, ALTERED: R. SRINIVASAN, CHECKED: [ ]

TITLE: **SPRINGS FOR PIPE HANGERS (DEFLECTION 160 MM)**

CARD CODE: U 01, DRAWING No: 2-80-999-99117, REV: 07


REV 05: 04-05-89, ALTERED: R. SRINIVASAN, CHECKED: R. ANANTH	REV 04: 11-6-88, ALTERED: R. SRINIVASAN, CHECKED: [ ]	REV 03: 09-05-88, ALTERED: R. SRINIVASAN, CHECKED: [ ]	REV 02: 18-04-88, ALTERED: R. SRINIVASAN, CHECKED: [ ]	REV 01: 01-01-88, ALTERED: R.S. Giri / R. Seshagiri, CHECKED: M.M. Mani
NOTE 01 & 02 REVISED. NOTE 12 ADDED. RAW MATERIAL LENGTH ADDED IN TABLE. 'L' FOR VAR NO. 09 (2500/160) REVISED FROM 2500 TO 2520. 4-80-999-99037 IS REPLACED BY TDE:PC:IND:006.	ZONE NOTE NO. 01 ALTERED.	DIMENSIONS ALTERED FOR VARIANT NO. 05.	DIMENSIONS ALTERED FOR VARIANT NO. 08.	DIMENSIONS IN TABLE ALTERED FOR VARIANT NOS. 03, 06, 07, 12, 13 & 14. NOTE NO. 10 & 11 ADDED. ALL REVISIONS MARKED AS [ ]



05-228/C

0E166-666-08-Z

DRAWING No.

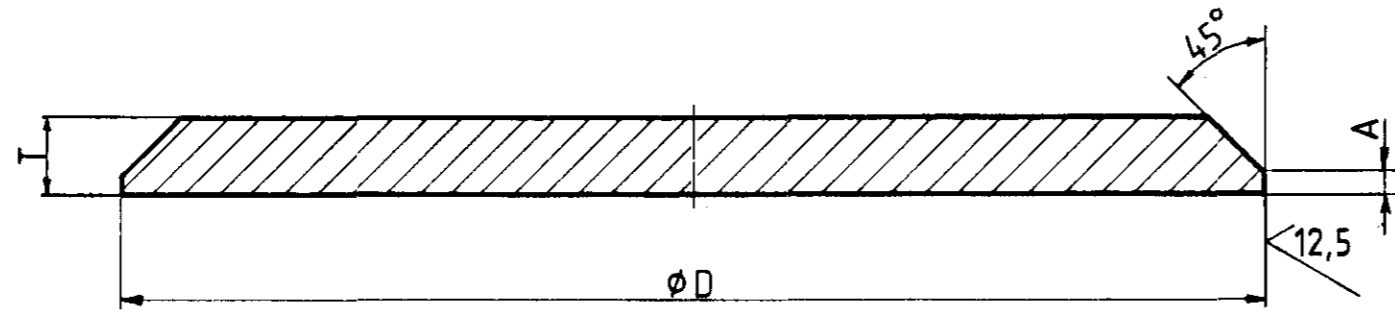

NOTES:

- 03 ~~01 EQUIVALENT MATL IS 226, IS 2062~~
- 02 ~~THIS COMPONENT SHALL BE ELECTRO GALVANISED TO A DEPTH OF 15µM ON ONE SIDE ON WHICH LUG PLATE (DRG NO. 2-80-999-99138) IS WELDED, PRIOR TO GALVANISING.~~

CAUTION THE INFORMATION ON THIS DOCUMENT IS THE PROPERTY OF BHARAT HEAVY ELECTRICALS LTD. IT MUST NOT BE USED DIRECTLY OR INDIRECTLY IN ANY WAY DETRIMENTAL TO THE INTEREST OF THE COMPANY

VAR. NO	ØD	T	A	REMARKS
01	105	5	1	
02	155	5	1	
03	105	5	1	
04	105	5	1	
05	155	5	1	
06	155	8	3	
07	204	8	2	
08	155	10	5	
09	204	12	6	
10	204	16	10	
11	306	16	8	
12	338	20	12	
13	385	25	15	
14	306	32	24	
15	338	36	28	

VARIANT No.	ITEM No.	DESCRIPTION	STD	DRAWING No.	ITEM No.	MATL CODE	A	UNIT	UNIT WT	QTY	ZONE
15		PLATE Ø338 T=36		2-80-999-99130		15-011-124	C		25,357		
						IS 2062 Fe 410WB					
14		PLATE Ø306 T=32				15-011-130	C		18,474		
						IS 2062 Fe 410WB					
13		PLATE Ø385 T=25				15-011-081	C		22,847		
						IS 2062 Fe 410WB					
12		PLATE Ø338 T=20				15-011-150	C		14,087		
						IS 2062 Fe 410WA					
11		PLATE Ø306 T=16				15-011-026	C		9,237		
						IS 2062 Fe 410WA					
10		PLATE Ø204 T=16				15-011-026	C		4,105		
						IS 2062 Fe 410WA					
09		PLATE Ø204 T=12				15-011-132	C		3,079		
						IS 2062 Fe 410WA					
08		PLATE Ø155 T=10				15-011-098	C		1,481		
						IS 2062 Fe 410WA					
07		PLATE Ø204 T=8				15-011-027	C		2,053		
						IS 2062 Fe 410WA					
06		PLATE Ø155 T=8				15-011-027	C		1,185		
						IS 2062 Fe 410WA					
05		PLATE Ø155 T=5				15-011-029	C		0,741		
						IS 2062 Fe 410WA					
04		PLATE Ø105 T=5				15-011-029	C		0,340		
						IS 2062 Fe 410WA					
03		PLATE Ø105 T=5				15-011-029	C		0,340		
						IS 2062 Fe 410WA					
02		PLATE Ø155 T=5				15-011-029	C		0,741		
						IS 2062 Fe 410WA					
01		PLATE Ø105 T=5				15-011-029	C		0,340		
						IS 2062 Fe 410WA					

TYPE OF PRODUCT OR NAME OF CUSTOMER / PROJECT: **STANDARD**

	BHARAT HEAVY ELECTRICALS LTD.,		DRN	R.Seshagiri	SIGN	R.Seshagiri	DATE	11-02-88	No. OF
	PIPING CENTRE, MADRAS		CHD	M.Masilamani	SIGN	M.Masilamani	DATE	18/6/88	VAR
			APPD	J.Jude	SIGN	J.Jude	DATE	21/06/88	15

DEPT.	PC	GRADE OF UN TOL. DIM	C/M/F	SCALE	NTS	WEIGHT (KG.)	AS PER BOM	REF TO ASSY/ DRG	1-80-999-99002 & 1-80-999-99003.	ITEM No.	02	
TITLE	TOP PLATE						CARD CODE	U 01	DRAWING No.	2-80-999-99130	REV	03



REV DATE	03/04/01	ALTD:	R.Seshagiri	REV DATE	02/18/2/94	ALTD:	R.Seshagiri	REV	01	DATE	23/08/88	ALTERED	Checked
MATERIAL CHANGED IN BOM FROM BMC20 & BMC16 TO IS 2062 Fe 410WA & IS 2062 Fe 410WB RESPECTIVELY. NOTE 01 DELETED.				NOTE: 02 DELETED.				END CHAMFERING DETAILS ADDED.					

1E166 - 666 - 08 - Z

DRAWING No.

12.5 / 6.3

CAUTION: THE INFORMATION ON THIS DOCUMENT IS THE PROPERTY OF BHARAT HEAVY ELECTRICALS LTD. IT MUST NOT BE USED DIRECTLY OR INDIRECTLY IN ANY WAY DETRIMENTAL TO THE INTEREST OF THE COMPANY.

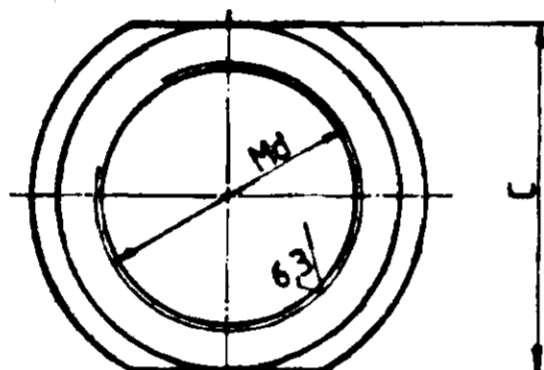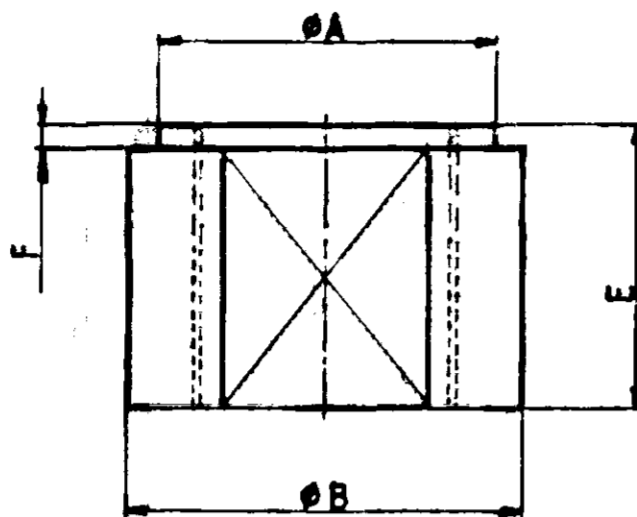

VAR. NO.	ØA	ØB	C	Md	E	F	REMARKS
01 TO 04	17	20	17	M12x1.75	10	2	
05 & 06	22	25	22	M16x2.0	14	2	
07	27	32	27	M20x2.5	18	2	
08 & 09	30	36	30	M24x3.0	20	2	
10	39	45	39	M30x3.5	26	3	
11	46	54	46	M36x4.0	32	3	
12	60	70	60	M48x5.0	42	3	
13	65	84	65	M56x4.0	50	3	
14	75	100	75	M68x4.0	63	3	
15	95	120	95	M85x4.0	80	3	

NOTES:

- MATL. EQUIVALENT: IS-1875 CL3, (OR) IS-961 Fe 540 WHT (OR) BS 970 080 M40
- THIS COMPONENT SHALL BE ELECTRO GALVANISED TO A DEPTH OF 15µM AND THREADED PORTIONS SHALL BE YELLOW CHROMATISED.
- THREAD MATCHING SHALL BE DONE AFTER GALVANISING.
- IS-1875CL2 IS ALSO ACCEPTABLE IN PLACE OF "SA105"

VARIANT No.	ITEM No.	DESCRIPTION	DWG No.	ITEM No.	MATL CODE	UNIT	WT	QTY	ZONE
	15	ROUND Ø125 L-80	2-80-999-99131	15-339-281 SA-105	C		3.090		
	14	ROUND Ø125 L-63		15-339-281 SA-105	C		1.760		
	13	ROUND Ø100 L-50		15-339-134 SA-105	C		1.040		
	12	ROUND Ø80 L-42		15-339-144 SA-105	C		0.620		
	11	ROUND Ø63 L-32		15-339-143-65 SA-105	C		0.290		
	10	ROUND Ø50 L-26		15-339-142 SA-105	C		0.170		
	09	ROUND Ø40 L-20		15-339-141 SA-105	C		0.080		
	08	ROUND Ø36 L-18		15-339-280 SA-105	C		0.060		
	07	ROUND Ø32 L-14		15-339-140 SA-105	C		0.030		
	06	ROUND Ø25 L-10		15-339-139 SA-105	C		0.010		

TYPE OF PRODUCT OR NAME OF CUSTOMER / PROJECT: **STANDARD**

**BHARAT HEAVY ELECTRICALS LTD.**  
PIPING CENTRE, MADRAS

DRN	R.Seshagiri	DATE	16-02-88
CHD	M.Mastamani	DATE	04/6/88
APPD	J. Jude	DATE	21/06/88

DEPT: PC GRADE OF UN TOL DIM: C/M/F SCALE: NTS WEIGHT (KG): AS PER BOM REF TO ASSY/ OLD DRG: 1.80-999-99002 & 1.80-999-99003. ITEM No: 06

TITLE: **CENTERING NUT** CARD CODE: U 01 DRAWING No: 2-80-999-99131 REV: 03

REV	DATE	ALTD: OF	REV	DATE	ALTERED	REV	DATE	ALTERED
03	01/03/88	APPD: J	02	01/04/88	CHECKED	01	06.07.88	CHECKED


NOTE: 04 ADDED.

In Note No: 01 MATL. BS 970 ENB changed to BS 970 080 M40.

FOR VAR. Nos. 13 & 15, DIMENSION 'A' ALTERED FROM 63 TO 65 AND 93 TO 95 RESPECTIVELY. IN NOTE 01, MATL BS 970 ENB ADDED.

FIRST ANGLE PROJECTION (ALL DIMENSIONS IN MILLIMETRES)

05-228/C  
EEL66-666-08-Z  
DRAWING No.

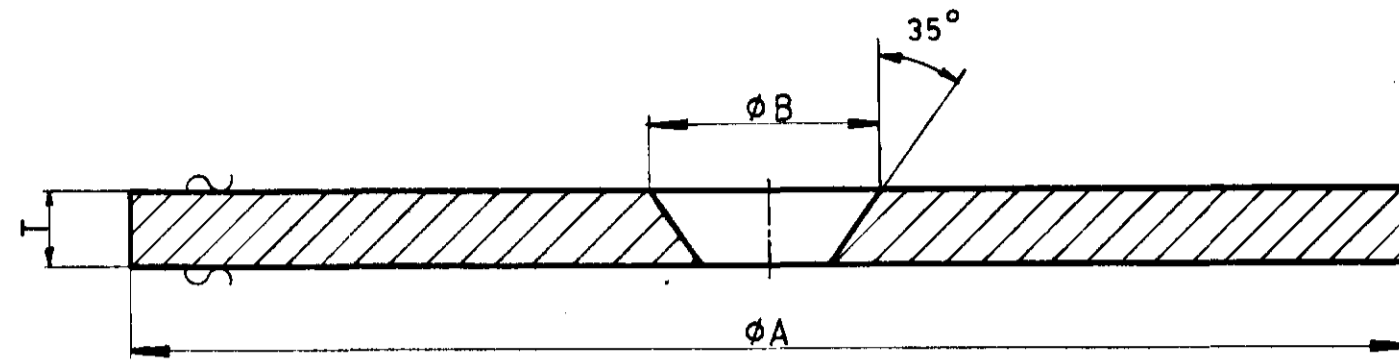

VAR. NO.	φA	φB	T	REMARKS
01	100	190	5	
02	150	190	5	
03	100	190	5	
04	100	20.4	6	
05	150	24.4	6	
06	150	27.2	8	
07	200	34.0	10	
08	150	40.8	12	
09	200	46.4	16	
10	200	52.4	16	
11	300	58.4	16	
12	330	76.0	20	
13	380	91.0	25	
14	290	110.0	32	
15	336	135.4	36	


VARIANT No.	ITEM No.	DESCRIPTION	STD	DRAWING No.	ITEM No.	MATL CODE	A	UNIT	UNIT WT	CS	ZONE
VAR. No.					VAR. No.	MATL SPEC.	C		QTY		
	15	PLATE φ336 T-36		2-80-999-99133		15-011-124	C		17 362		
						IS:2062 Fe 410B					
	14	PLATE φ290 T-32				15-011-130	C		15 030		
						IS:2062 Fe 410B					
	13	PLATE φ380 T-25				15-011-081	C		21 424		
						IS:2062 Fe 410B					
	12	PLATE φ330 T-20				15-011-150	C		12 954		
						IS:2062 Fe 410A					
	11	PLATE φ300 T-16				15-011-026	C		8 658		
						IS:2062 Fe 410A					
	10	PLATE φ200 T-16				15-011-026	C		3 778		
						IS:2062 Fe 410A					
	09	PLATE φ200 T-16				15-011-026	C		3 824		
						IS:2062 Fe 410A					
	08	PLATE φ150 T-12				15-011-132	C		1 309		
						IS:2062 Fe 410A					
	07	PLATE φ200 T-10				15-011-098	C		2 421		
						IS:2062 Fe 410A					
	06	PLATE φ150 T-8				15-011-027	C		1 086		
						IS:2062 Fe 410A					
	05	PLATE φ150 T-6				15-011-092	C		0 817		
						IS:2062 Fe 410A					
	04	PLATE φ100 T-6				15-011-092	C		0 360		
						IS:2062 Fe 410A					
	03	PLATE φ100 T-5				15-011-029	C		0 301		
						IS:2062 Fe 410A					
	02	PLATE φ150 T-5				15-011-029	C		0 687		
						IS:2062 Fe 410A					
	01	PLATE φ100 T-5				15-011-029	C		0 301		
						IS:2062 Fe 410A					

TYPE OF PRODUCT OR NAME OF CUSTOMER / PROJECT		STANDARD						
	BHARAT HEAVY ELECTRICALS LTD.,		DRN	R.Seshagiri	DATE	23-02-88	No. OF VAR	
	PIPING CENTRE, MADRAS		CHD	M.Masilamani	DATE	15/4/88	15	
			APPD	J.Jude	DATE	21/06/88		
REV	DATE	ALTERED	DEPT.	GRADE OF UN TOL. DIM	SCALE	WEIGHT (KG)	REF TO ASSY/ OLD DRG	ITEM No.
01	22/10/96	CHECKED	PC	C/M/F	NTS	AS PER BOM		08
A Dimensions & Weight Changed. Matl. Spec. changed to IS:			TITLE		CARD CODE		DRAWING No.	REV
			SPRING PLATE		U 01		2-80-999-99133	01

FIRST ANGLE PROJECTION (ALL DIMENSIONS IN MILLIMETRES)

2-80-999-99135

2-80-999-99135

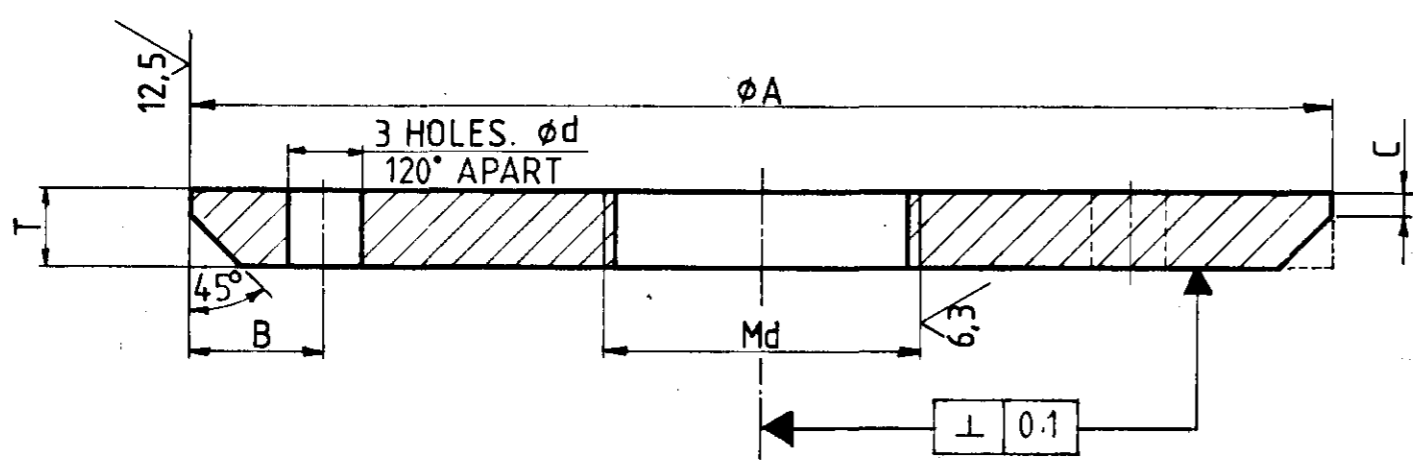

12.5/63

NOTES:

- 01 EQUIVALENT MATL IS 226, IS 2062
- 02 THIS COMPONENT SHALL BE ELECTRO-GALVANISED TO DEPTH OF 15 UM ON SURFACE MARKED AND THREADED PORTIONS SHALL BE YELLOW CHROMATISED.
- 03 THREAD MATCHING SHALL BE DONE AFTER GALVANISING.
- 04 FOR VAR. NO. 11 TO 15, THE DIMN. 'A' INDICATED, IS SUITABLE FOR HAVING PIPE THICKNESS OF 6.35mm. FOR THICKNESS HIGHER THAN 6.35 mm, THE O.D. OF THE BOTTOM PLATE IS TO BE SUITABLY MACHINED TO HAVE THE DIMN. 'A', TO BE APPROX. 2mm. LESS THAN THE I.D. OF THE HOUSING.

VAR.NO.	φA	Md	C	T	B	φd
01	105	M24X1.5	1	5	8.0	5
02	155	M24X1.5	1	5	11.0	5
03	105	M24X1.5	1	5	8.0	5
04	105	M24X1.5	1	5	8.0	5
05	155	M30X1.5	1	5	11.0	5
06	155	M30X1.5	1	6	11.0	6
07	204	M36X1.5	2	8	12.0	6
08	155	M42X1.5	5	10	31.0	8
09	204	M42X1.5	6	12	15.0	8
10	204	M50X1.5	10	16	38.0	10
11	306 <del>309</del>	M58X1.5	8	16	14.0	10
12	338 <del>392</del>	M75X2	12	20	62.0	12
13	385 <del>392</del>	M90X2.0	10	20	18.0	12
14	309	M105X2.0	24	32		12
15	338	M125X2.0	24	32		12

VAR. No.	ITEM No.	DESCRIPTION	STD	DRAWING No.	ITEM No.	MATL CODE	A	UNIT	UNIT WT	ZONE
15		PLATE φ338 T-32		2-80-999-99135		15-011-130	C		19 0.92	
						IS2062 Fe410WB				
14		PLATE φ309 T-32				15-011-130	C		16 3.28	
						IS2062 Fe410WB				
13		PLATE φ385 <del>392</del> T-20				15-011-150	C		17 7.74	
						IS2062 Fe410WA				
12		PLATE φ338 T-20				15-011-150	C		13 2.42	
						IS2062 Fe410WA				
11		PLATE φ306 <del>309</del> T-16				15-011-026	C		9 0.13	
						IS2062 Fe410WA				
10		PLATE φ204 T-16				15-011-026	C		3,,8,0,8	
						IS2062 Fe410WA				
09		PLATE φ204 T-12				15-011-132	C		2,,9,1,4	
						IS2062 Fe410WA				
08		PLATE φ155 T-10				15-011-098	C		1,,3,5,6	
						IS2062 Fe410WA				
07		PLATE φ204 T-8				15-011-027	C		1,,9,6,9	
						IS2062 Fe410WA				
06		PLATE φ155 T-6				15-011-092	C		0,,8,5,8	
						IS2062 Fe410WA				
05		PLATE φ155 T-5				15-011-029	C		0,,7,1,1	
						IS2062 Fe410WA				
04		PLATE φ105 T-5				15-011-029	C		0,,3,1,7	
						IS2062 Fe410WA				
03		PLATE φ105 T-5				15-011-029	C		0,,3,1,7	
						IS2062 Fe410WA				
02		PLATE φ155 T-5				15-011-029	C		0,,7,1,5	
						IS2062 Fe410WA				
01		PLATE φ105 T-5				15-011-029	C		0,,3,1,7	
						IS2062 Fe410WA				

REV	DATE	ALTD:	APPD:	REV	DATE	ALTD:	APPD:	REV	DATE	ALTD:	APPD:	REV	DATE	ALTD:	APPD:
07	04/01/2000	06		05	11/16/98	03		04	18/2/94	01		02	23/08/88		

MATERIAL CHANGED IN BOM FROM BMC20 & BMC16 TO IS 2062 Fe410WA & IS 2062 Fe410WB RESPECTIVELY. NOTE-01 DELETED.  
 FOR VAR. NO. 11 & 13 DIMENSION φA ALTERED AS SHOWN WITH 06.  
 NOTE 02 DELETED.  
 NOTES 03 & 04 DELETED.  
 REV. DATE 04/7/1994 ALTD: 06 APPD: 06  
 THREAD SIZE ALTD FROM M12X1.5 TO M12X2.0 FOR VAR. 15.

TYPE OF PRODUCT OR NAME OF CUSTOMER / PROJECT: STANDARD

BHARAT HEAVY ELECTRICALS LTD., PIPING CENTRE, MADRAS

DRN: R.Seshagiri, SIGN: R. Seshagiri, DATE: 24-02-88, No. OF VAR: 15

CHD: M.Masilamani, DATE: 18-6-88

APPD: J.Jude, DATE: 21-06-88

DEPT: PC, GRADE OF UN TOL. DIM: C/M/F, SCALE: NTS, WEIGHT (Kg): AS PER BOM, REF TO ASSY/DET DRG: 1-80-999-99002 & 1-80-999-99003, ITEM No.: 03

TITLE: BOTTOM PLATE, CARD CODE: U 01, DRAWING No.: 2-80-999-99135, REV: 03


05-228/C

FIRST ANGLE PROJECTION (ALL DIMENSIONS IN MILLIMETRES)

8E166-666-08-7

DRAWING No.

CAUTION - THE INFORMATION ON THIS DOCUMENT IS THE PROPERTY OF BHARAT HEAVY ELECTRICALS LTD. IT MUST NOT BE USED DIRECTLY OR INDIRECTLY IN ANY WAY DETRIMENTAL TO THE INTEREST OF THE COMPANY

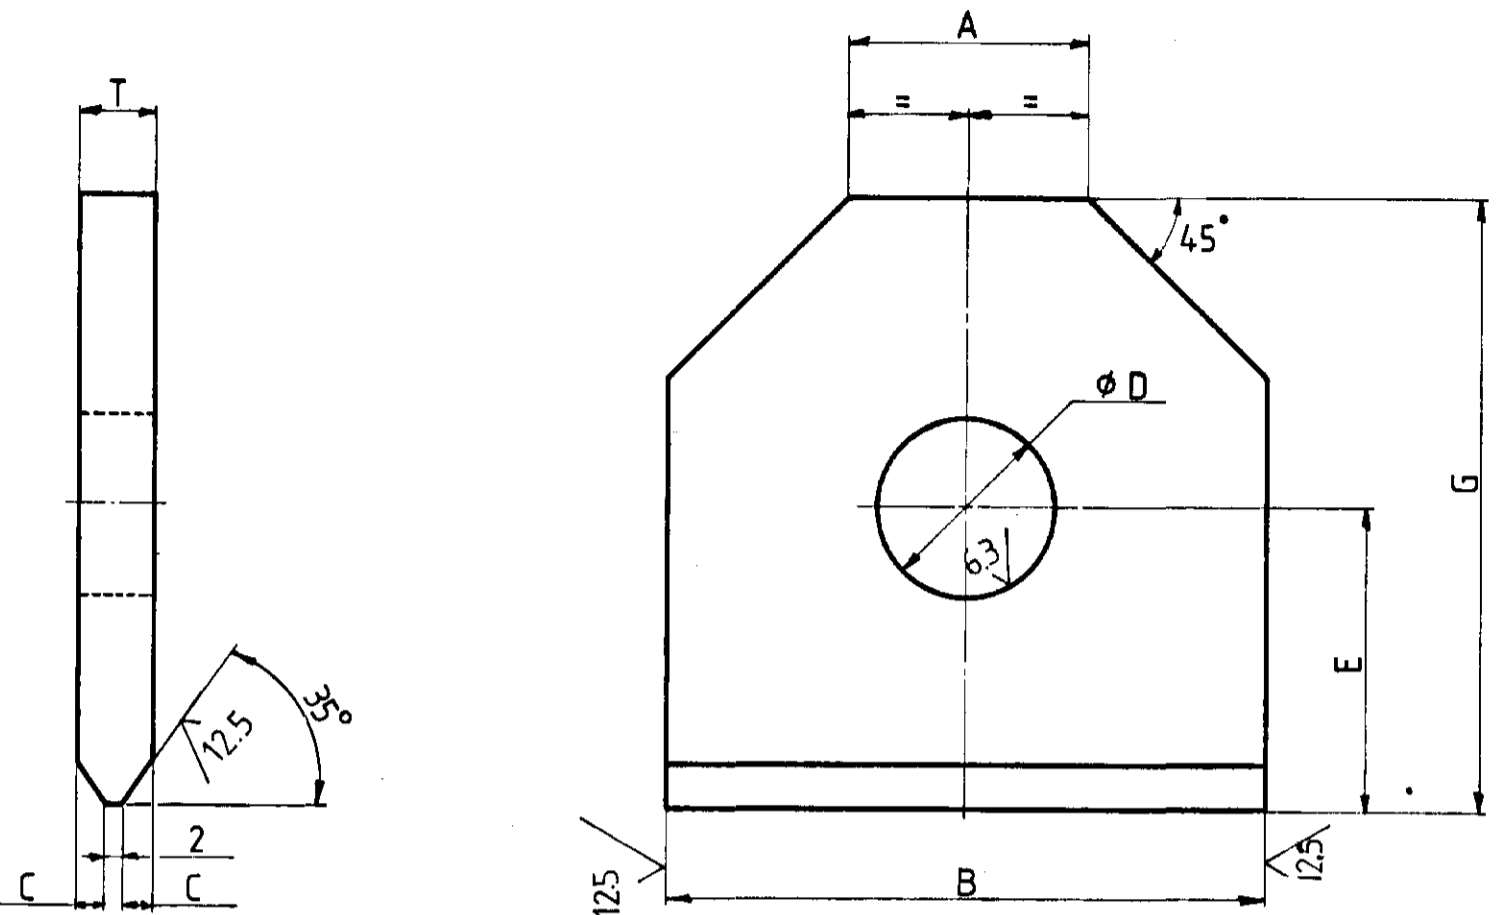

NOTES:  
 04 ~~IS 2062 Gr A - Fe 410 WA FOR BMC20 (THICKNESS 2.0 mm) TO~~  
 03 EQUIVALENT MATERIAL IS 2062 Gr B - Fe 410 WB FOR BMC16 (THICKNESS 2.5 mm) ABOVE  
 03 THIS COMPONENT SHALL BE ELECTRO GALVANISED TO A DEPTH OF 15 UM AFTER WELDING WITH TOP PLATE DRG. 2-80-999-99138

VAR. NO.	A	B	C	φD	E	G	T	REMARKS
01 to 04	16	25	1,5	12,5	30	50	5	✓
05 & 06	22	33	2,0	16,5	30	60	6	
07	26	41	3,0	20,5	35	70	8	
08 & 09	50	74	5,0	24,5	40	80	12	
10	68	101	7,0	33,5	50	100	16	
11	82	122	9,0	40,5	60	120	20	
12	102	152	11,5	50,5	77	154	25	
13	122	182	15,0	60,5	90	180	32	
14	90	142	15,0	70,5	107	214	32	
15	108	172	17,0	85,5	132	264	36	

ITEM No.	DESCRIPTION	STD	DRAWING No.	ITEM No.	MATL CODE	A	UNIT	UNIT WT	ZONE
15	PLATE 36 x 172 x 264		2-80-999-99138	15-011-124	BMC-16	E		1019,00	
16	PLATE 32 x 142 x 214			15-011-130	BMC-16	E		644,7	
13	PLATE 32 x 182 x 180		2-80-999-99138	15-011-130	IS 2062 Fe 410WB	C		728,0	
12	PLATE 25 x 152 x 154			15-011-081	IS 2062 Fe 410WB	C		478,0	
11	PLATE 20 x 122 x 120			15-011-150	IS 2062 Fe 410WA	C		210,30	
10	PLATE 16 x 101 x 100			15-011-026	IS 2062 Fe 410WA	C		112,20	
09 & 08	PLATE 12 x 74 x 80			15-011-132	IS 2062 Fe 410WA	C		05,00	
07	PLATE 8 x 41 x 70			15-011-027	IS 2062 Fe 410WA	C		015,6	
06 & 05	PLATE 6 x 33 x 60			15-011-092	IS 2062 Fe 410WA	C		0108,1	
04 to 01	PLATE 5 x 25 x 50			15-011-029	IS 2062 Fe 410WA	C		0104,6	

REV	DATE	ALTD:	APPD:	REV	DATE	ALTD:	APPD:	REV	DATE	ALTD:	APPD:
04	7/6/94	02	SK	03	18/2/94	02	SK	02	17-07-89	01	08-07-88

DIMENSIONS, WT & MATL CODE ALTD FROM

VAR. NO.	A	B	C	T	WT	MATL CODE
08,09	32	49	4	10	0.268	-098
10	42	67	5	12	0.533	-132
11	52	82	7	16	1.046	-026
12	64	102	9	20	2.079	-150
13	76	122	11,5	25	3.689	-081

MATERIAL CHANGED IN BOM FROM BMC20 & BMC16 TO IS 2062 Fe 410WA & IS 2062 Fe 410WB RESPECTIVELY. NOTE-01 DELETED.

NOTE-02 DELETED.

IN BOM, PLATE SIZE ALTERED FOR VAR-NO 01 TO 07.

FOR VAR. Nos. 01 TO 07 DIMENSIONS E & G AND WEIGHT ALTERED.

TYPE OF PRODUCT OR NAME OF CUSTOMER / PROJECT

## STANDARD

**BHARAT HEAVY ELECTRICALS LTD.**  
 PIPING CENTRE, MADRAS

DRN: R.Seshagiri  
 CHD: M.Masilamani  
 APPD: J.Jude

DATE: 07-04-88  
 No. OF VAR: 15

DEPT. PC GRADE OF UN TOL. DIM C/M/F SCALE NTS WEIGHT (Kg) AS PER BOM REF TO ASSY/DED DRG 1.80-999-99002 & 1.80-999-99003. ITEM No. 09

TITLE: LUG PLATE CARD CODE U 01 DRAWING No. 2-80-999-99138 REV 05


6E166 - 666 - 08 - Z

DRAWING No.


125/

NOTE :

01. ACCEPTABLE EQUIVALENT MATL : SA-192 FOR SA-210, Gr. A1  
SA-106, Gr. C FOR SA-106, Gr. B.

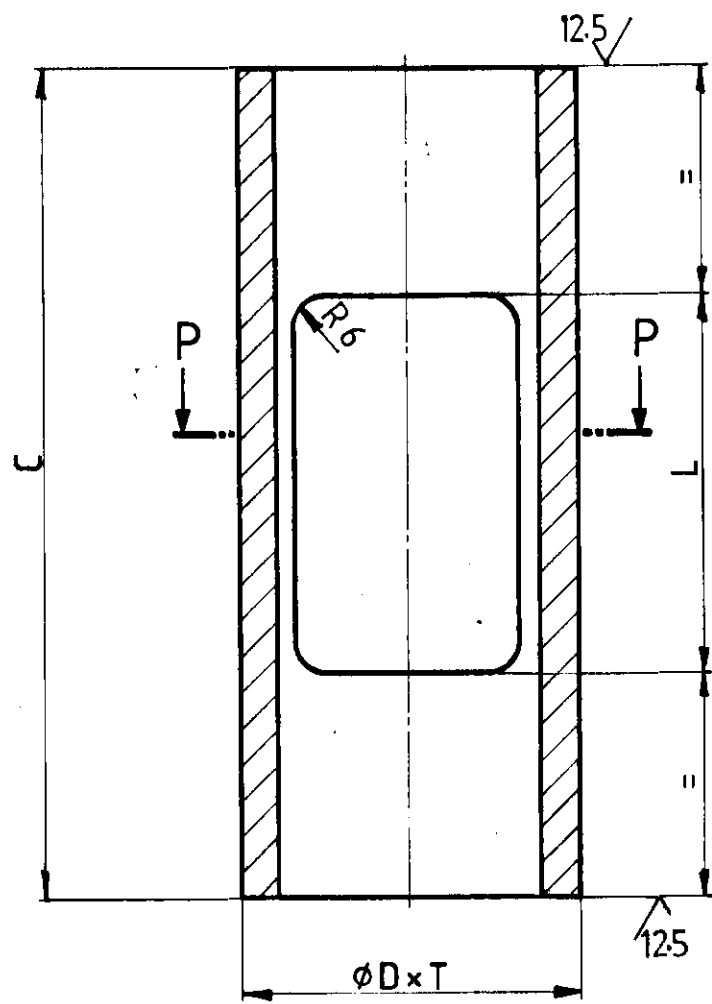

SECTION - PP

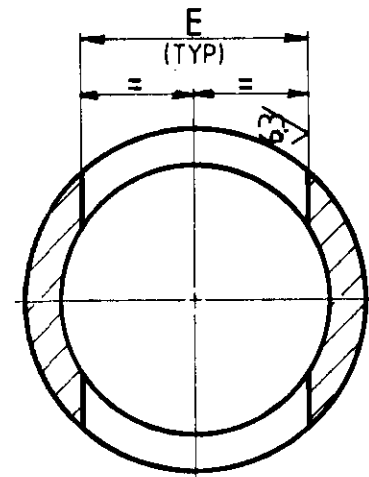

VAR. NO.	C	ØD x T	E	L	REMARKS
01 to 04	144	Ø44,5 x 5	30	100	
05 & 06	146	Ø63,5 x 5,6	46	86	
07	218	Ø63,5 x 5,6	46	160	
08 & 09	222	Ø76,1 x 7,1	46	155	
10	246	Ø88,9 x 5,49	60	170	
11	252	Ø108 x 8,0	80	160	
12	296	Ø127 x 8,0	90	165	
13	304	Ø127 x 8,0	90	155	
14	354	Ø219,1 x 22,2	160	220	
15	371	Ø219,1 x 22,2	160	220	

ITEM No.	DESCRIPTION	STD	DRAWING No.	ITEM No.	MATL CODE	UNIT	UNIT WT	QTY	ZONE
15	PIPE Ø219,1 x 22,2 L=371	2-80-999-99139		15 082 219	SA 106 Gr B	C	26,000	1	
14	PIPE Ø219,1 x 22,2 L=354			15 - 082 - 219	SA 106 Gr. B	C	24,100	1	
13	PIPE Ø127 x 8-Ø L=304			15 - 082 - 178	SA 106 Gr. B	C	7,600	1	
12	PIPE Ø127 x 8-Ø L=296			15 - 082 - 178	SA 106 Gr. B	C	7,130	1	
11	PIPE Ø108 x 8,0 L=252			15 - 082 - 164	SA 106 Gr. B	C	3,070	1	
10	PIPE Ø88,9 x 5,49; L=246			15 - 082 - 138	SA 106 Gr. B	C	2,930	1	
09 & 08	PIPE Ø76,1 x 7,1 L=222			15 - 086 - 124	SA 210 Gr. A1	C	1,330	1	
07	PIPE Ø63,5 x 5,6 L=218			15 - 086 - 116	SA 210 Gr. A1	C	1,280	1	
06 & 05	PIPE Ø63,5 x 5,6 L=146			15 - 086 - 116	SA 210 Gr. A1	C	0,931	1	
04 to 01	PIPE Ø44,5 x 5,0 L=144			15 - 086 - 071	SA 210 Gr. A1	C	0,536	1	

TYPE OF PRODUCT OR NAME OF CUSTOMER / PROJECT: **STANDARD**

**BHE** BHARAT HEAVY ELECTRICALS LTD., PIPING CENTRE, MADRAS

DRN: R.Seshagiri, NAME: R. Seshagiri, DATE: 14-4-88, No. OF VAR: 15  
 CHD: M.Masilamani, DATE: 18-6-88  
 APPD: J.Jude, DATE: 21-6-88

DEPT: PC, GRADE OF UN TOL DIM: C/M/F, SCALE: NTS, WEIGHT (Kg): AS PER BOM, REF TO ASSY/DWG DRG

TITLE: **TURN BUCKLE BODY**, CARD CODE: U 01, DRAWING No.: 2-80-999-99139, REV: 03

REV	DATE	ALTD	BY	REV	DATE	ALTERED	BY	ZONE
03	30/09/88	CHD		02	17/7/89	CHECKED		
01	20.02.88	CHECKED		01	20.02.88	CHECKED		

FOR VAR-NO. 10 SLOT DIMENSION 'E' ALTERED FROM 80 TO 60 mm.

ØD x T ALTERED AS FOLLOWS:

VAR-NO	FROM	TO	CORRECTION
08/09	63.5x5.6	76.1x7.1	PONDINKY
10	108x8	88.9x5.49	MATE CODE
12/12	127x12.5	127x8.0	ALTERED


DIMN. 'A' & 'B' AND TOLERANCE 'H7' DELETED.

05-228/C

CAUTION THE INFORMATION ON THIS DOCUMENT IS THE PROPERTY OF BHARAT HEAVY ELECTRICALS LTD. IT MUST NOT BE USED DIRECTLY OR INDIRECTLY IN ANY WAY DETRIMENTAL TO THE INTEREST OF THE COMPANY.

07166 - 666 - 08 - Z

DRAWING NO.

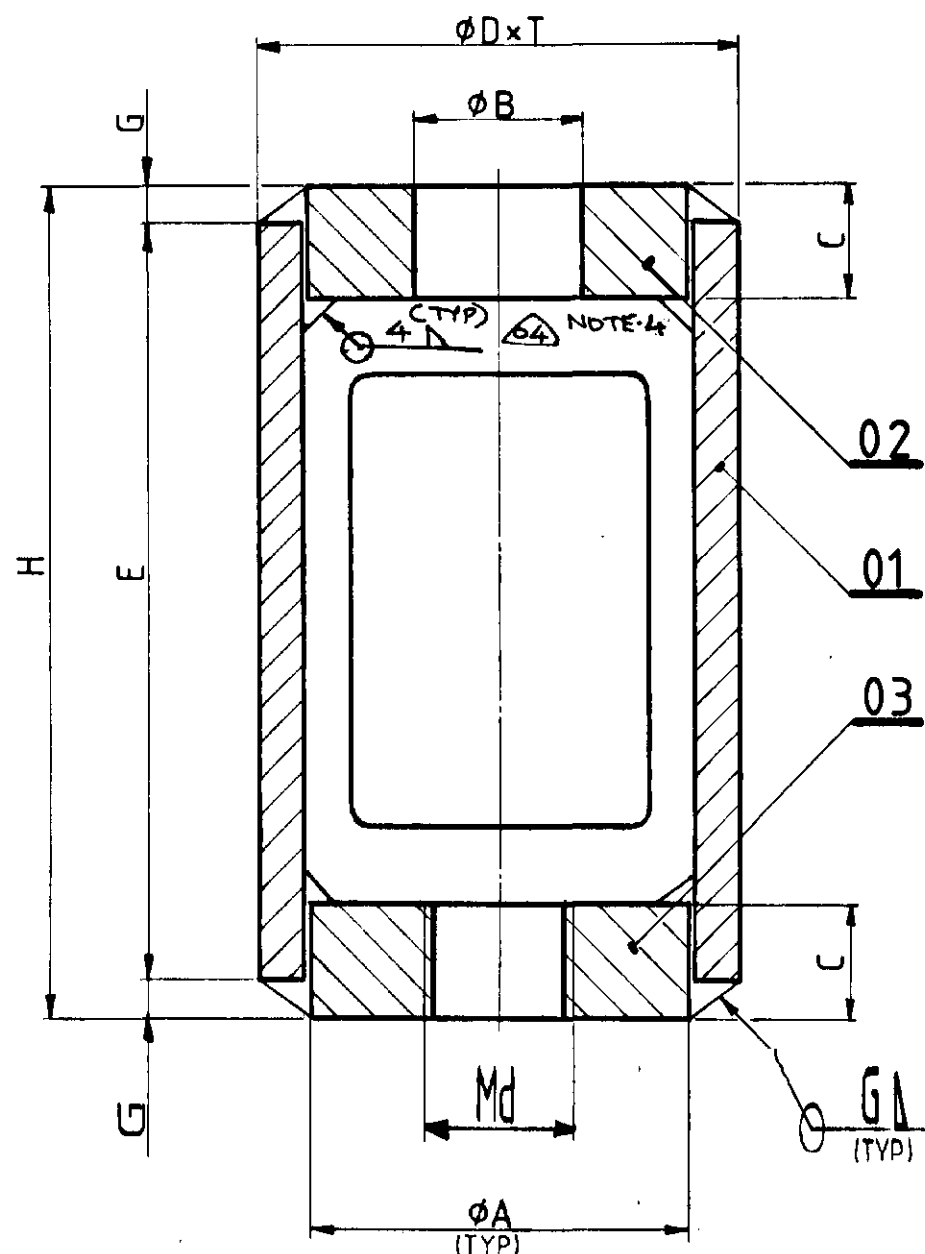

NOTE :-

- 01. EACH VARIANT OF THIS ASSEMBLY SHALL CONTAIN CORRESPONDING VARIANT OF THE PARTS.
- 02. ELECTRODE TO BE USED :- E 7018.
- 03. ELECTRO GALVANISING TO A DEPTH OF 15 µm TO BE DONE AFTER WELDING OF ITEM NO 02 & 03 TO ITEM NO 01. THREADED PART IS TO BE YELLOW CHROMOTISED TO 15µm & THREAD MATCHING SHALL BE DONE AFTERWARDS.
- 04. INSIDE WELDING SHALL BE DONE CAREFULLY TO AVOID WELD SPATTER ETC. MAINLY ON THE INNER SURFACE OF ITEM NO. 02, ON WHICH THE NUT HAS TO BE ACCOMODATED; ALSO THE HOLE IN ITEM NO. 02 AND THE INTERNAL THREAD IN ITEM NO. 03 SHOULD NOT BE DISTURBED DURING 'INSIDE WELDING'.

VAR. NO	φA	φB	C	Md	φD×T	E	G	H	WEIGHT(Kg)
01 to 04	33	14	16	M12×1,75	φ44,5×5,0	144	5	154	0,745
05 & 06	50	18	25	M16×2,0	φ63,5×5,6	146	6	158	1,708
07	50	22	25	M20×2,5	φ63,5×5,6	218	6	230	2,009
08 & 09	60	27	25	M24×3,0	φ76,1×7,1	222	6	234	1,995
10	76	33	36	M30×3,5	φ88,9×5,49	246	8	262	6,494
11	91	40	36	M36×4,0	φ108×8,0	252	8	268	6,433
12	109	52	56	M48×5,0	φ127×8,0	296	12	320	13,160
13	109	60	56	M56×4,0	φ127×8,0	304	12	328	13,033
14	174	72	85	M68×4,0	φ219,1×22,2	354	22	398	53,180
15	174	90	85	M85×4,0	φ219,1×22,2	371	22	415	52,189

VARIANT No.	ITEM No.	DESCRIPTION	STD	DRAWING No.	ITEM No.	MATL CODE	A	UNIT	UNIT WT	QTY
	03	PLATE - 2		3-80-999-99151					1	
	02	PLATE - 1		3-80-999-99150					1	
	01	TURN BUCKLE BODY		2-80-999-99139					1	
15 to 01		TURN BUCKLE		2-80-999-99140					1	
						WELDMENT				

TYPE OF PRODUCT OR NAME OF CUSTOMER / PROJECT: **STANDARD**

**BHARAT HEAVY ELECTRICALS LTD.,** PIPING CENTRE, MADRAS

DRN: R.Seshagiri, SIGN: R. Seshagiri, DATE: 15-4-88, No. OF: 15

CHD: M.Masilamani, APPD: J. Jude, DATE: 15-4-88, No. OF: 15

DEPT: PC, GRADE OF UN TOL DIM: C/M/F, SCALE: NTS, WEIGHT (kg): AS PER TABLE, REF TO ASSY/OLD DRG: 1-80-999-99002. & 1-80-999-99003, ITEM No: 15

TITLE: **TURN BUCKLE**, CARD CODE: U 01, DRAWING No: 2-80-999-99140, REV: 04

REV	DATE	ALTERED BY	APPROVED	REV	DATE	ALTERED BY	APPROVED	REV	DATE	ALTERED BY	APPROVED	REV	DATE	ALTERED BY	APPROVED
04	04/01/88	APPD		03	01/06/88	APPD		02	17/7/89	CHECKED		01	20/07/88	CHECKED	

INSIDE WELDING OF ITEM NOS 02 & 03 WITH ITEM NO. 01 ADDED. NOTE - 04 ADDED

DIM φA ALTERED AS FOLLOWS:

VAR. NO.	FROM	TO
08/09	50	60
10	91	76
12/13	100	109

φDXT ALTERED AS FOLLOWS:

VAR. NO.	FROM	TO
08/09	63.5×5.6	76.1×7.1
10	108×8	88.9×5.49
12/13	127×12.5	127×8.0


DIM. 'A' ALTERED. CONNECTING DETAIL OF ITEMS 1&2 AND 1&3 ALTERED.

05-228/C

CAUTION THE INFORMATION ON THIS DOCUMENT IS THE PROPERTY OF BHARAT HEAVY ELECTRICALS LTD. IT MUST NOT BE USED DIRECTLY OR INDIRECTLY IN ANY WAY DETRIMENTAL TO THE INTEREST OF THE COMPANY.

FIRST ANGLE PROJECTION (ALL DIMENSIONS IN MILLIMETRES)

2-80-99141

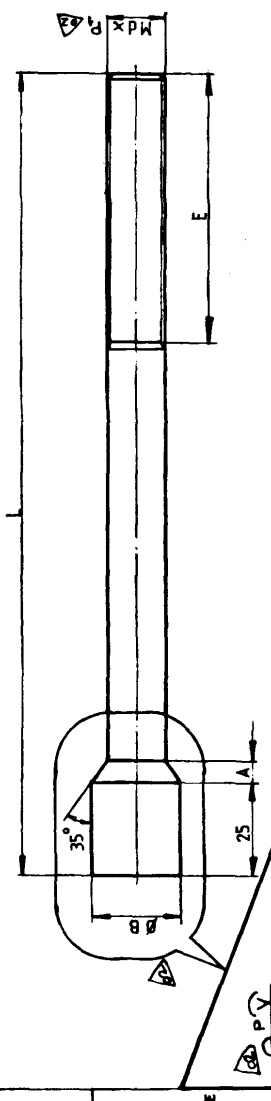

VAR NO.	P	Q	MdxR <sub>2</sub>	A	Ø B	MdxP <sub>1</sub>	E	L	REMARKS
01	2	3	M12x1.75	5	19.0	M12x1.75	300	467	
02	2	3	M12x1.75	5	19.0	M12x1.75	300	457	
03	2	3	M12x1.75	5	19.0	M12x1.75	300	607	
04	3	4	M12x1.75	6	20.4	M12x1.75	300	635	
05	4	4	M16x2	6	24.4	M16x2.0	325	668	
06	4	6	M16x2	8	27.2	M16x2.0	325	661	
07	5	7.5	M20x2.5	10	34.0	M20x2.5	375	694	
08	5	9	M24x3	12	40.8	M24x3.0	395	890	
09	5	13	M24x3	16	46.4	M24x3.0	395	1006	
10	8	12	M30x3.5	16	52.4	M30x3.5	450	1097	
11	8	13	M36x3	16	58.4	M36x4.0	480	1071	
12	10	17	M48x3	20	76.0	M48x5.0	565	1234	
13	12	22	M56x3	25	91.0	M56x4.0	605	1466	
14				32	112.8	M68x4.0	730	-	
15				36	135.4	M85x4.0	820	-	

**ALTERNATIVE ARRANGEMENT**  
 (MADE OF 2 PIECES AND WELDED TOGETHER).  
 BOTH THE PIECE ARE OF MATERIAL SA105(C) & SUITABLE SIZES, MAINTAINING ALL DIMENSIONS.

- NOTES:
01. MATL. EQUIVALENT: IS.1875 CL.3. (OR) IS.961 Fe 540 WHT (OR) BS 970 080 M40
  02. THIS COMPONENT SHALL BE ELECTRO GALVANISED TO A DEPTH OF 15UM AND THREADED PORTIONS SHALL BE YELLOW CHROMATISED.
  03. THREAD MATCHING SHALL BE DONE AFTER GALVANISING.

NOTE: IS.1875 CL.2 IS ALSO ACCEPTABLE IN PLACE OF SA105

ITEM No.	DESCRIPTION	QTY	UNIT	WT	QTY	UNIT	WT
15	ROUND Ø165. L=	2,80,999.99141					
	15-339-282 SA-105						
14	ROUND Ø125. L=						
	15-339-281 SA-105						
13	ROUND Ø100. L=1466						29 1000
	15-339-134 SA-105						
12	ROUND Ø80. L=1234						18 1000
	15-339-144 SA-105						
11	ROUND Ø63. L=1071						9 1000
	15-339-143 SA-105						
10	ROUND Ø63. L=1037						6 1200
	15-339-143 SA-105						
09	ROUND Ø50. L=1006						3 1000
	15-339-142 SA-105						
08	ROUND Ø50. L=890						3 1300
	15-339-142 SA-105						
07	ROUND Ø36. L=694						1 1830
	15-339-280 SA-105						
06	ROUND Ø32. L=661						1 1150
	15-339-140 SA-105						
05	ROUND Ø25. L=668						1 1130
	15-339-139 SA-105						
04	ROUND Ø22. L=635						0 1610
	15-339-343 SA-105						
03	ROUND Ø22. L=601						0 1580
	15-339-343 SA-105						
02	ROUND Ø22. L=457						0 1440
	15-339-343 SA-105						
01	ROUND Ø22. L=467						0 1450
	15-339-343 SA-105						

STANDARD

TYPE OF PRODUCT OR NAME OF CUSTOMER | PROJECT

**BHARAT HEAVY ELECTRICALS LTD.**  
 PIPING CENTRE, MADRAS

DRN: RSP/IND/IND/01  
 CHD: M/Masilamanni  
 APD: J. JUDGE

WEIGHT (KG) AS PER BOM: 1,80,999.99003

SCALE: NTS

DATE OF ISSUE: 01/10/88

BY: [Signature]

CHKD: [Signature]

DATE: 01/10/88

REVISIONS:

REV	DATE	ALTERED BY	REASON
01	01/10/88	[Signature]	ISSUED FOR FABRICATION
02	01/10/88	[Signature]	ISSUED FOR FABRICATION
03	01/10/88	[Signature]	ISSUED FOR FABRICATION
ITEM No. 15

UNIT WT 0.4

QTY 04

DRAWING No. 2-80-999.99141


REV 04

SIZE A2

CAUTION: THE INFORMATION ON THIS DOCUMENT IS THE PROPERTY OF BHARAT HEAVY ELECTRICALS LTD. IT MUST NOT BE USED DIRECTLY OR INDIRECTLY IN ANY MANNER DETRIMENTAL TO THE INTEREST OF THE COMPANY.

3-12-000-06295  
DRAWING NO.

12.5

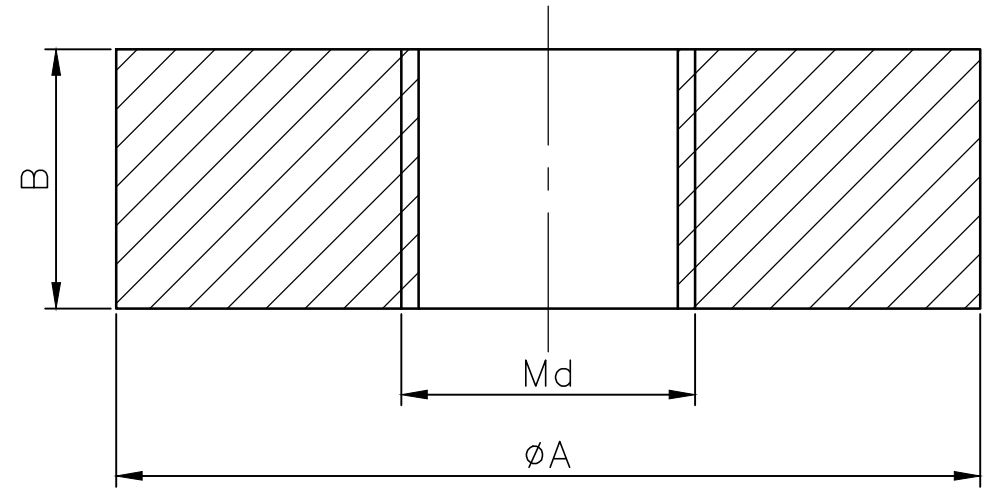


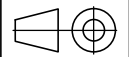
NOTES:

- 01. MATL- EQUIVALENT:- SA 515 Gr.70. (OR) IS-961 Fe-540 WHT.
- 02."IS 1875 CL2" IS ALSO ACCEPTABLE IN PLACE OF 'SA105'.


VARIANT NUMBER	ITEM NUMBER	DESCRIPTION	ØA	ØB	Md	ITEM NO	MATERIAL CODE	A/C/P	UNIT	UNIT WEIGHT	Q
						VAR NO	MATERIAL SPECN		DI	QUANTITY	
13		ROUND Ø125. L=56	109	56	M48x3		15-339-281 SA-105			2.797	
12		ROUND Ø125. L=56	109	56	M36x3		15-339-281 SA-105			3.084	
11		ROUND Ø100. L=36	91	36	M27x3		15-339-134 SA-105			1.715	
10		ROUND Ø80. L=36	76	36	M27x3		15-339-144 SA-105			1.803	
09 & 08		ROUND Ø63. L=25	60	25	M27x3		15-339-143 SA-105			0.344	
07		ROUND Ø50. L=25	50	25	M27x3		15-339-142 SA-105			0.371	
06 & 05		ROUND Ø50. L=25	50	25	M27x3		15-339-142 SA-105			0.394	
04 to 01		ROUND Ø36. L=16	33	16	M14x2		15-339-280 SA-105			0.107	

REV	DATE	ALTERED :
01		CHD & APPD:
ZONE		

CAUTION: The information on this document is the property of BHARAT HEAVY ELECTRICALS LTD. It must not be used directly or indirectly in any way detrimental to the interest of the company.

TYPE OF PRODUCT OR NAME OF CUSTOMER/PROJECT			
 355-055	Bharat Heavy Electricals Ltd UNIT: HIGH PRESSURE BOILER PLANT TIRUCHIRAPALLI - 620014		DRN R.GOBI CHD THINESH KUMAR APPD R.T
	DEPT	ALL DIMENSIONS ARE IN MM 	SCALE N.T.S WEIGHT (Kg) REF TO ASSY / OLD DWG 3-80-999-99151
	CODE	TITLE <b>PLATE-2</b> (FOR TURN BUCKLE)	
DRAWING NO : 3-12-000-06295			REV 00

3-12-000-06351  
DRAWING NO.:

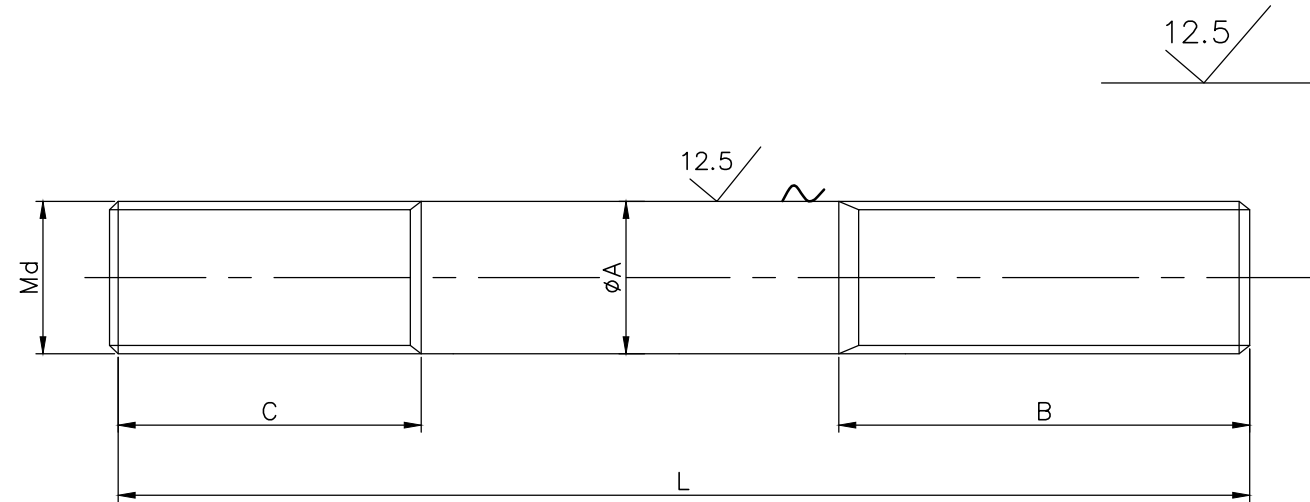

V.NO	MdxP	A	B	C	L	MATERIAL CODE	WEIGHT (kg).
01	M12x1.75	12	140	35	938	15-004-030	0.832
02	M12x1.75	12	140	35	938	15-004-030	0.832
03	M12x1.75	12	140	35	1021	15-004-030	0.906
04	M12x1.75	12	140	35	1021	15-004-030	0.906
05	M16x2	16	160	45	997	15-004-106	1.573
06	M16x2	16	160	45	997	15-004-106	1.573
07	M20x2.50	22	170	55	990	15-339-343	2.953
08	M24x3	25	180	65	1075	15-339-139	4.140
09	M24x3	25	180	70	1130	15-339-139	4.352
10	M30x3.50	32	200	80	1159	15-339-140	7.313
11	M36x4	36	210	95	1124	15-339-280	8.976
12	M48x5	48	260	120	1160	15-339-142	16.470
13	M56x4	56	270	145	1248	15-339-143	24.117

**MATERIAL :**

FOR VAR.No. 01 TO 06 IS 2062 E250A.

FOR VAR.No. 07 TO 15 - SA105.

**NOTES :**

01. MATERIAL EQUIVALENT :

IS 1875CL.3 OR IS 961 Fe540 WHT OR BS 970:080 M40.

02. THIS COMPONENT SHALL BE ELECTRO-GALVANIZED TO A DEPTH OF 15μM.

AND THREADED PORTIONS SHALL BE YELLOW CHROMATISED.

03. MATERIAL "IS 1875 CL2" IS ALSO ACCEPTABLE IN PLACE OF "SA105".


REV	DATE	ALTERED :
01		CHD & APPD:
ZONE		

CAUTION: The information on this document is the property of BHARAT HEAVY ELECTRICALS LTD. It must not be used directly or indirectly in any way detrimental to the interest of the company.				TYPE OF PRODUCT OR NAME OF CUSTOMER/PROJECT					
				DEPT CODE		ALL DIMENSIONS ARE IN MM PROJECTION 		SCALE N.T.S	
				WEIGHT (Kg)		REF TO ASSY / OLD DWG 3-80-999-99186		DRAWING NO : 3-12-000-06351	
DEPT CODE				NAME R.GOBI		SIGNATURE THINESHKUMAR		DATE 16.12.2014	
TITLE BOTTOM TIE ROD (TYPE SAT 80)				APPD R.T		DATE 17.12.2014		REV 00	



3-12-000-06486  
DRAWING NO.

VAR. NO.	MdxP	A	B	C	L	MATL CODE	WEIGHT (kg).
01	M12x1.75	12	140	35	1112	15-004-030	0.987
02	M12x1.75	12	140	35	1112	15-004-030	0.987
03	M12x1.75	12	140	35	1279	15-004-030	1.135
04	M12x1.75	12	140	35	1279	15-004-030	1.135
05	M16x2	16	160	45	1260	15-004-106	1.988
06	M16x2	16	160	45	1260	15-004-106	1.988
07	M20x2.5	22	170	55	1249	15-339-343	3.725
08	M24x3	25	180	65	1421	15-339-139	5.473
09	M24x3	25	180	70	1533	15-339-139	5.904
10	M30x3.5	32	200	80	1582	15-339-140	9.983
11	M36x4	36	210	95	1518	15-339-280	12.123
12	M48x5	48	260	120	1594	15-339-142	22.631
13	M56x4	56	270	145	1775	15-339-143	34.302

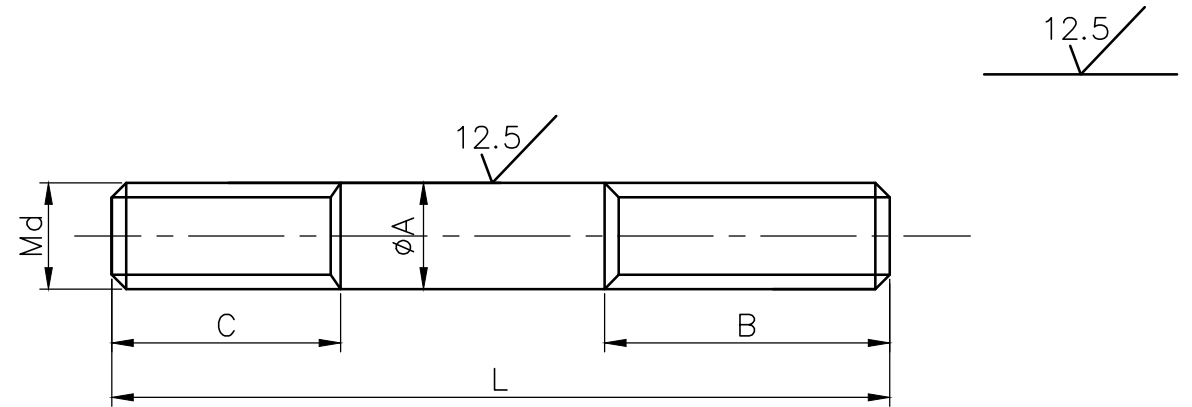

**MATERIAL:**

FOR VAR.No. 01 TO 06-IS 2062 E250A.

FOR VAR.No. 07 TO 15-SA105

**NOTES:**

- MATL. EQUIVALENT: IS1875 CL.3 OR IS961 Fe 540 WHT OR BS 970 080 M40.
- THIS COMPONENT SHALL BE ELECTRO-GALVANIZED TO A DEPTH OF 15µM. AND THREADED PORTIONS SHALL BE YELLOW CHROMATISED.
- "IS 1875 CL2" IS ALSO ACCEPTABLE IN PLACE OF "SA105".

REV	DATE	ALTERED :
01		CHD & APPD:
ZONE		

DEPT CODE TITLE <b>BHARAT HEAVY ELECTRICALS LTD</b> UNIT: HIGH PRESSURE BOILER PLANT TIRUCHIRAPALLI - 620014 355-055				TYPE OF PRODUCT OR NAME OF CUSTOMER/PROJECT		DRN		NAME		SIGNATURE		DATE			
				ALL DIMENSIONS ARE IN MM		PROJECTION		SCALE		WEIGHT (Kg)		REF TO ASSY / OLD DWG			
				N.T.S		N.T.S		3-80-999-99190		R.GOBI				16.12.14	
				BOTTOM TIE ROD (TYPE: SAT-160)		R.T				17.12.14		REV 3-12-000-06486 00			


CAUTION: The information on this document is the property of BHARAT HEAVY ELECTRICALS LTD. It must not be used directly or indirectly in any way detrimental to the interest of the company.

FIRST ANGLE PROJECTION (ALL DIMENSIONS IN MILLIMETRES)

3-80-999-99117

DRAWING No.

05-229/C.  
CAUTION THE INFORMATION OF THIS DOCUMENT IS THE PROPERTY OF BHARAT HEAVY ELECTRICALS LTD. IT MUST NOT BE USED DIRECTLY OR INDIRECTLY IN ANY WAY DETRIMENTAL TO THE INTEREST OF THE COMPANY.

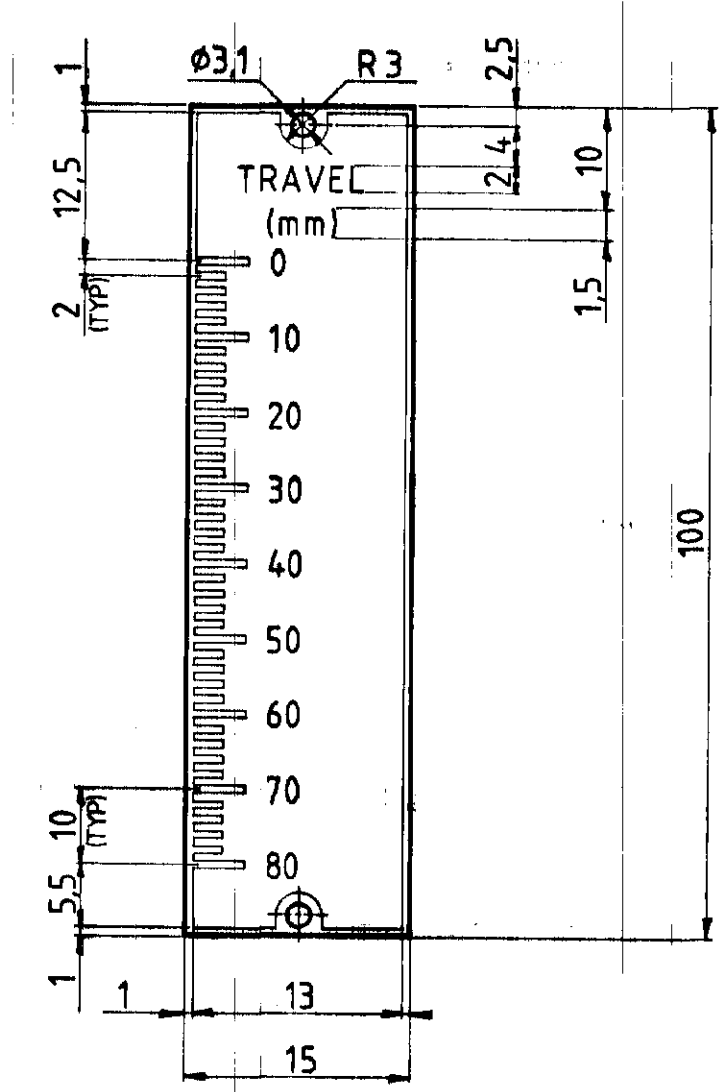

\* NOTES:-

01. LETTERING:- EURO STYLE - BOLD - EXTENDED.
02. FINISH:- LETTERS, GRADUATIONS AND BORDER SHALL BE BRIGHT WHITE WITH BLACK BACKGROUND.
03. PLATING:- PLATING SHALL BE CRACK RESISTANT SO THAT THE PLATING DOES NOT CRACK WHEN BENT.
04. ALL SHARP EDGES SHALL BE ROUNDED OFF.

△ THE HOLE FOR FIXING THE TRAVEL SCALE SHALL BE OF DIA. 2.65mm TO SUIT HAMMER DRIVE SCREWS  $\phi 3 \times 6$ , ON THE HOUSING.

VARIANT No.	ITEM No.	DESCRIPTION	QTY	MATL. CODE	A	UNIT	UNIT WT.	g
		SHEET 0.5 x 15 x 100	3-80-999-99117	SA 240 TYPE 304	C		0.012	1
				MATL SPEC.	C		QTY.	

TYPE OF PRODUCT OR NAME (I)		STANDARD	
CUSTOMER/ PROJECT		Bharat Heavy Electricals Ltd., BOILER PLANT UNIT TIRUCHIRAPALLI 620 014	
DRN	NAME R.Seshagiri	DATE	14-11-87
CHD	M.Masilamani	NO. OF VAR.	-
APP.	J.Jude		
DEPT	PC	GRADE OF INTOL DIM C/M/F	NTS
QTY	0,012	REF TO ASSY/ OLD DRG.	
TITLE	TRAVEL SCALE (TYPE-A)	CARD No.	01
		DRAWING No.	3-80-999-99117
		REV.	02

REV	DATE	ALTERED BY	REV	DATE	ALTERED BY
02	02/03/2005	APPD	01	10/2/2000	APPROVED
NOTE-05 DELETED.			SHEET THICKNESS ALTERED FROM 1 MM TO 0.5 MM. MATL CODE REMOVED.		


FIRST ANGLE PROJECTION (ALL DIMENSIONS IN MILLIMETERS)

06-229/C  
CAUTION THE INFORMATION OF THIS DOCUMENT IS THE PROPERTY OF BHARAT HEAVY ELECTRICALS LTD. IT MUST NOT BE USED DIRECTLY OR INDIRECTLY IN ANY WAY DETRIMENTAL TO THE INTEREST OF THE COMPANY.

81166-666-08-ε  
DRAWING

NOTES:-

- 01. LETTERING:- EURO STYLE - BOLD - EXTENDED.
- 02. FINISH:- LETTERS AND BORDER SHALL BE BRIGHT WHITE WITH BLACK BACKGROUND.
- 03. PLATING:- PLATING SHALL BE CRACK RESISTANT SO THAT THE PLATING DOES NOT CRACK WHEN BENT.
- 04. SHARP EDGES SHALL BE ROUNDED OFF.
- 05. HOLES FOR FIXING THE NAME PLATE SHALL BE OF DIA 2.65mm TO SUIT THE HAMMER DRIVE SCREWS  $\phi 3 \times 6$ , ON THE HOUSING.

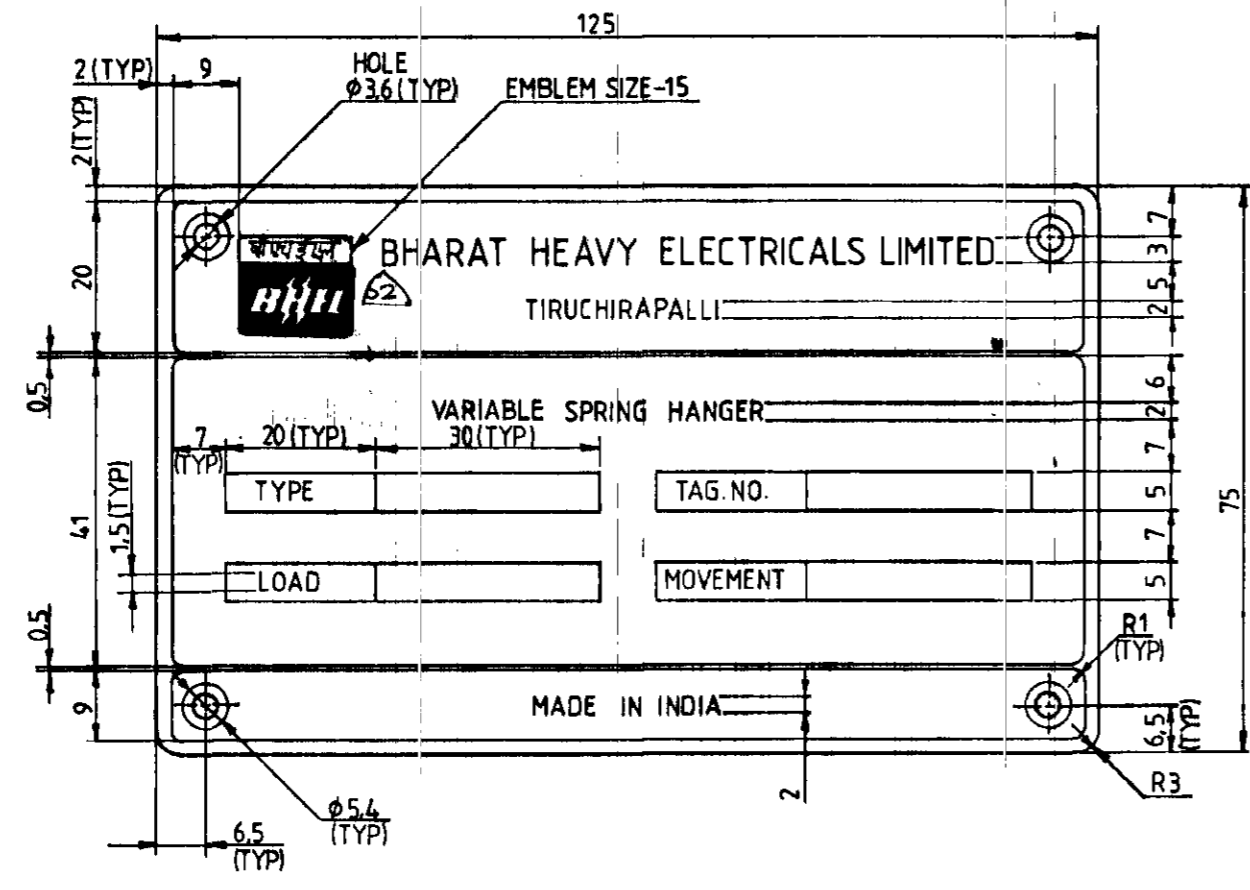

VARIANT No.	ITEM No.	DESCRIPTION	STD	DRAWING No.	MATL. CODE	A/C	UNIT	UNIT. WT.	QTY.	GS
		SHEET 0-5 75x125		3-80-999-99118	SA 240 TYPE 304	C		0.074	1	

TYPE OF PRODUCT OR NAME OF CUSTOMER/ PROJECT		STANDARD	
DEPT	UNION DIM. C/M/F	NTS	0,074
TITLE		3-80-999-99118.	
NAME PLATE FOR VARIABLE SPRING HANGER		REV. 02	

REV	DATE	ALTD	REV	DATE	ALTERED
02	02/03/2020	APPD.	01	12/2/2019	APPROVED
NOTE-05 DELETED. BH&EL EMBLEM IN THE NAME PLATE ALTERED.			SHEET THICKNESS ALTERED FROM 1mm TO 0.5mm. MATL CODE REMOVED.		


FIRST ANGLE PROJECTION (ALL DIMENSIONS IN MILLIMETRES)

05-229/C

CAUTION THE INFORMATION OF THIS DOCUMENT IS THE PROPERTY OF BHARAT HEAVY ELECTRICALS LTD. IT MUST NOT BE USED DIRECTLY OR INDIRECTLY IN ANY WAY DETRIMENTAL TO THE INTEREST OF THE COMPANY.

07166-666-08-E

DRAWING No.

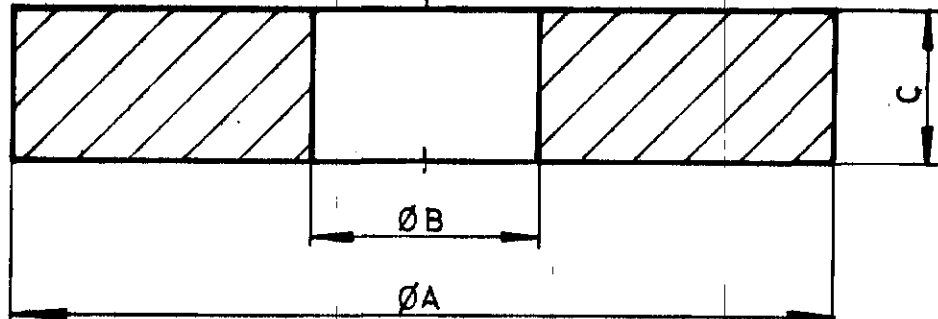

VAR. NO.	Ø A	Ø B	C	REMARKS
01	90	20	5	
02	130	20	5	
03	90	20	5	
04	100	20	6	
05	125	25	6	
06	130	25	8	
07	170	30	10	
08	150	35	12	
09	180	35	16	
10	200	40	16	
11	286	45	16	
12	330	60	20	
13	360	70	25	
14	290	80	32	
15	336	100	36	

VARIANT No.	ITEM No.	DESCRIPTION	DRAWING No.	ITEM No.	MATL. CODE	A	UNIT	UNIT. WT.	QTY.
	15	PLATE Ø336 T-36	3-80-999-99140	15-011-124	IS 2062 Fe 410 WB	C		22 838	1
	14	PLATE Ø290 T-32		15-011-130	IS 2062 Fe 410 WB	C		15 330	1
	13	PLATE Ø360 T-25		15-011-081	IS 2062 Fe 410 WB	C		19 219	1
	12	PLATE Ø330 T-20		15-011-150	IS 2062 Fe 410 WA	C		12 984	1
	11	PLATE Ø286 T-16		15-011-026	IS 2062 Fe 410 WA	C		7 687	1
	10	PLATE Ø200 T-16		15-011-026	IS 2062 Fe 410 WA	C		3 787	1
	09	PLATE Ø180 T-16		15-011-026	IS 2062 Fe 410 WA	C		3 075	1
	08	PLATE Ø150 T-12		15-011-132	IS 2062 Fe 410 WA	C		1 657	1
	07	PLATE Ø170 T-10		15-011-098	IS 2062 Fe 410 WA	C		1 726	1
	06	PLATE Ø130 T-8		15-011-027	IS 2062 Fe 410 WA	C		0 803	1
	05	PLATE Ø125 T-6		15-011-092	IS 2062 Fe 410 WA	C		0 555	1
	04	PLATE Ø100 T-6		15-011-092	IS 2062 Fe 410 WA	C		0 355	1
	03	PLATE Ø90 T-5		15-011-029	IS 2062 Fe 410 WA	C		0 237	1
	02	PLATE Ø130 T-5		15-011-029	IS 2062 Fe 410 WA	C		0 508	1
	01	PLATE Ø90 T-5		15-011-029	IS 2062 Fe 410 WA	C		0 237	1

TYPE OF PRODUCT OR NAME OF CUSTOMER/ PROJECT: **STANDARD**

Rharat Heavy Electricals Ltd.,  
BOILER PLANT UNIT  
TIRUCHIRAPALLI 620 014

NAME: R.Srinivasan  
SIGN: [Signature]  
DATE: 11 08 88  
No. OF VAR.: [Blank]

DESIGNED BY: M.Masilamani  
CHECKED BY: J.Jude  
DATE: 12 09 88

SCALE: NTS

TITLE: MIDDLE PLATE (SH-160)

DRAWING No.: 3-80-999-99140.

REV.: 01


REV 01 DATE 04-01-2000 ALTERED [Signature] CHECKED [Signature]  
MATERIAL CHANGED IN BOM FROM 'BMC20' & 'BMC16' TO 'IS 2062 Fe 410 WA' & 'IS 2062 Fe 410 WB' RESPECTIVELY

FIRST ANGLE PROJECTION (ALL DIMENSIONS IN MILLIMETRES)

67166-666-08-E

DRAWING NO.

SECTION - PP

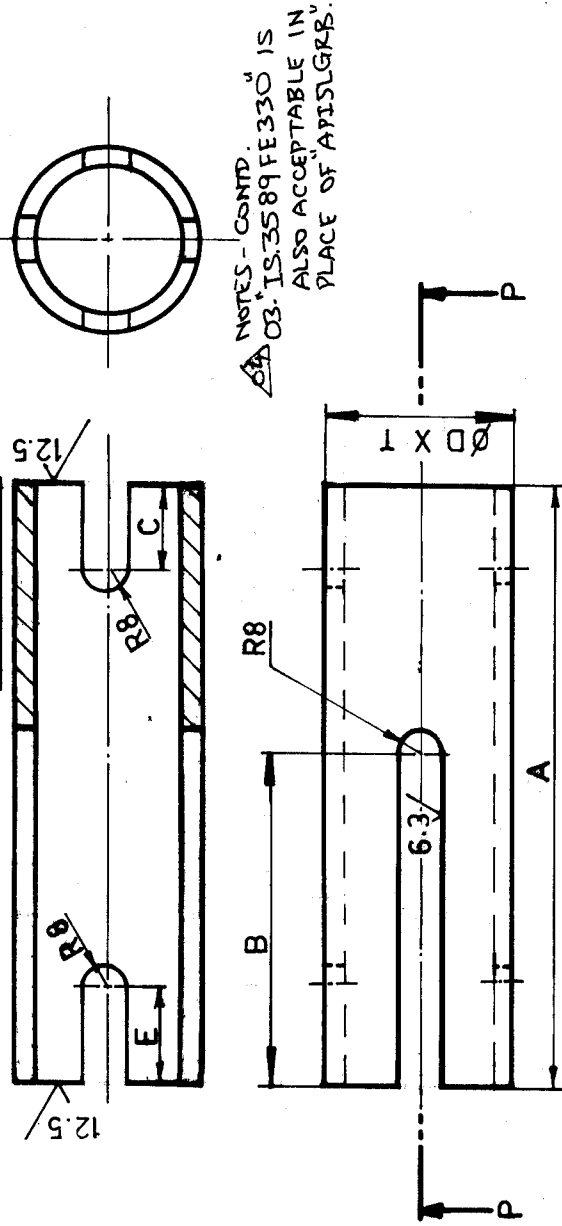

NOTES - CONTD.  
 03. IS-3589 FE330 IS ALSO ACCEPTABLE IN PLACE OF API 5L GR.B.

NOTE-01 FOR VAR.NOS. 11 TO 15. THICKNESS OF PIPES 6.35mm IS ACCEPTABLE.  
 02. THE INSIDE WELD BEAD HAS TO BE GROUND FLUSH, SMOOTH.

VAR NO	Ø D X T	A	B	C	E	REMARKS
01	113.9 X 3.65	393	225	30	5	
02	166.5 X 4.85	385	225	30	6	
03	113.9 X 3.65	527	225	30	5	
04	113.9 X 3.65	561	225	30	5	
05	166.5 X 4.85	573	225	35	6	
06	166.5 X 4.85	569	225	35	6	
07	219.1 X 6.35	573	225	40	7	
08	166.5 X 4.85	749	225	45	6	
09	219.1 X 6.35	869	225	55	7	
10	219.1 X 6.35	917	225	60	7	
11	323.9 X 7.92	863	225	70	9	
12	355.6 X 7.92	951	225	90	9	
13	406.4 X 9.53	1146	225	90	11	
14	323.9 X 7.92		225	110	9	
15	355.6 X 7.92		225	110	9	

REV DATE	ALTD	REV DATE	ALTD	REV DATE	ALTD
03/11/08	APPD	02/10/2008	APPD	01/19/6/89	CHECKED

NOTE-02 ADDED. DIMENSION 'B' FOR SLOTS INCREASED BY 20mm FOR ALL VARIANTS AS PER SHOP FEEDBACK.

NOTE-03 ADDED. DIMENSION 'A' ALTERED FROM 813 TO 869mm; WEIGHT ALTERED FROM 26.720 TO 28.585 kg [FOR VAR.NO-09]

ITEM No.	DESCRIPTION	DRAWING No.	MATL CODE	MATL SPEC.	UNIT. WT.	QTY.
15	PIPE Ø355.6 x 7.92	3-80-999-99149	15-938-217	API 5L GR.B		
14	PIPE Ø323.9 x 7.92		15-938-199	API 5L GR.B		
13	PIPE Ø406.4 x 9.53		15-938-172	API 5L GR.B	106	105
12	PIPE Ø355.6 x 7.92		15-938-217	API 5L GR.B	64	150
11	PIPE Ø323.9 x 7.92		15-938-199	API 5L GR.B	52	858
10	PIPE Ø219.1 x 6.35		15-938-194	API 5L GR.B	30	166
09	PIPE Ø219.1 x 6.35		15-938-194	API 5L GR.B	28	585
08	PIPE Ø166.5 x 4.85		15-038-085	IS-1239	14	143
07	PIPE Ø219.1 x 6.35		15-938-194	API 5L GR.B	18	767
06	PIPE Ø166.5 x 4.85		15-038-085	IS-1239	10	706
05	PIPE Ø166.5 x 4.85		15-038-085	IS-1239	10	783
04	PIPE Ø113.9 x 3.65		15-038-089	IS-1239	5	388
03	PIPE Ø113.9 x 3.65		15-038-089	IS-1239	5	051
02	PIPE Ø166.5 x 4.85		15-038-085	IS-1239	7	179
01	PIPE Ø113.9 x 3.65		15-038-089	IS-1239	3	727

**STANDARD**

TYPE OF PRODUCT OR NAME OF CUSTOMER/ PROJECT

**Bharat Heavy Electricals Ltd.,  
BOILER PLANT UNIT  
TIRUCHIRAPALLI 620 014**

DEPT PC GRADE OF UNTOL DIM. C/M/F SCALE NTS WEIGHT (kg) AS PER BOM 1-80-999-99003. REF. TO ASSY/ Q&D DRG. ITEM No.

DRN. R.Srinivasan. SIGN DATE No. OF VAR. 28.04.88  
 CHD. M.Masilaman. APPD. J.Judc. 12.09.88

TITLE HOUSING. (SH-160) DRAWING No. 3-80-999-99149 REV. 04


U 01

CAUTION THE INFORMATION OF THIS DOCUMENT IS THE PROPERTY OF BHARAT HEAVY ELECTRICALS LTD. IT MUST NOT BE USED DIRECTLY OR INDIRECTLY IN ANY WAY DETRIMENTAL TO THE INTEREST OF THE COMPANY.

FIRST ANGLE PROJECTION (ALL DIMENSIONS IN MILLIMETRES)

05166 - 666 - 08 - E

ON DRAWING

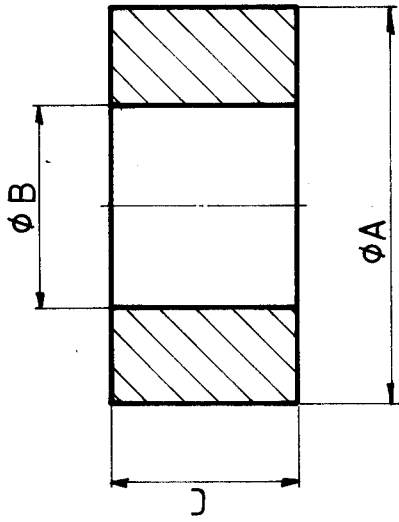

NOTES:-

- 01. MATERIAL EQUIVALENT:- SA 515 Gr 70. (OR) IS\_961 Fe\_540 WHT.
- 02. IS 1875 CL2 IS ALSO ACCEPTABLE IN PLACE OF SA-105.

125/

VAR. NO.	phi A	phi B	C	REMARKS
01 to 04	33	14	16	
05 & 06	50	18	25	
07	50	22	25	
08 & 09	60	27	25	
10	76	33	36	
11	91	40	36	
12	109	52	56	
13	109	60	56	
14	174	72	85	
15	174	90	85	

ITEM No.	DESCRIPTION	DRAWING No.	ITEM No. VAR. No.	MATL. CODE	MATL. SPEC.	UNIT. WT.	QTY.
15	ROUND phi 200. L = 85.	3 - 80 - 999 - 99150		15-339-283	SA-105	12,924	
14	ROUND phi 200. L = 85.			15-339-283	SA-105	14,452	
13	ROUND phi 125. L = 56.			15-339-281	SA-105	2,636	
12	ROUND phi 125. L = 56.			15-339-281	SA-105	2,946	
11	ROUND phi 100. L = 36.			15-339-134	SA-105	1,648	
10	ROUND phi 80. L = 36.			15-339-144	SA-105	1,761	
09 & 08	ROUND phi 63. L = 25.			15-339-143	SA-105	0,321	
07	ROUND phi 50. L = 25.			15-339-142	SA-105	0,358	
06 & 05	ROUND phi 50. L = 25.			15-339-142	SA-105	0,383	
04 to 01	ROUND phi 36. L = 16.			15-339-280	SA-105	0,102	

TYPE OF PRODUCT OR NAME OF CUSTOMER/ PROJECT

STANDARD



Bharat Heavy Electricals Ltd.,  
BOILER PLANT UNIT  
TIRUCHIRAPALLI 620 014

DRN. R.Seshagiri  
CHD. M.Masilamani  
APPD. J.Jude  
NAME R.Seshagiri  
SIGN R.Seshagiri  
DATE 08-04-88  
No. OF VAR. 15

REV.	DATE	ALTERED BY	CHECKED BY	REVISION
02	17/1/89	RA	RA	
01	20.07.88	RA	RA	

NOTE: 02 ADDED.

DIM 'A' ALTERED AS FOLLOWS:  
 VAR-NO. FROM TO CORRESPONDING  
 08/09 50 60  
 10 91 76  
 12/13 100 109  
 CHANGE IN BODY PIPE SIZE.

DIMENSION 'A' ALTERED. TOLERANCE Y5 DELETED.  
 MATL IS 1875 CL-3 REPLACED BY SA 515 Gr. 70. IN NOTE-1.  
 MATL. SIZE & CODE ALTD. FOR VAR. No. 01 TO 09. 12 & 13.

DEPT	GRADE OF UNTOOL. DIM. C/M/F	SCALE	WEIGHT (kg)	REF. TO ASSY/ DED DRG.	ITEM No.
PC		NTS	AS PER BOM		

TITLE: PLATE-1 (For Turn Buckle)

CARD CODE: U 01

DRAWING No.: 3-80-999-99150

REV. 03

CAUTION THE INFORMATION OF THIS DOCUMENT IS THE PROPERTY OF BHARAT HEAVY ELECTRICALS LTD. IT MUST NOT BE USED DIRECTLY OR INDIRECTLY IN ANY WAY DETRIMENTAL TO THE INTEREST OF THE COMPANY.


FIRST ANGLE PROJECTION (ALL DIMENSIONS IN MILLIMETRES)

12.5/√

NOTES:

- 01. MATL. EQUIVALENT:-SA 515 Gr 70. (OR) IS-961 FG-540 WHT.
- 02. "IS.1875 CL2" IS ALSO ACCEPTABLE IN PLACE OF SA105.

15166 - 666 - 08 - E

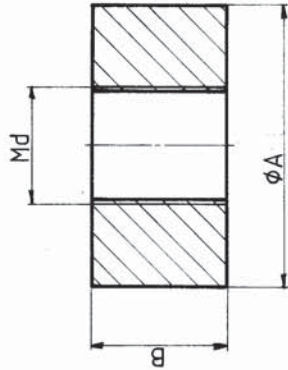

VAR. NO.	phi A	B	Md	REMARKS
01 to 04	33	16	12x1,75	
05 & 06	50	25	16x2	
07	50	25	20x2,5	
08 & 09	60	25	24x3	
10	76	36	30x3,5	
11	91	36	36x4	
12	109	56	48x5	
13	109	56	56x4	
14	174	85	68x4	
15	174	85	85x4	

CAUTION THE INFORMATION OF THIS DOCUMENT IS THE PROPERTY OF BHARAT HEAVY ELECTRICALS LTD. IT MUST NOT BE USED DIRECTLY OR INDIRECTLY IN ANY WAY DETRIMENTAL TO THE INTEREST OF THE COMPANY.

ITEM No.	DESCRIPTION	GRADE OF UNTOOL. DIM. C/M/F	SCALE	WEIGHT (KG)	AS PER BOM	DR. No.	CHD.	APPD.	NAME	DATE	No. OF VAR.
15	ROUND φ200. L=85		NTS			3-80-999-99151			R. Seshagiri	11-04-88	13,382
14	ROUND φ200. L=85								SA-105		14,745
13	ROUND φ125 L=56								SA-105		2,797
12	ROUND φ125 L=56								SA-105		3,084
11	ROUND φ100. L=36								SA-105		1,715
10	ROUND φ80. L=36								SA-105		1,803
09 & 08	ROUND φ63. L=25								SA-105		0,344
07	ROUND φ50. L=25								SA-105		1,037,1
06 & 05	ROUND φ50. L=25								SA-105		1,039,4
04 to 01	ROUND φ36. L=16								SA-105		1,107

TYPE OF PRODUCT OR NAME OF CUSTOMER/ PROJECT

DEPT PC

GRADE OF UNTOOL. DIM. C/M/F

SCALE

WEIGHT (KG)

AS PER BOM

DR. No.

CHD.

APPD.

NAME

DATE

No. OF VAR.

ITEM No.

REV.

**Bharat Heavy Electricals Ltd.,**  
**BOILER PLANT UNIT**  
**TIRUCHIRAPALLI 620 014**

**STANDARD**

**PLATE - 2**  
**(For Turn Buckle)**

**3-80-999-99151**


**U 01**

**03**

FIRST ANGLE PROJECTION (ALL DIMENSIONS IN MILLIMETRES)

Z5166 - 666 - 08 - E

DRAWING NO.

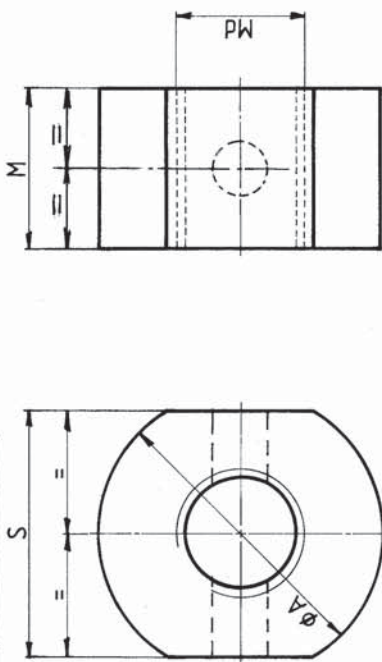

NOTE:

01. MATL. EQUIVALENT: IS-1875 (L.3. (OR) IS-961 Fe.540 WHT (OR) BS 970 080 M40
02. THIS COMPONENT SHALL BE ELECTRO GALVANISED TO A DEPTH OF 15µM AND THREADED PORTIONS SHALL BE YELLOW CHROMATISED.
03. THREAD MATCHING SHALL BE DONE AFTER GALVANISING.
04. HOLE TO BE DRILLED AS INDICATED IN DOTTED LINES, AS PER SHOP NOTE-5 OF ASSY DRG. NO: 1-80-999-99002.

05. "IS.1875CL2" IS ALSO ACCEPTABLE IN PLACE OF "SA105"

VAR. NO.	φ A	Md	S	M	REMARKS
01 to 04	22	M12x1,75	19	12	
05 & 06	28	M16x2,0	24	16	
07	35	M20x2,5	30	20	
08 & 09	42	M24x3,0	36	24	
10	53	M30x3,5	46	30	
11	63	M36x4,0	55	36	
12	80	M48x5,0	70	48	
13	92	M56x4,0	80	56	
14	110	M68x4,0	100	68	
15	127	M85x4,0	115	85	

ITEM No.	DESCRIPTION	GRADE OF UNTOOL DIM. C/M/F	SCALE	WEIGHT (KG)	AS PER BOM	REF. TO ASSY/ OLD DRG. No.	ITEM No.
15	ROUND φ165. L-85		NTS			1-80-999-99002 & 1-80-999-99003	16
14	ROUND φ125. L-68						
13	ROUND φ100. L-56						
12	ROUND φ100. L-48						
11	ROUND φ80. L-36						
10	ROUND φ63. L-30						
09 & 08	ROUND φ50. L-24						
07	ROUND φ36. L-20						
06 & 05	ROUND φ32. L-16						
04 to 01	ROUND φ25. L-12						

STANDARD

TYPE OF PRODUCT OR NAME OF CUSTOMER/ PROJECT

Bharat Heavy Electricals Ltd., BOILER PLANT UNIT TIRUCHIRAPALLI 620 014

DRN. R.Seshagiri R. Seshagiri  
CHD. M.Masilamani  
APPD. J. Jude

DATE: 19-04-88  
No. OF VAR.: 15

DEPT. PC  
SCALE: NTS  
WEIGHT (KG): AS PER BOM

TITLE: NUT

CARD CODE: U 01  
DRAWING NO.: 3-80-999-99152

REV. 03

REV	DATE	ALTERED	CHECKED	DATE	ALTERED	CHECKED
02	01/11/89			22/7/89		
01						

IN NOTE 1, MATL. BS 970 EN8 IS ADDED.

14 NOTE No- 01 MATL: BS 970 EN8 changed to BS 970 080 M40

REV DATE 07-03-07 ALTERED: APPROVED: B


NOTE 05 ADDED

FIRST ANGLE PROJECTION (ALL DIMENSIONS IN MILLIMETRES)

ES166-666-08-E

ON DRAWING

THIS SURFACE TO BE KNURLED PARALLELLY.

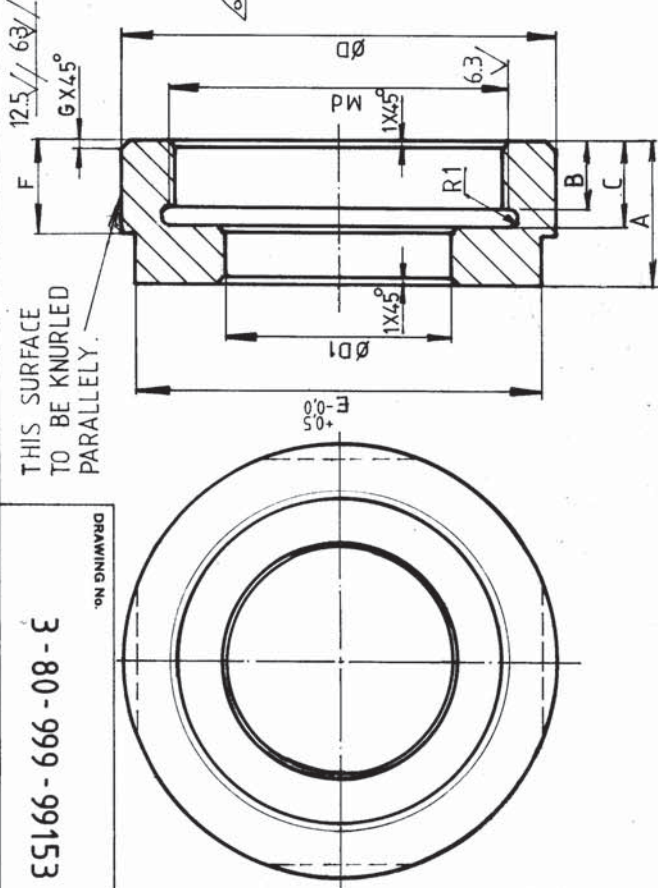

NOTES:

01. MATL. EQUIVALENT: IS-1875 CL.3. (OR) IS-961 Fe-540 WHT (OR) BS: 970 D80 M40
02. THIS COMPONENT SHALL BE ELECTRO GALVANISED TO A DEPTH OF 15 µM AND THREADED PORTIONS SHALL BE YELLOW CHROMATISED.
03. THREAD MATCHING SHALL BE DONE AFTER GALVANISING.
04. "IS-1875 CL.2" IS ALSO ACCEPTABLE IN PLACE OF "SA105".

ITEM No.	DESCRIPTION	QTY	DRAWING No.	ITEM No.	VAR. No.	MATL. CODE	MATL. SPEC.	UNIT. WT.	QTY.
15	ROUND Ø165. L-178.	3	3-80-999-99153			15-339-282	C		10190
						SA-105			
14	ROUND Ø165. L-144.					15-339-282	C		51810
						SA-105			
13	ROUND Ø125. L-114.					15-339-281	C		31270
						SA-105			
12	ROUND Ø100. L-94.					15-339-134	C		11660
						SA-105			
11	ROUND Ø80. L-73.					15-339-144	C		01830
						SA-105			
10	ROUND Ø63. L-59.					15-339-143	C		01490
						SA-105			
09	ROUND Ø50. L-46.					15-339-142	C		01260
						SA-105			
08	ROUND Ø50. L-42.					15-339-142	C		01190
						SA-105			
07	ROUND Ø36. L-32.					15-339-280	C		01100
						SA-105			
06	ROUND Ø32. L-27.					15-339-140	C		01070
						SA-105			
04									
05									
01									

STANDARD

TYPE OF PRODUCT OR NAME OF CUSTOMER/ PROJECT



Bharat Heavy Electricals Ltd.,  
BOILER PLANT UNIT  
TIRUCHIRAPALLI 620 014

DRN. R.Srinivasan, P. Srinivasan, P. Srinivasan  
CHD. M.Masilamathi, V. Narasimhan, V. Narasimhan  
APPD. J.Jude, J.Jude, J.Jude  
SIGN. P. Srinivasan, P. Srinivasan, P. Srinivasan  
DATE 20-4-88  
No. OF VAR. 15  
ITEM No. 07  
REF. TO ASSY/ ORDER DRG. 1.80-999-99002 & 1.80-999-99003

DEPT PC GRADE OF UNTOOL DIM C/M/F SCALE NTS WEIGHT (kg) AS PER BOM



TITLE HYDRAULIC LOCK NUT  
CARD CODE U 01  
DRAWING No. 3-80-999-99153

VAR NO	ØD	ØD1	Md	A	B	C	E	F	6	REMARKS
01 to 04	30	14	M24x15	27	20	22	27	22	2	
05 & 06	36	18	M30x15	32	25	27	32	27	2	
07	44	23	M36x15	42	34	36	41	36	2	
08 & 09	50	27	M42x15	46	36	38	46	40	2	
10	60	33	M50x15	59	47	49	55	51	3	
11	70	39	M58x15	73	59	61	60	63	3	
12	90	51	M75x2	94	80	82	80	84	3	
13	110	59	M90x2	114	96	98	100	102	3	
14	130	71	M105x2	144	126	128	115	132	3	
15	155	88	M125x2	178	156	158	145	162	3	

REV DATE ALTERED: 03/11/99 APPROVED: [Signature]  
02 7/6/94 APPROVED: [Signature]  
01 22/7/89 CHECKED: [Signature]  
In Note No: 01 MATL BS: 970 M40 changed to BS 970 D80 M40  
REV DATE APPROVED: 04/07/03 APPROVED: [Signature]  
NOTE: 04 ADDED.


REV. DATE 03/11/99 APPROVED: [Signature]  
02 7/6/94 APPROVED: [Signature]  
01 22/7/89 CHECKED: [Signature]  
IN NOTE 1, MATL BS 970 EN 8 IS ADDED, NOTE -4 IS DELETED.  
TITLE CHANGED FROM SLEEVE NUT TO HYDRAULIC LOCK NUT.

CAUTION THE INFORMATION OF THIS DOCUMENT IS THE PROPERTY OF BHARAT HEAVY ELECTRICALS LTD. IT MUST NOT BE USED DIRECTLY OR INDIRECTLY IN ANY WAY DETRIMENTAL TO THE INTEREST OF THE COMPANY.

FIRST ANGLE PROJECTION (ALL DIMENSIONS IN MILLIMETRES)

75166-666-08-E

ON DRAWING

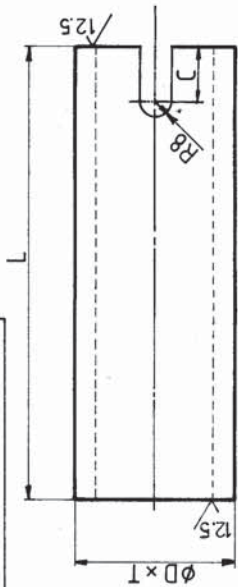

NOTES:

01. MACHINING ON OD IS APPLICABLE FOR VAR.NO.12 ONLY.  
 02. IS-1239 PIPES IN PLACE OF SA-192 IS ACCEPTABLE SUBJECT TO THE CONDITION OF MAINTAINING ØD  
 03. IS-3589 FE-330 IS ALSO ACCEPTABLE IN PLACE OF API-SLGR-B.

VAR.NO.	ØD x T	L	C	REMARKS.
01	Ø63,5 x 3,2	55	20	
02	Ø89,5 x 4,85	50	20	
03	Ø51,0 x 4,0	112	20	
04	Ø63,5 x 3,2	128	20	
05	Ø76,0 x 3,25	133	25	
06	Ø76,0 x 3,25	127	25	
07	Ø113,9 x 3,65	145	30	
08	Ø89,5 x 4,85	230	35	
09	Ø108,0 x 8,0	283	40	
10	Ø113,9 x 3,65	303	45	
11	Ø166,5 x 4,85	274	55	
12	Ø210,0 x 9,65	310	70	
13	Ø219,1 x 6,35	398	70	
14	Ø140,8 x 4,85	733	70	
15	Ø166,5 x 4,85	882	70	

REV	DATE	ALTERED BY	DATE	ALTERED BY	REV	DATE	ALTERED BY
03	20-6-99	Checked: [Signature]	19.6.89	Checked: [Signature]	01	21.07.88	Checked: [Signature]
DIMENSION 'L' REDUCED FROM 8mm FOR ALL VARIANTS AS PER SHOP FEEDBACK. DIMENSION 'C' ADDED. SLOTS TO BE CUT AS REQUIRED. Ø DXT, MATERIAL CODE & WEIGHT ALTERED FOR VAR NOS: 01 TO 04, 06 TO 12, AND 14.							

ITEM No.	DESCRIPTION	STG	DRAWING No.	ITEM No. / VAR. No.	MATL. CODE	MATL. SPEC.	UNIT. WT.	QTY.
15	PIPE Ø166,5x4,85 L-882		3-80-999-99154		15-038-085	IS-1239	17,088	
14	PIPE Ø140,8x4,85 L-733				15-038-084	IS-1239	12,000	
13	PIPE Ø219,1x6,35 L-406				15-938-194	API 5L Gr.B	13,512	
12	PIPE Ø219,1x14,2 L-310				15-082-215	SA 106 Gr.B	15,162	
11	PIPE Ø166,5x4,85 L-282				15-038-085	IS1239	5,415	
10	PIPE Ø113,9x3,65 L-303				15-038-089	IS1239	3,075	
09	PIPE Ø108,0x8,0 L-283				15-082-164	SA 106 Gr.B	5,740	
08	PIPE Ø89,5x4,85 L-230				15-038-073	IS-1239	2,404	
07	PIPE Ø113,9x3,65 L-145				15-038-089	IS1239	1,513	
06	PIPE Ø76,0x3,25 L-155				15-038-058	IS-1239	0,900	
05	PIPE Ø76,0x3,25 L-167				15-038-058	IS-1239	0,934	
04	PIPE Ø63,5x3,2 L-156				15-084-111	SA192	0,842	
03	PIPE Ø51,0x4,0 L-140				15-084-104	SA192	0,732	
02	PIPE Ø89,5x4,85 L-68				15-038-073	IS 1239	0,687	
01	PIPE Ø63,5x3,2 L-63				15-084-111	SA192	0,394	

STANDARD

TYPE OF PRODUCT OR NAME OF CUSTOMER/ PROJECT

Bharat Heavy Electricals Ltd.,  
 BOILER PLANT UNIT  
 TIRUCHIRAPALLI 620 014

DRN. R.Seshagiri R. [Signature]  
 CHD. M.Masilamani [Signature]  
 APPD. J.Jude [Signature]

DATE: 21-4-88

NO. OF VAR.: 15

REF. TO ASSY. DRG. NO.: 1-80-999-99002

SCALE: NTS

DEPT: PC GRADE OF UNITS: C/M/F

ITEM No. 14

REV. 05

CARD CODE U 01

DRAWING No. 3-80-999-99154


TITLE: INNER GUIDE PIPE

CAUTION THE INFORMATION OF THIS DOCUMENT IS THE PROPERTY OF BHARAT HEAVY ELECTRICALS LTD. IT MUST NOT BE USED DIRECTLY OR INDIRECTLY IN ANY WAY DETRIMENTAL TO THE INTEREST OF THE COMPANY.

FIRST ANGLE PROJECTION (ALL DIMENSIONS IN MILLIMETRES)

LS166-666-08-E

SECTION\_PP

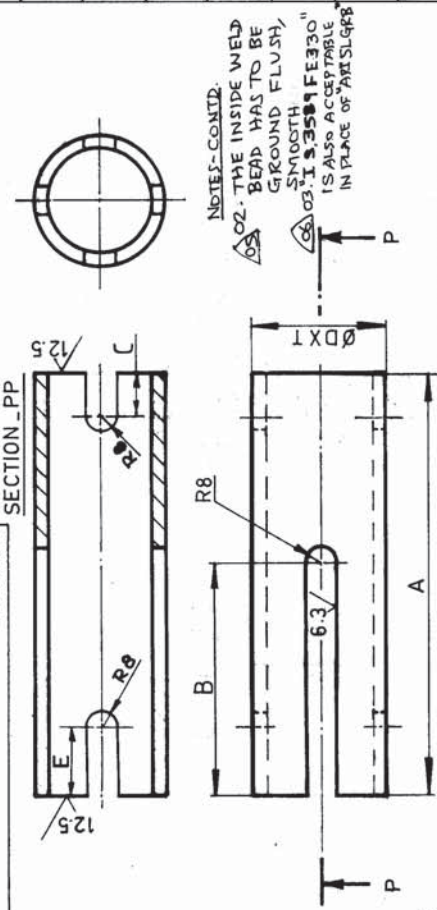

NOTES: CONTD.  
 02. THE INSIDE WELD BEAD HAS TO BE GROUND FLUSH, SMOOTH.  
 03. I 3.358 F E 330 IS ALSO ACCEPTABLE IN PLACE OF AISI 316

NOTES: 01. FOR VAR. NOS. 11 TO 15, THICKNESS OF PIPES 6.35MM IS ACCEPTABLE.

VAR. NO	Ø D X T	A	B	C	E	REMARKS
01	113.9 X 3.65	219	145	30	5	
02	166.5 X 4.85	216	145	30	6	
03	113.9 X 3.65	286	145	30	5	
04	113.9 X 3.65	303	145	30	5	
05	166.5 X 4.85	310	145	35	6	
06	166.5 X 4.85	310	150	35	6	
07	219.1 X 6.35	314	150	40	7	
08	166.5 X 4.85	403	150	45	6	
09	219.1 X 6.35	466	150	55	7	
10	219.1 X 6.35	494	160	60	7	
11	323.9 X 7.92	469	160	70	9	
12	355.6 X 7.92	517	170	90	9	
13	406.4 X 9.53	619	180	90	11	
14	323.9 X 7.92					
15	355.6 X 7.92					

REV	DATE	BY	CHKD	REK	DATE	ALTERED	DATE	REV	DATE	ALTERED	CHECKED
04	10/2/00	APPD		02	24/8/02	CHECKED	01	03/07/08			

DIMENSIONS A, B, C, AND WEIGHT ALTERED.  
 DIMENSION E, ADDED.  
 DIMENSION 'B' ALTERED FOR ALL VARIANTS.  
 REV DATE ALTERED: 8 JANUARY 03  
 06 07-03-07 APPROVED: [Signature]  
 NOTE-03 ADDED.

ITEM No.	DESCRIPTION	QTY	DRAWING No.	ITEM No. VAR. No.	MATL. CODE	MATL. SPEC.	UNIT. WT.	QTY.
15	PIPE Ø355.6X7.92.		3-80-999-99157.		15-938-217	API-5L GR-B	C	
14	PIPE Ø323.9X7.92.				15-938-199	API-5L GR-B	C	
13	PIPE Ø406.4X9.53				15-938-172	API-5L GR-B	C	57 1025
12	PIPE Ø355.6X7.92				15-938-217	API-5L GR-B	C	34 1648
11	PIPE Ø323.9X7.92				15-938-199	API-5L GR-B	C	28 517
10	PIPE Ø219.1X6.35				15-938-194	API-5L GR-B	C	16 1089
09	PIPE Ø219.1X6.35				15-938-194	API-5L GR-B	C	15 175
08	PIPE Ø166.5X4.85				15-038-085	IS-1239	C	7 500
07	PIPE Ø219.1X6.35				15-938-194	API-5L GR-B	C	10 147
06	PIPE Ø166.5X4.85				15-038-085	IS-1239	C	5 733
05	PIPE Ø166.5X4.85				15-038-085	IS-1239	C	5 733
04	PIPE Ø113.9X3.65				15-038-089	IS-1239	C	2 836
03	PIPE Ø113.9X3.65				15-038-089	IS-1239	C	2 16.68
02	PIPE Ø166.5X4.85				15-038-085	IS-1239	C	3 1934
01	PIPE Ø113.9X3.65				15-038-089	IS-1239	C	2 1006

TYPE OF PRODUCT OR NAME OF CUSTOMER/ PROJECT

**STANDARD**

Bharat Heavy Electricals Ltd.,  
 BOILER PLANT UNIT  
 TIRUCHIRAPALLI 620 014

NAME: R.Srinivasan  
 CHD: M.Masilamani  
 APPD: J.Judec.

DATE: 27.04.88  
 (86198)

REF. TO ASSY/ OLD DRG. 1-80-999-99002.

SCALE: NTS

WEIGHT (kg) AS PER BOM

DEPT PC GRADE OF UNIT DIM. C/M/F

ITEM No. 01

TITLE: HOUSING (SH-80)

CARD CODE U 01

DRAWING No. 3-80-999-99157.

REV. 06


CAUTION THE INFORMATION OF THIS DOCUMENT IS THE PROPERTY OF BHARAT HEAVY ELECTRICALS LTD. IT MUST NOT BE USED DIRECTLY OR INDIRECTLY IN ANY WAY DETRIMENTAL TO THE INTEREST OF THE COMPANY.

FIRST ANGLE PROJECTION (ALL DIMENSIONS IN MILLIMETRES)

5/166-666-08-E

DRAWING No.

SECTION-PP

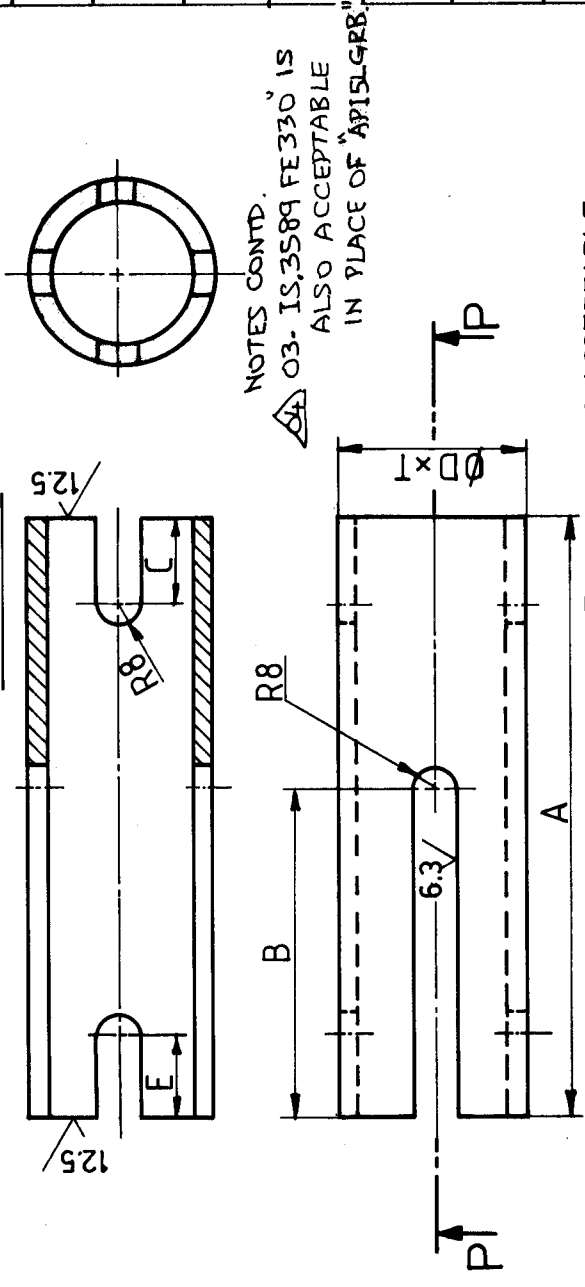

NOTES CONTD.  
 03- IS.3589 FE330 IS ALSO ACCEPTABLE IN PLACE OF "API5LGRB."

NOTES: 01- FOR VAR. NOS. 11 TO 15, THICKNESS OF PIPES 6.35mm. IS ACCEPTABLE.  
 02- THE INSIDE WELD BEAD HAS TO BE GROUND FLUSH, SMOOTH

VAR. NO.	A	B	C	E	REMARKS
01	204	145	30	5	
02	201	145	30	6	
03	271	145	30	5	
04	288	145	30	5	
05	298	145	35	6	
06	298	160	35	6	
07	305	160	40	7	
08	397	160	45	6	
09	460	160	55	7	
10	493	190	60	7	
11	473	190	70	9	
12	530	190	90	9	
13	639	210	90	11	
14					
15					

REV DATE	ALTD	APPD	REV DATE	ALTD	APPD	REV	DATE	ALTERED
03/11/11			02/12/2008			01	19/9/89	CHECKED
04/10/10								

NOTE 02 ADDED. DIMENSION 'B' FOR SLOTS INCREASED BY 10mm FOR VARIANTS 01 TO 13 AS PER SHOP FEED BACK.  
 NOTE 03 ADDED. FOR VAR. NO. 09 - DIMENSION 'A' ALTERED FROM 432 TO 460; WEIGHT ALTERED FROM 14.040 TO 14.973 kg.

ITEM No.	DESCRIPTION	DRAWING No.	MATL. CODE	MATL. SPEC.	UNIT. WT.	QTY.
15	PIPE Ø355,6x7,92.	3-80-999-99175	15-938-217	API 5L GRB		
14	PIPE Ø323,9x7,92.		15-938-199	API 5L GRB		
13	PIPE Ø406,4x9,53.		15-938-172	API 5L GRB	58,890	
12	PIPE Ø355,6x7,92.		15-938-217	API 5L GRB	35,530	
11	PIPE Ø323,9x7,92.		15-938-199	API 5L GRB	28,760	
10	PIPE Ø219,1x6,35.		15-938-194	API 5L GRB	16,060	
09	PIPE Ø219,1x6,35.		15-938-194	API 5L GRB	14,973	
08	PIPE Ø166,5x4,85.		15-038-085	IS 1239	7,380	
07	PIPE Ø219,1x6,35.		15-938-194	API 5L GRB	9,850	
06	PIPE Ø166,5x4,85.		15-038-085	IS 1239	5,500	
05	PIPE Ø166,5x4,85.		15-038-085	IS 1239	5,500	
04	PIPE Ø113,9x3,65.		15-038-089	IS 1239	2,690	
03	PIPE Ø113,9x3,65.		15-038-089	IS 1239	2,520	
02	PIPE Ø166,5x4,85.		15-038-085	IS 1239	3,650	
01	PIPE Ø113,9x3,65.		15-038-089	IS 1239	1,860	

TYPE OF PRODUCT OR NAME OF CUSTOMER/ PROJECT: **STANDARD**

Customer: **Bharat Heavy Electricals Ltd., BOILER PLANT UNIT TIRUCHIRAPALLI 620 014**

DRN. PS.VEL. DATE 19.09.88  
 CHD. M.M.MANI.  
 APPD. J.JUDE. 19.88

WEIGHT (kg) REF. TO ASSY/ OLD DRG.  
 SCALE NTS.  
 GRADE OF UNTOL. DIM. C/M/F

DEPT. TITLE: **HOUSING. (SA-80)**

CARD CODE: **U 01**

DRAWING No.: **3-80-999-99175**

REV. **04**


CAUTION THE INFORMATION OF THIS DOCUMENT IS THE PROPERTY OF BHARAT HEAVY ELECTRICALS LTD. IT MUST NOT BE USED DIRECTLY OR INDIRECTLY IN ANY WAY DETRIMENTAL TO THE INTEREST OF THE COMPANY.

FIRST ANGLE PROJECTION (ALL DIMENSIONS IN MILLIMETRES)

94166-666-08-E

DRAWING

SECTION-PP

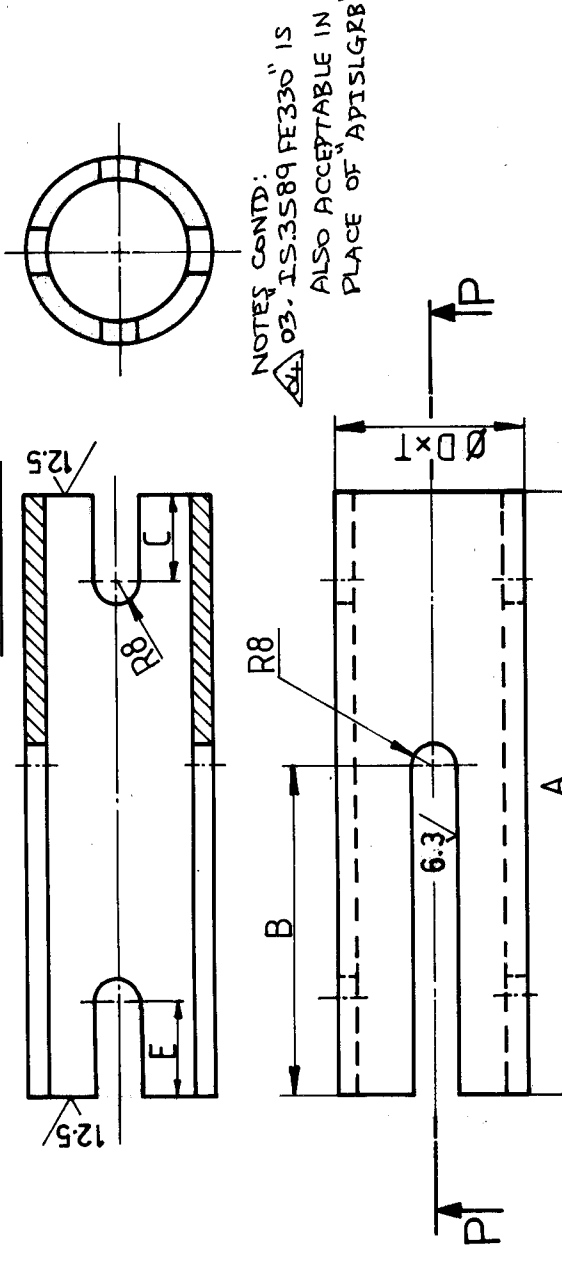

NOTES CONTD:  
 03. IS 3589 FE 330 IS ALSO ACCEPTABLE IN PLACE OF API 5L GRB.

NOTES: 01. FOR VAR. NOS. 11 TO 15, THICKNESS OF PIPES 6.35 mm. IS ACCEPTABLE.  
 02. THE INSIDE WELD BEAD HAS TO BE GROUND FLUSH, SMOOTH.

VAR. NO.	A	B	C	E	REMARKS.
01	378	245	30	5	
02	370	245	30	6	
03	512	245	30	5	
04	546	245	30	5	
05	561	245	35	6	
06	557	250	35	6	
07	564	250	40	7	
08	743	250	45	6	
09	863	250	55	7	
10	916	280	60	7	
11	867	280	70	9	
12	964	280	90	9	
13	1166	320	90	11	
14					
15					

REV	DATE	ALTD	APPD	REV	DATE	ALTD	APPD
03	11/1/00	APPD		01	19/1/80	ALTD	
02	10/2/00	APPD		01	19/1/80	CHECKED	
04	10/10/10	APPD					

NOTE 02 ADDED: DIMENSION 'B' FOR SLOTS INCREASED BY 20 MM FOR VARIANTS 01 TO 13, AS PER SHOP FEEDBACK.

NOTE 03 ADDED: FOR VAR. NO. 09, DIMENSION 'A' ALTERED FROM 807 TO 863; WEIGHT ALTERED FROM 26.520 TO 28.385 kg.

ITEM No.	DESCRIPTION	GRADE OF UNTOOL DIM. C/M/F	SCALE	WEIGHT (kg)	REF. TO ASSY/OLD DRG.	ITEM No.
15	PIPE Ø355,6 x 7,92		NTS			15-938-217
14	PIPE Ø323,9 x 7,92		NTS			API 5L GRB
13	PIPE Ø406,4 x 9,53		NTS			15-938-199
12	PIPE Ø355,6 x 7,92		NTS			API 5L GRB
11	PIPE Ø323,9 x 7,92		NTS			15-938-172
10	PIPE Ø219,1 x 6,35		NTS			API 5L GRB
09	PIPE Ø219,1 x 6,35		NTS			15-938-217
08	PIPE Ø166,5 x 4,85		NTS			API 5L GRB
07	PIPE Ø219,1 x 6,35		NTS			15-938-194
06	PIPE Ø166,5 x 4,85		NTS			API 5L GRB
05	PIPE Ø166,5 x 4,85		NTS			15-038-085
04	PIPE Ø113,9 x 3,65		NTS			IS1239
03	PIPE Ø113,9 x 3,65		NTS			15-038-085
02	PIPE Ø166,5 x 4,85		NTS			IS1239
01	PIPE Ø113,9 x 3,65		NTS			15-038-089

TYPE OF PRODUCT OR NAME OF CUSTOMER/ PROJECT: **STANDARD**

NAME: P.S. VEL  
 SIGNATURE: [Signature]  
 DATE: 20.09.88

DRN. CHD. APPD. M.M. MANI. J. JUDE.  
 REF. TO ASSY/OLD DRG. 14x88

ITEM No. 04

SCALE: NTS

DEPT. GRADE OF UNTOOL DIM. C/M/F

TITLE: HOUSING. (SA-160)

DRAWING No. 3-80-999-99176.

CARD CODE U 01

REV. 04

CAUTION THE INFORMATION OF THIS DOCUMENT IS THE PROPERTY OF BHARAT HEAVY ELECTRICALS LTD. IT MUST NOT BE USED DIRECTLY OR INDIRECTLY IN ANY WAY DETRIMENTAL TO THE INTEREST OF THE COMPANY.


SIZE A3

FIRST ANGLE PROJECTION (ALL DIMENSIONS IN MILLIMETRES)

77166-666-08-E

DRAWING No.

SECTION-PP

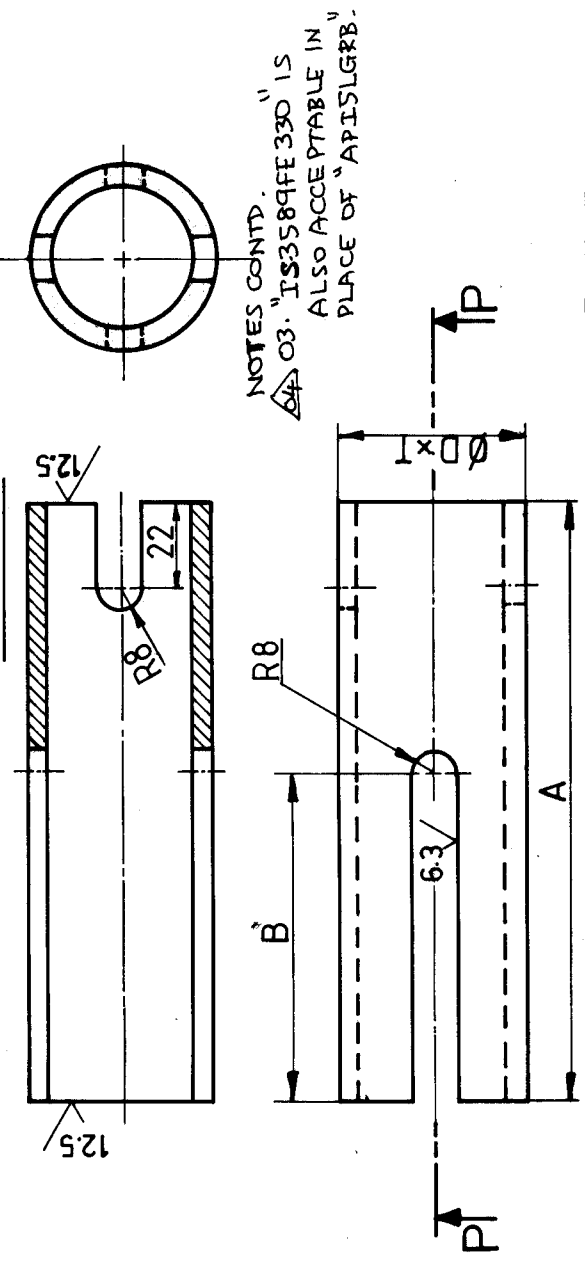

NOTES CONTD.  
 03. IS3589FE 330 IS ALSO ACCEPTABLE IN PLACE OF "API5LGRB".

NOTES: 01. FOR VAR. NO. 11 TO 15. THICKNESS OF PIPES 6.35 mm. IS ACCEPTABLE.  
 02. THE INSIDE WELD BEAD HAS TO BE GROUND FLUSH, SMOOTH.

VAR. NO.	A	B	REMARKS
01	199	155	
02	194	155	
03	266	155	
04	283	156	
05	288	156	
06	284	158	
07	284	160	
08	371	162	
09	428	166	
10	448	166	
11	419	166	
12	459	170	
13	552	175	
14	892	180	
15	1047	186	

REV	DATE	REV DATE	ALTD	REV	DATE	REV	DATE	ALTERED	CHECKED
03	11/19/2000	02	10/2/2000	01	19/16/89	01	19/16/89	CHECKED	

NOTE 02: ADDER DIMENSION B FOR SLOTTED DIMENSION B FOR SLOTTED INCREASED BY 10MM FOR ALL VARIANTS AS PER STOP FEED BACK.

NOTE 03: ADDED

ITEM No.	DESCRIPTION	GRADE OF UNTOOL. DIM. C/M/F	SCALE	WEIGHT (KG)	REF. TO ASSY/ OLD DRG.	ITEM No.
15	PIPE Ø355,6x7,92					70,689
14	PIPE Ø323,9x7,92					54,654
13	PIPE Ø406,4x9,53					51,021
12	PIPE Ø355,6x7,92					30,794
11	PIPE Ø323,9x7,92					25,491
10	PIPE Ø219,1x6,35					14,631
09	PIPE Ø219,1x6,35					13,965
08	PIPE Ø166,5x4,85					6,953
07	PIPE Ø219,1x6,35					9,177
06	PIPE Ø166,5x4,85					5,276
05	PIPE Ø166,5x4,85					5,356
04	PIPE Ø113,9x3,65					2,164,8
03	PIPE Ø113,9x3,65					2,14,80
02	PIPE Ø166,5x4,85					3,539
01	PIPE Ø113,9x3,65					1,18,16

TYPE OF PRODUCT OR NAME OF CUSTOMER/ PROJECT: STANDARD

Bharat Heavy Electricals Ltd., BOILER PLANT UNIT TIRUCHIRAPALLI 620 014

NAME: P.S.VEL. DRN. No. M.M.MANI CHD. No. J. JUDE APPD. No.

DATE: 17.09.88

SCALE: NTS

TITLE: HOUSING. (SS-80)

DRAWING No. 3-80-999-99177.

REV. 04


CAUTION THE INFORMATION OF THIS DOCUMENT IS THE PROPERTY OF BHARAT HEAVY ELECTRICALS LTD. IT MUST NOT BE USED DIRECTLY OR INDIRECTLY IN ANY WAY DETRIMENTAL TO THE INTEREST OF THE COMPANY.

FIRST ANGLE PROJECTION (ALL DIMENSIONS IN MILLIMETRES)

8/166-666-08-E

DRAWING NO.

SECTION-PP

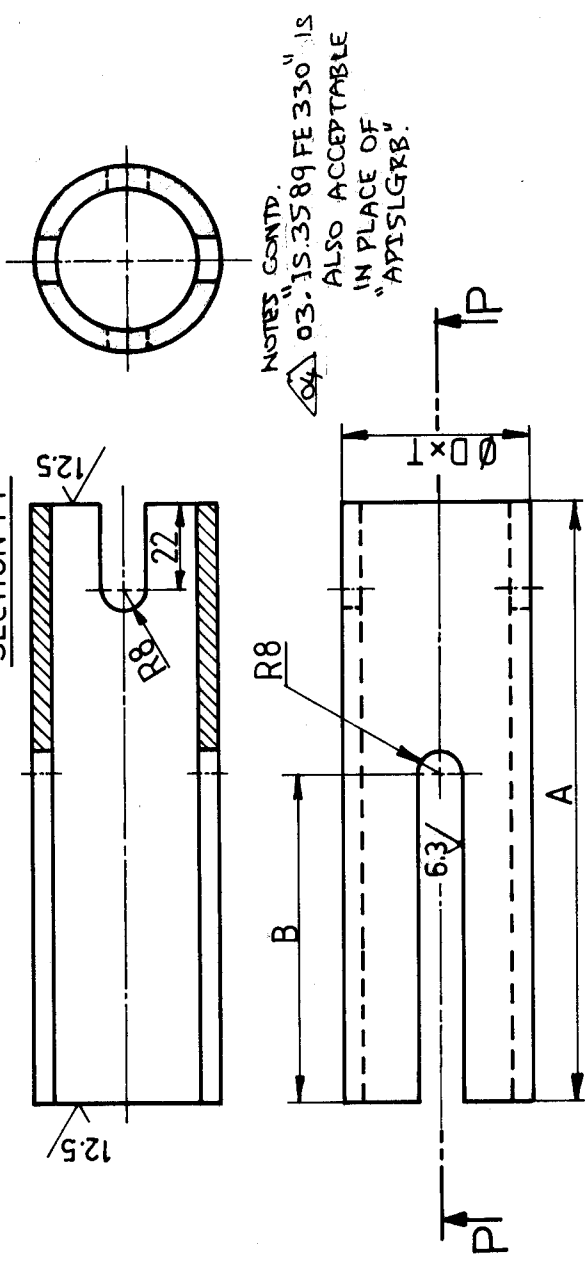

NOTE: 03. 15.3589 FE 330 IS ALSO ACCEPTABLE IN PLACE OF "APISLGRB".

VAR. NO.	A	B	REMARKS
01	373	260	
02	363	260	
03	507	260	
04	541	262	
05	551	262	
06	543	266	
07	543	270	
08	717	274	
09	831	262	
10	871	262	
11	813	262	
12	893	260	
13	1079	260	
14	1759	260	
15	2069	312	

REV	DATE	ALTD	APPD	REV	DATE	ALTD	APPD
03	11/19/00	01	10/2/00	01	19/6/89	01	10/2/00
04	11/03/00	02	10/2/00	02	19/6/89	02	10/2/00

NOTE 02 ADDED. DIMENSION 'B' FOR SLOTS INCREASED BY 20MM FOR ALL VARIANTS AS PER SHOP FEEDBACK.

NOTE 03 ADDED. DIMENSION 'A' ALTERED FROM 775 TO 831; WEIGHT ALTERED FROM 25.356 TO 27.221kg.


ITEM No.	DESCRIPTION	DRAWING No.	MATL. CODE	MATL. SPEC.	UNIT. WT.	QTY.
15	PIPE Ø355,6x7,92	3-80-999-99178.	15-938-217	API 5L GR B	C	139,837
14	PIPE Ø323,9x7,92		15-938-199	API 5L GR B	C	107,920
13	PIPE Ø406,4x9,53		15-938-172	API 5L GRB	C	99,898
12	PIPE Ø355,6x7,92		15-938-217	API 5L GRB	C	60,045
11	PIPE Ø323,9x7,92		15-938-199	API 5L GRB	C	49,595
10	PIPE Ø219,1x6,35		15-938-194	API 5L GRB	C	28,554
09	PIPE Ø219,1x6,35		15-938-194	API 5L GRB	C	27,221
08	PIPE Ø166,5x4,85		15-038-085	IS1239	C	13,518
07	PIPE Ø219,1x6,35		15-938-194	API 5L GRB	C	17,646
06	PIPE Ø166,5x4,85		15-038-085	IS1239	C	10,164
05	PIPE Ø166,5x4,85		15-038-085	IS1239	C	10,323
04	PIPE Ø113,9x3,65		15-038-089	IS1239	C	5,121
03	PIPE Ø113,9x3,65		15-038-089	IS1239	C	4,785
02	PIPE Ø166,5x4,85		15-038-085	IS1239	C	6,691
01	PIPE Ø113,9x3,65		15-038-089	IS1239	C	3,455

STANDARD

TYPE OF PRODUCT OR NAME OF CUSTOMER/ PROJECT



Bharat Heavy Electricals Ltd.,  
BOILER PLANT UNIT  
TIRUCHIRAPALLI 620 014

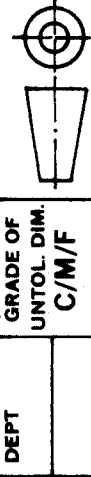

SCALE NTS

TITLE

HOUSING.  
(SS-160)

CARD CODE

U 01

DRAWING No.

3-80-999-99178.

REV.

04

SIZE A3


CAUTION THE INFORMATION OF THIS DOCUMENT IS THE PROPERTY OF BHARAT HEAVY ELECTRICALS LTD. IT MUST NOT BE USED DIRECTLY OR INDIRECTLY IN ANY WAY DETRIMENTAL TO THE INTEREST OF THE COMPANY.

FIRST ANGLE PROJECTION (ALL DIMENSIONS IN MILLIMETRES)

18166-666-08-E

DRAWING NO.

VAR NO.	Md	ROD DIA	L	MATL CODE	WEIGHT (Kg)	REMARKS
01	M12x1.75	12	191	15-004-030	0.170	
02	M12x1.75	12	191	15-004-030	0.170	
03	M12x1.75	12	191	15-004-030	0.170	
04	M12x1.75	12	192	15-004-030	0.170	
05	M16x2.00	16	217	15-004-106	0.342	
06	M16x2.00	16	219	15-004-106	0.346	
07	M20x2.50	22	249	15-339-343	0.615	
08	M24x3.00	25	272	15-339-139	0.970	
09	M24x3.00	25	276	15-339-139	0.980	
10	M30x3.50	32	316	15-339-140	1.750	
11	M36x4.00	36	355	15-339-280	2.840	
12	M48x5.00	48	425	15-339-142	6.040	
13	M56x4.00	56	479	15-339-143	9.260	
14	M68x4.00	68	571	15-339-144	16.280	
15	M85x4.00	85	672	15-339-134	29.930	

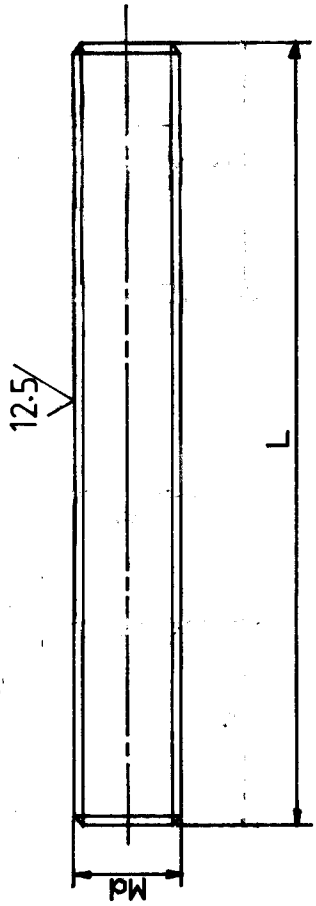

**MATERIAL:**  
 VAR. NO. 01 TO 06 - ~~BMC20~~ IS 2062 Fe 410 WA.  
 07 TO 15 - SA105

**NOTES:**  
 01. MATL. EQUIVALENT: IS 1875 CL3 (OR) IS 961 Fe 540 WHT (OR) BS 970 080 M40.  
 02. THIS COMPONENT SHALL BE ELECTRO-GALVANIZED TO A DEPTH OF 15 μm AND THREADED PORTIONS SHALL BE YELLOW CHROMATISED.  
 03. "IS 1875 CL2" IS ALSO ACCEPTABLE IN PLACE OF "SA105".

ITEM No.	DESCRIPTION	DRAWING No.	ITEM No. VAR. No.	MATL CODE	MATL SPEC.	UNIT. WT.	QTY.
1							
2							
3							
TYPE OF PRODUCT OR NAME OF CUSTOMER/ PROJECT: **STANDARD**

DEPT: **Electricals** | GRADE OF UNTOL. DIM. C/M/F: **NTS** | SCALE: **NTS** | WEIGHT (kg): **REF. TO ASSY/ OLD DRG.**

NAME: **R. ANANTH.** | DRN. No.: **620014** | CHD. No.: **620014** | APPD. No.: **620014** | SIGN: **R. Ananth** | DATE: **14/08/88** | No. OF VAR.: **03**

Customer: **Bharat Heavy Electricals Ltd., BOILER PLANT UNIT, TIRUCHIRAPALLI 620 014**

APPROVED: **J. JUDE.** | DATE: **14/88**

TITLE: **TOP TIE ROD (TYPE: SA-80)** | CARD CODE: **U 01** | DRAWING No.: **3-80-999-99181.** | REV. **03**

REV	DATE	ALTERED	APPROVED	REV	DATE	ALTERED	CHECKED
03	15/11/1998	APPROVED	<i>[Signature]</i>	01	2/3/198	APPROVED	<i>[Signature]</i>
02	15/11/1998	APPROVED	<i>[Signature]</i>				

NOTE-03 ADDED.  
 MATERIAL FOR VAR. NOS 01 TO 06 ALTERED FROM BMC20 TO IS 2062 Fe 410 WA.  
 IN NOTE NO-01, MATL BS970 -EM 8 CHANGED TO BS970 080-M40.


TOP TIE ROD IS CHANGED AS FULLY THREADED. DIM. B & C REMOVED. DIM 'A' CHANGED AS ROD DIA.

CAUTION THE INFORMATION OF THIS DOCUMENT IS THE PROPERTY OF BHARAT HEAVY ELECTRICALS LTD. IT MUST NOT BE USED DIRECTLY OR INDIRECTLY IN ANY WAY DETRIMENTAL TO THE INTEREST OF THE COMPANY.

98166-666-08-E

ON DRAWING

12.5/

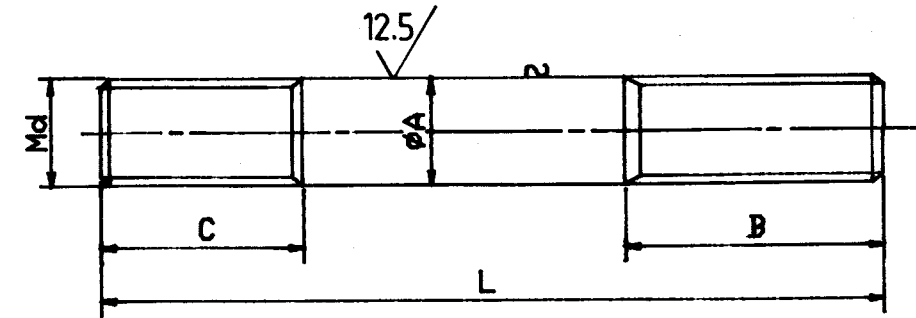

VAR NO.	Md	A	B	C	L	MATL CODE	WEIGHT (Kg).	REMARKS
01	M12x1.75	12	140	35	321	15-004-030	0.285	
02	M12x1.75	12	140	35	316	15-004-030	0.280	
03	M12x1.75	12	140	35	438	15-004-030	0.388	
04	M12x1.75	12	140	35	454	15-004-030	0.403	
05	M16x2.00	16	160	45	518	15-004-106	0.818	
06	M16x2.00	16	160	45	515	15-004-106	0.813	
07	M20x2.50	22	170	55	515	15-339-343	1.270	
08	M24x3.00	25	180	65	654	15-339-139	2.320	
09	M24x3.00	25	180	70	709	15-339-139	2.528	
10	M30x3.50	32	200	80	805	15-339-140	4.470	
11	M36x4.00	36	210	95	776	15-339-280	6.200	
12	M48x5.00	48	260	120	844	15-339-142	12.000	
13	M56x4.00	56	270	145	990	15-339-143	19.140	
14	M68x4.00	68	320	175	1367	15-339-144	39.000	
15	M85x4.00	85	396	210	1526	15-339-134	68.000	

**MATERIAL:**

FOR VAR.NO. 01 TO 06 - ~~IS 226~~ IS 2062 Fe 410 WA.

FOR VAR.NO. 07 TO 15 - SA105

**NOTES:**

01. MATL.EQUIVALENT: IS 1875 CL.3 (OR) IS 961 Fe540 WHT (OR) BS 970 080 M40.

02. THIS COMPONENT SHALL BE ELECTRO-GALVANIZED TO A DEPTH OF 15 μM. AND THREADED PORTIONS SHALL BE YELLOW CHROMATISED.

03. "IS.1875 CL2" IS ALSO ACCEPTABLE IN PLACE OF "SA105".

CAUTION THE INFORMATION ON THIS DOCUMENT IS THE PROPERTY OF BHARAT HEAVY ELECTRICALS LTD. IT MUST NOT BE USED DIRECTLY OR INDIRECTLY IN ANY WAY DETRIMENTAL TO THE INTEREST OF THE COMPANY.

TYPE OF PRODUCT OR NAME OF CUSTOMER /PROJECT		STANDARD				
	Bharat Heavy Electricals Ltd.,		DRN	PS. VEL.	DATE	No. OF VAR.
	PIPING CENTRE		CHD.	M.M.MANI.	11.10.88	
	MADRAS 600 017		APPD.	J. JUDE.	14X88	
DEPT.	GRADE OF UNTOL. DIM.	SCALE	WEIGHT (Kg)	REF. TO ASSY./OLD DRG.		ITEM No.
CODE	C/M/F	NTS				
TITLE			CARD CODE	DRAWING No.		REV.
BOTTOM TIE ROD (TYPE: SA 80)			U 01	3-80-999-99186.		02

REV	DATE	ALTD:	REV	DATE	ALTERED	REV	DATE	ALTERED
03	01/06/88	APPD:	02	15-11-1999	APPROVED	01	19/6/89	CHECKED
NOTE-03 ADDED.			FOR VAR.NO. 01 TO 06 MATL ALTD FROM IS 226 TO IS 2062 Fe410-WA.			FOR VAR.NO. 09 DIMENSION 'L' ALTERED FROM 681 TO 709; WEIGHT ALTERED FROM 2.420 TO 2.528 Kg.		
			* IN NOTE NO. 01 MATL BS 970 EN 8 CHANGED TO BS 970 080 M40.					






FIRST ANGLE PROJECTION (ALL DIMENSIONS IN MILLIMETRES)

06166-666-08-E

DRAWING NO.

VAR NO.	Md	A	B	C	L	MATL CODE	WEIGHT (Kg)	REMARKS
01	M12x1.75	12	140	35	495	15-004-030	0.440	
02	M12x1.75	12	140	35	485	15-004-030	0.430	
03	M12x1.75	12	140	35	679	15-004-030	0.600	
04	M12x1.75	12	140	35	712	15-004-030	0.630	
05	M16x2.00	16	160	45	781	15-004-106	1.230	
06	M16x2.00	16	160	45	774	15-004-106	1.220	
07	M20x2.50	22	170	55	774	15-339-343	1.910	
08	M24x3.00	25	180	65	1000	15-339-139	3.550	
09	M24x3.00	25	180	70	1112	15-339-139	3.966	
10	M30x3.50	32	200	80	1228	15-339-140	6.810	
11	M36x4.00	36	210	95	1170	15-339-280	9.350	
12	M48x5.00	48	260	120	1278	15-339-142	18.150	
13	M56x4.00	56	270	145	1517	15-339-143	29.330	
14	M68x4.00	68	320	175	2236	15-339-144	83.800	
15	M85x4.00	85	396	210	2548	15-339-134	113.500	

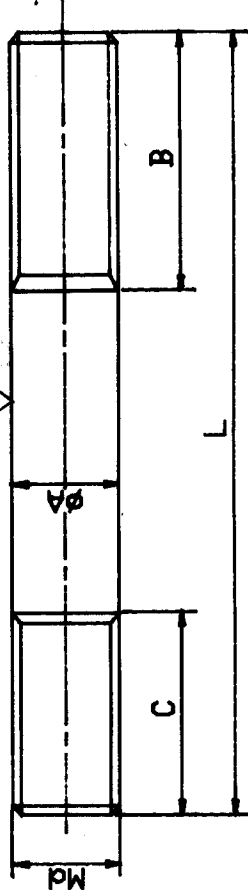

MATERIAL:  
 FOR VAR. NO. 01 TO 06 - ~~IS 2062~~ IS 2062 Fe 410WA.  
 FOR VAR. NO. 07 TO 15 - SA105

NOTES: 01. MATL. EQUIVALENT: IS 1875 CL.3 OR IS 961 Fe 540 WHT OR BS 970 080 M40.

02. THIS COMPONENT SHALL BE ELECTRO-GALVANIZED TO A DEPTH OF 15 μm AND THREADED PORTIONS SHALL BE YELLOW CHROMATISED.

03. "IS.1875CL2" IS ALSO ACCEPTABLE IN PLACE OF "SA105".

ITEM No.	DESCRIPTION	DRAWING No.	ITEM No.	MATL CODE	UNIT. WT.	QTY.
01						
02						
03						
STANDARD

TYPE OF PRODUCT OR NAME OF CUSTOMER/ PROJECT



Bharat Heavy Electricals Ltd.,  
 BOILER PLANT UNIT  
 TIRUCHIRAPALLI 620 014

DEPT



SCALE  
 NTS

WEIGHT (kg)

REF. TO ASSY/ OLD DRG.

ITEM No.

TITLE

BOTTOM TIE ROD  
 (TYPE: SA-160)

CARD CODE

DRAWING No.

3-80-999-99190.

REV.

03

REV	DATE	ALTERED	REV	DATE	ALTERED
02	15-11-1999	APPROVED	01	19/6/89	CHECKED
03	15/10/88	APPROVED			

NOTE: 03 ADDED.  
 FOR VAR. NOS 01 TO 06 MATL ALTERED FROM IS 226 TO IS 2062 Fe 410 WA.  
 IN NOTE NO. 01 MATL BS 970 EN 8 CHANGED TO BS 970 080 M 40.


CAUTION THE INFORMATION OF THIS DOCUMENT IS THE PROPERTY OF BHARAT HEAVY ELECTRICALS LTD. IT MUST NOT BE USED DIRECTLY OR INDIRECTLY IN ANY WAY DETRIMENTAL TO THE INTEREST OF THE COMPANY.

**CAUTION** THE INFORMATION OF THIS DOCUMENT IS THE PROPERTY OF BHARAT HEAVY ELECTRICALS LTD. IT MUST NOT BE USED DIRECTLY OR INDIRECTLY IN ANY WAY DETRIMENTAL TO THE INTEREST OF THE COMPANY.

26166 - 666 - 08 - E

ON DRAWING

THIS SURFACE TO BE KNURLED PARALLELLY

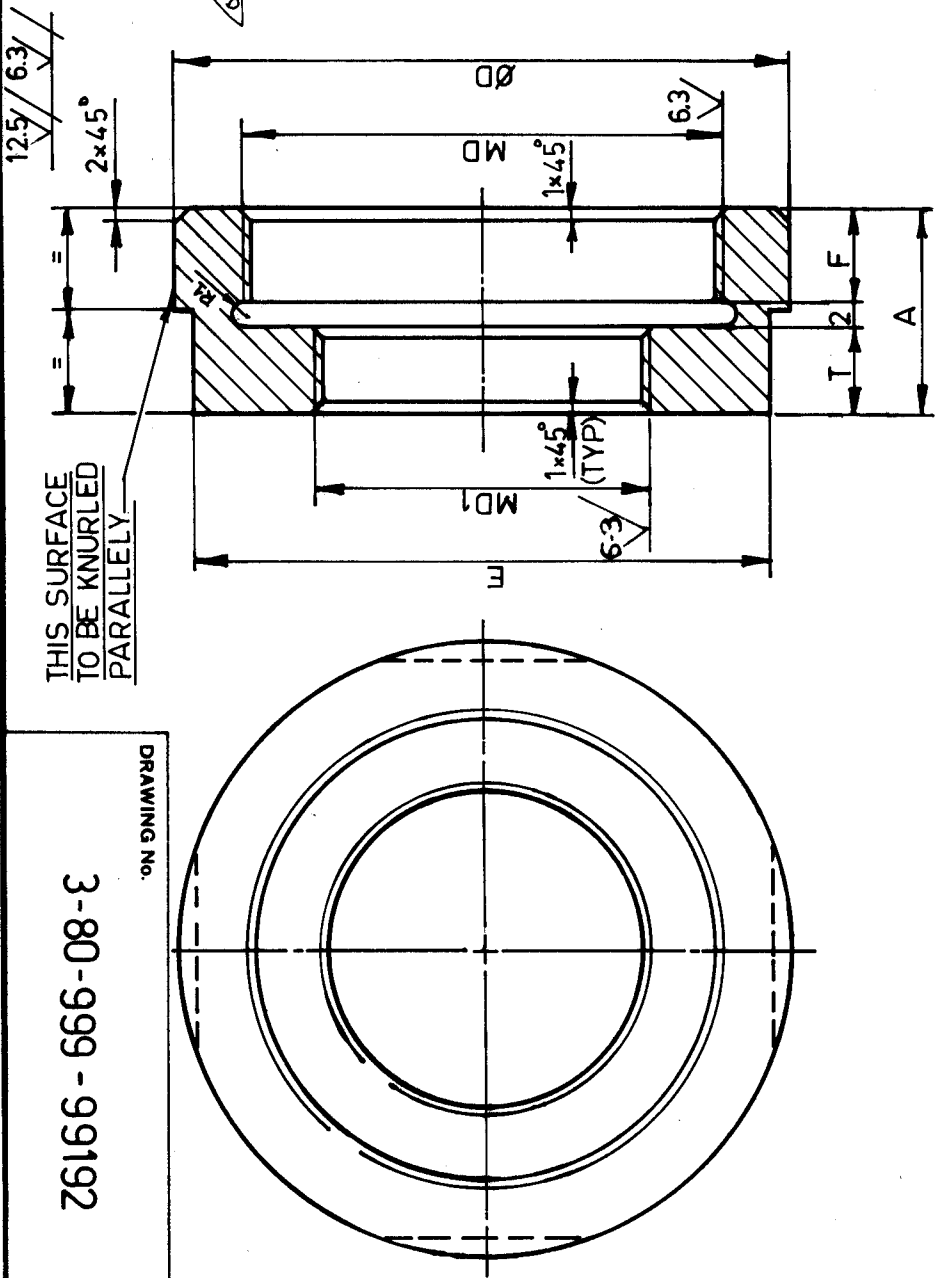

FIRST ANGLE PROJECTION (ALL DIMENSIONS IN MILLIMETRES)

NOTES:

- 01. MATL. EQUIVALENT: IS 1875 CL 3 (OR) IS 961 Fe 540. WHT (OR) BS:970 080 M40
- 02. THIS COMPONENT SHALL BE ELECTRO-GALVANIZED TO A DEPTH OF 15 UM AND THREADED PORTIONS SHALL BE YELLOW CHROMATISED.
- 03. THREAD MATCHING SHALL BE DONE AFTER GALVANISING.
- 04. "IS:1875CL2" IS ALSO ACCEPTABLE IN PLACE OF "SA105".

ITEM No.	DESCRIPTION	DRAWING No.	ITEM No. VAR. No.	MATL. CODE	MATL. SPEC.	UNIT. WT.	QTY.
15							
14							
13	ROUND $\phi$ 155	3-80-999-99192.		15 339 282	SA 105	5.370	
12	ROUND $\phi$ 136			15 339 282	SA 105	3.150	
11	ROUND $\phi$ 110			15 339 281	SA 105	1.440	
10	ROUND $\phi$ 90			15 339 134	SA 105	0.870	
08 & 09	ROUND $\phi$ 80			15 339 134	SA 105	0.650	
07	ROUND $\phi$ 70			15 339 144	SA 105	0.310	
05 & 06	ROUND $\phi$ 60			15 339 143	SA 105	0.220	
01 & 04	ROUND $\phi$ 50			15 339 143	SA 105	0.150	

STANDARD

TYPE OF PRODUCT OR NAME OF CUSTOMER/ PROJECT



Bharat Heavy Electricals Ltd.,  
BOILER PLANT UNIT  
TIRUCHIRAPALLI 620 014

DRN. P.S.VEL  
CHD. M.M. MANI  
APPD. J.JUDE.


SIGN. *[Signature]*  
DATE 20.11.88

No. OF VAR. 26/11 26/188

REV	DATE	ALTERED	CHECKED	REV	DATE	ALTERED	CHECKED
02	01/11/99			01	7/6/94		
03	07/03/07	APPROVED: <i>[Signature]</i>					

NOTE - 04 ADDED.

FOR VAR. TO MD AND FOR VAR. 12 MD1 ALTD FROM M75X1.5 TO M75X2.

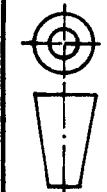

SCALE NTS

WEIGHT (KG)

REF. TO ASSY/ OLD DRG.

ITEM No.

TITLE

HYDRAULIC LOCK NUT

CARD CODE U 01

DRAWING No.


3-80-999 - 99192

REV. 03

FIRST ANGLE PROJECTION (ALL DIMENSIONS IN MILLIMETRES)

76166-666-08-E

DRAWING NO.

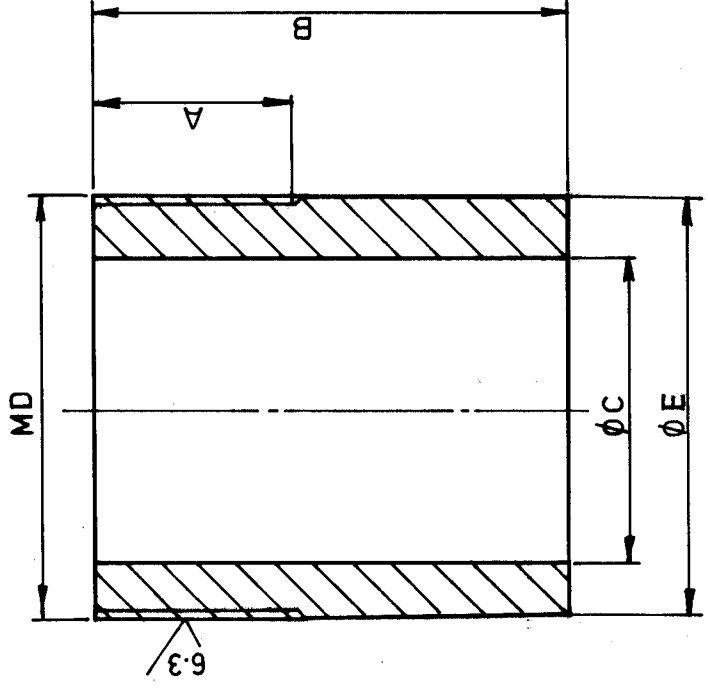

NOTES:

- 01. MATERIAL EQUIVALENT: IS 961 Fe540 WHT.
- ~~02. ALL COMPONENTS SHALL BE ELECTRO GALVANIZED TO A DEPTH OF 15 UM, AND~~
- ~~03. REBARED PORTIONS SHALL BE YELLOW CHROMIUMS.~~
- ~~04. GALVANIZING SHALL BE DONE AFTER GALVANIZING.~~
- 04. IS.1875 CL2 IS ALSO ACCEPTABLE IN PLACE OF SA105

VAR. NO.	A	B	ØC	MD	ØE	REMARKS
01 TO 04	25	100	30	M42 x1.5	42	
05 & 06	30	100	41	M50 x1.5	50	
07	35	100	51	M58 x1.5	58	
08 & 09	40	100	56	M64 x1.5	64	
10	45	100	63	M75 x2	75	
11	50	100	76	M90 x2.0	90	
12	55	100	91	M110 x2.0	110	
13	60	116	105	M125 x2.0	125	
14						
15						

ITEM No.	DESCRIPTION	DRAWING No.	ITEM No. / VAR. No.	MATL. CODE	MATL. SPEC.	UNIT. WT.	QTY.
15	ROUND Ø						
14	ROUND Ø						
13	ROUND Ø 125	3-80-999-99194.		15 339 281	SA105	2.830	
12	ROUND Ø 110			15 339 281	SA105	2.350	
11	ROUND Ø 90			15 339 134	SA105	1.430	
10	ROUND Ø 75			15 339 144	SA105	1.020	
08 & 09	ROUND Ø 64			15 339 144	SA105	0.592	
07	ROUND Ø 58			15 339 143	SA105	0.470	
05 & 06	ROUND Ø 50			15 339 143	SA105	0.505	
01 TO 04	ROUND Ø 42			15 339 142	SA105	0.533	

STANDARD

TYPE OF PRODUCT OR NAME OF CUSTOMER/ PROJECT: **Bharat Heavy Electricals Ltd., BOILER PLANT UNIT TIRUCHIRAPALLI 620 014**

DEPT: **BEHE** GRADE OF UNTOOL. DIM. C/M/F: **NTS.** SCALE: **NTS.** WEIGHT (kg): **REF. TO ASSY/OLD DRG.**

DRN. PS. VEL. **M.M.MANI.** NAME **J. JUDE.** SIGN. **J. JUDE.** DATE **12.11.88.** No. OF VAR. **26/11**

CHD. APPD. **J. JUDE.** ITEM No. **8**

CARD CODE **U 01** DRAWING No. **3-80-999-99194.** REV. **03**

TITLE: **BOTTOM SOCKET (TYPE. 55-80)**

REV	DATE	ALTERED BY	APPROVED BY
01	18/2/84	<i>[Signature]</i>	<i>[Signature]</i>
02	7/6/94	<i>[Signature]</i>	<i>[Signature]</i>

NOTE: 04 ADDED.

NOTE: 02 & 03 DELETED.

FOR VAR 10, THREAD SIZE ALTD FROM M75x1.5 TO M75x2.


CAUTION THE INFORMATION OF THIS DOCUMENT IS THE PROPERTY OF BHARAT HEAVY ELECTRICALS LTD. IT MUST NOT BE USED DIRECTLY OR INDIRECTLY IN ANY WAY DETRIMENTAL TO THE INTEREST OF THE COMPANY.

FIRST ANGLE PROJECTION (ALL DIMENSIONS IN MILLIMETRES)

56166-666-08-E

DRAWING NO.

12.5

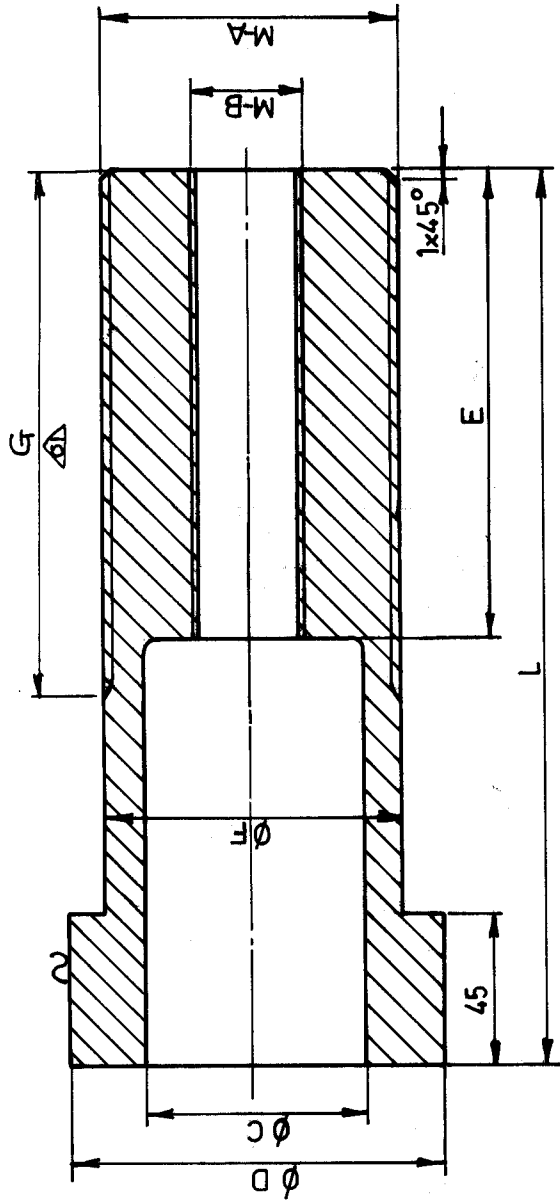

VAR. NO.	MA	MB	MC	MD	ME	MF	L	G	REMARKS.
01 TO 03	M20 x 1.5	M12 x 1.75	12.5	25	50	20	260	120	
04	M20 x 1.5	M12 x 1.75	12.5	25	50	20	265	120	
05 & 06	M30 x 1.5	M16 x 2.0	17	36	50	30	265	120	
07	M36 x 1.5	M20 x 2.5	22	40	50	36	265	120	
08	M42 x 1.5	M24 x 3.0	25	50	50	42	275	150	
09	M42 x 1.5	M24 x 3.0	25	50	50	42	280	150	
10	M50 x 1.5	M30 x 3.5	33	63	50	50	285	150	
11	M58 x 1.5	M36 x 4.0	39	63	60	58	290	160	
12	M75 x 2	M48 x 5.0	51	80	60	75	305	180	
13	M90 x 2.0	M56 x 4.0	59	100	70	90	335	200	
14									
15									

NOTES:-  
 01. MATERIAL EQUIVALENT: IS 961 Fe 540 WHT.  
 02. THIS COMPONENT SHALL BE ELECTRO GALVANIZED TO A DEPTH OF 15 μm. AND THREADED PORTIONS SHALL BE YELLOW CHROMATISED.  
 03. THREAD MATCHING SHALL BE DONE AFTER GALVANISING.  
 04. "IS 1875 CL 2" IS ALSO ACCEPTABLE IN PLACE OF "SA 105".

ITEM No.	DESCRIPTION	DRAWING No.	ITEM No. VAR. No.	MATL. CODE	MATL. SPEC.	UNIT. WT.	QTY.
15	ROUND φ						
14	ROUND φ						
13	ROUND φ 100	3-80-999-99195.		15 339 134	SA 105		10 465
12	ROUND φ 80			15 339 144	SA 105		6 011
11	ROUND φ 63			15 339 143	SA 105		3 547
10	ROUND φ 63			15 339 143	SA 105		2 946
09	ROUND φ 50			15 339 142	SA 105		2 038
08	ROUND φ 50			15 339 142	SA 105		2 006
07	ROUND φ 40			15 339 141	SA 105		1 377
05 & 06	ROUND φ 36			15 339 280	SA 105		1 023
04	ROUND φ 25			15 339 139	SA 105		0 373
01 TO 03	ROUND φ 25			15 339 139	SA 105		0 355

TYPE OF PRODUCT OR NAME OF CUSTOMER/ PROJECT  
**STANDARD**

	Bharat Heavy Electricals Ltd., BOILER PLANT UNIT TIRUCHIRAPALLI 620 014		NAME P.S. VEL.	SIGN 	DATE 25.11.88.	No. OF VAR.
	DRN. CHD.	APPD. J. JUDE.	REF. TO ASSY/ OLD DRG.	WEIGHT (kg)	SCALE NTS.	ITEM No.
	DEPT.	GRADE OF UNTO. DIM. C/M/F	DEPT.	SCALE	NTS.	ITEM No.

TITLE  
**SPINDLE PIPE.**  
 (TYPE: SS-80)

CARD CODE  
 U 01

DRAWING No.  
 3-80-999-99195.

REV.  
 03




REV	DATE	ALTERED	REV	DATE	ALTERED
02	7/6/94	FOR VAR. 12, THREAD SIZE MA' ALTD FROM M12x1.5 TO M12x2	01	28/12/89	CHECKED
03	07/03/07	ALTERED: APPROVED:			
NOTE	04	ADDED.			

CAUTION THE INFORMATION OF THIS DOCUMENT IS THE PROPERTY OF BHARAT HEAVY ELECTRICALS LTD. IT MUST NOT BE USED DIRECTLY OR INDIRECTLY IN ANY WAY DETRIMENTAL TO THE INTEREST OF THE COMPANY.

00266-666-08-E

ON DRAWING

VAR.No	Md x PITCH	φA	B	C	WT (kg)	MATL CODE
01 TO 04	M 12 x 1.75	22	19	6	0.012	15 339 343
05 & 06	M 16 x 2.00	32	24	8	0.036	15 339 140
07	M 20 x 2.50	36	30	10	0.064	15 339 280
08 & 09	M 24 x 3.00	40	36	12	0.071	15 339 141
10	M 30 x 3.50	50	46	15	0.147	15 339 142
11	M 36 x 4.00	63	55	18	0.295	15 339 143
12	M 48 x 5.00	80	70	24	0.600	15 339 144
13	M 56 x 4.00	100	85	28	1.180	15 339 134

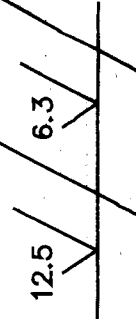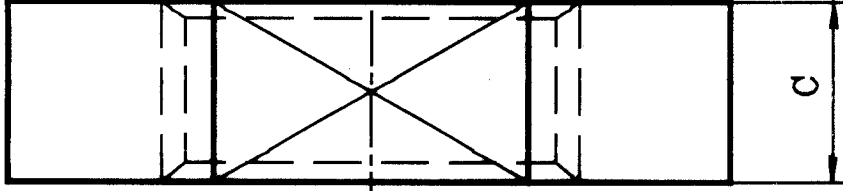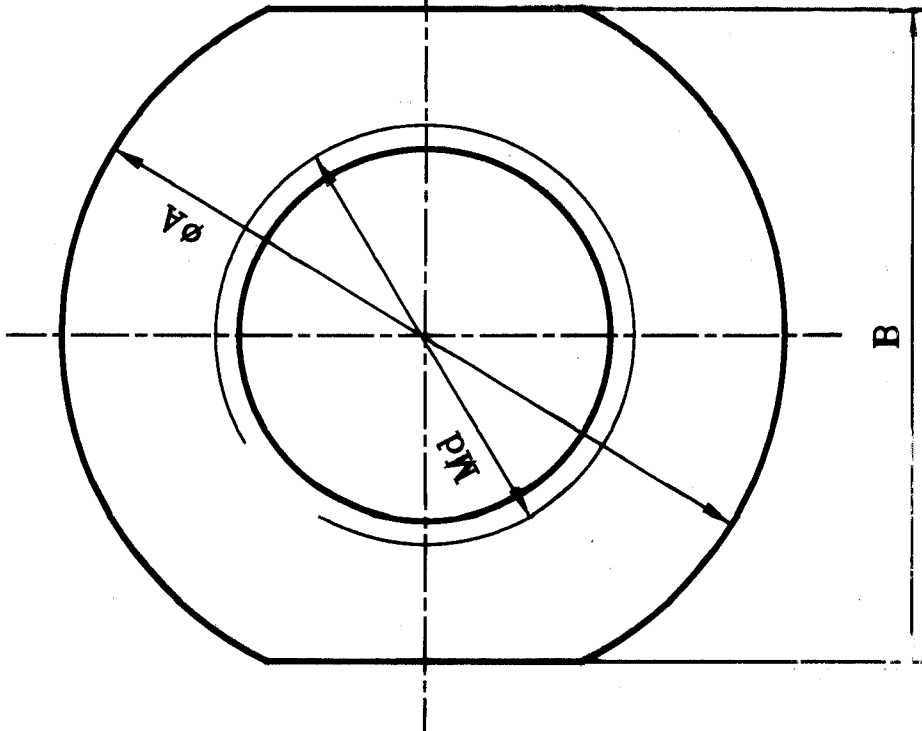

**NOTES: -**

- EQUIVALENT MATERIAL IS: 1875 CLIV (OR) BS.970 709 M40.
- THE COMPONENT SHALL BE GALVANISED TO A DEPTH OF 15 μm AND THREAD MATCHING SHALL BE DONE AFTER GALVANISING.
- THREAD TOLERANCE AS PER 6H OF IS:4218.
- 1:5.1875 CL2" IS ALSO ACCEPTABLE IN PLACE OF "SA105".

MATERIAL SA105

**STANDARD**

TYPE OF PRODUCT OR NAME OF CUSTOMER/PROJECT


	BHARAT HEAVY ELECTRICALS LTD., PIPING CENTRE, CHENNAI 600 017			NAME R. SURESHKANNAN	SIGN --Sd--	DATE 28/10/99	NO OF ITEMS
	DESK M.M. NAME	SIGN --Sd--	DATE 28/10/99	NAME S. S. SIVANANDAN	SIGN --Sd--	DATE 28/10/99	NO OF ITEMS
	APPD J. JUDIE	SIGN --Sd--	DATE 28/10/99	NAME S. S. SIVANANDAN	SIGN --Sd--	DATE 28/10/99	NO OF ITEMS
DEPT. CODE	GRADE OF UN TOL. DIM C/M/F	SCALE N.T.S	WEIGHT (KG) ---	INCH ---	DATE 28/10/99	NO OF ITEMS	ITEM No.
TITLE LOCK NUT	CLASS CODE U 01	DRAWING No. 3-80-999-99200 02	REV 01	DATE 03.12.99	APPROVED [Signature]	REV 01	DATE 03.12.99
ZONE NOTE-4 ADDED.	ZONE In Note No: -01 Matl. 'BS970- -EN19' Changed to 'BS970 -709 M40.'	ZONE NOTE-4 ADDED.	ZONE NOTE-4 ADDED.	ZONE NOTE-4 ADDED.	ZONE NOTE-4 ADDED.	ZONE NOTE-4 ADDED.	ZONE NOTE-4 ADDED.

CAUTION THE INFORMATION ON THIS DOCUMENT IS THE PROPERTY OF BHARAT HEAVY ELECTRICALS LIMITED. IT MUST NOT BE USED DIRECTLY OR INDIRECTLY IN ANY WAY DETRIMENTAL TO THE INTEREST OF THE COMPANY

FIRST ANGLE PROJECTION (ALL DIMENSIONS IN MILLIMETRES)

10266-666-08-E

DRAWING NO.

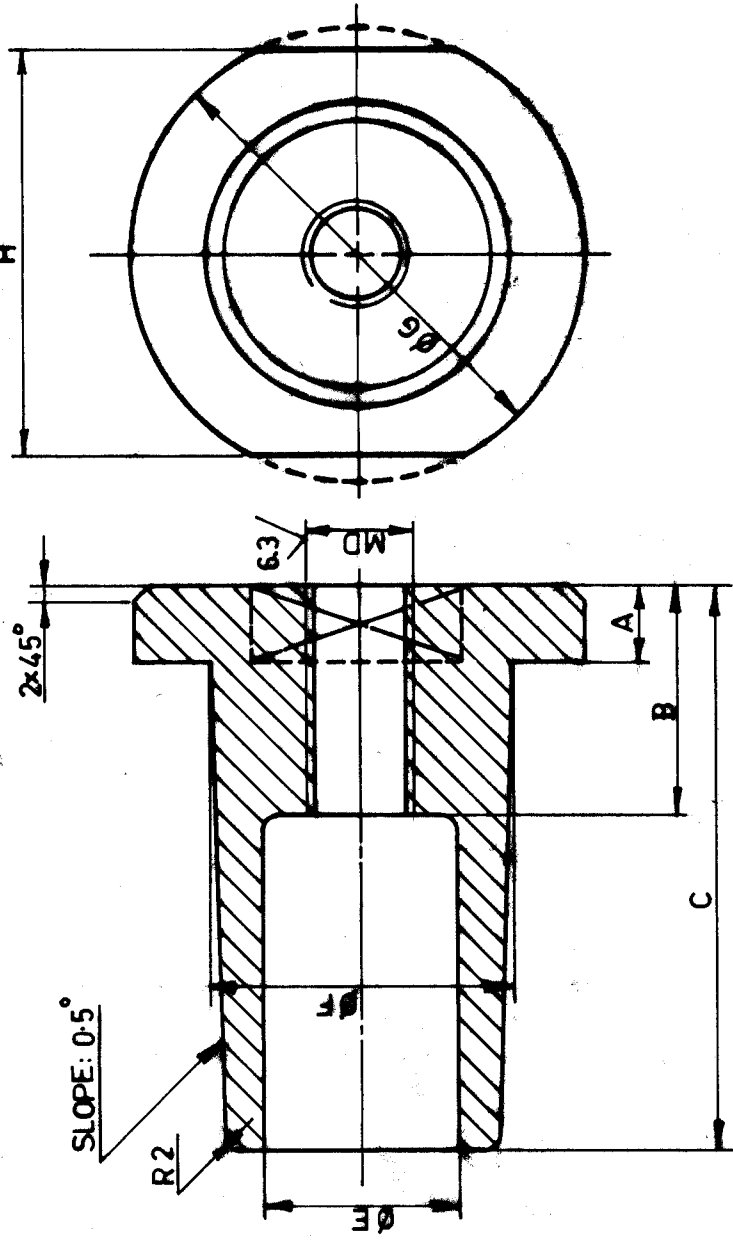

- NOTES:-
01. MATERIAL EQUIVALENT: IS 1875 CL.3 (OR) IS 961 Fe 540WH(OOR) BS: 970 080 M40
  02. THIS COMPONENT SHALL BE ELECTRO-GALVANIZED TO A DEPTH OF 15 μ.M. AND THREADED PORTIONS SHALL BE YELLOW CHROMATISED.
  03. THREAD MATCHING SHALL BE DONE AFTER GALVANISING.
  04. "IS.1875 CL2" IS ALSO ACCEPTABLE IN PLACE OF "SA105".

VAR. NO.	A	B	C	MD	φE	φF	φG	H	REMARKS
01 TO 04	10	15	200	M20x1.5	22	28	36	37	
05 & 06	10	20	200	M30x1.5	32	40	48	41	
07	10	20	200	M36x1.5	38	50	54	50	
08 & 09	15	25	205	M42x1.5	44	55	60	55	
10	20	30	210	M50x1.5	52	62	70	65	
11	20	30	210	M58x1.5	60	75	89	80	
12	30	45	220	M75x2	77	90	103	95	
13	40	60	230	M90x2.0	92	104	116	110	
14									
15									

REV	DATE	ALTERED	CHECKED	REVISION
02	01/11/93	ALTERED	CHECKED	
01	7/6/97	ALTERED	CHECKED	

1st Note No.-01 MATL. BS 970 EN8  
Changed to BS 970 080 M40

FOR VAR. 12, THREAD SIZE ALTD FROM M15x1.5 TO M15x2.

REV	DATE	ALTERED	CHECKED	REVISION
01	7/6/97	ALTERED	CHECKED	
02	01/11/93	ALTERED	CHECKED	

ITEM No.	DESCRIPTION	DRAWING No.	ITEM No.	VAR. No.	MATL. CODE	MATL. SPEC.	UNIT. WT.	QTY.
15	ROUND φ							
14	ROUND φ							
13	ROUND φ 118	3-80-999-99201			15 339 281	C	7.770	
12	ROUND φ 103				15 339 281	C	6.350	
11	ROUND φ 85				15 339 134	C	4.690	
10	ROUND φ 70				15 339 144	C	2.840	
08 & 09	ROUND φ 60				15 339 143	C	2.100	
07	ROUND φ 54				15 339 143	C	1.810	
05 & 06	ROUND φ 46				15 339 142	C	1.340	
01 TO 04	ROUND φ 36				15 339 141	C	0.990	



TYPE OF PRODUCT OR NAME OF CUSTOMER/ PROJECT

STANDARD

DEPT	GRADE OF UNTOL DIM C/M/F	SCALE	WEIGHT (kg)	REF. TO ASSY/ OLD DRWG.	ITEM No.
		MIS			
		Bharat Heavy Electricals Ltd., BOILER PLANT UNIT THIRUCHIRAPALLI 620014		NAME P.S. VEL. M.M. MANI. J. JUDE.	SIGN DATE 09-11-88
TITLE			CARD CODE	DRAWING No.	REV.
CENTERING NUT (TYPE SS-760)			U 01	3-80-999-99201	03

20266-666-08-E

ON DRAWING

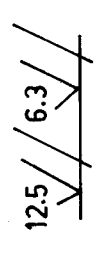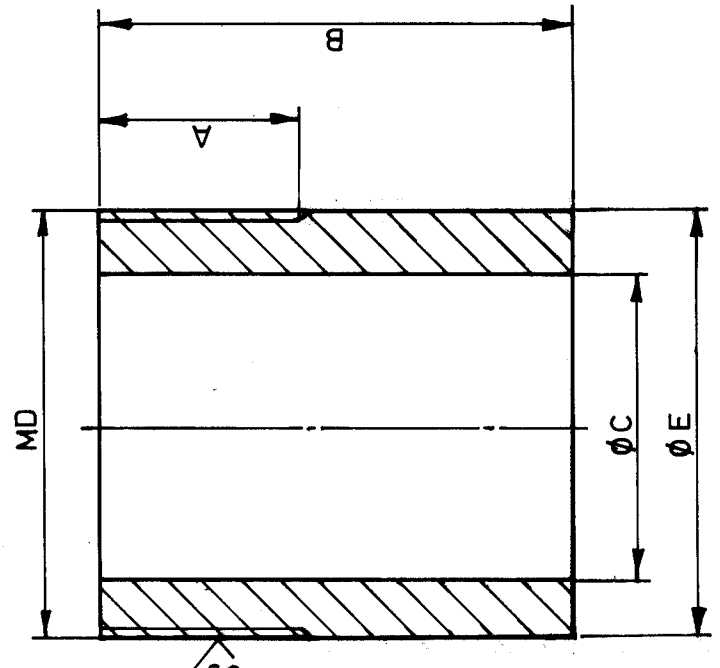

NOTES:  
 01. MATERIAL EQUIVALENT: IS 961 Fe 540 WHT.  
 02. THIS COMPONENT SHALL BE ELECTRO GALVANIZED TO A DEPTH OF 15 MICRONS.  
 03. REAR END MATCHING SHALL BE DONE AFTER GALVANIZING.  
 04. "IS:1875 CL2" IS ALSO ACCEPTABLE IN PLACE OF "SA105".

VAR. NO.	A	B	C	D	E	F	G	H	I	J	K	L	M	N	O	P	REMARKS
01 TO 04	25	190	30	M42 x 1.5	42												
05 & 06	30	190	41	M50 x 1.5	50												
07	35	190	51	M58 x 1.5	58												
08 & 09	40	190	56	M64 x 1.5	64												
10	45	190	63	M75 x 2	75												
11	50	190	76	M90 x 2.0	90												
12	55	190	91	M110 x 2.0	110												
13	60	190	105	M125 x 2.0	125												
14																	
15																	

REV	DATE	ALTERED BY	REMARKS
01	18/2/14	APPROVED: [Signature]	
02	7/6/14	APPROVED: [Signature]	FOR VAR 10, THREADED SIZE ALTD FROM MTSX15 TO MTSX2.
03			

DEPT	GRADE OF UNTOOL DIM. C/M/F	SCALE	WEIGHT (KG)	REF. TO ASSY/ OLD DRG.
		NTS.		

TYPE OF PRODUCT OR NAME OF CUSTOMER/ PROJECT  
**STANDARD**  
 Bharat Heavy Electricals Ltd.,  
 BOILER PLANT UNIT  
 TIRUCHIRAPALLI 620 014

ITEM No.	DESCRIPTION	DRAWING No.	ITEM No. VAR. No.	MATL. CODE	MATL. SPEC.	UNIT. WT.	QTY.
15	ROUND $\phi$						
14	ROUND $\phi$						
13	ROUND $\phi$ 125	3-80-999-99202.		15 339 281 SA105	C	4.630	
12	ROUND $\phi$ 110			15 339 281 SA105	C	4.465	
11	ROUND $\phi$ 90			15 339 134 SA105	C	2.717	
10	ROUND $\phi$ 75			15 339 144 SA105	C	1.938	
08 & 09	ROUND $\phi$ 64			15 339 144 SA105	C	1.124	
07	ROUND $\phi$ 58			15 339 143 SA105	C	0.893	
05 & 06	ROUND $\phi$ 50			15 339 143 SA105	C	0.956	
01 TO 04	ROUND $\phi$ 42			15 339 142 SA105	C	1.010	

TITLE  
**BOTTOM SOCKET**  
 (TYPE: SS160)

CARD CODE  
 U 01

DRAWING No.  
 3-80-999-99202.

REV. 03


CAUTION THE INFORMATION OF THIS DOCUMENT IS THE PROPERTY OF BHARAT HEAVY ELECTRICALS LTD. IT MUST NOT BE USED DIRECTLY OR INDIRECTLY IN ANY WAY DETRIMENTAL TO THE INTEREST OF THE COMPANY.

90266-666-08-E

12-5  
✓  
✓

NOTES

- 01. MATERIAL EQUIVALENT IS SA105 Fe 540 WHT
- 02. THIS COMPONENT SHALL BE ELECTRO GALVANIZED TO A DEPTH OF 15 μm AND THREADED PORTIONS SHALL BE YELLOW CHROMATISED.
- 03. THREAD MATCHING SHALL BE DONE AFTER GALVANISING.
- 04. "IS:1875CL2" IS ALSO ACCEPTABLE IN PLACE OF "SA105".

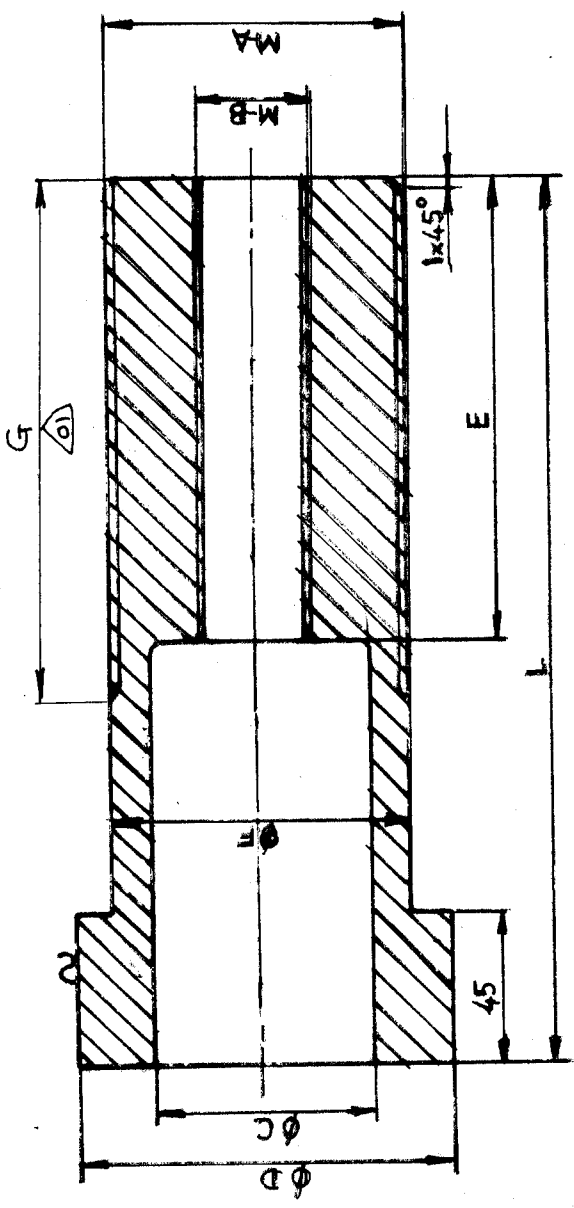

VAR. NO.	M/A	M/B	φC	φD	E	φF	L	G	REMARKS.
01 TO 03	M20x1.5	M12x1.75	12.5	25	50	20	450	240	
04	M20x1.5	M12x1.75	12.5	25	50	20	455	240	
05 & 06	M30x1.5	M16x2.0	17	36	50	30	455	240	
07	M36x1.5	M20x2.5	22	40	50	36	455	240	
08	M42x1.5	M24x3.0	25	50	50	42	465	290	
09	M42x1.5	M24x3.0	25	50	50	42	470	290	
10	M50x1.5	M30x3.5	33	63	50	50	475	300	
11	M50x1.5	M36x4.0	39	63	60	58	480	310	
12	M75x2	M48x5.0	51	80	60	75	495	320	
13	M90x2.0	M56x4.0	59	100	70	90	510	340	
14									
15									

15	14	13	12	11	10	09	08	07	05 & 06	04	01 TO 03	VAR. No.	DESCRIPTION	DRAWING No.	ITEM No.	VAR. No.	MATL. CODE	MATL. SPEC.	A	E	Z	UNIT. WT.	QTY.	
													ROUND φ											
													ROUND φ 100	3-80-999-99206			15 339 134	SA 105	C				15.495	
													ROUND φ 80				15 339 144	SA 105	C				9.572	
													ROUND φ 63				15 339 143	SA 105	C				5.721	
													ROUND φ 63				15 339 143	SA 105	C				4.635	
													ROUND φ 50				15 339 142	SA 105	C				3.268	
													ROUND φ 50				15 339 142	SA 105	C				3.236	
													ROUND φ 40				15 339 141	SA 105	C				2.283	
													ROUND φ 36				15 339 280	SA 105	C				1.665	
													ROUND φ 25				15 339 139	SA 105	C				0.583	
													ROUND φ 25				15 339 139	SA 105	C				0.566	

TYPE OF PRODUCT: STANDARD

OR NAME OF CUSTOMER/ PROJECT: Bharat Heavy Electricals Ltd, BOILER PLANT UNIT, TRUCHIRAPALLI 620 014

DEPT: [ ] GRADE OF UNITS, DIM: C/M/F [ ] SCALE: NTS. [ ] WEIGHT (kg): [ ] REF. TO ASSY/ OLD DRG. [ ]

DRN: P.S. VEL. NAME: M.M. MANI. DATE: 25.11.88. SIGN: [ ] NO. OF VAR.: [ ]

CHD: M.M. MANI. DATE: 26.11.88. SIGN: [ ] NO. OF VAR.: [ ]

APPD: J. JUDE. DATE: 26.11.88. SIGN: [ ] NO. OF VAR.: [ ]

TITLE: SPINDLE PIPE. (TYPE: SS-160)

DRAWING No. 3-80-999-99206

CARD CODE U 01

REV. 02


REV	DATE	ALTERED BY	APPROVED BY	REMARKS
01	28/12/88	[ ]	[ ]	CHECKED
02	7/6/94	[ ]	[ ]	FOR VAR 12 THREADED SIZE MAILED FROM MTSX-15 TO MTSX-2.
03	01/03/87	[ ]	[ ]	ALTERED FOR VAR-NDS. 01 TO 09.
04		[ ]	[ ]	INST. - 04. ADDED.

CAUTION: THE INFORMATION OF THIS DOCUMENT IS THE PROPERTY OF BHARAT HEAVY ELECTRICALS LTD. IT MUST NOT BE REPRODUCED DIRECTLY OR INDIRECTLY IN ANY MANNER WITHOUT THE WRITTEN PERMISSION OF THE COMPANY.

FIRST ANGLE PROJECTION (ALL DIMENSIONS IN MILLIMET)

REV 01	DATE 14.01.2000	ALTERED <i>[Signature]</i>	REV 02	DATE	ALTERED
		CHECKED <i>[Signature]</i>			CHECKED
MATERIAL CHANGED FROM BM 220 TO 'IS 2062 Fe410 WA'. NOTE-2 DELETED					

CAUTION! THIS INFORMATION ON THIS DOCUMENT IS THE PROPERTY OF BHARAT HEAVY ELECTRICALS LTD. IT MUST NOT BE USED DIRECTLY OR INDIRECTLY IN ANY WAY DETRIMENTAL TO THE INTEREST OF THE COMPANY

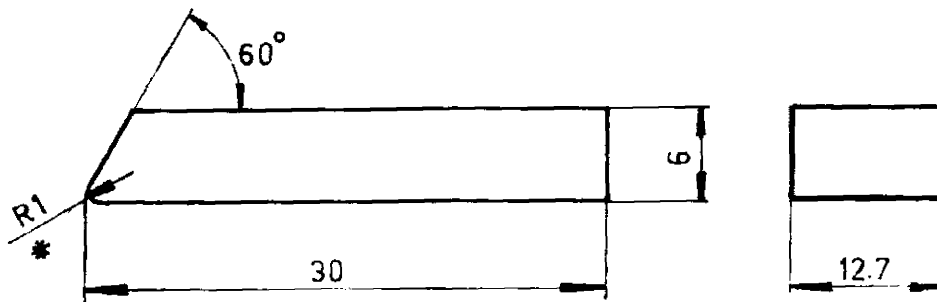

NOTE:-

- 1) \* RADIUS R1 TO BE PROVIDED BY HAND GRINDING. POINTER TIP TO BE COATED WITH BRIGHT RED OR ORANGE COLOUR FLUORESCENT PAINT.



- 2) ~~EQUIVALENT MATERIAL IS 226 OR IS 2062~~

VARIANT No.	DESCRIPTION	STD	15-008-283	A/C	UNIT	0.017
			IS 2062 Fe410WA			1
			MATL CODE			UNIT WT
			MATL SPEC			QTY.



**BHARAT HEAVY ELECTRICALS LTD.**  
BOILER PLANT UNIT  
TIRUCHIRAPALLI-620 014.

DRN.	NAME	SIGN	DATE
CHD.	M. Masilamani	<i>[Signature]</i>	18/6/88
APPD.	J. Jude.	<i>[Signature]</i>	210688

DEPT. CODE	GRADE OF TOL DIM C/M/F		SCALE	WEIGHT (Kg)	REF TO ASSY/OLD DRG	ITEM No.
			NTS	0.017		10
TITLE			CARD CODE	DRAWING No.	REV.	
POINTER			U 01	4-80-999-99047.	01	

SCOPE OF SUPPLY FOR VLH-SA-080 (WITHOUT SPRING)						ANNEXURE-VSA-080
SL.NO.	DESCRIPTION	DRG. NO.	QPA	TYPE	SPECN,	
1	HOUSING	3-80-999-99175	1	PIPE	IS-1239	TO BE SUPPLIED IN ASSEMBLED CONDITION
2	BOTTOM PLATE	3-80-999-99179	1	PLATE	IS2062	
3	TOP PLATE	3-80-999-99180	1	PLATE	IS2062	
4	TOP TIE ROD	3-80-999-99181	1	ROUND	IS2062	
5	BOTTOM SOCKET	2-80-999-99136	1	ROUND	SA105	
6	CENTERING NUT	2-80-999-99131	1	ROUND	SA105	
7	HYD. LOCK NUT	3-80-999-99153	1	ROUND	SA105	
8	SPRING PLATE	3-80-999-99182	1	PLATE	IS2062	
9	BEARING PLATE ASSLY.	3-80-999-99183	1			
9.1	BEARING PLATE	3-80-999-99185	1	PLATE	IS2062	
9.2	BUSH	3-80-999-99184	1		SA193 B7	
10	POINTER	4-80-999-99047	2	FLAT	IS2062	
14	INNER PIPE GUIDE	3-80-999-99154	1	PIPE	SA192	
15	TURN BUCKLE	2-80-999-99140	1			
15.1	TURN BUCKLE BODY	2-80-999-99139	1	PIPE	SA210 Gr. A1	
15.2	PLATE-1	3-80-999-99150	1	PLATE	SA105	
15.3	PLATE-2	3-80-999-99151	1	PLATE	SA105	
16	NUT	3-80-999-99152	1	ROUND	SA105	
17	SPLIT PIN	STANDARD	3			
18	BOTTOM TIE ROD	3-80-999-99186	1	ROUND	IS2062	
20	SPHERICAL WASHER	3-80-999-99187	1		SA193 B7	
21	COUPLING	3-80-999-99188	1	ROUND	SA105	
22	NUT	STANDARD	2			

NOTE- TOP PLATE IS TO BE TACK WELDED WITH HOUSING FOR EASY TRANSPORTATION AND AVOIDING MISPLACEMENT.

SCOPE OF SUPPLY FOR VLH-SA-160 (WITHOUT SPRING)						ANNEXURE-VSA-160
SL.NO.	DESCRIPTION	DRG. NO.	QPA	TYPE	SPECN,	
1	HOUSING	3-80-999-99176	1	PIPE	IS-1239	TO BE SUPPLIED IN ASSEMBLED CONDITION
2	BOTTOM PLATE	3-80-999-99179	1	PLATE	IS2062	
3	TOP PLATE	3-80-999-99180	1	PLATE	IS2062	
4	TOP TIE ROD	3-80-999-99189	1	ROUND	SA105	
5	BOTTOM SOCKET	2-80-999-99136	1	ROUND	SA105	
6	CENTERING NUT	2-80-999-99131	1	ROUND	SA105	
7	HYD. LOCK NUT	3-80-999-99153	1	ROUND	SA105	
8	SPRING PLATE	3-80-999-99182	1	PLATE	IS2062	
9	BEARING PLATE ASSLY.	3-80-999-99183	1	PLATE	IS2062	
9.1	BEARING PLATE	3-80-999-99185	1	PLATE	IS2062	
9.2	BUSH	3-80-999-99184	1		SA193 B7	
10	POINTER	4-80-999-99047	2	FLAT	IS2062	
14	INNER PIPE GUIDE	3-80-999-99154	1	PIPE	IS-1239	
15	TURN BUCKLE	2-80-999-99140	1			
15.1	TURN BUCKLE BODY	2-80-999-99139	1	PIPE	SA106 Gr. B	
15.2	PLATE-1	3-80-999-99150	1	PLATE	SA105	
15.3	PLATE-2	3-80-999-99151	1	PLATE	SA105	
16	NUT	3-80-999-99152	1	ROUND	SA105	
17	SPLIT PIN	STANDARD	3			
18	BOTTOM TIE ROD	3-80-999-99190	1	ROUND	SA105	
20	SPHERICAL WASHER	3-80-999-99187	1		SA193 B7	
21	COUPLING	3-80-999-99188	1	ROUND	SA105	
22	NUT	STANDARD	2			
23	MIDDLE PLATE ASSLY.	2-80-999-99129	1			
23.1	INNER PIPE GUIDE	3-80-999-99154	1	PIPE	SA192	
23.2	MIDDLE PLATE	3-80-999-99140	1	PLATE	IS2062	

NOTE- TOP PLATE IS TO BE TACK WELDED WITH HOUSING FOR EASY TRANSPORTATION AND AVOIDING MISPLACEMENT.

SCOPE OF SUPPLY FOR VLH-SAT-080 (WITHOUT SPRING)						ANNEXURE-VSAT-080
DRG. SL.NO.	DESCRIPTION	DRG. NO.	QPA	TYPE	SPECN,	
1	HOUSING	3-80-999-99175	1	PIPE	IS-1239	TO BE SUPPLIED IN ASSEMBLED CONDITION
2	BOTTOM PLATE	3-80-999-99179	1	PLATE	IS2062	
3	TOP PLATE	3-80-999-99180	1	PLATE	IS2062	
4	TOP TIE ROD	3-80-999-99181	1	ROUND	SA105	
5	BOTTOM SOCKET	2-80-999-99136	1	ROUND	SA105	
6	CENTERING NUT	2-80-999-99131	1	ROUND	SA105	
7	HYD. LOCK NUT	3-80-999-99153	1	ROUND	SA105	
8	SPRING PLATE	3-80-999-99182	1	PLATE	IS2062	
9	BEARING PLATE ASSLY.	3-80-999-99183	1	PLATE	IS2062	
9.1	BEARING PLATE	3-80-999-99185	1	PLATE	IS2062	
9.2	BUSH	3-80-999-99184	1		SA193 B7	
10	POINTER	4-80-999-99047	2	FLAT	IS2062	
14	INNER PIPE GUIDE	3-80-999-99154	1	PIPE	IS-1239	
15	TURN BUCKLE	2-12-000-01853	1			
15.1	TURN BUCKLE BODY	2-80-999-99139	1	PIPE	SA106 Gr. B	
15.2	PLATE-1	3-80-999-99150	1	PLATE	SA105	
15.3	PLATE-2	3-12-000-06295	1	PLATE	SA105	
16	NUT	3-80-999-99152	1	ROUND	SA105	
17	SPLIT PIN	STANDARD	3			
18	BOTTOM TIE ROD	3-12-000-06351	1	ROUND	SA105	
20	SPHERICAL WASHER	3-80-999-99187	1		SA193 B7	
21	COUPLING	3-80-999-99188	1	ROUND	SA105	
22	NUT	STANDARD	2			

NOTE- TOP PLATE IS TO BE TACK WELDED WITH HOUSING FOR EASY TRANSPORTATION AND AVOIDING MISPLACEMENT.

SCOPE OF SUPPLY FOR VLH-SAT-160 (WITHOUT SPRING)						ANNEXURE-VSAT-160
SL.NO.	DESCRIPTION	DRG. NO.	QPA	TYPE	SPECN,	
1	HOUSING	3-80-999-99176	1	PIPE	IS-1239	TO BE SUPPLIED IN ASSEMBLED CONDITION
2	BOTTOM PLATE	3-80-999-99179	1	PLATE	IS2062	
3	TOP PLATE	3-80-999-99180	1	PLATE	IS2062	
4	TOP TIE ROD	3-80-999-99189	1	ROUND	SA105	
5	BOTTOM SOCKET	2-80-999-99136	1	ROUND	SA105	
6	CENTERING NUT	2-80-999-99131	1	ROUND	SA105	
7	HYD. LOCK NUT	3-80-999-99153	1	ROUND	SA105	
8	SPRING PLATE	3-80-999-99182	1	PLATE	IS2062	
9	BEARING PLATE ASSLY.	3-80-999-99183	1	PLATE	IS2062	
9.1	BEARING PLATE	3-80-999-99185	1	PLATE	IS2062	
9.2	BUSH	3-80-999-99184	1		SA193 B7	
10	POINTER	4-80-999-99047	2	FLAT	IS2062	
14	INNER PIPE GUIDE	3-80-999-99154	1	PIPE	IS-1239	
15	TURN BUCKLE	2-12-000-01853	1			
15.1	TURN BUCKLE BODY	2-80-999-99139	1	PIPE	SA106 Gr. B	
15.2	PLATE-1	3-80-999-99150	1	PLATE	SA105	
15.3	PLATE-2	3-12-000-06295	1	PLATE	SA105	
16	NUT	3-80-999-99152	1	ROUND	SA105	
17	SPLIT PIN	STANDARD	3			
18	BOTTOM TIE ROD	3-12-000-06486	1	ROUND	SA105	
20	SPHERICAL WASHER	3-80-999-99187	1		SA193 B7	
21	COUPLING	3-80-999-99188	1	ROUND	SA105	
22	NUT	STANDARD	2			
23	MIDDLE PLATE ASSLY.	2-80-999-99129	1			
23.1	INNER PIPE GUIDE	3-80-999-99154	1	PIPE	SA192	
23.2	MIDDLE PLATE	3-80-999-99140	1	PLATE	IS2062	

NOTE- TOP PLATE IS TO BE TACK WELDED WITH HOUSING FOR EASY TRANSPORTATION AND AVOIDING MISPLACEMENT.

SCOPE OF SUPPLY FOR VLH-SH-080 (WITHOUT SPRING)

ANNEXURE-VSH-080


SL.NO.	DESCRIPTION	DRG. NO.	QPA	TYPE	SPECN,
1	HOUSING	3-80-999-99157	1	PIPE	IS-1239
2	TOP PLATE	2-80-999-99130	1	PLATE	IS2062
3	BOTTOM PLATE	2-80-999-99135	1	PLATE	IS2062
4	SPINDLE BOLT	2-80-999-99137	1	ROUND	SA105
5	BOTTOM SOCKET	2-80-999-99136	1	ROUND	SA105
6	CENTERING NUT	2-80-999-99131	1	ROUND	SA105
7	HYD. LOCK NUT	3-80-999-99153	1	ROUND	SA105
8	SPRING PLATE	2-80-999-99133	1	PLATE	IS2062
9	LUG PLATE	2-80-999-99138	1	PLATE	IS2062
10	POINTER	4-80-999-99047	2	FLAT	IS2062
14	INNER PIPE GUIDE	3-80-999-99154	1	PIPE	IS-1239
15	TURN BUCKLE	2-80-999-99140	1		
15.1	TURN BUCKLE BODY	2-80-999-99139	1	PIPE	SA106 Gr. B
15.2	PLATE-1	3-80-999-99150	1	PLATE	SA105
15.3	PLATE-2	3-80-999-99151	1	PLATE	SA105
16	NUT	3-80-999-99152	1	ROUND	SA105
17	SPLIT PIN	STANDARD	1		
18	HAMMER DRIVEN SCREW	STANDARD	8		

TO BE SUPPLIED IN  
ASSEMBLED CONDITION

NOTE- TOP PLATE IS TO BE TACK WELDED WITH HOUSING FOR EASY TRANSPORTATION AND AVOIDING MISPLACEMENT.

SCOPE OF SUPPLY FOR VLH-SH-11-160 (WITHOUT SPRING)						ANNEXURE-VSH-160
SL.NO.	DESCRIPTION	DRG. NO.	QPA	TYPE	SPECN,	
1	HOUSING	3-80-999-99149	1	PIPE	IS-1239	TO BE SUPPLIED IN ASSEMBLED CONDITION
2	TOP PLATE	2-80-999-99130	1	PLATE	IS2062	
3	BOTTOM PLATE	2-80-999-99135	1	PLATE	IS2062	
4	SPINDLE BOLT	2-80-999-99141	1	ROUND	SA105	
5	BOTTOM SOCKET	2-80-999-99136	1	ROUND	SA105	
6	CENTERING NUT	2-80-999-99131	1	ROUND	SA105	
7	HYD. LOCK NUT	3-80-999-99153	1	ROUND	SA105	
8	SPRING PLATE	2-80-999-99133	1	PLATE	IS2062	
9	LUG PLATE	2-80-999-99138	1	PLATE	IS2062	
10	POINTER	4-80-999-99047	2	FLAT	IS2062	
14	INNER PIPE GUIDE	3-80-999-99154	1	PIPE	IS-1239	
15	TURN BUCKLE	2-80-999-99140	1			
15.1	TURN BUCKLE BODY	2-80-999-99139	1	PIPE	SA106 Gr. B	
15.2	PLATE-1	3-80-999-99150	1	PLATE	SA105	
15.3	PLATE-2	3-80-999-99151	1	PLATE	SA105	
16	NUT	3-80-999-99152	1	ROUND	SA105	
17	SPLIT PIN	STANDARD	1			
18	MIDDLE PLATE ASSLY.	2-80-999-99129	1			
18.1	INNER PIPE GUIDE	3-80-999-99154	1	PIPE	SA192	
18.2	MIDDLE PLATE	3-80-999-99140	1	PLATE	IS2062	
19	HAMMER DRIVEN SCREW	STANDARD	8			

NOTE- TOP PLATE IS TO BE TACK WELDED WITH HOUSING FOR EASY TRANSPORTATION AND AVOIDING MISPLACEMENT.

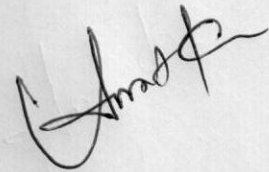

SCOPE OF SUPPLY FOR VLH-SS-080 (WITHOUT SPRING)					ANNEXURE-VSS-080
SL.NO.	DESCRIPTION	DRG. NO.	QPA	TYPE	SPECN,
1	HOUSING	3-80-999-99177	1	PIPE	IS-1239
2	BOTTOM PLATE	3-80-999-99198	1	PLATE	IS2062
3	TOP PLATE	3-80-999-99199	1	PLATE	IS2062
4	SPINDLE PIPE	3-80-999-99195	1	ROUND	SA105
5	BOTTOM SOCKET	3-80-999-99194	1	ROUND	SA105
6	CENTERING NUT	3-80-999-99193	1	ROUND	SA105
7	HYD. LOCK NUT	3-80-999-99192	1	ROUND	SA105
8	SPRING PLATE	3-80-999-99196	1	PLATE	IS2062
9	INNER PIPE GUIDE	3-80-999-99154	1	PIPE	SA192
10	POINTER	4-80-999-99047	2	FLAT	IS2062
15	ADJUSTMENT BOLT	3-80-999-99197	1	ROUND	SA193 B7
16	LOCK NUT	3-80-999-99200	1	ROUND	SA105
17	DISC	3-80-999-99174	1	ROUND	IS2062

TO BE SUPPLIED IN  
ASSEMBLED CONDITION

NOTE- TOP PLATE IS TO BE TACK WELDED WITH HOUSING FOR EASY TRANSPORTATION AND AVOIDING MISPLACEMENT.

SCOPE OF SUPPLY FOR VLH-SS-160 (WITHOUT SPRING)					ANNEXURE-VSS-160
SL.NO.	DESCRIPTION	DRG. NO.	QPA	TYPE	SPECN,
1	HOUSING	3-80-999-99178	1	PIPE	IS-1239
2	BOTTOM PLATE	3-80-999-99198	1	PLATE	IS2062
3	TOP PLATE	3-80-999-99199	1	PLATE	IS2062
4	SPINDLE PIPE	3-80-999-99206	1	ROUND	SA105
5	BOTTOM SOCKET	3-80-999-99202	1	ROUND	SA105
6	CENTERING NUT	3-80-999-99201	1	ROUND	SA105
7	HYD. LOCK NUT	3-80-999-99192	1	ROUND	SA105
8	SPRING PLATE	3-80-999-99196	1	PLATE	IS2062
9	INNER PIPE GUIDE	3-80-999-99154	1	PIPE	SA192
10	POINTER	4-80-999-99047	2	FLAT	IS2062
15	ADJUSTMENT BOLT	3-80-999-99197	1	ROUND	SA193 B7
16	LOCK NUT	3-80-999-99200	1	ROUND	SA105
17	DISC	3-80-999-99174	1	ROUND	IS2062
18	MIDDLE PLATE ASSLY.	2-80-999-99129	1		
18.1	INNER PIPE GUIDE	3-80-999-99154	1	PIPE	SA192
18.2	MIDDLE PLATE	3-80-999-99140	1	PLATE	IS2062

TO BE SUPPLIED IN  
ASSEMBLED CONDITION

NOTE- TOP PLATE IS TO BE TACK WELDED WITH HOUSING FOR EASY TRANSPORTATION AND AVOIDING MISPLACEMENT.



**PROCEDURE FOR MANUFACTURING OF CONSTANT & VARIABLE LOAD  
HANGERS (CLH/VLH) (LISEGA DESIGN)**

**Objective:** - This document covers the procedure to be followed for manufacturing of CLH & VLH.

The material normally used and their TDC nos. are given below :

Material Specification			TDC No.
Plates	:	IS 2062 Gr. A & B	TDC:0:301 Latest Revision
		SA 515/SA 516 Gr. 70	TDC:0:202 Latest Revision
		SA 387 Gr. 12 & 22	TDC:0:202 Latest Revision
Pipes	:	SA 106 Gr. B & C	TDC 0:101, 0:112 Latest Revision
Tubes	:	SA 210 Gr. A1 & C	TDC 0:102, 0:111 Latest Revision
Bars	:	SA 105	TDC 5:002 Latest Revision
		SA 193 B7	

1.0 Raw material procurement control including sub deliveries.

1.1 Raw material used shall conform to the relevant specification as given in the drawing and applicable TDC/PO. Any substitution of material shall be done only with prior approval of engineering through applicable document.

1.2 The raw material for the manufacturing of CLH & VLH shall be procured from BHEL approved vendors listed in BHEL PMD. List of approved Vendors shall be furnished with BHEL Tender enquiry and Purchase Order. **All the relevant test certificates / documents shall be original and in the name of raw material vendor.** Carbon steel material of thickness less than 20 mm can however be procured from traders if tested on random basis in NABL accredited labs for each melt or each lot identified by the tagging incoming material physically and correlating the same tag with the material receipt no. recorded in the day receipt register. The lab test report shall be enclosed with the copy of test certificates.

1.3 Ensure that the raw material procured as per the specification /TDC and shall have valid test certificates, indicating the mechanical/ chemical values and other test result as the case may be.

1.4 Raw material procured shall be free from visual defects like cracks, seams, laps, laminations, heavy pitting etc. when defects are noticed in visual inspection the same shall be confirmed using appropriate NDE technique and repaired using applicable approved process.

Rev no.-02	Ref. TRICHY QP NO. : QP:OS:01/01	Prepared Amit Kumar अमित कुमार / Amit Kumar उप प्रबन्धक (अभि० एवं वि० / Dy. Manager (E&M)) भारत हेवि इलेक्ट्रिकल्स लि० Bharat Heavy Electricals Ltd.	Approved S K Tiwari S K Tiwari 30/8/19	Date: 30-08-2019
------------	-------------------------------------	---	---	------------------



The detail of non-conformities shall be documented and analyzed for future improvement of process control.

1.5 Also ensure that the material are procured with the permitted dimensional tolerance of the material specification and / or TDC wherever required, the raw material shall be corrected prior to fabrication to achieve the required product tolerance.

### 1.6 TRACEABILITY OF RAW MATERIALS AT CLH/VLH MANUFACTURER'S WORKS

1.6.1 On receipt of the material, the practice of allotting day book no. shall be followed by hard stamping the day book no. material specification & heat no. on plates greater than 20 mm and stamping or stenciling day book no. and specification and heat no. on other material including plates of thickness less than 20 mm.

1.6.2 Raw material procured as stated under point 1.2 of note -1 shall be correlated to the mill test certificates, melt no. and specification and the confirmation shall be transferred to the job / identified by the inspector by stamping suitably on the materials.

1.6.3 This identification shall be properly documented in the register and maintained suitably for each process till completion of the final product.

1.6.4 The scanned copy of the daybook detail along with the TC and invoice as applicable shall be sent to BHEL/HERP/VARANASI for review. The material shall be further processed only on acceptance of the material by BHEL/HERP/VARANASI and physical verification by HERP QC or AIA.

1.6.5 Subsequent transfer by punching of daybook no., material specification & heat no. on plates of thickness greater than 20 mm and transfer by punching /stenciling of day book no. & specification on other material including plate of thickness less than 20 mm shall be meticulously followed during further cutting /processing & witnessing by HERP QC or AIA. The Stamp of HERP QC or AIA shall be put while transferring the details.

1.7 The requirement of material traceability shall be as indicated in the respective drawings.

Product attest "P" items indicated as in the drawings are traceable to the test certificates and identified with the material specification, grade and melt no. by stamping.

CERTIFIED item indicated as "C" in drawings are traceable to material specification / grade only and identified by stamping /engraving /stenciling /painting

### NOTE – 2.0 FOR FABRICATION OF VLH

#### 2.1 MARKING, CUTTING AND PREPARETION OF SCA & VLH

Rev no.-02	Ref. TRICHY QP NO. : QP:OS:01/01	Prepared Amit Kumar Dy. Manager (E&M)	Approved S K Tiwari	Date: 30-08-2019
------------	----------------------------------	---	------------------------	------------------



2.2 Raw material shall be marked and cut to size by shearing, machining, saw cutting, flame or plasma (for SS materials) cutting. Flame cut edges shall be dressed by grinding. Gas cutting notches shall be filled up after grinding the notches smoothly by welding using compatible electrodes and ground before taking up for further fabrication.

2.3 Edge preparation of bottom end cover shall be done by machining only. Top end cover and compression plates shall be match drilled.

2.4 Lug plates shall be perpendicular to the body. Bottom end cover shall be welded maintaining perpendicularity and concentricity of hole with tube diameter. The rods bolt shall be welded with compression plate. Side suspension rods shall be set perpendicular to the lug plate and parallel to axis of pipe.

2.5 Top end cover shall be set in position after assembling the spring and compression plate. Free movement of compression plate shall be ensured before the welding of side suspension rods top end cover and top end cover shall be with pipe assembly. The eye hanger shall be welded exactly at center of top end cover.

2.6 Ensure that the spring is located centrally in the cage and not rubbing with tube wall during compression and expansion. Also ensure that the suspension rods move freely inside turn buckles.

2.7 Rating plate and indicator shall be fixed such that indicator reads zero on 56 mm compression of spring (for 80 series) and on 112 mm compression (160 mm series). The cut edge should be smoothly ground.

2.8 Heat treatment shall be done after shearing for P4 material  $t > 12.5$  mm and for P5 material  $t > 10$  mm. The requirement of preheat for gas cutting are as follows :

Carbon steel	$t \leq 50$ mm	:	Nil
Carbon steel	$t > 50$ mm	:	100 °C. min.
Alloy steel (P4)	$t \leq 25$ MM	:	NIL
ALLOY STEEL (P4)	$t > 25$ mm	:	150 °C
Alloy steel (P5)	ALL	:	150 °C
STAINLESS STEEL	NOT APPLICABLE		

2.9 Stress relieving for gas cut edges shall be as follows :

MATERIAL	THICKNESS	HEAT TREATMENT CYCLE
P1	> 50	600 °C - 650 °C for 30 minutes followed by

Rev no.-02	Ref. TRICHY QP NO. : QP:OS:01/01	Prepared Amit Kumar Dy. Manager (E&M) Bharat Heavy Electricals Ltd. HERP Varanasi	Approved S K Tiwari 20/8/19	Date: 30-08-2019
------------	-------------------------------------	---	-----------------------------------	------------------



PLANT STANDARD  
HERP VARANASI

RV/CLH-VLH/PROCEDURE-001  
Rev-02  
Page 4 of 7

	mm	Furnace cooling. (Alternatively , the cut surface ground /machined up to 3 mm to remove Heat affected area).
P4	> 16 mm	650 ° C - 700 ° C for 30 minutes. Cool.
P5	All	680 ° C - 730 ° C for 30 minutes. Cool.
SS (PLASMA)	Any	Not required

2.10 The raw material after cutting shall be identified with relevant Part No. and material Spec. / Grade transferred. Rating plate shall be fixed only after final assembly and painting. Pointers are to be welded to the spring plate as per drawing.

2.11 Top and bottom tie rods are to be machined to achieve the surface finish given in the drawing. Top and bottom tie rods are to be match drilled with coupling wherever two tie rods are involved. Bottom tie rod is to be match drilled with nut. Hole size shall be as per the drawing requirements.

2.12 Turn buckles shall be welded as per the drawing and drilled coaxial. Special care is to be taken to ensure alignment of pins and bushes.

2.13 Areas in accessible for painting in final assembled condition shall be painted during assembly stage itself.

#### 2.14 The Following Tolerances shall apply

Hole center of lug plate	± 2mm
Hole center of top end cover	± 2 mm
Hole center of compression plate	± 2 mm
Distance between lug plate and top end cover	+5mm/-0 mm
Length of slot	+ 5 mm/-0 mm
Width of slot	+ 2 mm/-0 mm
Lateral shift of slot	± 2 mm
Overall length of tube	± 5 mm

2.15 NDE –The following welds shall be checked by LPI as per procedure BHE: NDT: PB: PT1.

Rev no.-02	Ref. TRICHY QP NO. : QP:OS:01/01	Prepared by <i>Amit Kumar</i> Amit Kumar, Manager (E&M) उप-प्रबंधक (अभियंता एवं डिजाइन) भारत हेवी इलेक्ट्रिकल्स लि. Bharat Heavy Electricals Ltd. Varanasi	Approved S K Tiwari	Date: 30-08-2019
------------	----------------------------------	--	------------------------	------------------



Lug plate and turn buckles welds : 100%  
Top and bottom plate welds : 10%

2.16 All other welds shall be visually examined.

**NOTE -03 For CLH**

Ensure the following during fabrication, machining and assembly.

3.1 Stress relieving requirements shall be same as mentioned at point 2.8 and 2.9

3.2 Suitable templates shall be used for cutting the fixed /swing plate to the required configuration. Two plates shall be tack welded and drilled to get perfect alignment of holes. Match mark are to be made for further assembly and identified pair of plates only should be used in the assembly. Suitable fixture can be used to ensure alignment of holes.

3.3 The distance between the pivot pin and hole and eye bolts pin varies with each hanger i.e. WW value shall be taken from load movement chart and shall be marked on each assembly (on swinging plate).

3.4 Adjusting Plate assembly:

3.4.1 Ensure the center lines of hole and slot are in one line. There should be no taper in the slot.

3.4.2 Necessary care shall be taken while welding side plate and tapped hole plate, to ensure side plate are exactly parallel within 1mm after welding. After welding, the adjusting plate shall be drilled and tapped.

3.4.3 Ensure axis of hole of side plates and tapped plates are perpendicular to each other. Use suitable fixture.

3.4.4 The adjusting plate assembly shall be phosphated.

3.4.5 The spring tension rods is to be machined to achieve the surface finish and slot dimensions as given in the drawing. The threads are to be protected while welding before and after assembly. Chromium plating shall be carried to achieve a minimum thickness 0.06 mm.

3.4.6 During assembly, special care is to be taken to ensure alignment of pins and bushes. After positioning all the part, the arrow is to welded suitably to swing plate assembly so that it should be coincided with zero mark on adjusting plate assembly.

3.5 All load carrying weld shall be subjected to 100% LPI as per BHE: NDT: PB: PT1. All other weld shall be subjected to 100% visual examination and 10% LPI.

Rev no.-02	Ref. TRICHY QP NO. : QP:OS:01/01	Prepared Amit Kumar अमित कुमार उप-प्रबन्धक (अमित एवं वि० / Dy. Manager (E&M) भारत हेवि इलेक्ट्रिकल्स लि० Heavy Electricals Ltd. Varanasi	Approved S/K Tiwari 30/8/19	Date: 30-08-2019
------------	-------------------------------------	--	-----------------------------------	------------------



3.6 All the dimension shall be as per drawing. Untoleranced dimension for fabrication shall be as under :

Length up to and including 750 mm	±2 mm
Length above 750 mm	±3 mm

**NOTE – 04 TESTING OF VLH**

4.1 Ensure that the moving/mating parts are free to rotate before testing.

4.2 Load test shall be carried out on a test rig consisting of Fabricated test stand, calibrated digital load and displacement indicator, calibrated load cells, hydraulic power pack and hydraulic cylinder. (The set up should be similar to that installed in BHEL). Check the calibration of test rig by comparing the deflection of master spring also.

4.3 Mount the Variable Load Hanger on test rig and compress the spring completely then decompress gradually. Again compress the spring and mark the position of pointer by locating the mid load (mentioned in the Load Displacement format Provided by BHEL). Now take the reading of loads at other points below and above the marked mid position and record. While recording the load, it should be ensured that reading should be taken while compressing the spring and not during decompressing.

4.4 If the readings of all the positions are found within limits, Punch mark the zero, mid and extreme positions and set the pointer at zero position (if Cold & Hot values are not mentioned) or on Cold position (where Cold & Hot values are mentioned in details provided by BHEL) and lock the hydraulic nut. Remove the Hanger from test rig and weld the top cover. Paint the final assembly and fix the travel scale. Drill the Spindle bolt together with Nut at specified position. Assemble the Turn Buckle and lock with split pin.

**NOTE -05 FUNCTIONAL TESTING OF CLH (LISEGA) AT MANUFACTURER'S WORKS**

Adjust the compression of the main and auxiliary spring such that the load tube is at centre position between the two lower connection blocks. At this point, both the load adjusting bolts should be equally engaged with bottom connection blocks (to be ensured by measuring the unengaged portion of load bolts). Also, both the Auxiliary springs should be equally compressed. Mount the CLH on the load pulling machine. The pulling tie rod and frame of the lifting machine should be sturdy enough to take the pulling load of respective constant load hanger. Release and remove the Guide bolt stop plates and compress the main spring by pulling the load tube approximately 125 mm for travel scale 150mm, 275 mm for travel scale 300 mm, 425 mm for travel scale 450 mm, 575 mm for travel scale 600 mm (measured by travel scale). There should not be any rubbing between Load tube and Upper Spring end plate. Also there should not be any jamming / unusual rubbing noise of mating components. Check the Nylon Stell rings, it

Rev no.-02	Ref. TRICHY QP NO. : QP:OS:01/01	Prepared Amit Kumar / Amit Kumar Dy. Manager (E&M) BHEL Electricals Ltd. Varanasi	Approved S K Tiwari	Date: 30-08-2019
------------	-------------------------------------	---	------------------------	------------------



PLANT STANDARD  
HERP VARANASI

RV/CLH-VLH/PROCEDURE-001  
Rev-02  
Page 7 of 7

should not be rubbing with case assembly. Inspect by Pulling each assembly 3 to 4 times on the Pulling machine. If deviation is observed, dismantle the assembly and rectify the deviated component.


Rev no.-02	Ref. TRICHY QP NO. : QP:OS:01/01	Prepared Amit Kumar अमित कुमार / Amit Kumar उप० प्रबन्धक (अभि० एवं वि०) / Dy. Manager (E&M) भारत हेवि इलेक्ट्रिकल्स लि०	Approved S K Tiwari S K Tiwari 30/8/19	Date: 30-08-2019
------------	-------------------------------------	---	---	------------------




**BHEL HERP VARANASI  
QUALITY PLAN**

**QUALITY PLAN FOR VARIABLE LOAD HANGERS (WITHOUT SPRING)**

SL.NO.	COMPONENT	CHARACTERISTIC CHECKED	TYPE/METHOD OF CHECK	EXTENT OF CHECK	REFERENCE DOCUMENTS & ACCEPTANCE NORM	FORMAT OF RECORD	AGENCY			REMARKS	
							P	W	V		
1.0	Raw Material : Plates : IS2062 Gr.A/B, Rods : SA 105, IS1875 CL.3, IS:981 Fe 540 HT-W, SA-193B7, ERW Pipes : IS 1239, Seamless pipes : SA 210 Gr. A.1, SA 106 Gr.B	i. Chem. & Mech. Properties	Chem. & Mechanical test	1 sample per batch of material	Applicable material standards (as mentioned in component drawings)	T.C.	3	-	2	Raw material sources and T.C. requirements shall be as per standard No. RV/CLH-VLH/Procedure-001 REV-00	
		ii. Soundness of Rod	Ultrasonic test	20% by BHEL, 100% by Vendor	Acceptance: SA 388; ASME Sec.VII Div. 2 clause 3.3.4	T.C.	3	2		Only for Rod Dia/Thicknesses >50 mm. 100% UT by party (report) and 20% UT witness by TPI during PDI for each size Rod. If 20% of any particular Rod size quantity is less than 01 Whole Rod then Complete Rod Length to be checked.	
2.0	Final Inspection after Assly.	i. D.P. Testing of welded joints	D.P. test	100% by Vendor, 10% random by BHEL	BHENDT.PB:PT-01	TC	3	2	-	Only External Welded Joints (Load Bearing) shall be checked by DP Test. During Final Inspection, 10% randomly selected samples shall be offered to inspector for DP Test witness.	
		ii. Appearance and accuracy of Threads in different componets	Visual, Measurement with GO and NOGO Plug and Ring Gauges	100% by Vendor 10% random by BHEL	Threads to be free from chattering and should pass the GO, NOGO test	Inspection Report	3	2	-	Special Emphasis to be given to Turn Buckle Threads.	
		iii. Zinc plating (wherever specified in the component drawing)	Measurement of coating thickness	100% by Vendor 10% random by BHEL	Drawing	Inspection Report	3	2	-		
		iv. Make of standard fasteners	Review of documents	100%				-	-	2	All the Std. fasteners like Nuts, Bolts, Screws should be make specified as per technical specn. of PO. All the fasteners shall be zinc plated and yellow passivated.
		iv. Dimensions and Threads Checking	Measurement	100% by Vendor 10% by BHEL	Drawing.	Dimension Report	3	2	-	unspecified tolerances shall be maintained as per clause no. 2.14 of standard No. RV/CLH-VLH/Procedure-001 REV-00	
		vii. Identification & Marking	PO No., VLH Type & Vendor Code is to be written by White Paint.	100%	-	Inspection Report	3	2	-	Vendor Code is to be written with white paint as per Writing Instruction for proper accountal of items.	
		viii. Painting of casing	Paint shade and DFT	10% by BHEL on random basis	-	Insp. Report	3	-	1	Surface Preparation of casing must be done with Abrasive blast cleaning method to Sa 2-1/2 before painting.	
											Apply one coat of Epoxy Zinc rich primer, (% vs = 35 min), dft = 40 micron minimum (Shade- Grey).
QP. NO.	RV-QPLH-15 Rev-00	PREPARED BY	APPROVED BY		LEGENDS:		P = TEST CERTIFICATE				
DATE	04-05-2019	SIGNATURE & DATE	SIGNATURE & DATE		W =		H.T. = HEAT TREATMENT				
PG. NO.	1 OF 1				V = VERIFY						
					3 = VENDOR						
					2 = BHEL TPI						
					1 = BHEL						

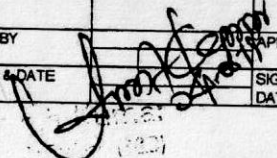  
 J. K. Singh  
 Chief Engineer  
 Bharat Heavy Electricals Ltd.  
 30, Airport Road, Varanasi

  
 M. K. Singh  
 4/5/19



**TECHNICAL SPECIFICATION FOR VARIABLE LOAD SPRING HANGERS (WITHOUT SPRING)**

**A) Scope of supply**

This indent has been raised for fabrication and supply of variable load hanger (without spring, name plate, travel scale & hammer drive screw) in assembled condition for the qty mentioned against each item as per respective annexures. top plate is to be only light tack welded at two places at 180 degree with housing for easy transportation and to avoid misplacement. Pre-dispatch inspection will be carried out at party's works by BHEL representative as per QAP No. mentioned in the PO.

**B) General Requirement**

a. Vendor shall have major in-house manufacturing facilities and services. The details of these major in house manufacturing facilities and services are listed below :

1. Flame cutting, Saw cutting
2. MIG Welding sets
3. Qualified Welders
4. Covered shade for fabrication of Variable Load Hangers
5. Covered storage space for storage of VLH Springs.
6. Small lathes, Milling, Drilling machines for manufacturing of components like Centering Nut, Bottom socket, Spindle Bolt, Top Plate, Bottom plate, Hydraulic Locknut, Bearing Plate, Top & Bottom Tie rod, Spherical washer, Turn Buckle etc.
7. Abrasive blast cleaning facility
8. Separate covered Painting area
9. Level-II qualified D.P. personnel
10. Overhead / Gib crane to handle Load hangers weight > 50 Kg.

Some non-core and hazardous activities like Zinc plating may be outsourced.

**C) Technical Requirement**

1. Raw material should be used as per drawings.
2. Raw material should be procured from sources mentioned in enclosed Annexure-C. Carbon steel material of thickness less than 20 mm can however be procured from traders if tested on random basis in NABL accredited labs for each melt or each lot identified by the tagging incoming material physically and correlating the same tag with the material receipt no. recorded in the day receipt register. The lab test report shall be enclosed with the copy of test certificates.

<b>Date:</b> 29/05/2019	<b>Prepared By</b> Amit Kumar	<b>Prepared By</b>	<b>Approved By</b> S. k. Tiwari
----------------------------	----------------------------------	--------------------	------------------------------------

*(Handwritten signature)*  
29/5/19



3. Party may use equivalent materials as mentioned in the drawing. Use of any other material is not acceptable.
4. Dimensions and tolerances are to be maintained as per drawing and Procedure no. RV/CLH-VLH/Procedure-001 REV-00.
5. All welds are to be carried out by Gas Metal Arc Welding (GMAW) or MIG welding. SMAW or Manual Arc welding may be carried out in special cases with covered electrodes.
6. All welds should be as per sizes mentioned on the drawings. VLH with undersized welds shall not be accepted. The slots on VLH housings should be free from weld bead.
7. Procedure no. RV/CLH-VLH/Procedure-001 REV-00 should be strictly followed for raw material sources and process control in manufacturing and testing.
8. All the standard fasteners to be used shall be zinc plated and yellow chromatised. All standard fasteners shall be any of the following makes.

- a) Sunderam fasteners (TVS brand name)
- b) Laxmi Precision Screw, Rohtak (LPS Brand name)
- c) Deepak Fasteners Ltd. , Ludhiana(DFL Brand name)
- d) Boltmaster India Pvt. Ltd., Mumbai
- e) Caparo Engg. India Ltd., Gurgaon
- f) Sree Pavithra Industries, Chennai
- g) J.J.Industries, Mumbai
- h) KAYPEE Industries, Ludhiana
- i) New Star Industries, Ludhiana
- j) Mega Engg. Pvt. Ltd., Thane
- k) Pioneer Nuts & Bolts Pvt Ltd, Ludhiana
- l) President Engg. Works. Mumbai
- m) Vardhman Industrial Fasteners
- n) Shri Adinath Automotive, Rohtak
- o) Lloyd Infrsystems, Ludhiana

9. For fixing the Name Plate, the size of Pop-Rivet should be chosen w.r.t. housing Thickness in a manner so that it should not be projected much inside housing to create hindrance for smooth movement of spring & Spring Plate.

#### D) Painting

**Surface Preparation & surface profile** : Abrasive blast cleaning to sa - 2 1/2, 35-50 microns.

**Primer** : One Coat of Epoxy Zinc rich primer as per IS 14589 Gr II, (% vs = 35 min), dft = 40 micron minimum.

Date: 29/05/2019	Prepared By Amit Kumar	Prepared By	Approved By S.K. Tiwari
---------------------	---------------------------	-------------	----------------------------



PLANT STANDARD  
HERP VARANASI

RV:TR:VLHUA:001 Rev-01  
Page 3 of 3

Finish Paint : One Coat of Aliphatic acrylic polyurethane paint, (% vs = 40 min), dft = 30 micron minimum. Painting shade shall be Phirozi blue (IS:5 shade no.176 )

**E) Packing instruction:**

items to be supplied in loose condition. threads should be protected with polythene sleeve & foam sheet in such a way that turn buckle movement should be restricted.

Date: 29/05/2019	Prepared By Amit Kumar	Prepared By	Approved By S. k. Tiwari
---------------------	---------------------------	-------------	-----------------------------