
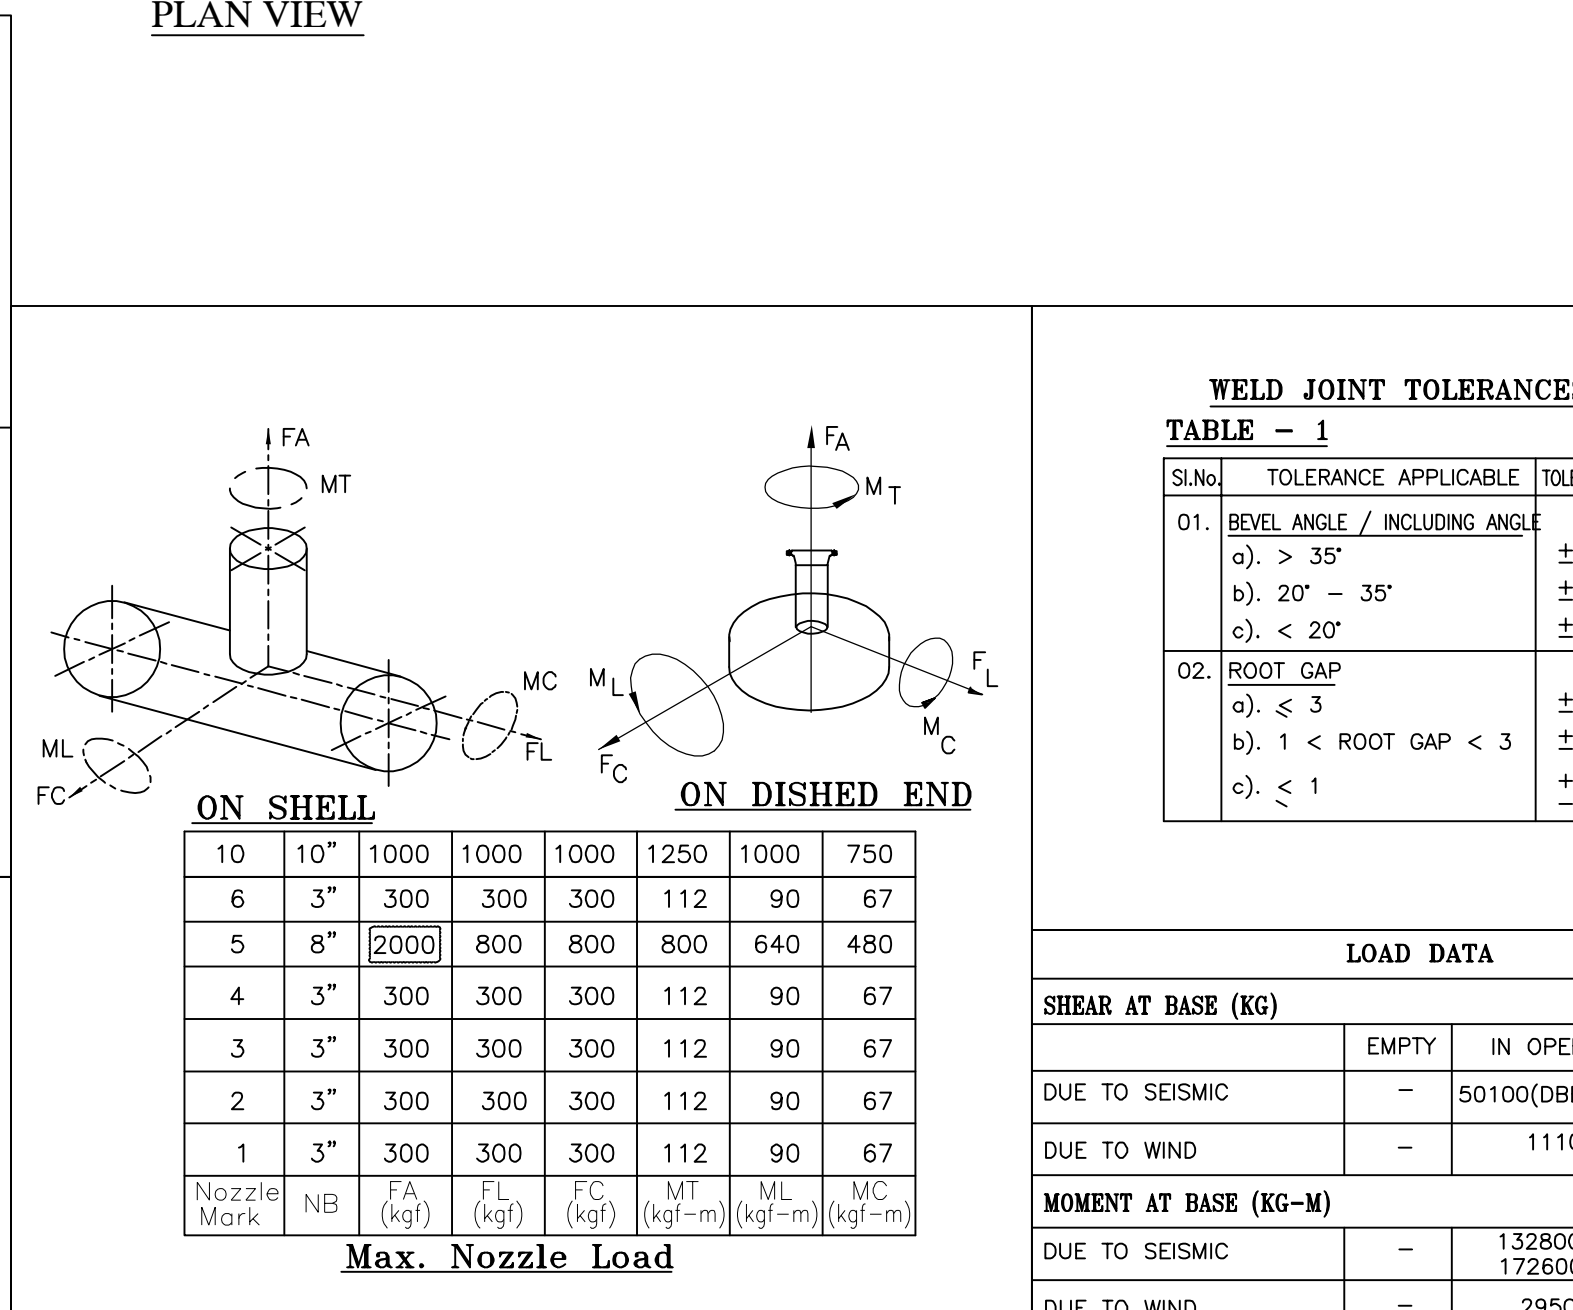
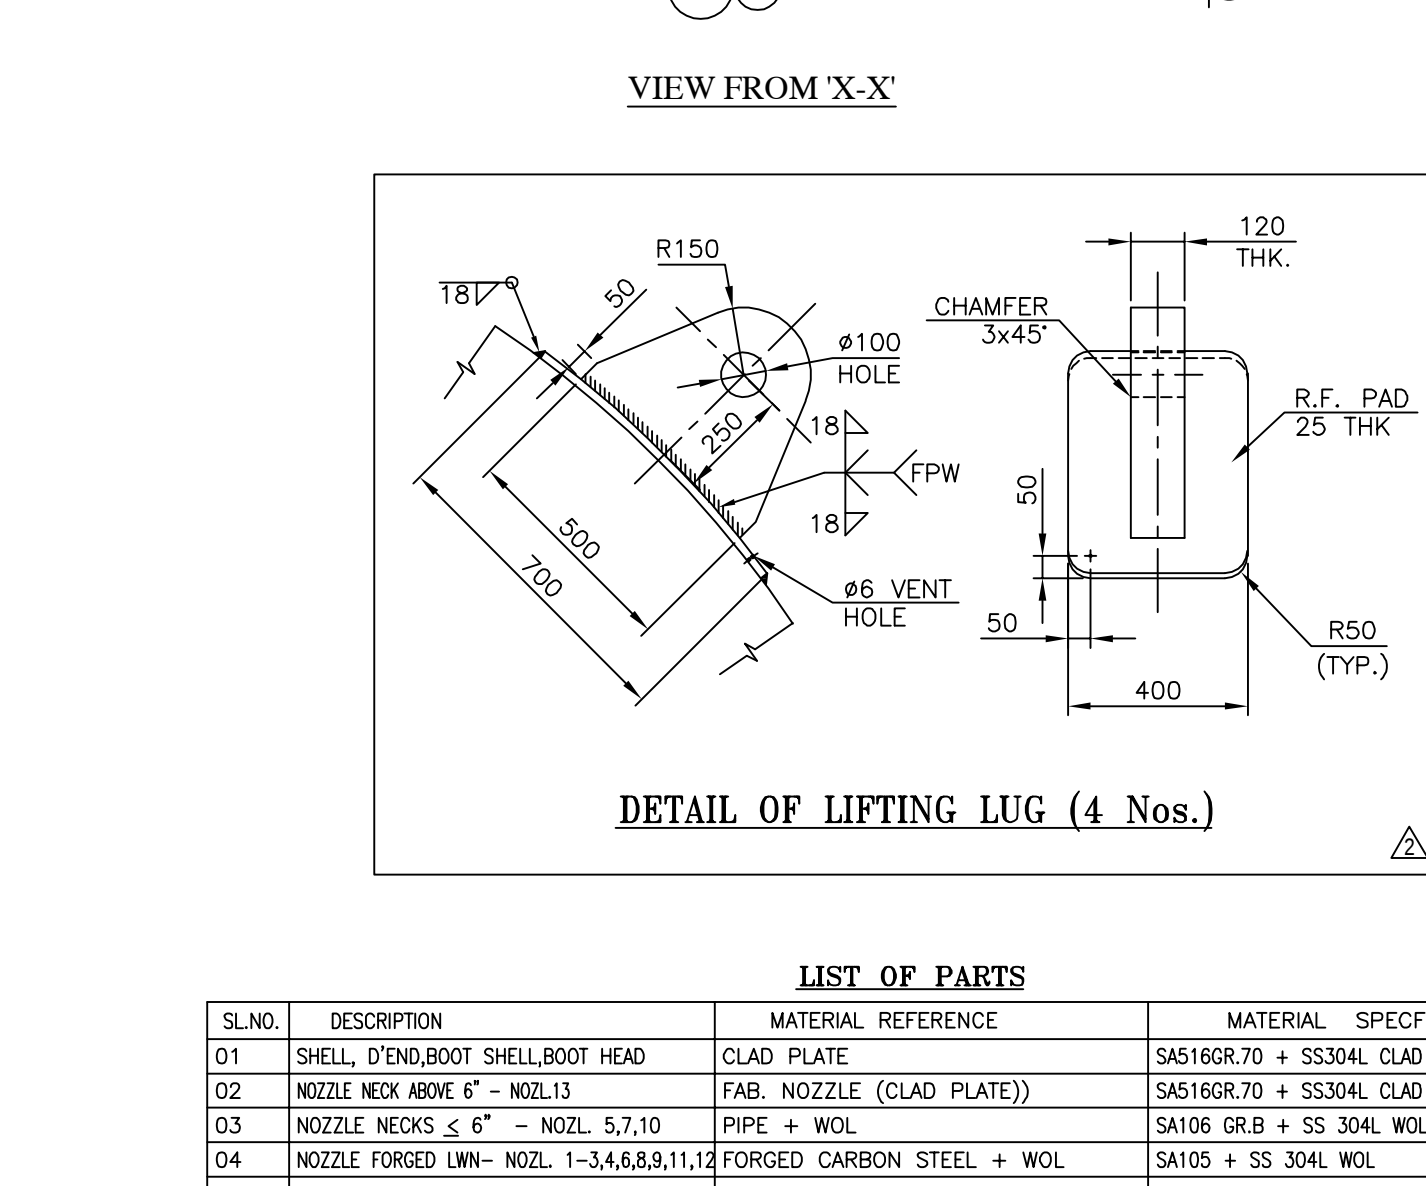
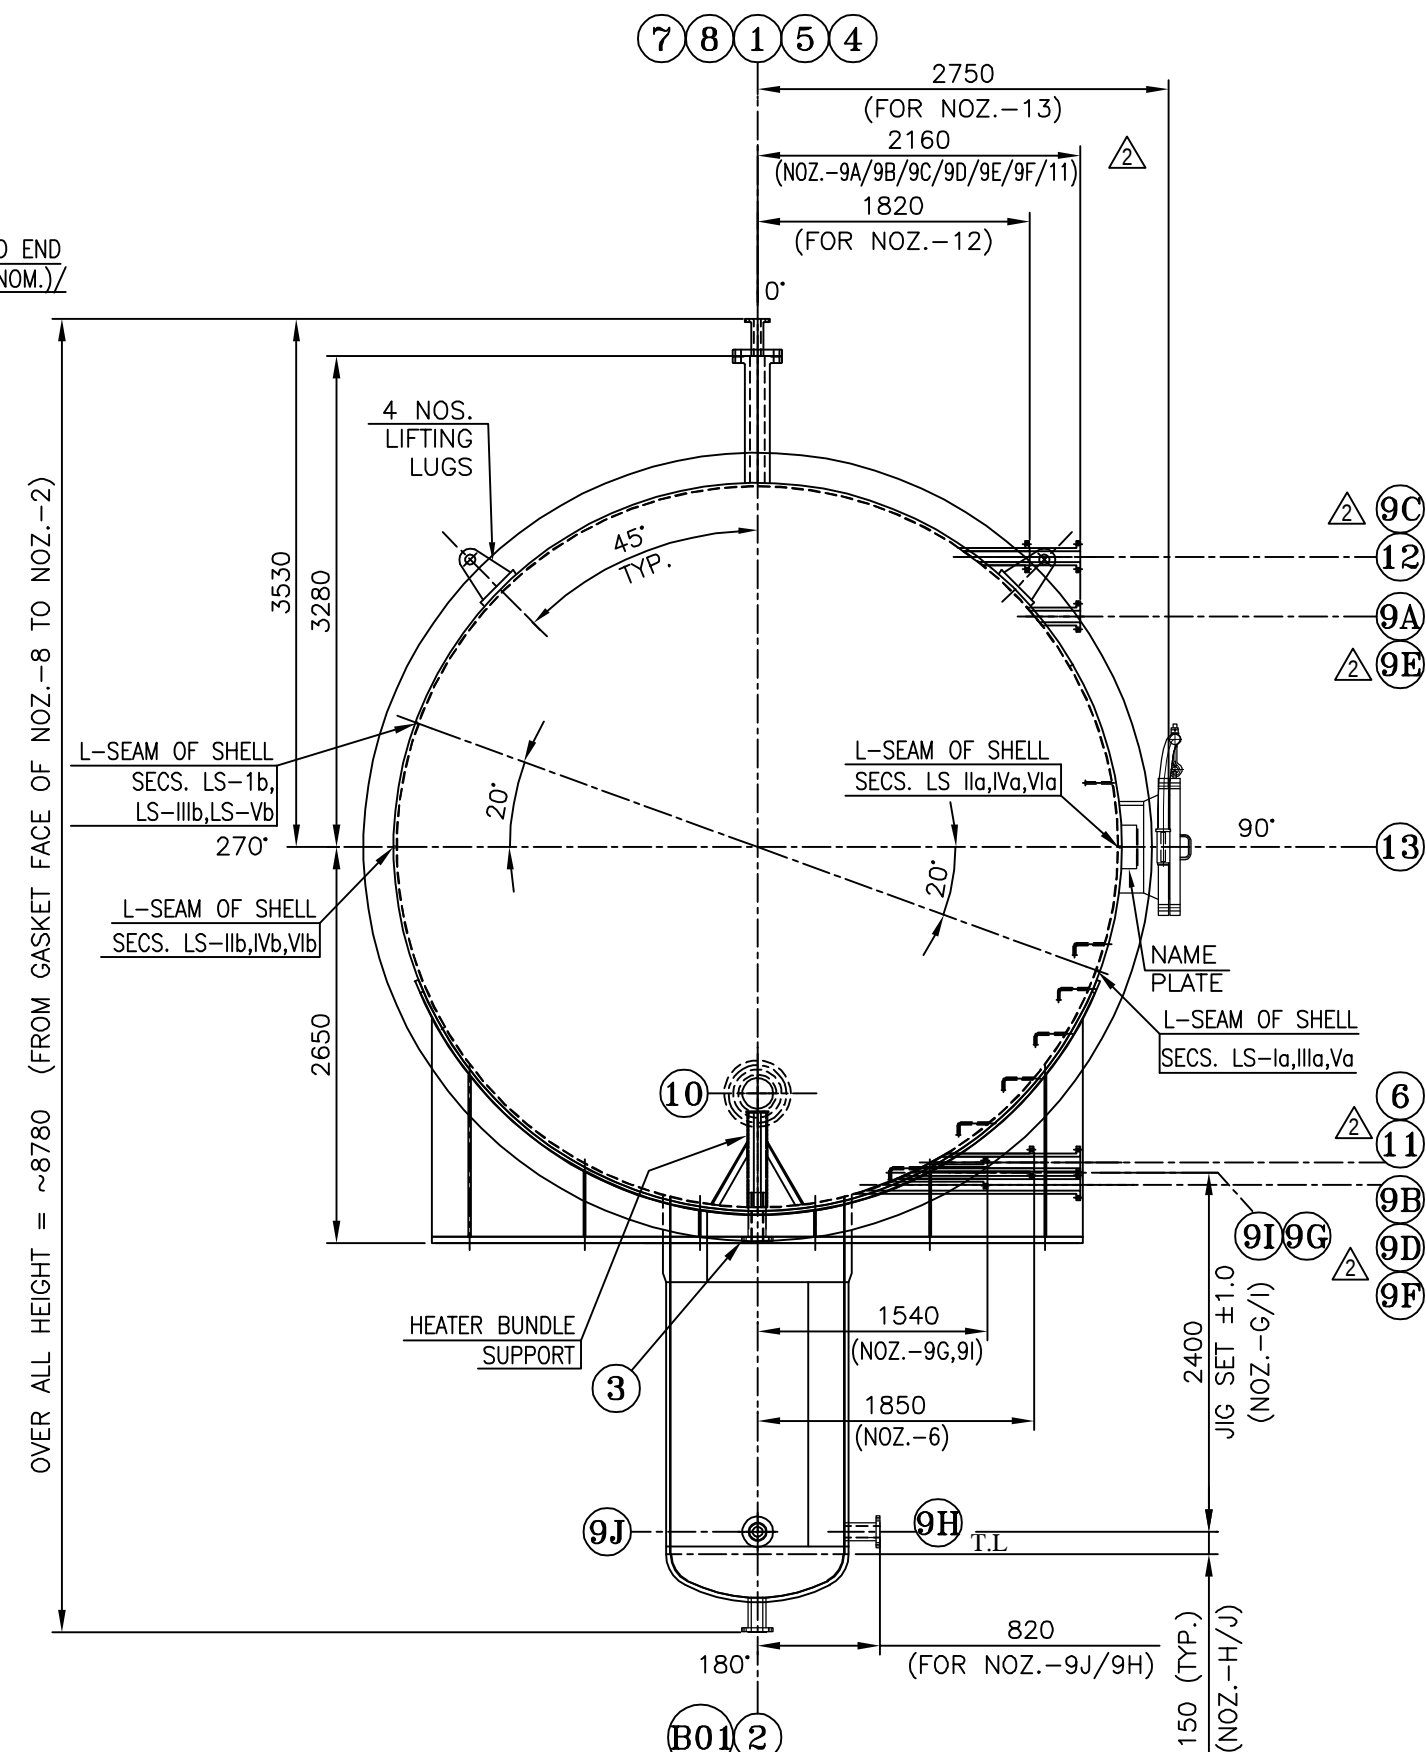
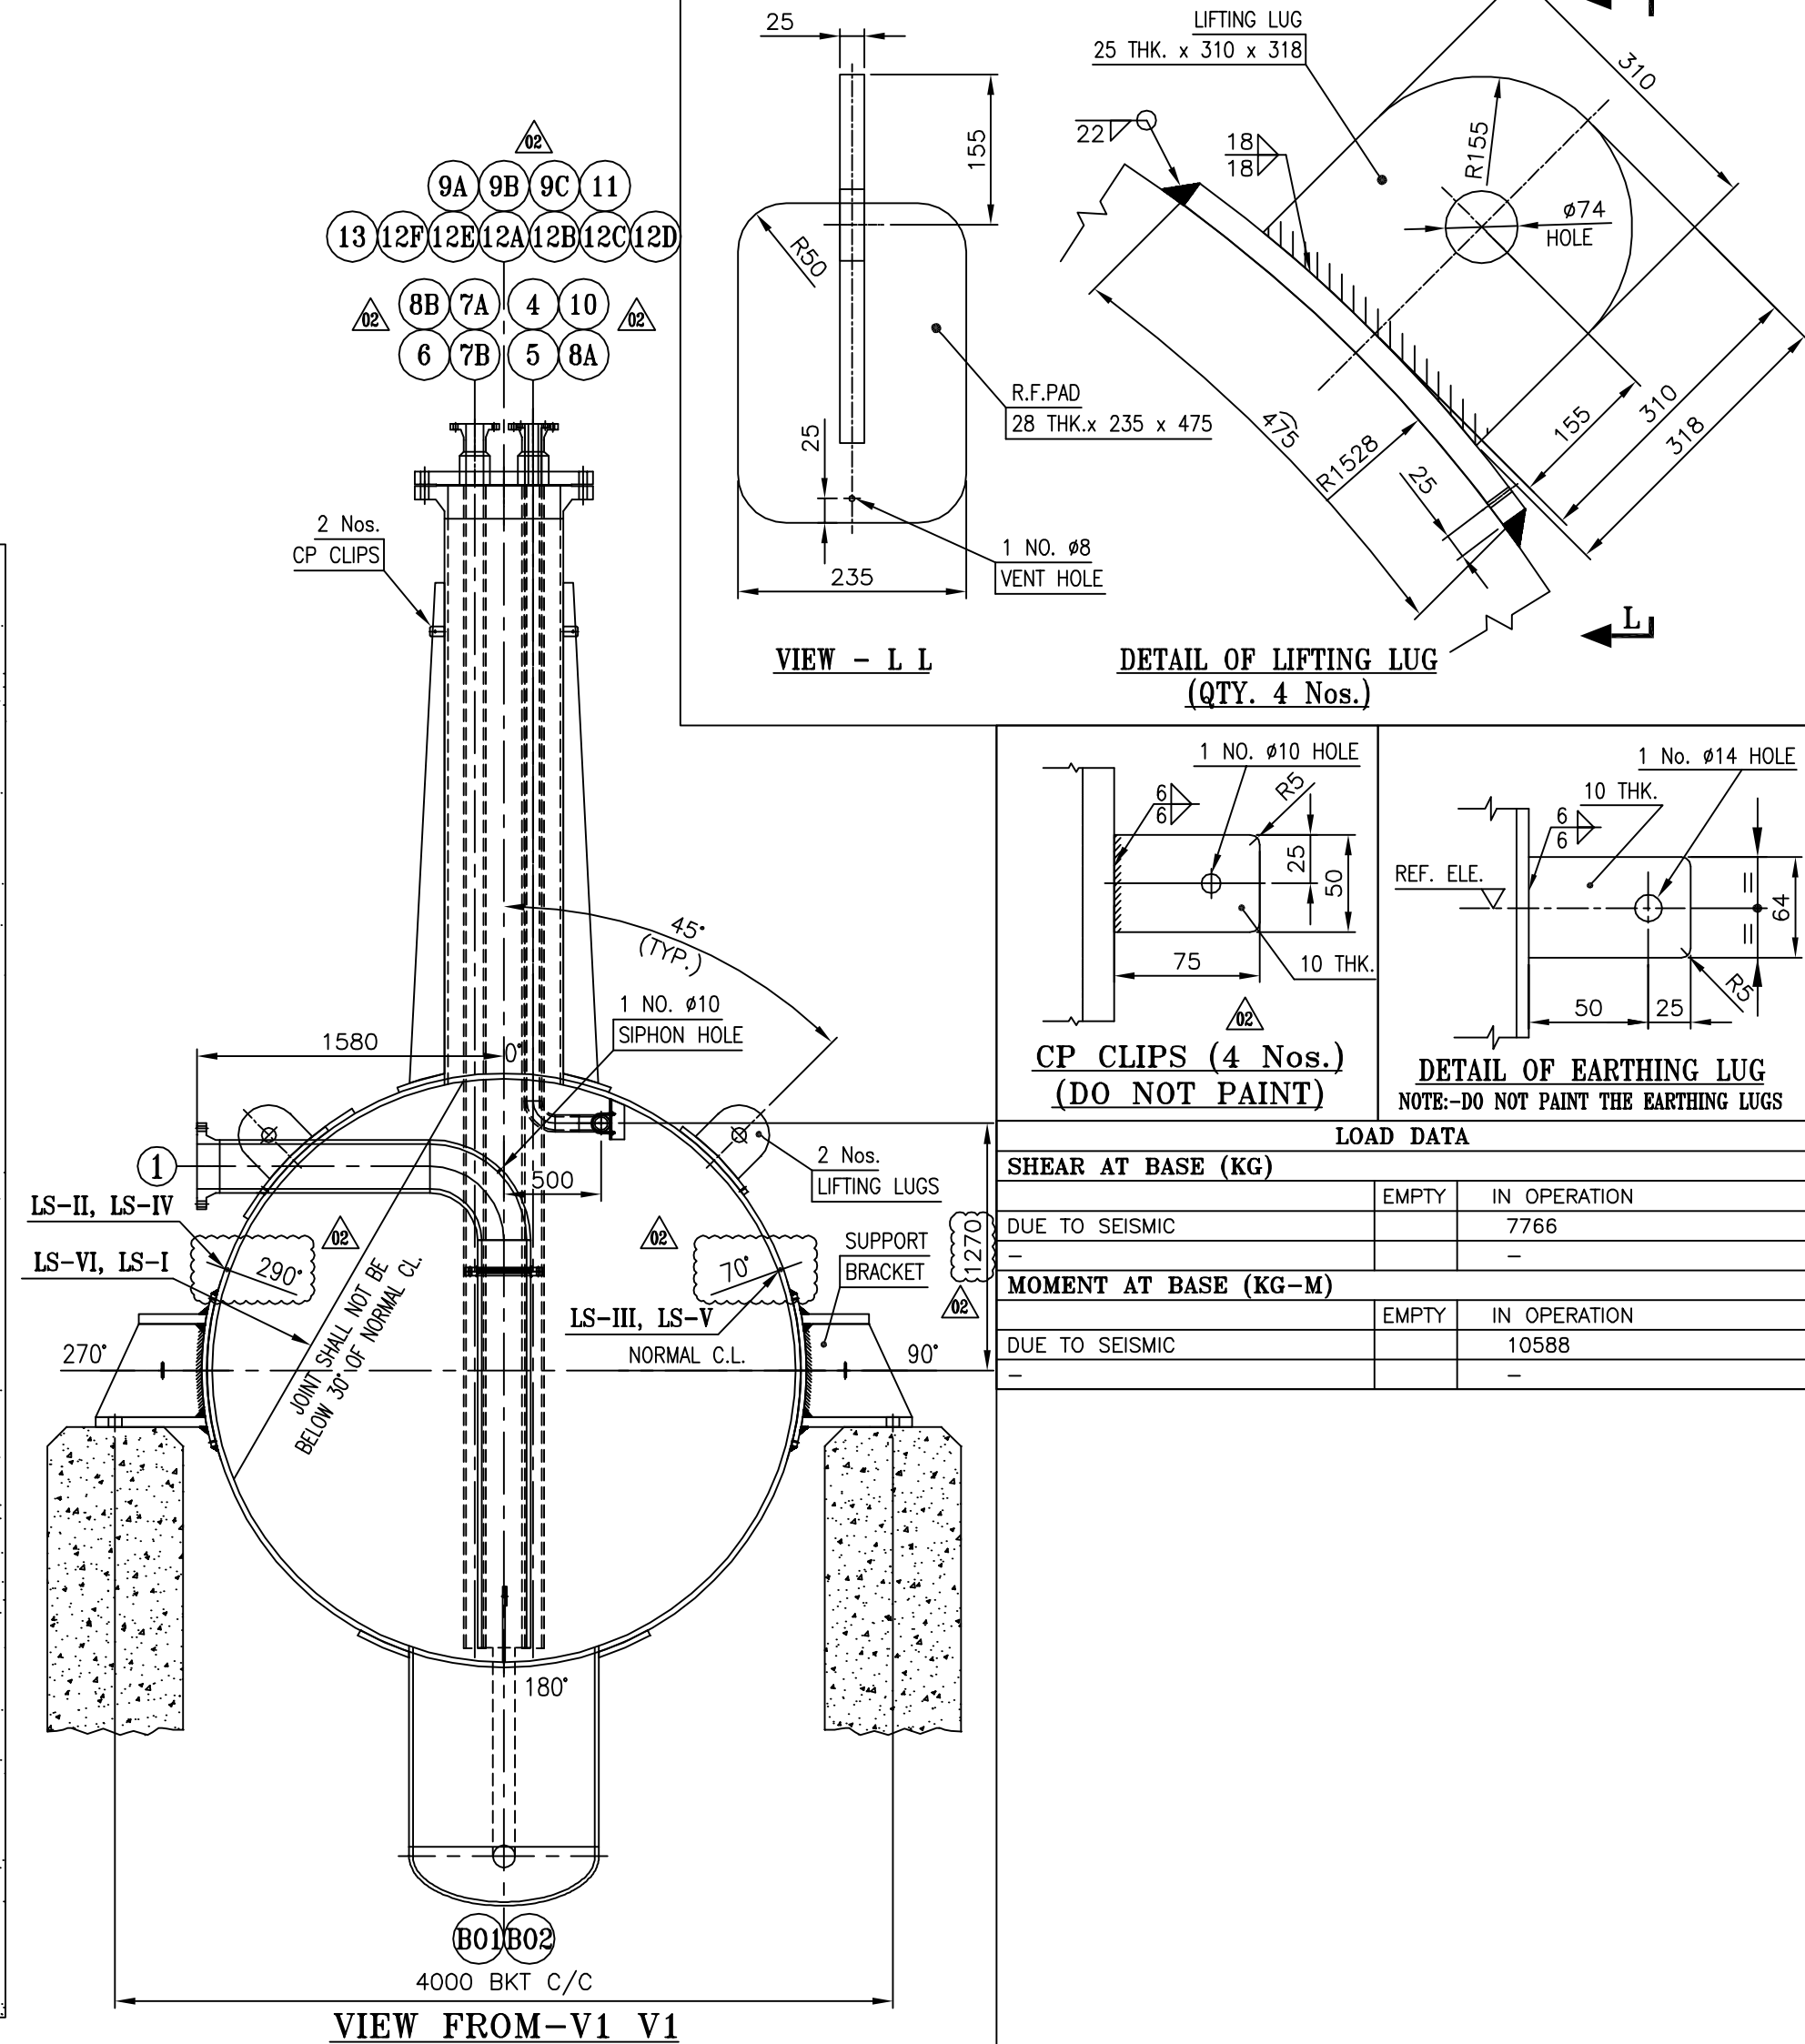
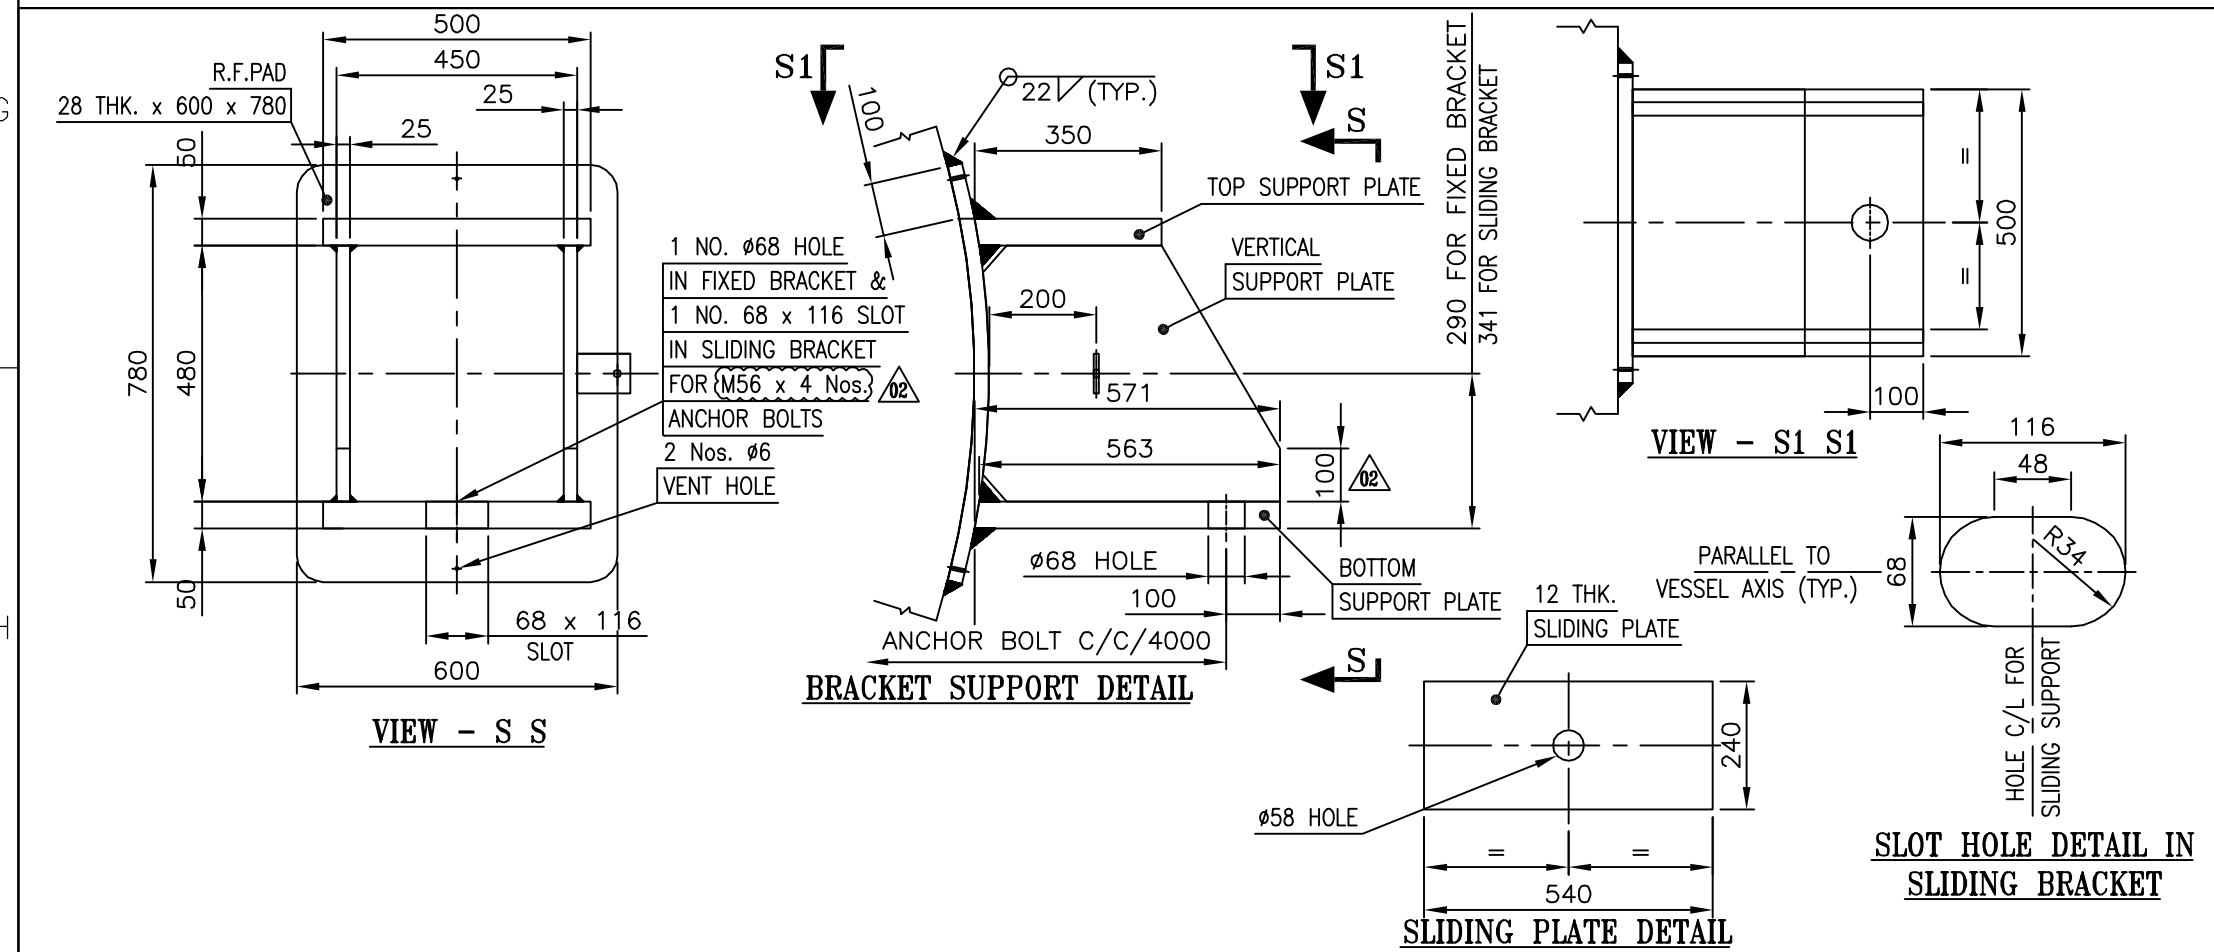
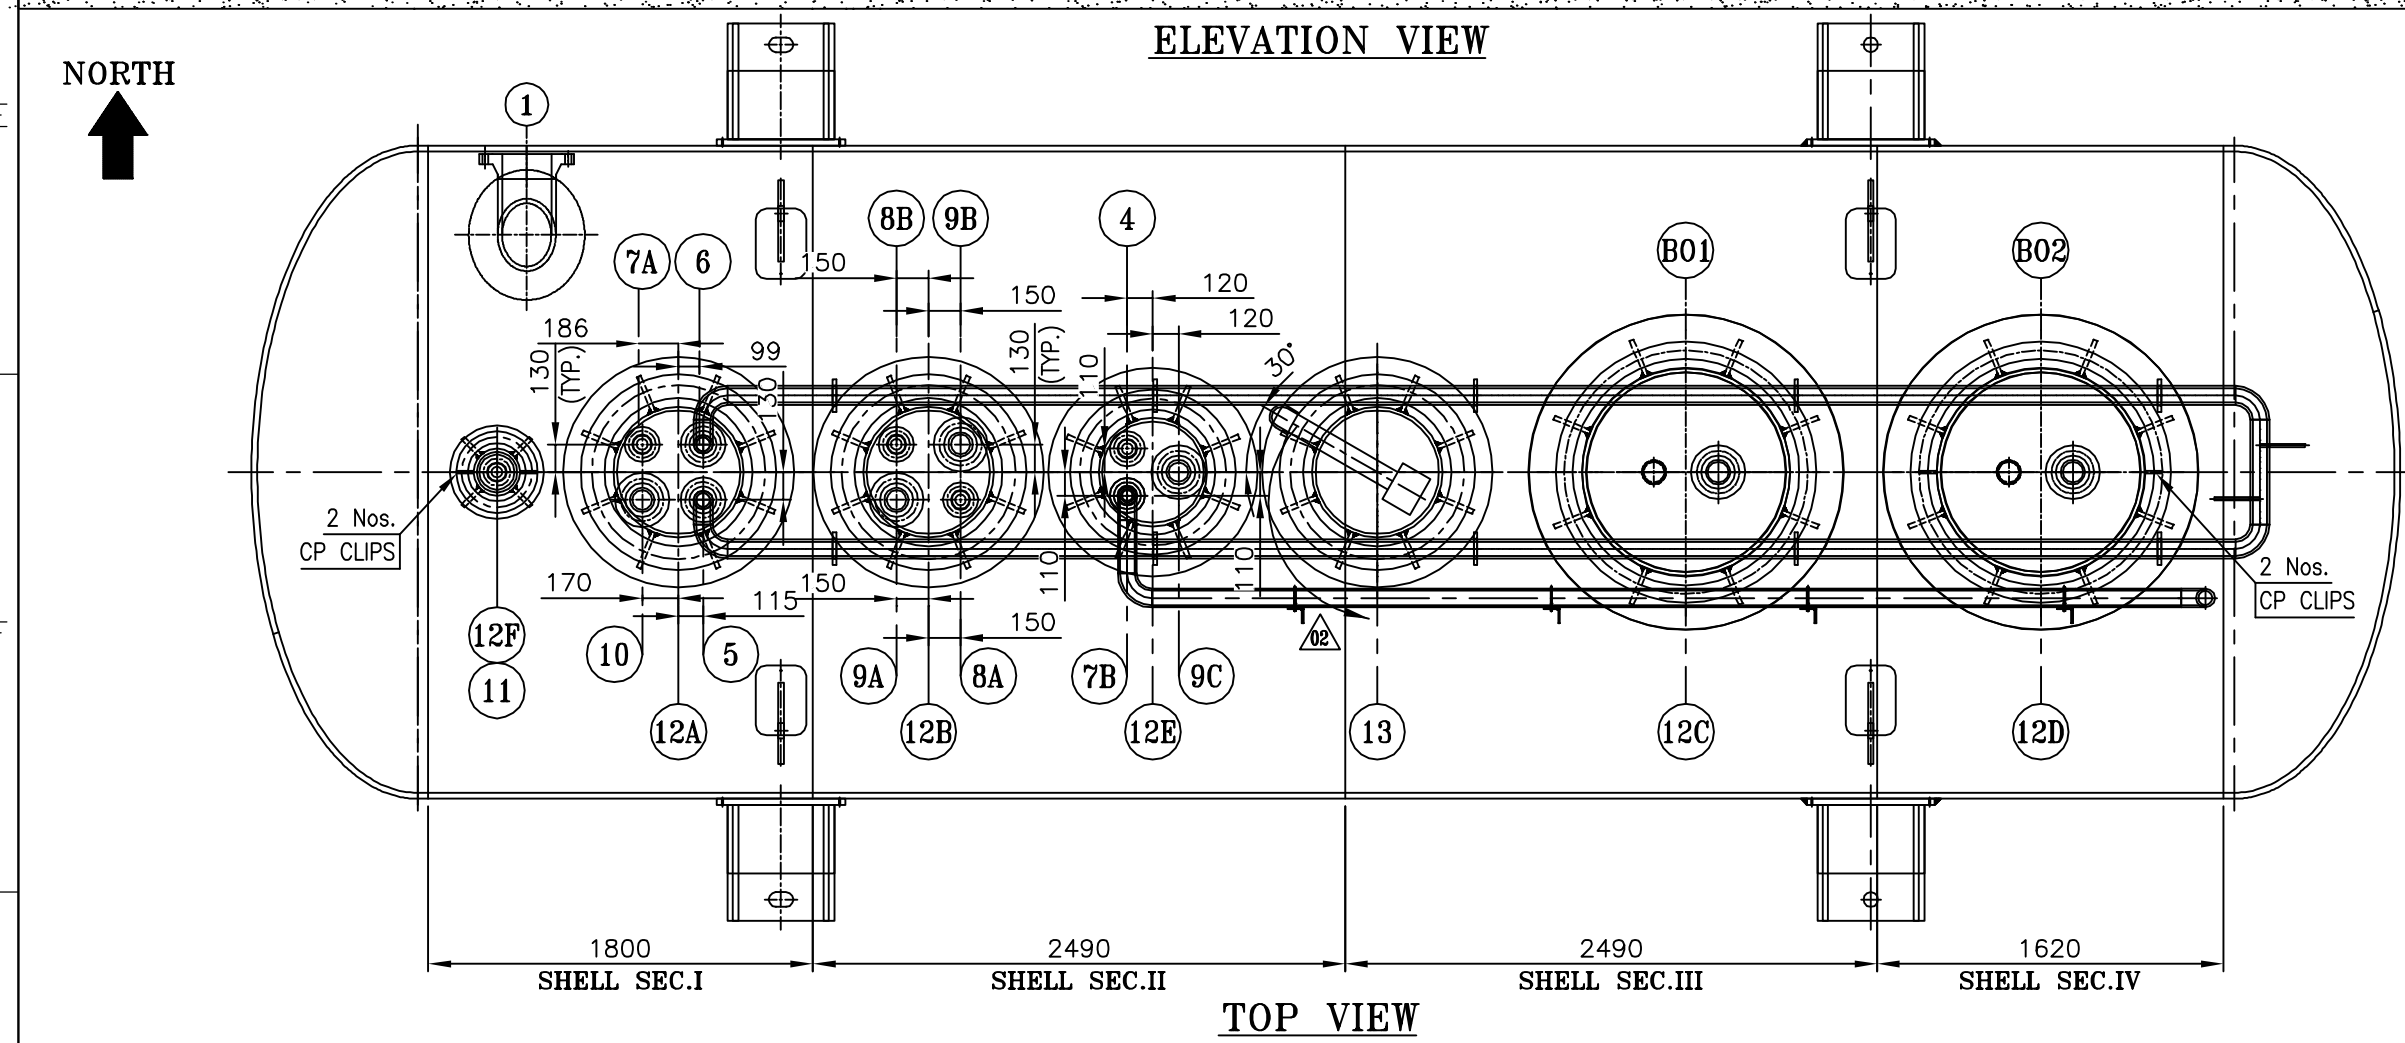


[illegible]

consistency between calculation & drawings.		02 ISSUED FOR APPROVAL		NPR	IM	YPK	18-03-22
		01 ISSUED FOR APPROVAL		NPR	IM	YPK	26-10-22
		00 ISSUED FOR APPROVAL		IZM	YPK	YPK	11-06-22
REV.	DESCRIPTION	DRN	CHECKED	APPROVED	REVIEWED	APPROVED	DATE
OWNER :		 HINDUSTAN PETROLEUM CORPORATION LIMITED VISAKH REFINERY MODERNIZATION PROJECT EPCC-03 PACKAGE FOR RESIDUE UPG-GRADATION FACILITY (RUF)					
PMC :		  ENGINEERS INDIA LIMITED (A Govt. of India Undertaking)					
LSTK CONTRACTOR :		 L&T Hydrocarbon Engineering					
DETAILED ENGINEERING CENTER :		L&T - CHIYODA LIMITED					
VENDOR :		 Bharat Heavy Electricals Limited UNIT: HEAVY PIPES & VESSELS PLANT VISAKHAPATNAM-530012		VENDOR PO NO.: REFINERY/75000-66912/NG DT:18.03.2020			
VENDOR DWG. NO.:		1-PV-050-U0088, REV.2					
DATE		SCALE		TITLE:		GENERAL ASSEMBLY OF	
11.06.20		1:50		TITLE:		SEAL OIL RESERVOIR	
DEPT:		HT ENG:		ITEM NO.		504-V-122	
DRN BY:		IZM		PROJECT:		DRC. NO.:	
CHK BY:		YPR		PWO NO.:		B016-RUF-LT-504-MS-GA-BHEL1)-02151	
APPROVED BY:		YPR		APPROVED BY:		SH. 01 of 02	
REVISED BY:		YPR		APPROVED BY:		REV. 02	

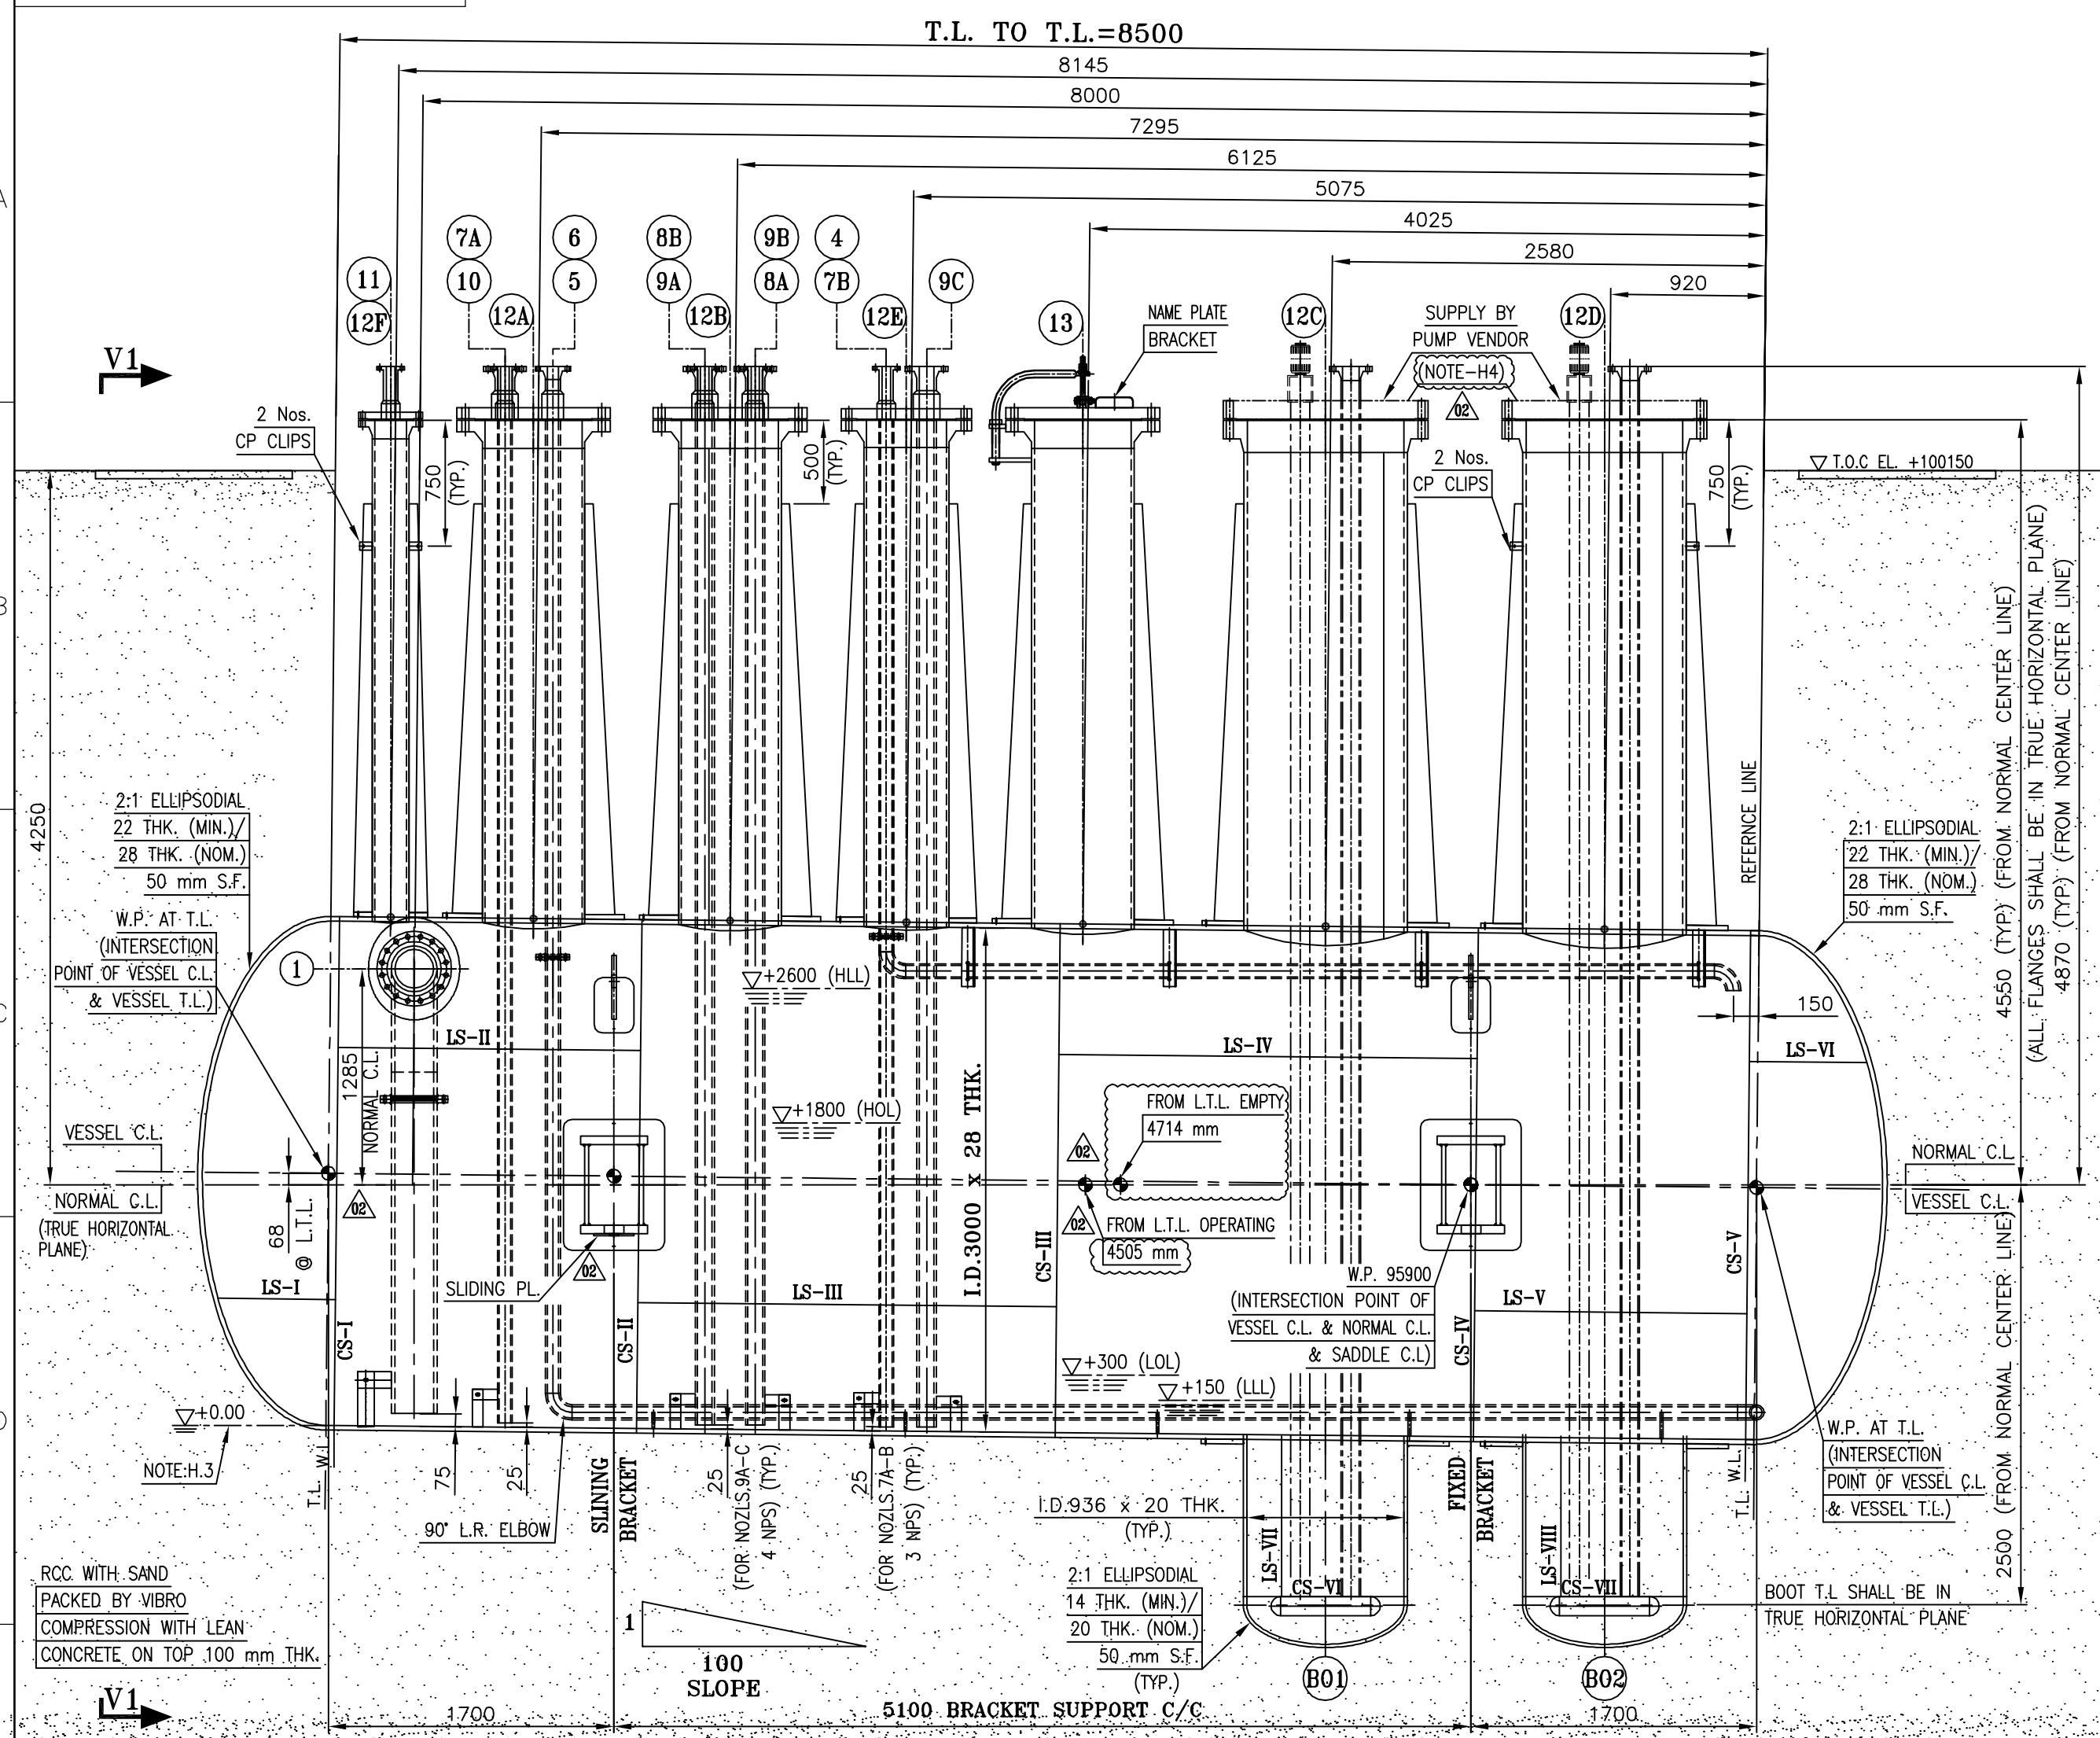

10		11		12	
DESIGN DATA					
SERVICE					
DESIGN PRESSURE INT/EXT – MPa		(Kg/cm ² g)	0.49 (5)	0.183 (1.87) @ HEIGHT POINT Δ	
MAXIMUM ALLOWABLE WORKING PRESSURE MPa		(Kg/cm ² g)	0.49 (5)		
MAXIMUM ALLOWABLE PRESSURE MPa		(Kg/cm ² g)	2.4 (24.7) (LIMITED BY D'END)		
MAXIMUM ALLOWABLE EXT. WORKING PRESSURE MPa		(Kg/cm ² g)	0.208 (2.127)		
MAXIMUM ALLOWABLE CORROSION ALLOWANCE (MM)			7.2 Δ		
DESIGN TEMPERATURE (INT./EXT.) (°C)			260 / 260		
OPERATING PRESSURE MPa		(Kg/cm ² g)	0.147 (1.5)		
OPERATING TEMPERATURE (°C)			56		
STEAM OUT CONDITION MPa		(Kg/cm ² g)	0.049 (0.5) @ 170°C		
LOWEST ALLOWABLE MDMT & COINCIDENT MAX. PRESSURE			-48° C @ 5 (Kg/cm ² g)		
HYD. TEST PRESSURE AS PER UG-99(c) MPa		(Kg/cm ² g)	2.56 (26.10) AT SHOP		
HYD. TEST PRESSURE AS PER UG-99(b) MPa		(Kg/cm ² g)	0.64 (6.5) AT SITE		
CORROSION ALLOWANCE (MM) SHELL, HEADS (INT./EXT.)-3/3 REMOVABLE INTERNAL, BRACKET SUPPORT-3 PERMANENT INTERNAL-6					
CAPACITY (Kg/M ³)			67.404	CLAD (mm)	NIL
RADIOGRAPHY:			SHELL: 100%	HEAD: 100%	
JOINT EFFICIENCY			SHELL: 1.0	1.0	
IMPACT TESTING		EXEMPTED, AS PER UCS-66(b)(3)		WEIGHTED WEIGHT : ~38500 Kg.	
OTHER LOADINGS [YES AS PER UG-22(a), (b), (c), (d), (2), (f)]				FABRIC (EMPTY) : ~38500 Kg.	
INSULATION / FIRE PROOFING		NO		OPERATION WEIGHT : ~90000 Kg.	
DENSITY OF FLUID (Kg/M ³)		600–1000 (max)		TEST WEIGHT : ~107000 Kg.	
MDMT @ MAWP (°C) @ (Kg/cm ²)		12.5 @ 5		SPECIAL SERVICE : SUPPLEMENTARY–A	
NB CODE STAMP REQUIRED		☐ YES ☒ NO		CYCLIC SERVICE : NO	
ASME CERTIFICATION MARK Δ		YES, U STAMP		VESSEL SLNO. : 26675	
CODE: ASME SEC. VIII DIV –1 : ED–2019				CONSIGNMENT SIZE : ODC/ORDINARY	
NOZZLE LOAD DATA		APPLICABLE		POSITION OF VESSEL : HORIZONTAL	
WIND SPECIFICATION :		NOT APPLICABLE		HYDROTEST POSITION : HORIZONTAL IN SHOP	
EARTHQUAKE SPECIFICATION : IS 1893 (PART 4)–2015 & SITE SPECTRA				INSPECTION: M's/TUV, AUTHORISED INSPECTION M's/BV	
EQUIPMENT CATEGORY : 1, SOIL TYPE : SOFT				STATE WISE & THIRD PARTY INSPECTION : YES	
SEISMIC CODE : III, IMPORTANCE FACTOR : 2				NATIONAL BOARD REGISTRATION : NOT REQUIRED	
POST WELD HEAT TREATMENT [YES, (REFER HEAT TREATMENT TABLE BELOW)]					
POST FORMING HEAT TREATMENT Δ		NOT REQUIRED, AS PER 4.3.1. (C) OF 6–12–0002 (FOR COLD FORMED HEADS)			
LOCATION OF INSTALLATION		M/s.HPCL–VISAKHAPATNAM, AP, INDIA.			
COIL DESIGN PRESSURE ((NOZ.5 & 6) INT./EXT.) (Kg/cm ² g)		8 / 5			
COIL DESIGN TEMPERATURE ((NOZ.5 & 6) INT./EXT.) (°C)		190/260			
COIL DEGREE OF RADIOGRAPHY		100%			
COIL JOINT EFFICIENCY : 1.0		COIL HYDROTEST PRESSURE : 26.10 (Kg/cm ² g)			

MATERIAL OF CONSTRUCTION			
SL.NO.	DESCRIPTION	MATERIAL REFERENCE	MATERIAL SPECIFICATION
01	SHELL / BOOT SHELL	CARBON STEEL	SA 516 GR.70
02	HEADS / BOOT HEADS	CARBON STEEL	SA 516 GR.70
03	SUPPORT	CARBON STEEL	SA 516 GR.70
04	NOZZLE FLANGE	FORGED (CARBON STEEL)	SA 105
05	NOZZLE NECK	CARBON STEEL (FORGED CARBON STEEL)	SA 106 GR.B / SA 516 GR.70/SA 105
06	GASKET (EXTERNAL)	STAINLESS STEEL	SS 316 SPIRAL WOUND GASKET FILLED WITH SS 316 INNER RING & C.S. OUTER RING
07	GASKET (INTERNAL)	ALLOY STEEL	CNAF
08	BOLT & NUT (EXTERNAL)	CARBON STEEL	SA 193 GR.B7 / SA 194 GR.2H
09	BOLT & NUT (INTERNAL)	STAINLESS STEEL	SS 304
10	INTERNAL ATTACHMENT	CARBON STEEL	SA 516 GR.70 / SA 106 GR.B
11	EXTERNAL ATTACHMENT	CARBON STEEL	SA 516 GR.70
12	PIPE FITTINGS	CARBON STEEL	SA 234 GR.WPB
13	EARTHING LUG	STAINLESS STEEL	SA 240 TP 304
14	LIFTING LUG	CARBON STEEL	SA 516 GR.70
15	ANCHOR BOLT	CARBON STEEL	IS 2062 GR.E250 B0/BR
16	CATHODIC PROTECTION CLIP	CARBON STEEL	SA 516 GR.70

REFERENCE DRAWING LIST			
BHEL DOCUMENT NUMBER	CLIENT DOCUMENT NUMBER	DRAWING TITLE	
1-PV-160-U0116	B016-RUF-LT-504-MS-FD-BHEL(1)-02552	ASSEMBLY DETAILS OF CLOSED BLOWDOWN DRUM-1 (504-V-803)	
0-PV-160-U0018	B016-RUF-LT-504-MS-FD-BHEL(1)-02554	SHELL DEVELOPMENT OF CLOSED BLOWDOWN DRUM-1 (504-V-803)	
3-PV-160-U0182	B016-RUF-LT-504-MS-FD-BHEL(1)-02555	DETAILS OF MANWAY DAWIT FOR CLOSED BLOWDOWN DRUM-1 (504-V-803)	
3-PV-160-U0180	B016-RUF-LT-504-MS-FD-BHEL(1)-02557	NAME PLATE DETAILS FOR CLOSED BLOWDOWN DRUM-1 (504-V-803)	
3-PV-160-U0179	B016-RUF-LT-504-MS-FD-BHEL(1)-02558	GENERAL NOTES FOR CLOSED BLOWDOWN DRUM-1 (504-V-803)	
2-PV-160-U0045	B016-RUF-LT-504-MS-DW-BHEL(1)-02559	TRANSPORTATION ARRANGEMENT DETAILS FOR CLOSED BLOWDOWN DRUM-1 (504-V-803)	
1-PV-160-U0052	B016-RUF-LT-504-MS-LS-BHEL(1)-03024	SCHEDULE OF MANDATORY SPARES & COMMISSIONING SPARES (504-V-803)	
PPVP-2438-PV-160-001	B016-RUF-LT-504-MS-CL-BHEL(1)-02556	MECHANICAL DESIGN OF CLOSED BLOWDOWN DRUM-1 (504-V-803)	

LIST OF HOLDS 1. PUMP NOZZLE LOAD+MOMENT FOR 12c/O		DRG. CATEGORY: _____ (USE TICK MARK)		☐ R	☐ I	EIL REVIEW/APPROVAL _____	VPLT. NO.: _____
		SCH. DATE OF SUBMISSION _____		DOCUMENT STATUS STATEMENT OF SUB: ☐ 1st ☐ 2nd ☐ 3rd		CODE: _____	
☐ FINAL FOR CODE-1		☐ AS BUILT		☐ PROCEED WITH MANUFACTURE / FABRICATION / CONSTRUCTION AS PER THE DOCUMENT.		☐ REVIEW CODE 2 – PROCEED WITH MANUFACTURE / FABRICATION / CONSTRUCTION AS PER THE COMMENTED DOCUMENT. REVISED DOCUMENT REQUIRED.	
☐ AS BUILT ☐ CONSTRUCTION		ISSUED FOR ☐ INFORMATION ☐ REVIEW		☐ REVIEW CODE 3 – DOCUMENT DOES NOT CONFORM TO BASIC REQUIREMENTS AS MARKED. RESUBMIT FOR REVIEW.		☐ R – DOCUMENT IS RETAINED FOR RECORDS. PROCEED WITH MANUFACTURE / FABRICATION	
SIGN: _____		DATE: _____		☐ V-VOID NAME _____ DOCPLINE _____		SIGN _____ DATE _____	

[illegible]


 PWC : **इंजीनियर्स इंडिया लिमिटेड**  **ENGINEERS INDIA LIMITED**
 (एनटी हाइड्रोकार्बन एंजिनियरिंग) (A Govt. of India Undertaking)

L&T CONTRACTOR:  **L&T Hydrocarbon Engineering**

SMC CERTIFICATION MARK
WITH U-DESIGNATOR

KT - CHIVODA LIMITED REVIEW CODE 1 - NO COMMENTS PROCEED WITH MANUFACTURE / FABRICATION / CONSTRUCTION AS PER THE DOCUMENT. REVIEW CODE 2 - PROCEED WITH MANUFACTURE / FABRICATION / CONSTRUCTION AS PER THE COMMENTED DOCUMENT. REVISED DOCUMENT REQUIRED. REVIEW CODE 3 - DOCUMENT DOES NOT CONFORM TO BASIC REQUIREMENTS AS MARKED. RESUBMIT FOR REVIEW. R - DOCUMENT IS RETAINED FOR RECORDS. PROCEED WITH MANUFACTURE / FABRICATION V-VOID				VENDOR : effa Bharat Heavy Electricals Limited UNIT: HEAVY PULPS & VESSIS PLANT VISAKHAPATNAM-530012 DATE: 23.11.2020 DEPT: HT/ENG. DRN BY: ALPKAVASH CHK BY: D.SATISH APP BY: D.SATISH		VENDOR : REFINERY/75000-66912/NG DT:18.03.2020 VENDOR DWG. NO.: 1-PV-160-U0115, REV-02 GENERAL ASSEMBLY OF CLOSED BLOWDOWN DRUM-1 (ITEM M-RUF-54-V-803) DGR. NO.: B016-RUF-54-MS-GA-BHEH(1)-02551 PWO NO.: SH. 01 of 01 REV. 02 CAD: REUSE THE DWG. USING CAD SYSTEM ONLY. FILE:	
---	--	--	--	--	--	---	--

HEAT TREATMENT CYCLE							
Part	Procedure	Loading Temperature (°C)	Holding Temperature (°C)	Heating Rate (°C/hr)	Holding Time (min)	Cooling Rate (°C/hr)	Remarks
BLIND FLG. ASSLY	PWHT	<425	630±10	110	165	140	Unloading at 425°C
COMPLETE EQUIPMENT	PWHT	<425	630±10	110	70	140	Unloading at 425°C

APPLICABLE STANDARDS :	
1.	ASME BOILER & PRESSURE VESSEL CODE SEC VIII DIV 1 : ED-2019
2.	ASME BOILER & PRESSURE VESSEL CODE SEC II PART A, C & D : ED-2019
3.	ASME BOILER & PRESSURE VESSEL CODE SEC V : ED-2019
4.	ASME BOILER & PRESSURE VESSEL CODE SEC IX ED-2019
5.	ASME B16.5 ED-2013-STANDARD FOR PIPE FLANGES AND FLANGED FITTINGS.
6.	ASME B16.11 ED-2016 FORGED STEEL FITTINGS, SOCKET WELDED & THREADED
7.	ASME B36.10M ED-2018 WELDED AND SEAMLESS WROUGHT STEEL PIPE
8.	ASME B16.20 ED2013 METALLIC FLAT GASKET FOR PIPE FLANGES
9.	ASME B16.21 ED2011 NON METALLIC FLAT GASKET FOR PIPE FLANGES

B01-2	2	BOOT FOR PUMP NOZZLE	I.D.936	—	—	—	SEE DRG.	250 x 32		
13	1	MANWAY+B.F.+DAVIT	600 (24")	610.0	40	300	WN/RF	SEE DRG.	235 x 28	
12F	1	VENTILATION+B.F	200 (8")	219.1	100	300	WN/RF	SEE DRG.	110 x 28	
12E	1	HOUSING NOZZLE FOR NOZLS.4, 7B & 9C	500 (20")	508.0	60	300	WN/RF	SEE DRG.	165 x 32 (WITH BLIND)	
12C-D	2	PUMP NOZZLE	950 (38")	I.D. 931.6	20	300	WN/RF	SEE DRG.	250 x 32 AS PER 16.47 SERIES-B	
12B	1	HOUSING NOZZLE FOR NOZLS.8A/B & 9A/B	600 (24")	610.0	40	300	WN/RF	SEE DRG.	235 x 28 (WITH BLIND)	
12A	1	HOUSING NOZZLE FOR NOZLS.5, 6, 7A & 10	600 (24")	610.0	40	300	WN/RF	SEE DRG.	235 x 28 (WITH BLIND)	
11	1	VENT	50 (2")	84.0	16.6	300	SRLWN/RF	SEE DRG.	— I.D.50.8	
10	1	LP FLARE	100 (4")	114.3	160	300	SRWN/RF	SEE DRG.	—	
9A-C	3	LEVEL TAPS RADAR (NON CONTACT TYPE)	100 (4")	114.3	160	300	SRWN/RF	SEE DRG.	— {I.D.87.2 (WITH PIPE)}	
8A/B	2	PRESSURE TAPS	50 (2")	84.0	16.6	300	SRLWN/RF	SEE DRG.	— I.D.50.8	
7A/B	2	TEMPERATURE TAPS	50 (2")	84.0	16.6	300	SRLWN/RF	SEE DRG.	— {I.D.50.8 (WITH PIPE)}	
6	1	BEARING COOLING WATER RETURN	80 (3")	88.9	160	300	SRWN/RF	SEE DRG.	—	
5	1	BEARING COOLING WATER SUPPLY	80 (3")	88.9	160	300	SRWN/RF	SEE DRG.	—	
4	1	STEAM OUT/FG	50 (2")	84.0	16.6	300	SRLWN/RF	SEE DRG.	— {WITH PIPE}	
1	1	FEED INLET	250 (10")	273.1	120	300	WN/RF	SEE DRG.	135 x 28	
MARK NO.	QTY.	SERVICE	NB (N.P.S.)	O.D.	SCH. THK.	RATING CLASS	TYPE/ FACE	PROJECTION	R.F. PAD W x THK.	REMARKS
TABLE OF NOZZLES										

4	2	200	200	200	50	40	30
5, 6	3	300	300	300	112	90	67
10	4	400	400	400	200	160	120
12E	20	2000	2000	2000	5000	4000	3000
12D	38	3800	3800	3800	18050	14440	10830
12C	38	3800	3800	3800	18050	14440	10830
12B	24	2400	2400	2400	7200	5760	4320
12A	24	2400	2400	2400	7200	5760	4320
1	10	1000	1000	1000	1250	1000	750
Nozzle Mark	NPS	FA (kgf)	FL (kgf)	FC (kgf-m)	MT (kgf-m)	ML (kgf-m)	MC (kgf-m)
Max. Nozzle Load							

TABLE OF NOZZLES 02

